

CANADA - BRITISH COLUMBIA

FRASER RIVER FLOOD CONTROL 1968 AGREEMENT

Inventory and Engineering Branch  
Ministry of Environment  
Victoria, British Columbia

Water Planning and Management Branch  
Inland Waters Directorate  
Pacific and Yukon Region  
Department of the Environment  
Vancouver, British Columbia

DISTRICT OF SURREY

Operations and Maintenance Instructions  
Flood Control Works

Serpentine and Nicomekl Dams

Associated Engineering Services Ltd.  
1661 West 8th Avenue  
Vancouver, B.C.  
V6J 1V1

DISTRICT OF SURREY

Operations and Maintenance Instructions  
Flood Control Works

Serpentine and Nicomekl Dams

CONTENTS

Page No.

Title Page . . . . .	i
Record of Amendments . . . . .	ii
Contents . . . . .	iii
List of Appendices . . . . .	v
Key Plan . . . . .	vi

SECTION A INTRODUCTION

1.	THE PROGRAM	
1.1	The Fraser River Flood Control 1968 Agreement . . . . .	1
2.	THE PROJECT	
2.1	The District of Surrey Project . . . . .	1
2.2	Project Construction Period . . . . .	1
3.	RESPONSIBILITY FOR MAINTENANCE	
3.1	Responsibility for Project Maintenance . . . . .	1
3.2	Contract Maintenance Term . . . . .	2
4.	THE OPERATION AND MAINTENANCE MANUAL	
4.1	Manual Content . . . . .	2
4.2	Flexibility of the Manual and the Addition of Information . . . . .	2
5.	PROGRAMS	
5.1	Questions and Technical Advice . . . . .	2

SECTION B OPERATION AND MAINTENANCE INSTRUCTIONS

1.	GENERAL	
1.1	Scope of Section B . . . . .	3
1.2	Maintenance Requirement . . . . .	3
1.3	Municipal Controls . . . . .	4

TABLE OF CONTENTS


	<u>Page No.</u>
1.3.1	Excavations Adjacent to Flood Control Works . . . . . 4
1.3.2	Access for Maintenance . . . . . 4
1.3.3	Review of Proposals for Works in the Vicinity of Flood Control Works . . . . . 4
1.3.4	Municipal Regulations . . . . . 4
1.3.5	Engineering Evaluation for New Works . . . . . 4
2.	EMERGENCY REPAIR WORK
2.1	Men and Equipment . . . . . 5
2.2	Freshet Emergency Procedures . . . . . 5
2.2.1	Emergency Work . . . . . 5
2.2.2	Engineering and Soils Consultant Advice . . . . . 5
2.3	Danger of Dams Overtopping . . . . . 5
2.4	Records . . . . . 5
3.	DAMS
3.1	Basis of Dam Repairs . . . . . 6
3.2	Inspections . . . . . 6
3.2.1	Routine Annual Inspections . . . . . 6
3.2.2	Debris and Garbage . . . . . 6
3.2.3	Patrol Observations and Reports . . . . . 6
3.2.4	Field Inspection Log . . . . . 6
3.3	Maintenance of Dam Structures . . . . . 7
3.4	Maintenance of Channels . . . . . 7

LIST OF APPENDICES

DISTRICT OF SURREY FLOOD CONTROL PROJECT

		<u>Page No.</u>
APPENDIX 1	List of Government Agencies, Consulting Engineers and Contractors	8
APPENDIX 2	List of Agencies that might be concerned about the Dams	9
APPENDIX 3	As-Constructed Drawings	11
APPENDIX 4	Sample Log of Dam Inspections	13
APPENDIX 5	Proposed Modifications to Local Regulations to Control Work on or about the Flood Control Works	14
APPENDIX 6	Dyke Maintenance Act	15

KEY PLAN

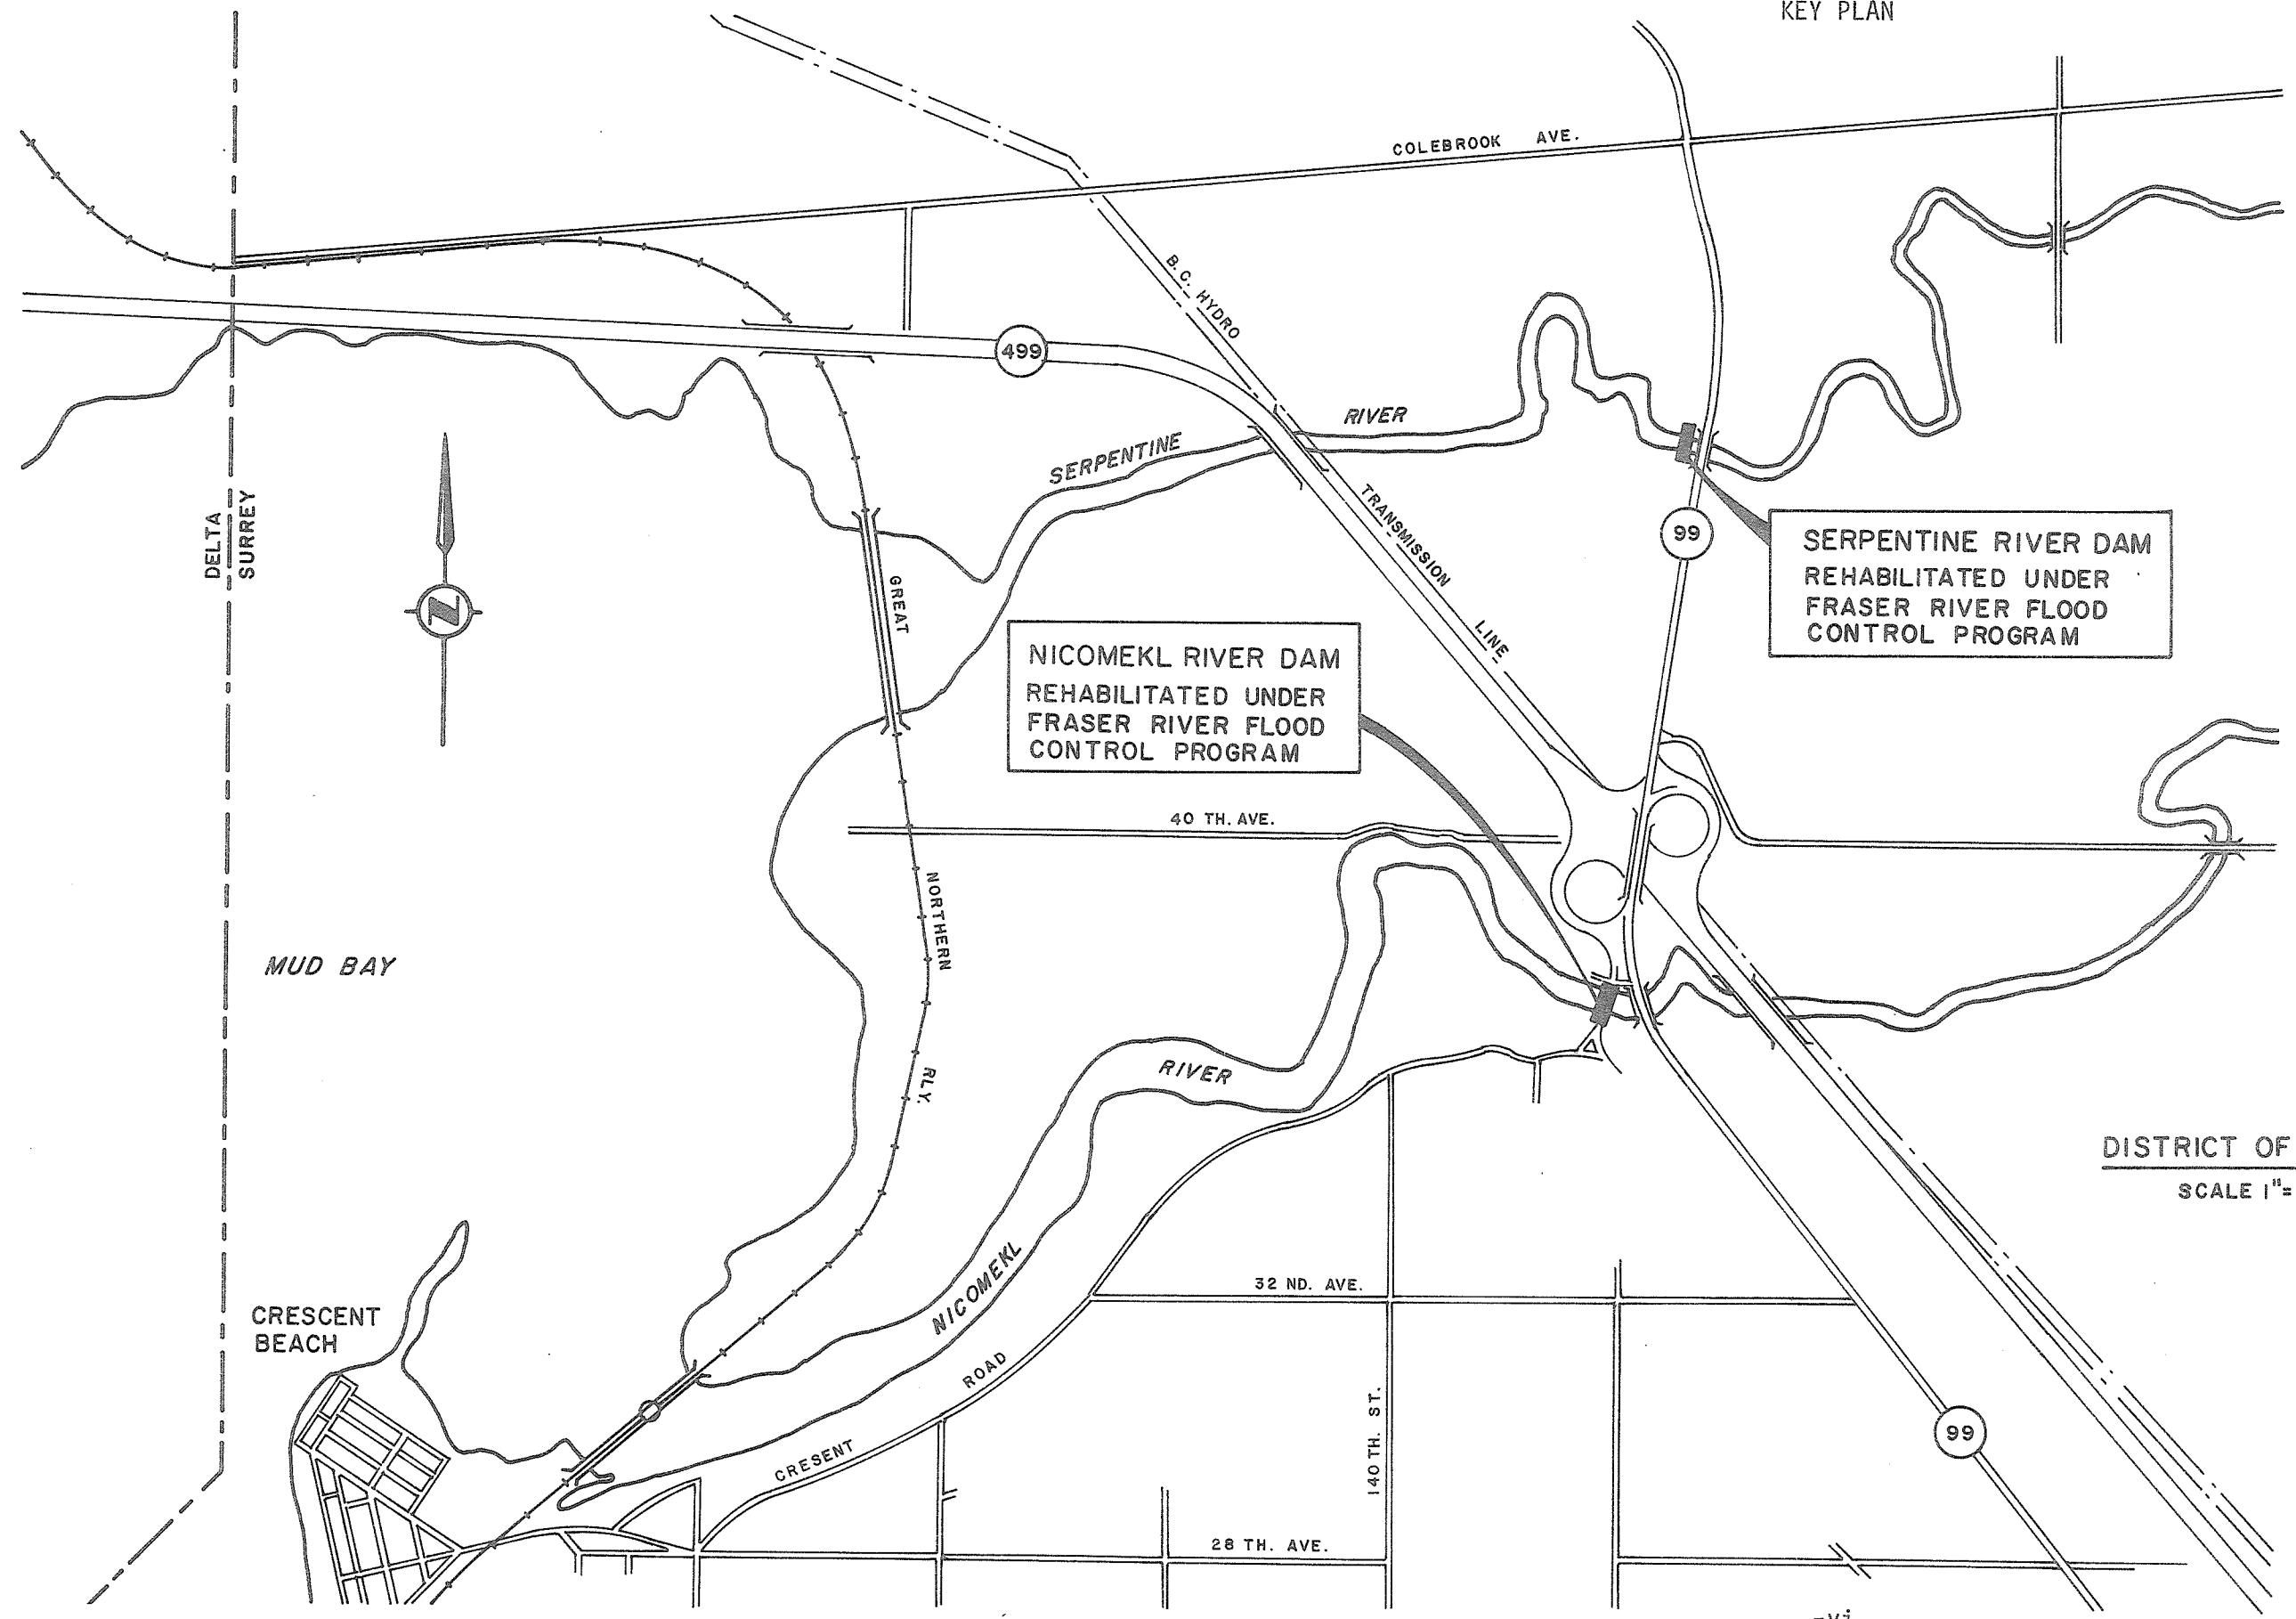

DISTRICT OF SURREY  
SCALE 1" = 1000'

# INTRODUCTION

---

1. THE PROGRAM

1.1 THE FRASER RIVER FLOOD CONTROL 1968 AGREEMENT

Canada and the Province of British Columbia signed an agreement on May 24, 1968, providing for construction of flood control works in the lower Fraser Valley. The Agreement carried out jointly by the two senior governments, provides for a comprehensive flood control program for the area and includes rehabilitation of existing dykes, increased river bank protection, and improvement of internal drainage facilities.

2. THE PROJECT

2.1 THE DISTRICT OF SURREY PROJECT

At the District of Surrey, work under the Fraser River Flood Control Program included repairs to the Serpentine and Nicomekl dams including the provision of stoplog guides. The construction costs amounted to \$1,175,955.66 and the supervision costs amounted to \$79,539.20 for a total contract cost of \$1,255,494.86.

2.2 PROJECT CONSTRUCTION PERIOD

At the District of Surrey, construction commenced in December 1973 and was substantially completed in November 1974.

3. RESPONSIBILITY FOR MAINTENANCE

3.1 RESPONSIBILITY FOR PROJECT MAINTENANCE

Under the Fraser River Flood Control 1968 Agreement, the District of Surrey undertook to operate and maintain the completed structures. This manual has been prepared with this maintenance in mind.

Under the Dyke Maintenance Act (Appendix 6), it is the responsibility of the Inspector of Dykes to ensure that the integrity of the dyking system is maintained. It is the intention that the Inspector of Dykes will conduct regular inspections.

### 3.2 CONTRACT MAINTENANCE TERM

Under the contract maintenance guarantee, the Contractor is responsible to maintain the new works for a period of twelve months following completion of the contract, against any defects arising from improper installation, inferior material, or faulty workmanship.

## 4. THE OPERATION AND MAINTENANCE MANUAL

### 4.1 MANUAL CONTENT

Operation and maintenance instructions provided in these instructions are for facilities which were improved under the Program. Special instructions are not provided for existing facilities which were not improved under the Program, except where their maintenance or operation is critical to the integrity of the structures.

These instructions provide general and detailed information on the operation and maintenance of the Serpentine and Nicomekl dams. Included are the as-constructed drawings. Additional information can be found in the Contract Specifications issued to the Municipality during construction.

### 4.2 FLEXIBILITY OF THE MANUAL AND THE ADDITION OF INFORMATION

This manual should be the working document wherein additional information gained by the experience of the operators and changing conditions in the Municipality should be appended for the benefit of future operators. The Province may issue addenda or amendments to this document from time to time.

## 5. PROBLEMS

### 5.1 QUESTIONS AND TECHNICAL ADVICE

Dyking personnel should familiarize themselves with all the flood control works especially the critical areas so that they have a working knowledge of the works. Questions regarding the system should be directed to the Inspector of Dykes.



# **OPERATING AND MAINTENANCE INSTRUCTIONS**

---

SECTION B  
OPERATION AND MAINTENANCE INSTRUCTIONS

1. GENERAL

1.1 SCOPE OF SECTION B

1.1.1 This section contains instructions, methods, techniques and data pertinent to the operation and maintenance of the District of Surrey flood control works, which are the basis of the design of works constructed under the Fraser River Flood Control 1968 Agreement.

1.2 MAINTENANCE REQUIREMENT

1.2.1 Regular inspection and maintenance of flood protection works is necessary to maintain the integrity of this flood protection system.

1.2.2 Instructions are provided for the guidance and training of operating staff and for reference information on general procedures and precautions concerning the maintenance of the flood protection system.

1.2.3 Maintenance will generally comprise the following:

- 1) inspection of all works each fall, spring, and during the freshet
- 2) repair of filter blanket
- 3) excavation and backfill of all animal holes
- 4) replacement of anodes
- 5) repainting of flood gates and metal surfaces
- 6) reseeding of slopes as required
- 7) removal of debris and garbage from all flood control works
- 8) inspection of structures constructed in and about the dam to verify that the standard of flood protection has not been reduced.

1.2.4 Maintenance will include the control of development and construction on, through or in the vicinity of flood control works, to ensure that the standard of protection provided by the reconstruction under the Federal Provincial Fraser River Flood Control 1968 Agreement Program is maintained.

### 1.3 MUNICIPAL CONTROLS

The Municipality should ensure that construction on through or in the vicinity of the flood control works does not reduce the standard of flood protection provided by the reconstruction under the Federal Provincial Fraser River Flood Control 1968 Agreement Program.

#### 1.3.1 Excavations Adjacent to Flood Control Works

Excavation adjacent and very close to the flood protection structures should be discouraged, but where excavation is necessary, expert advice should be obtained to ensure that the excavation is compatible with stability of the flood protection works.

#### 1.3.2 Access for Maintenance

Access to the dam crest, slopes and adjacent banks shall be maintained to permit inspection and repair of the dams and adjacent flood protection works.

#### 1.3.3 Review of Proposals for Works in the Vicinity of Flood Control Works

Any work or works proposed on or in the immediate vicinity of flood control works should be reviewed by the Municipality, the Inspector of Dykes, and other affected regulatory agencies before work is approved to proceed.

#### 1.3.4 Municipal Regulations

A Municipal by-law and regulations may be required to regulate work on, through or in the vicinity of the flood protection works.

#### 1.3.5 Engineering Evaluation for New Works

Where work or a new structure is proposed on or adjacent to flood control works and the stability of the works under the new conditions is suspect, an engineering evaluation should be made before work is approved to proceed.

## 2. EMERGENCY REPAIR WORK

### 2.1 MEN AND EQUIPMENT

2.1.1 The Municipality should store sufficient materials and maintain equipment adequate to cope with normal emergency operations. As the river rises to critical levels, crews should be advised that they may be called upon, at short notice, to cope with emergencies related to their flood protection works.

2.1.2 Should the Provincial Government mobilize the Lower Fraser Valley Flood Organization and declare an emergency then the municipal forces would be integrated into this organization.

### 2.2 FRESHET EMERGENCY PROCEDURES

#### 2.2.1 Emergency Work

Municipal work crews should be equipped and on short notice call to cope with emergencies.

#### 2.2.2 Engineering and Soils Consultant Advice

Engineering and soils consultant advice should be obtained to recommend permanent corrective action following emergency situations. The Engineer and soils consultant should be advised promptly of such emergencies so that the area may be inspected under critical conditions.

### 2.3 DANGER OF DAMS OVERTOPPING

The overtopping of dams should be an infrequent danger since the dams have been rehabilitated. In the event that such a danger does occur, it is probable that the Province will assist the Municipality in any emergency action.

### 2.4 RECORDS

Cases of severe damage should be recorded, where possible, for the benefit of future maintenance. Photographs with locations and dates should be obtained before repairs are affected, but this should not in any way interfere or prejudice emergency work.

### 3. DAMS

#### 3.1 BASIS OF DAM REPAIRS

3.1.1 The dams were upgraded to increase the useful life expectancy of the structures to a minimum of 25 years and to increase the factor of safety relative to sliding.

3.1.2 The roadway on the existing structures was raised to provide a minimum 2-foot freeboard above design water level.

#### 3.2 INSPECTIONS

##### 3.2.1 Routine Annual Inspections

As a matter of routine the entire dam should be inspected annually.

##### 3.2.2 Debris and Garbage

The dams and channels should be cleared of all debris and garbage.

##### 3.2.3 Patrol Observations and Reports

Municipal patrols should observe and report to their local control headquarters any occurrences that could signal a weakening of the works. Points to look for include:

- 1) damage to the concrete and gunite surfaces;
- 2) cracking or spalling of concrete and opening of contraction joints;
- 3) damage to the gates - in particular the neoprene seals, urethane bushings and anodes;
- 4) damage or loss of filter material upstream of the dams;
- 5) unusual or inadequate operation behavior.

##### 3.2.4 Field Inspection Log

A log as illustrated in Appendix 4 should be kept of all inspections, and should include the following data:

- 1) date and time of inspection;

- 2) condition of gunite surfaces;
- 3) areas of piping downstream of the dams;
- 4) problems experienced with the gates;
- 5) condition of painted surfaces;
- 6) extent of anode deterioration.

### 3.3 MAINTENANCE OF DAM STRUCTURES

Since all structures and facilities are subject to deterioration in varying degree, constant vigilance is necessary to be alert to and correct potential unsafe or unsatisfactory conditions as they develop.

Concrete repairs are required where unforeseen conditions may have developed to cause damage. Where the erosion and other damage is extensive and where much of the remaining concrete is suitable for continued service, shotcrete may be used in the maintenance and repair of the eroded concrete.

Metal surfaces require painting from time to time for protection against corrosion. Submerged metalwork is subject to electrolytic deterioration. To reduce the corrosion or oxidation on the submerged metal gates, zinc plates were placed on the face of the gates. The resulting electrolytic action on the zinc necessitates replacement of these anodes every 4 or 5 years. The maintenance of these facilities is principally one of inspecting. The anodes are dissipated on a generally straight-line basis and records are needed to predict when replacement will be required.

### 3.4 MAINTENANCE OF CHANNELS

To control seepage and eliminate piping below the dams, the inlet channels in the vicinity of the structures were lined with a 4-foot thick gravel filter layer. Maintenance should consist of inspecting the filter layer and replacing any deficiency of filter material.

Scour protection blankets, consisting of a 2-foot thick gravel filter layer overlain by a 2-foot thick layer of 6 to 9 inches of cobbles, were placed on the river bottom on the downstream side of the dams. The scour protection blanket should require little or no maintenance.

# APPENDICES

---

## DISTRICT OF SURREY FLOOD CONTROL PROJECT

LIST OF GOVERNMENT AGENCIES, CONSULTING ENGINEERS  
CONTRACTORS, MANUFACTURERS AND SUPPLIERS FOR THE PROJECT

AGENCY	RESPONSIBILITIES
Office of the Director Inventory and Engineering Branch Ministry of Environment Parliament Buildings Victoria, British Columbia	Coordination and execution of the Project, designers for river bank protection, direction of the construction, and 50% funding of the project.
Water Planning and Management Branch Inland Waters Directorate Pacific and Yukon Region Fisheries and Environment Canada Room 502 - 1001 W. Pender Street Vancouver, B. C., V6E 2M9	Establishment of dyke design grades, and 50% funding of the project.
CONSULTING ENGINEERS	RESPONSIBILITIES
Associated Engineering Services Ltd. 1661 West 8th Avenue Vancouver, B. C. V6J 1V1	Consultants for the dams.
Golder Associates Consulting Geotechnical Engineers 224 West 8th Avenue Vancouver, B. C. V5Y 1N5	Soils consultants to Associated Engineering Services Limited.
CONTRACTOR	RESPONSIBILITIES
Pine Tree Construction Co. Ltd. 18557 - 96th Avenue Surrey, B. C.	General contractor for the repair of the dams.
Brittain Steel Ltd. 400 Ewen Avenue New Westminster, B. C.	Contractor for supply and installation of flood gates.
Caproco Corrosion Prevention Ltd. 12188 - 86A Avenue Surrey, B. C.	Contractor for supply and installation of cathodic protection on flood gates.



## DISTRICT OF SURREY FLOOD CONTROL PROJECT

LIST OF AGENCIES THAT MIGHT BE  
CONCERNED ABOUT THE STRUCTURES

AGENCY	INTEREST
District of Surrey Surrey, B. C.	Safety of the dams.
Inspector of Dykes	Safety of the dams.
Office of the Director Inventory and Engineering Branch Ministry of Environment Parliament Buildings Victoria, B. C. V8V 1X4	Safety of the dams.
Water Planning and Management Branch Inland Waters Directorate Pacific and Yukon Region Fisheries and Environment Canada Room 502 - 1001 W. Pender Street Vancouver, B. C. V6E 2M9	Safety of the dams.
Regional Manager Aids and Waterways Transport Canada Canadian Coast Guard Box 10060, Pacific Centre 700 West Georgia Street Vancouver, B. C. V7Y 1E1	Navigable Waters - Responsible for administration of the Federal Navigable Waters Protection Act with respect to navigable waters of the Province of British Columbia.
Public Works Canada Manager, Design and Construction 1110 West Georgia Street Vancouver, B. C. V6E 3W5	For consideration of work proposed within the wetted perimeter of a navigable water.
Ministry of Agriculture and Food Parliament Buildings Victoria, B. C.	Flood protection of agricultural lands.

AGENCY	INTEREST
Habitat Protection Division Fisheries and Oceans Canada 1090 West Pender Street Vancouver, B. C. V6E 2P1	Environmental. Recreation and commercial fisheries protection and propogation.
Canadian Wildlife Service Vivarium University of British Columbia Vancouver, B. C. V6T 1W5	Environmental. Recreational wildlife protection and propogation.
Parks and Outdoor Recreation Division Ministry of Lands, Parks and Housing Victoria, B. C.	Environmental. Recreation and land use.
Greater Vancouver Water District 2294 West 10th Avenue Vancouver, B. C.	Watermain crossing the dams.
B.C. Hydro and Power Authority 970 Burrard Street Vancouver, B. C. V6Z 1Y3	Hydro and gas works and structures in or on the dams.
B.C. Telephone Company 768 Seymour Street Vancouver, B. C. V6B 3K9	Telephone communication works and structures in or on the dams.
B.C. Land Commission 4333 Ledger Avenue Burnaby, B. C. V5G 3T3	Establishment of statutory Agricultural Reserves.

# **DRAWINGS**

---

DISTRICT OF SURREY FLOOD CONTROL PROJECT  
AS-CONSTRUCTED DRAWINGS

<u>DRAWING NUMBER</u>	<u>DRAWING TITLE</u>	<u>PROVINCIAL 105 mm NEGATIVE NUMBER</u>
<u>CONTRACT NO. 1</u>	REPAIRS TO THE SERPENTINE AND NICOMEKL DAMS	105325
4884-1-1	Nicomekl and Serpentine Dams, Key Plan	105326
4884-1-2	Nicomekl Dam, Site Plan	105327
4884-1-3	Serpentine Dam, Site Plan	105328
4884-1-4	Nicomekl Dam, River Road Cross Sections	105329
4884-1-5	Serpentine Dam, River Road Cross Sections	105330
4884-1-6	Nicomekl and Serpentine Dams, Filter and Scour Protection Profiles, Road Cross Section	105331
4884-1-7	Nicomekl Dam, General Arrangement, Plan and Sections	105332
4884-1-8	Nicomekl and Serpentine Dams, Roadway Cross Sections, Concrete	105333
4884-1-9	Nicomekl and Serpentine Dams, Roadway Cross Sections, Reinforcement	105334
4884-1-10	Nicomekl Dam, Gate Collar, Elevation and Sections, Concrete	105335
4884-1-11	Nicomekl and Serpentine Dams, Gate Collar, Sections and Details, Concrete	105336
4884-1-12	Nicomekl Dam, Gate Collar, Elevation and Section Reinforcement	105337
4884-1-13	Nicomekl and Serpentine Dams, Gate Collar, Sections and Details, Reinforcement	105338

## APPENDIX 3, cont'd.

<u>DRAWING NUMBER</u>	<u>DRAWING TITLE</u>	<u>PROVINCIAL 105 mm NEGATIVE NUMBER</u>
4884-1-14	Serpentine Dam, General Arrangement, Plan and Sections	105339
4884-1-15	Serpentine Dam, Gate Collar, Elevation and Section, Concrete	105340
4884-1-16	Serpentine Dam, Gate Collar, Elevation and Section, Reinforcement	105341
4884-1-17	Nicomekl and Serpentine Dams, Gate and Hinge, Elevation and Section, Structural Steel-Sheet No. 1	105342
4884-1-18	Nicomekl and Serpentine Dams, Gate Hinge Details, Structural Steel-Sheet No. 2	105343
4884-1-19	Nicomekl Dam, Stoplog Guides, Elevation and Section, Concrete	105344
4884-1-20	Nicomekl and Serpentine Dams, Stoplog Guides, Sections and Details, Concrete	105345
4884-1-21	Nicomekl Dam, Stoplog Guides, Elevation and Section, Reinforcement	105346
4884-1-22	Nicomekl and Serpentine Dams, Stoplog Guides, Sections and Details, Reinforcement	105347
4884-1-23	Serpentine Dams, Stoplog Guides, Elevation and Sections, Concrete	105348
4884-1-24	Serpentine Dam, Stoplog Guides, Elevation and Section, Reinforcement	105349

**CANADA · BRITISH COLUMBIA**

**FRASER RIVER FLOOD CONTROL 1968 AGREEMENT  
PROJECT NO: 10-1 DISTRICT OF SURREY**



**CONTRACT NO: 1 REPAIRS TO THE SERPENTINE  
AND NICOMEKL DAMS**

**AESL**

Consulting Engineers

ASSOCIATED ENGINEERING SERVICES LTD.

VANCOUVER B. C.

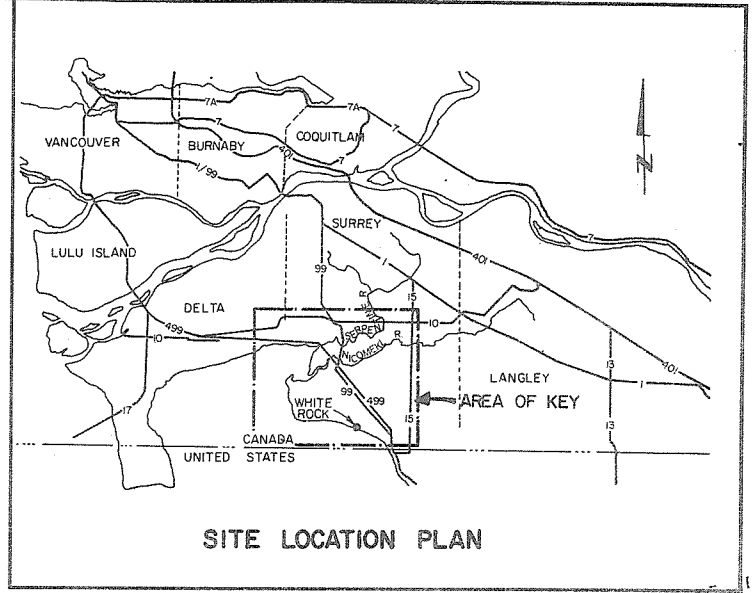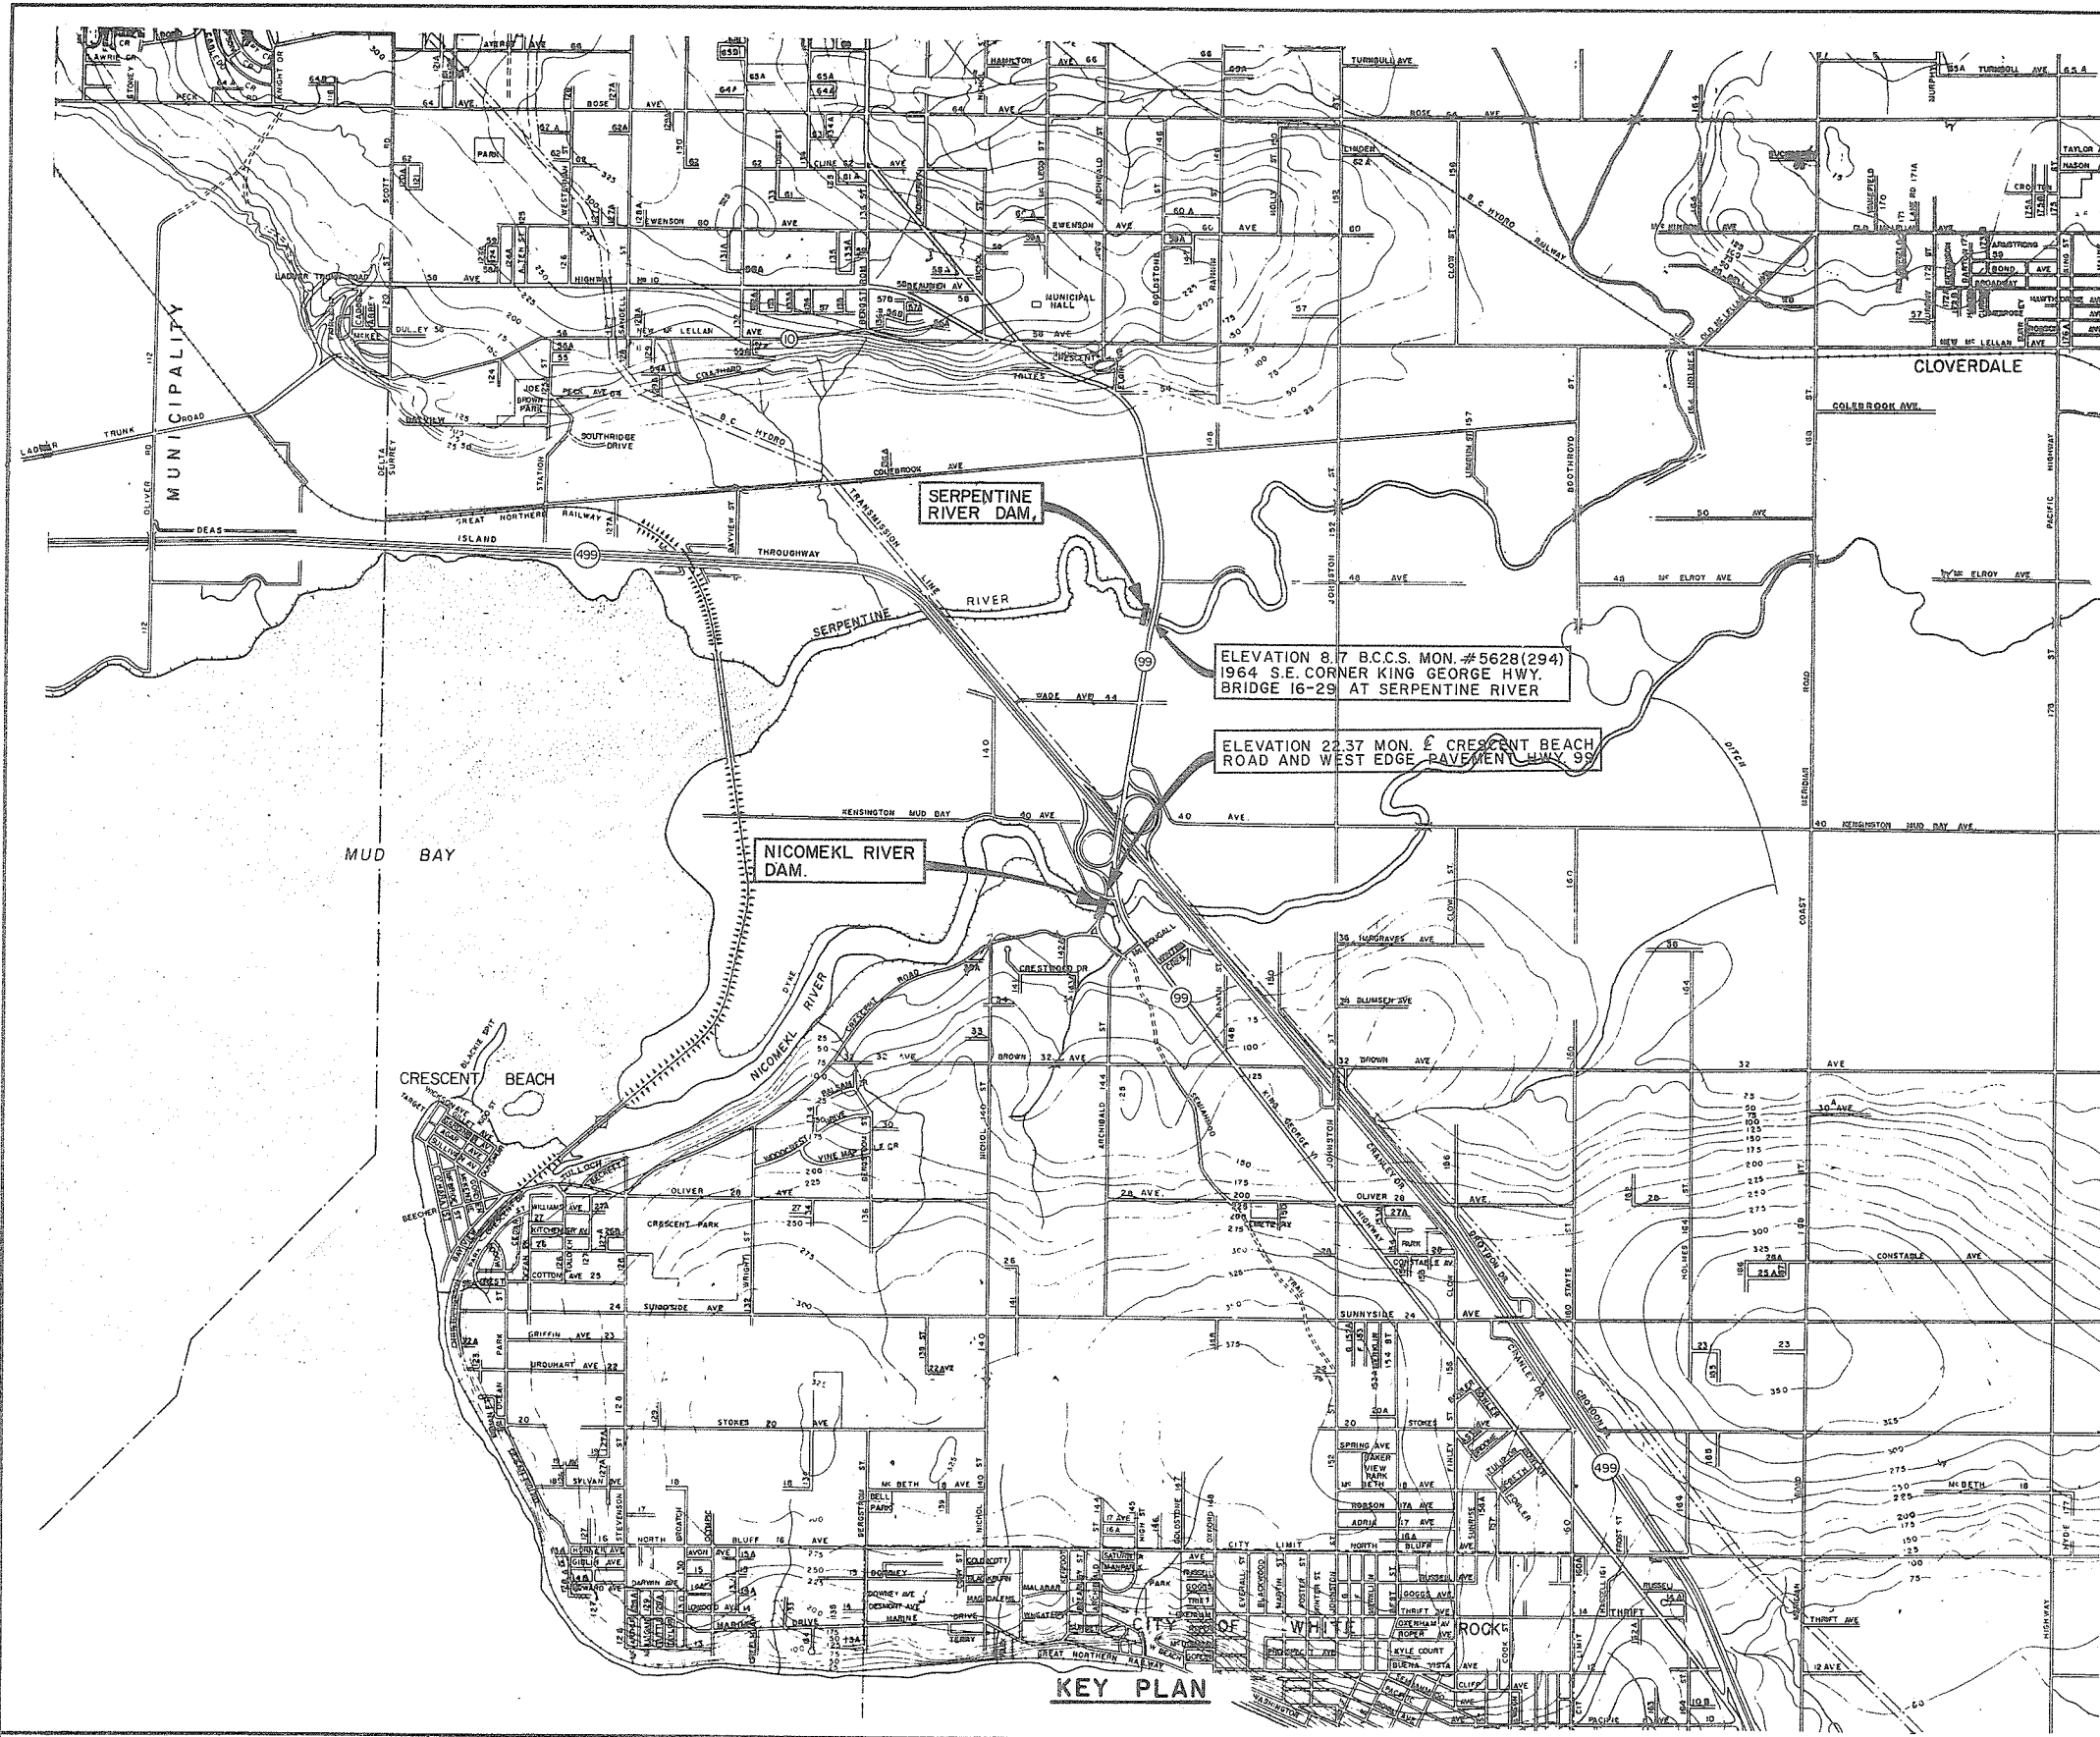

ELEVATION 8.7 B.C.C.S. MON. #5628(294)  
1964 S.E. CORNER KING GEORGE HWY.  
BRIDGE 16-29 AT SERPENTINE RIVER

ELEVATION 22.37 MON. # CRESCENT BEACH  
ROAD AND WEST EDGE PAVEMENT HWY 99

**AS CONSTRUCTED NOTES**

1. THE NOTATION 'EXISTING' REFERS TO STRUCTURES, GRADES AND PROFILES PRIOR TO CONSTRUCTION.
2. THE CONTRACT COMPLETION DATE WAS NOVEMBER 22, 1974.

NOTE: ELEVATIONS ARE TO GEODETIC SURVEY OF CANADA.

**KEY PLAN**

NO.	DATE	BY	REVISIONS
1	16.6.75	W.A.	AS CONSTRUCTED

PROJECT NO. 10-1	CONTRACT NO. 1	A.E.S.L. DRAWING NO. 4064-07-101
THE GOVERNMENT OF THE PROVINCE OF BRITISH COLUMBIA DEPT. OF LANDS, FORESTS AND WATER RESOURCES WATER RESOURCES SERVICE		AESL ASSOCIATED ENGINEERING SERVICES LTD. VANCOUVER, B.C.
CANADA - BRITISH COLUMBIA FRASER RIVER FLOOD CONTROL 1922 AGREEMENT DISTRICT OF SURREY		DESIGN: [Signature] SCALE: 1"=1000'
TITLE: NICOMEKL AND SERPENTINE DAMS KEY PLAN		DATE: AUGUST, 1972 APPROVED: [Signature]
DRAWN: [Signature] CHECKED: [Signature]		DRAWING NO. 4884-1-1 REV. 1



SUPERSEDES ALL PREVIOUS PRINTS WITH A NUMBER LOWER THAN

TEST HOLE NO. 101 LOG		TEST HOLE NO. 2 LOG		TEST HOLE NO. 102 LOG	
ELEV.	SYMBOL	ELEV.	SYMBOL	ELEV.	SYMBOL
-9.0		10.0			
-9.5		5.0			
-11.0					
-13.5					
-16.5					
-18.5					
-30.5					
		-14.8		-14.0	
		-17.2		-20.0	
		-18.0		-29.5	
		-19.0			
		-33.5			

GREY VERY FINE SANDY SILT.  
 LOOSE BLACK ORGANIC SILT AND SHELLS.  
 LOOSE GREY CLAYEY SILT WITH TRACE MED. SAND AND SHELLS.  
 COMPACT GREY VARVED SILTY CLAY.  
 DENSE GREY SILTY FINE SAND TRACE GRAVEL.  
 VERY DENSE GREY FINE SILTY SAND TILL.

FILL-SAND AND GRAVEL WITH CLAY ZONES.  
 CONCRETE - 2/3 GOOD CONDITION 1/3 BROKEN CONCRETE LACKING IN CEMENT BINDER 90% RECOVERY, LOSS OF WATER BELOW 16' DEPTH.  
 VOID.  
 CLAYEY SAND AND GRAVEL.  
 BENTONITE.  
 HARD TO VERY HARD LAYERS OF SANDY SILT, SILTY SAND AND CLAYEY SILT WITH OCCASSIONAL PEBBLES AND COBBLES.

3" ORGANIC SILT COMPACT GREY CLAYEY SILT WITH SOME VERY FINE SAND AND SAND PARTINGS.  
 VERY DENSE GREY FINE SILTY SAND TILL SOME GRAVEL.

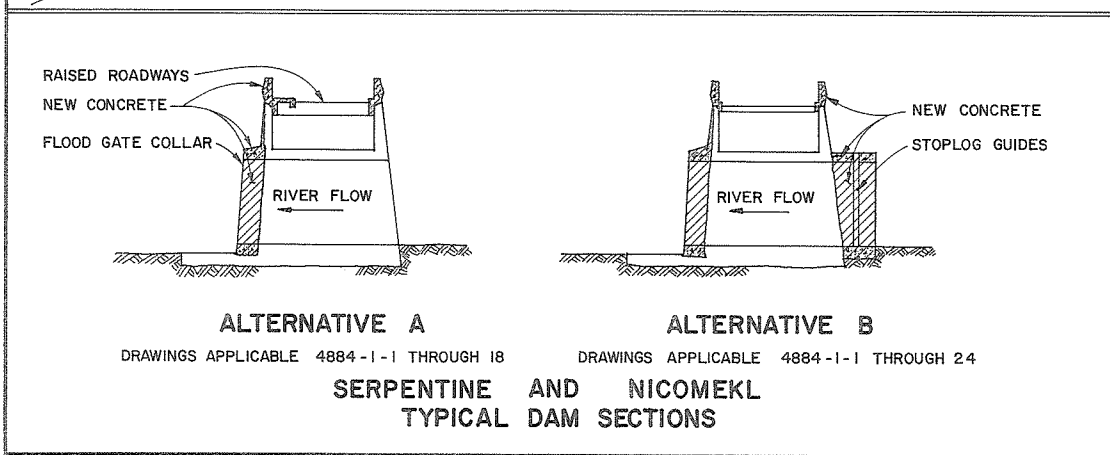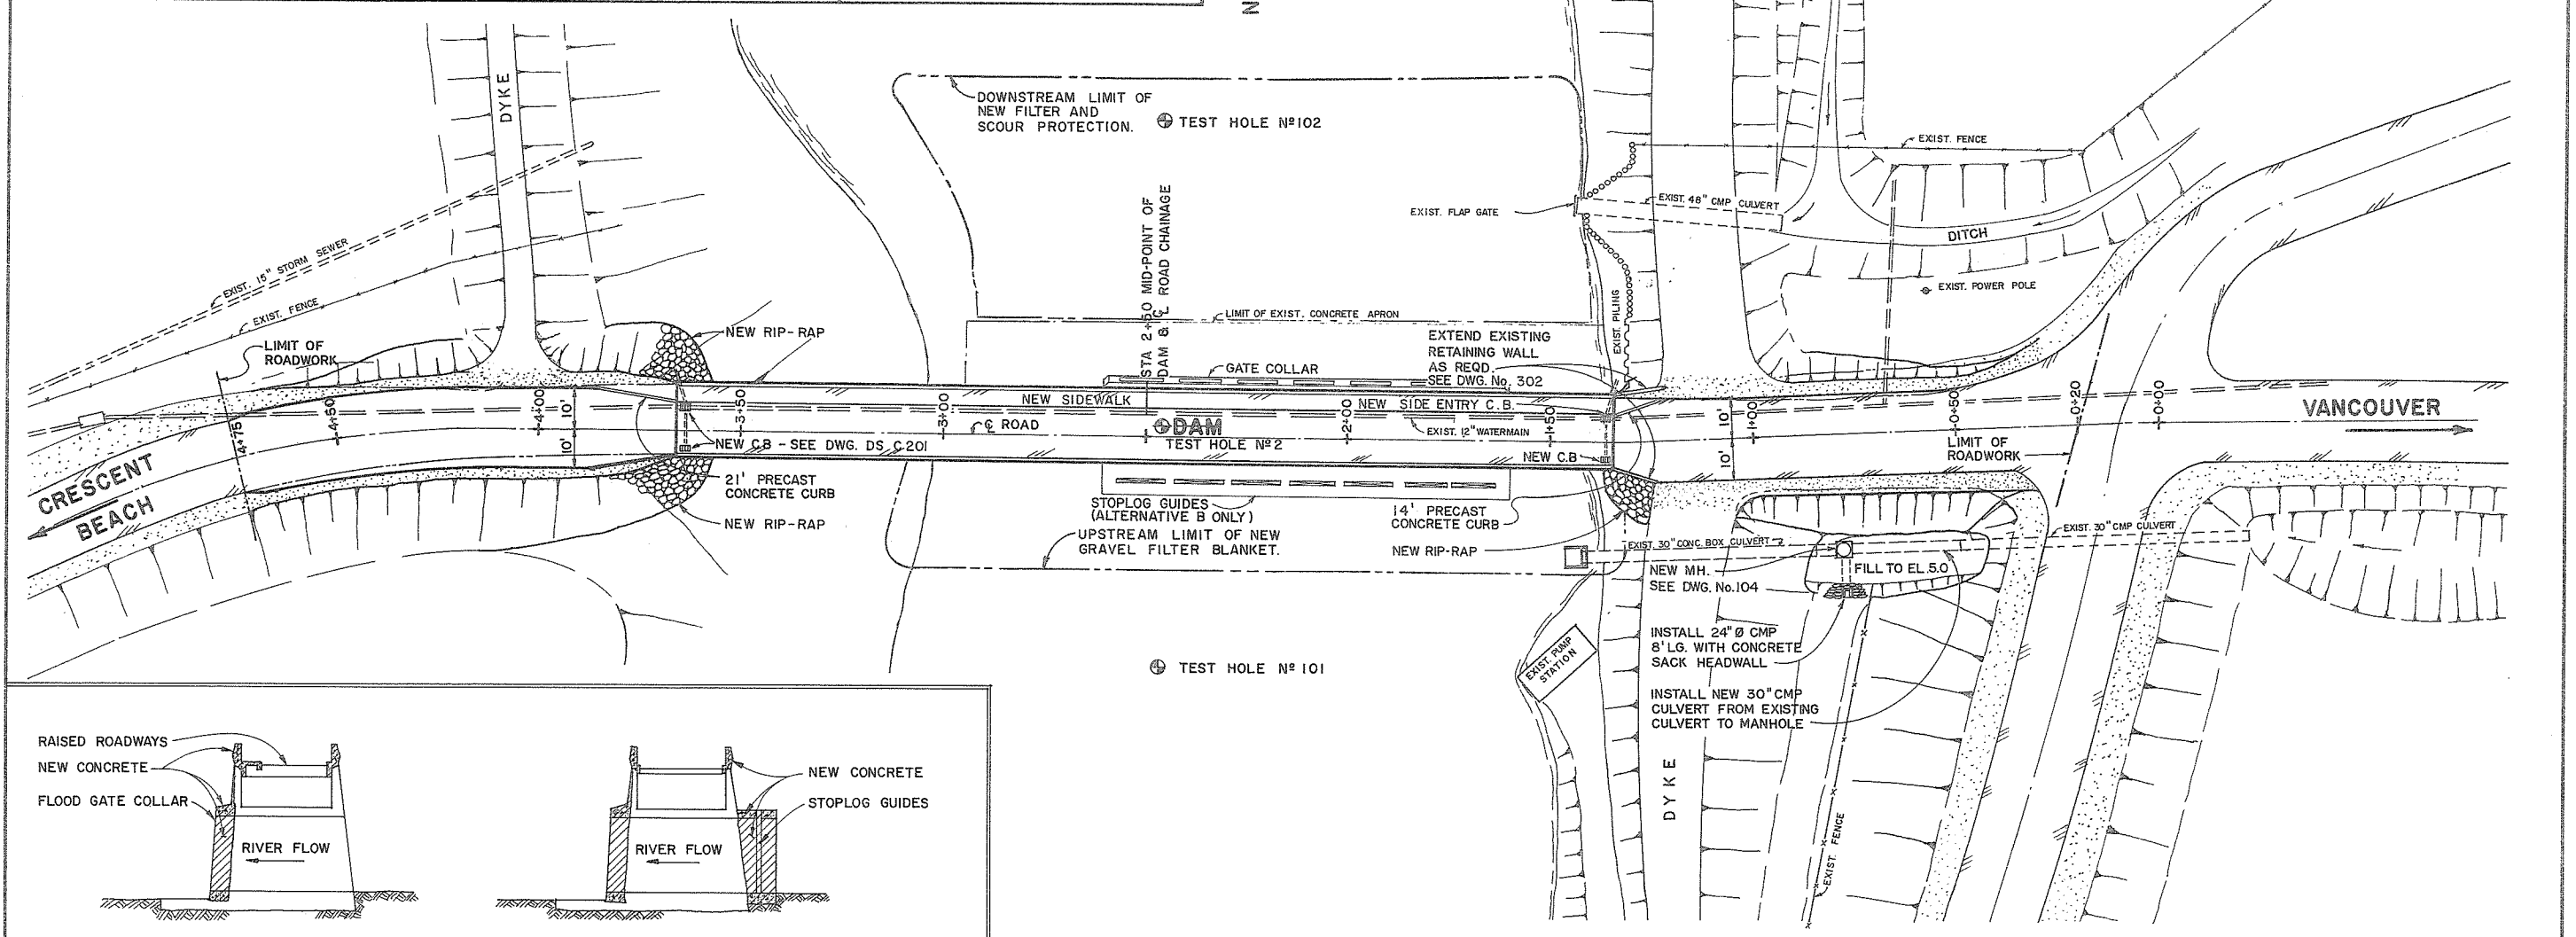


ALTERNATIVE A DRAWINGS APPLICABLE 4884-1-1 THROUGH 18  
 ALTERNATIVE B DRAWINGS APPLICABLE 4884-1-1 THROUGH 24  
**SERPENTINE AND NICOMEKL TYPICAL DAM SECTIONS**

NOTE:  
 1. FOR RIVER AND ROAD CROSS SECTIONS AND PROFILES SEE DRAWINGS NO. 104 AND NO. 106.

PROJECT NO. 10-1		CONTRACT NO. 1		A.E.S.L. DRAWING NO. 4064-07-102	
THE GOVERNMENT OF THE PROVINCE OF BRITISH COLUMBIA DEPT. OF LANDS, FORESTS AND WATER RESOURCES WATER RESOURCES SERVICE				AESL ASSOCIATED ENGINEERING SERVICES LTD. VANCOUVER, B.C.	
CANADA - BRITISH COLUMBIA FRASER RIVER FLOOD CONTROL 1969 AGREEMENT DISTRICT OF SURREY				105327	
TITLE NICOMEKL DAM SITE PLAN				SCALE 1" = 20'	
DESIGN				DATE AUGUST, 1972	
DRAWN				APPROVED	
CHECKED				DRAWING NO. 4884-1-2	
REV. 1					

APPROVED FOR THE PROVINCE OF BRITISH COLUMBIA  
 APPROVED THE FRASER RIVER JOINT PROGRAM COMMITTEE  
 11 Sept 72  
 AS CONSTRUCTED  
 REVISIONS  
 NO. DATE BY ENG.



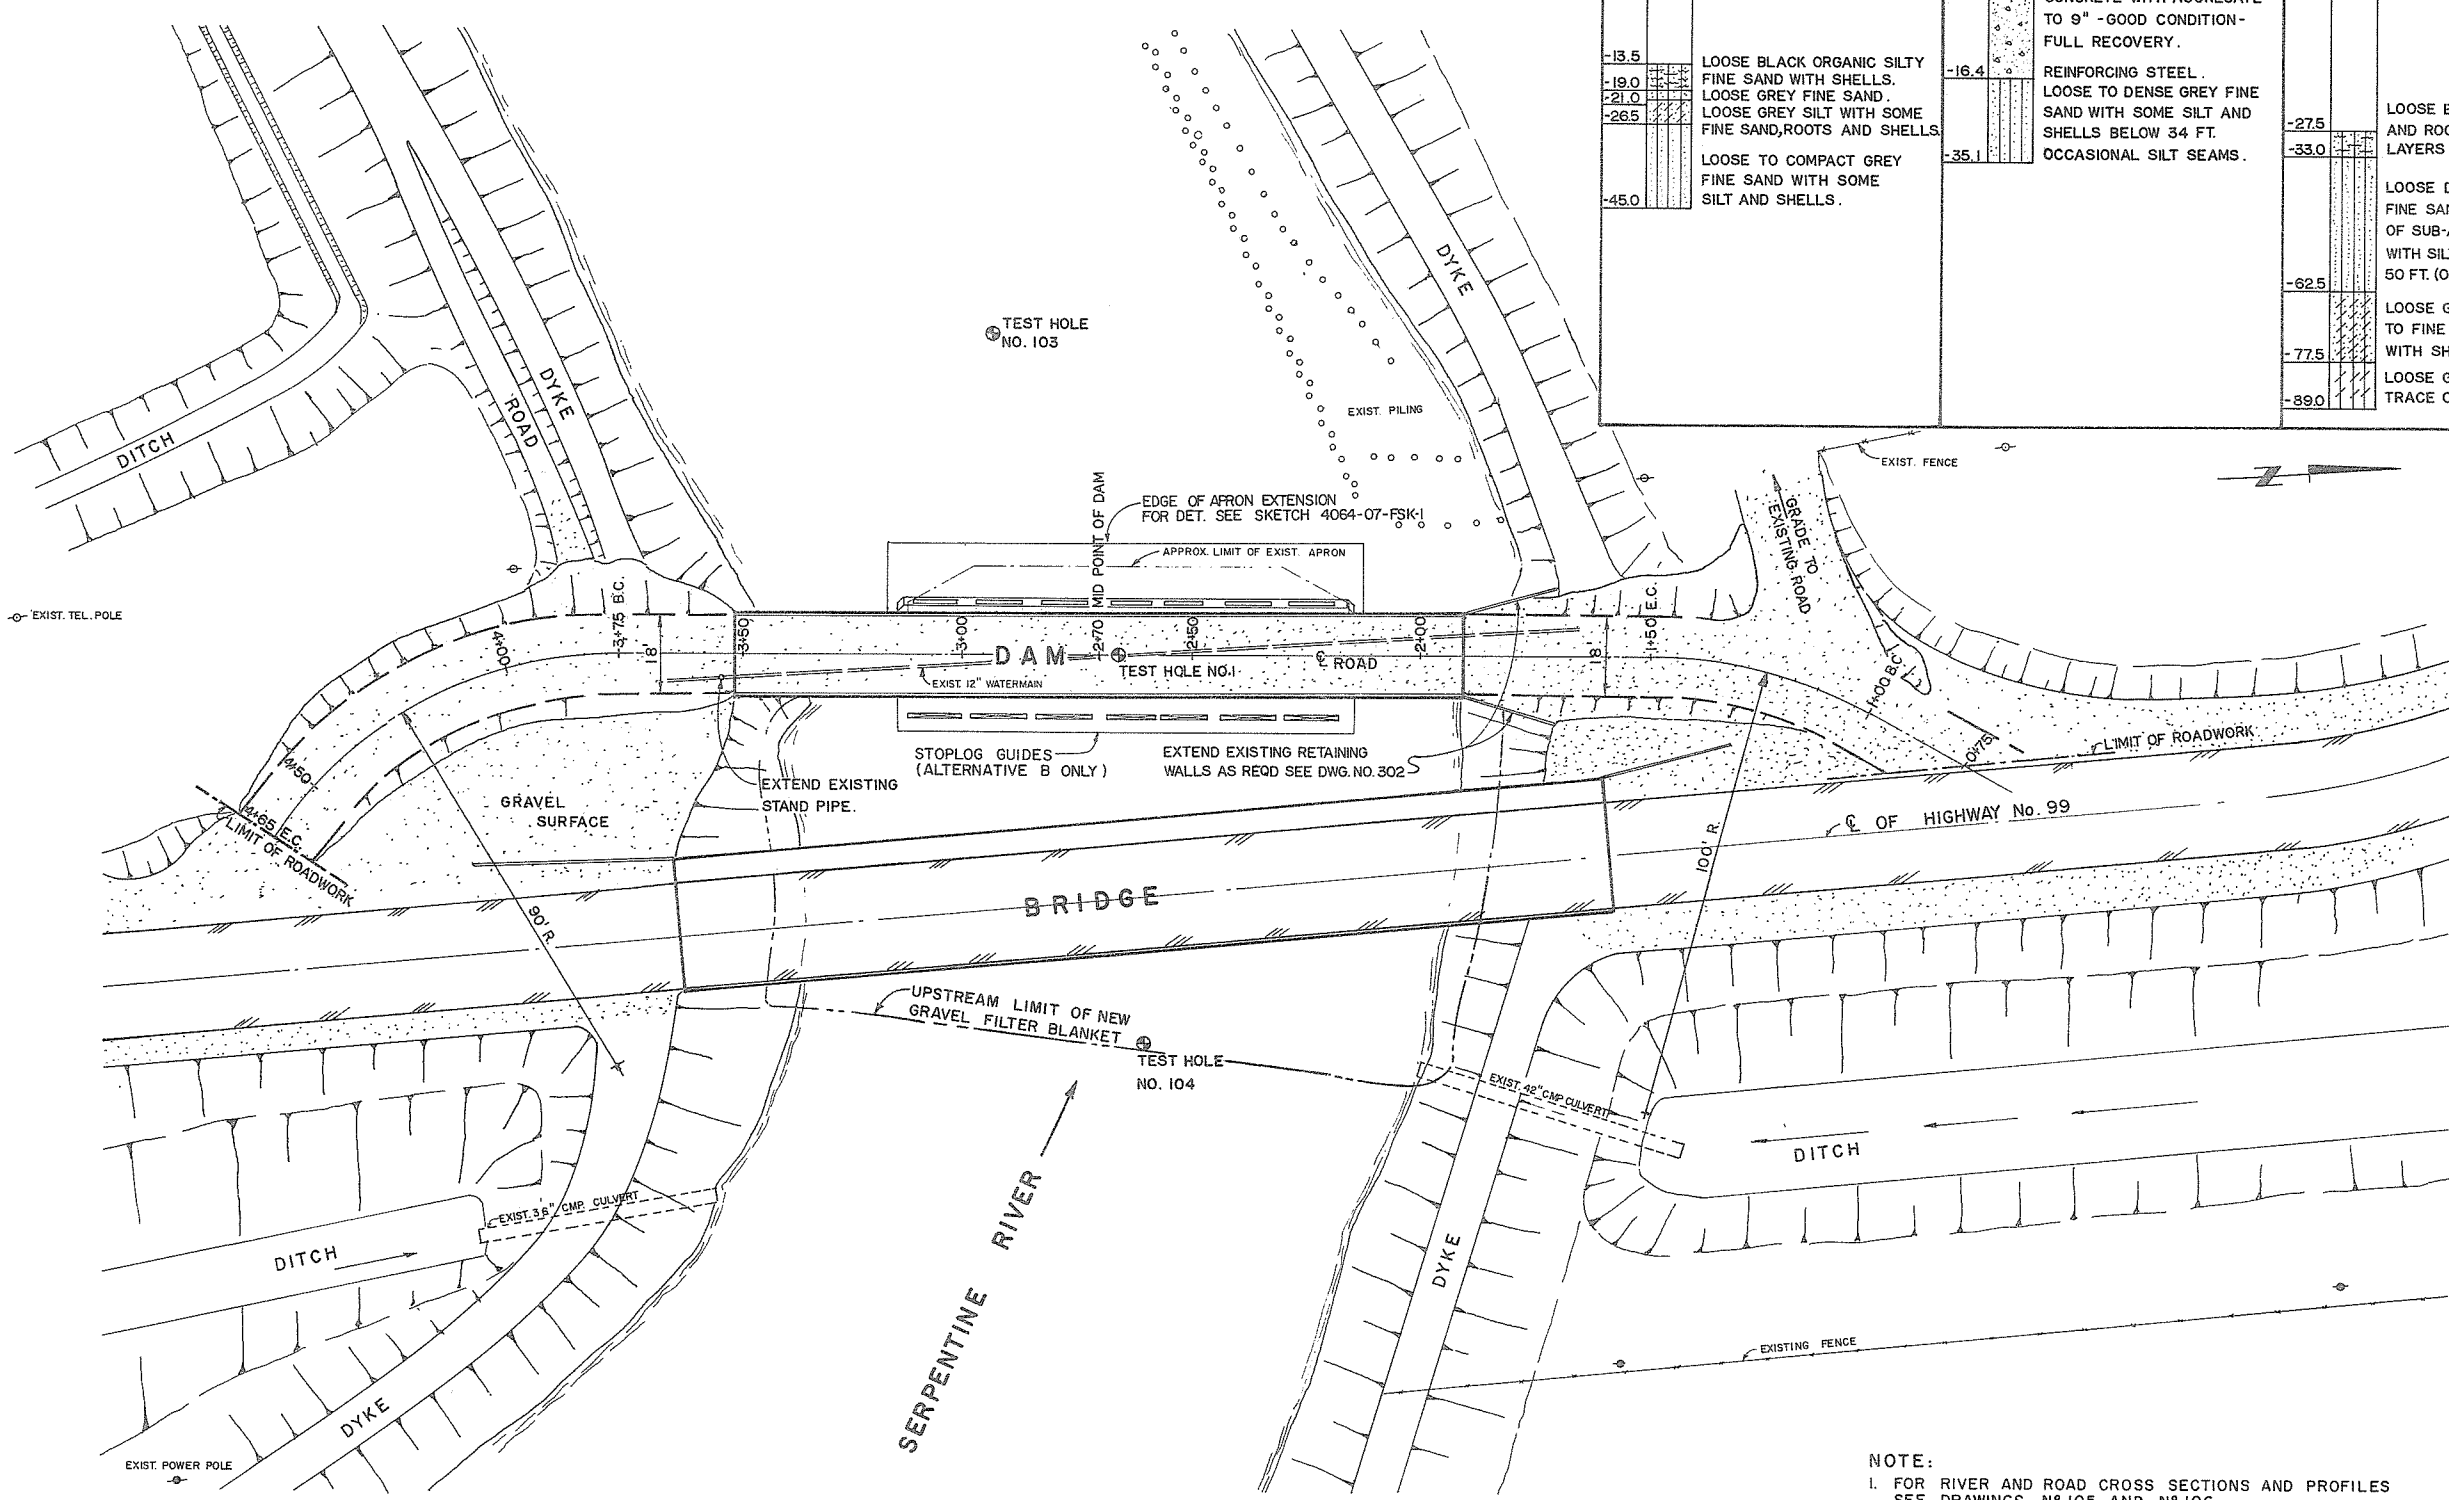

TEST HOLE NO. 104 LOG		TEST HOLE NO. 1 LOG		TEST HOLE NO. 103 LOG	
ELEV.	SYMBOL	ELEV.	SYMBOL	ELEV.	SYMBOL
-13.5		10.0			
-19.0		4.4			
-21.0					
-26.5		-16.4			
		-35.1		-27.5	
-45.0				-33.0	
				-62.5	
				-77.5	
				-89.0	

TEST HOLE NO. 104 LOG  
 LOOSE BLACK ORGANIC SILTY FINE SAND WITH SHELLS.  
 LOOSE GREY FINE SAND.  
 LOOSE GREY SILT WITH SOME FINE SAND, ROOTS AND SHELLS.  
 LOOSE TO COMPACT GREY FINE SAND WITH SOME SILT AND SHELLS.

TEST HOLE NO. 1 LOG  
 FILL - CLAY, SAND AND GRAVEL, OCCASIONAL COBBLES.  
 CONCRETE WITH AGGREGATE TO 9" - GOOD CONDITION - FULL RECOVERY.  
 REINFORCING STEEL.  
 LOOSE TO DENSE GREY FINE SAND WITH SOME SILT AND SHELLS BELOW 34 FT.  
 OCCASIONAL SILT SEAMS.

TEST HOLE NO. 103 LOG  
 LOOSE BLACK ORGANIC SILT AND ROOTS, CHIPS WITH LAYERS OF GREY FINE SAND.  
 LOOSE DARK GREY SILTY FINE SAND WITH A TRACE OF SUB-ANGULAR GRAVEL WITH SILTIER STRATUM AT 50 FT. (OCCASIONAL SHELLS).  
 LOOSE GREY VERY FINE TO FINE SANDY SILT WITH SHELLS.  
 LOOSE GREY SILT WITH A TRACE OF CLAY.





NOTE:  
 1. FOR RIVER AND ROAD CROSS SECTIONS AND PROFILES SEE DRAWINGS N<sup>o</sup> 105 AND N<sup>o</sup> 106.

PROJECT NO. 10-1	CONTRACT NO. 1	A.E.S.L. DRAWING NO. 4064-07-103
THE GOVERNMENT OF THE PROVINCE OF BRITISH COLUMBIA DEPT. OF LANDS, FORESTS AND WATER RESOURCES WATER RESOURCES SERVICE		105328
CANADA - BRITISH COLUMBIA FRASER RIVER FLOOD CONTROL 1988 AGREEMENT DISTRICT OF SURREY		AESL ASSOCIATED ENGINEERING SERVICES LTD. VANCOUVER, B.C.
TITLE SERPENTINE DAM SITE PLAN		DESIGN DRAWN CHECKED DRAWING NO. 4884-1-3
APPROVED FOR THE PROVINCE OF BRITISH COLUMBIA		SCALE 1" = 20' DATE AUGUST, 1972 APPROVED REV. 1

NO.	DATE	BY	REVISIONS	ENG.
1	16.6.75		AS CONSTRUCTED	







APPROVED  
 THE FRASER RIVER JOINT PROGRAM COMMITTEE  
 APPROVED

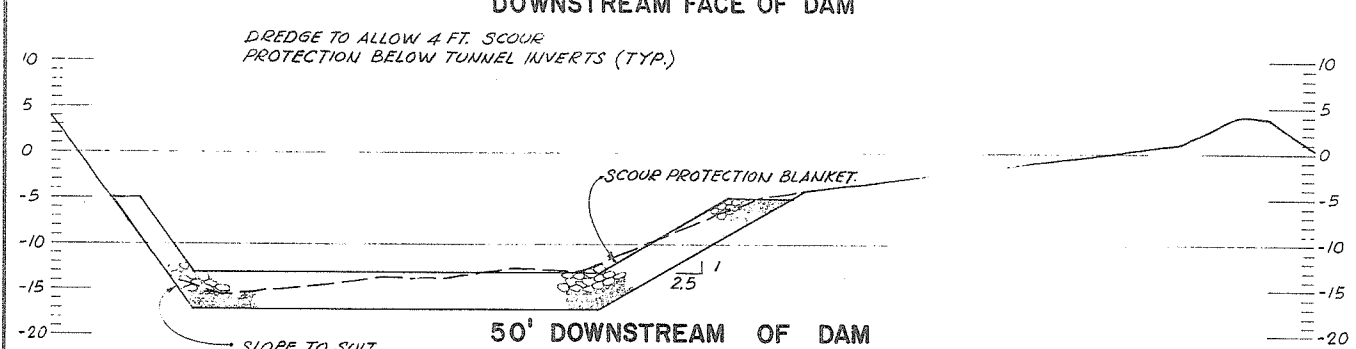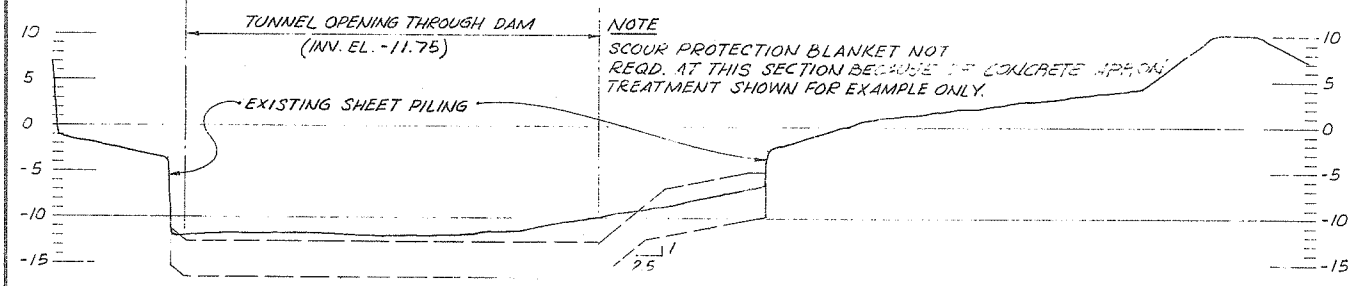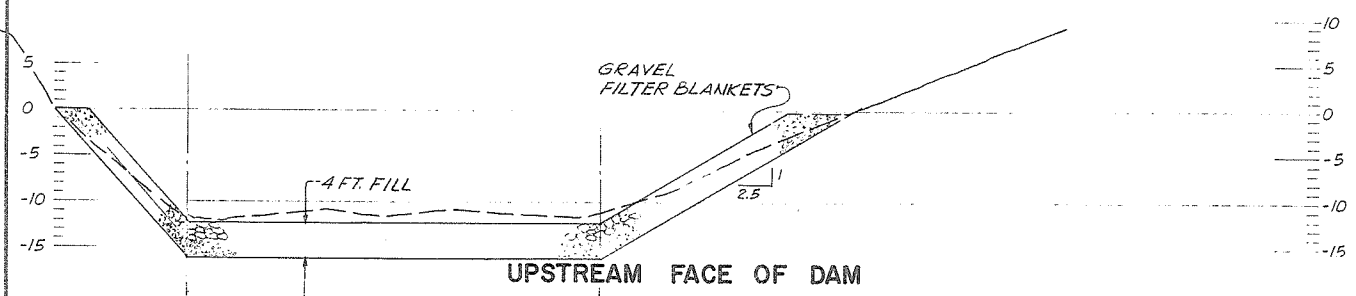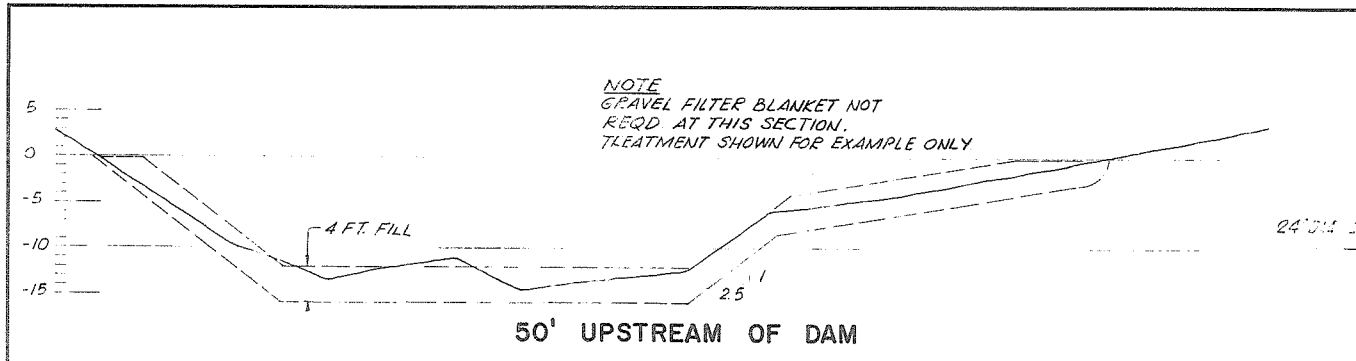


**RIVER CROSS SECTIONS**  
(LOOKING UPSTREAM)  
SCALE - HORIZ. 1" = 20'-0"  
VERT. 1" = 10'-0"

- NOTES:**
1. ALL RIVER BANK SLOPES TO BE TRIMMED TO 2 1/2 HORIZONTAL TO 1 VERTICAL SLOPES OR FLATTER, AS REQUIRED, UNLESS NOTED.
  2. UPSTREAM UNDER SEEPAGE BLANKET TO EXTEND UP RIVER BANKS TO ELEVATION 0.0 FT.
  3. DOWNSTREAM SCOUR PROTECTION BLANKET TO CONSIST OF 2 FT. MINIMUM SAND AND GRAVEL FOLLOWED BY 2 FT. MINIMUM THICK LAYER OF 6 IN. TO 9" COBBLES.
  4. DOWNSTREAM SCOUR PROTECTION BLANKET TO EXTEND UP RIVER BANKS TO ELEVATION -5 FT.

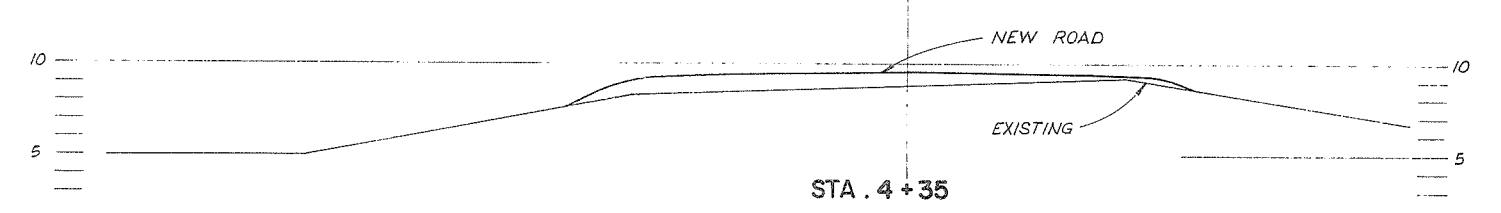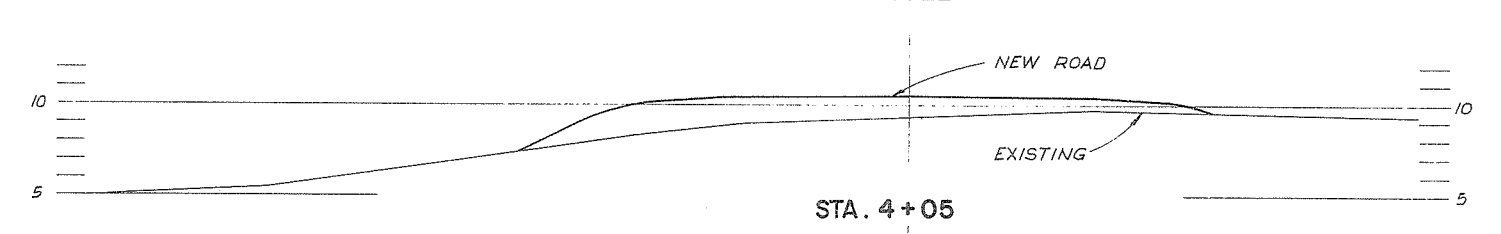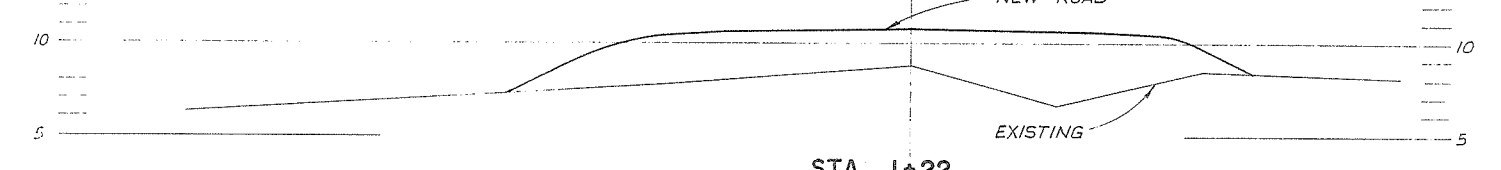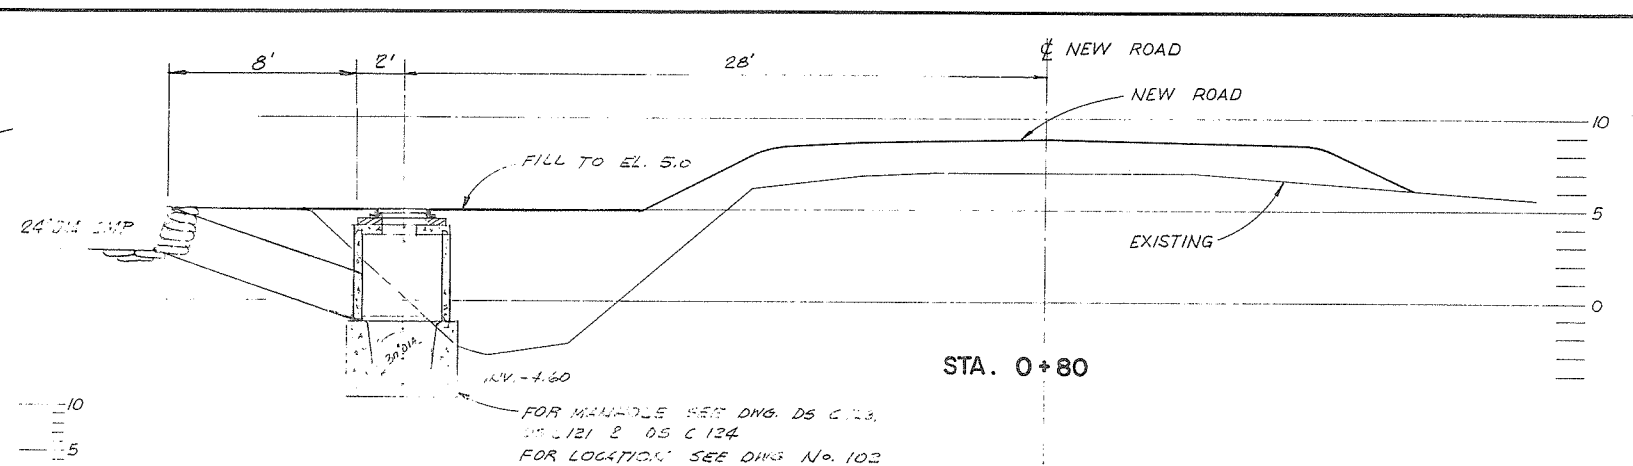

**ROAD CROSS SECTIONS**  
SCALE 1" = 5'-0"



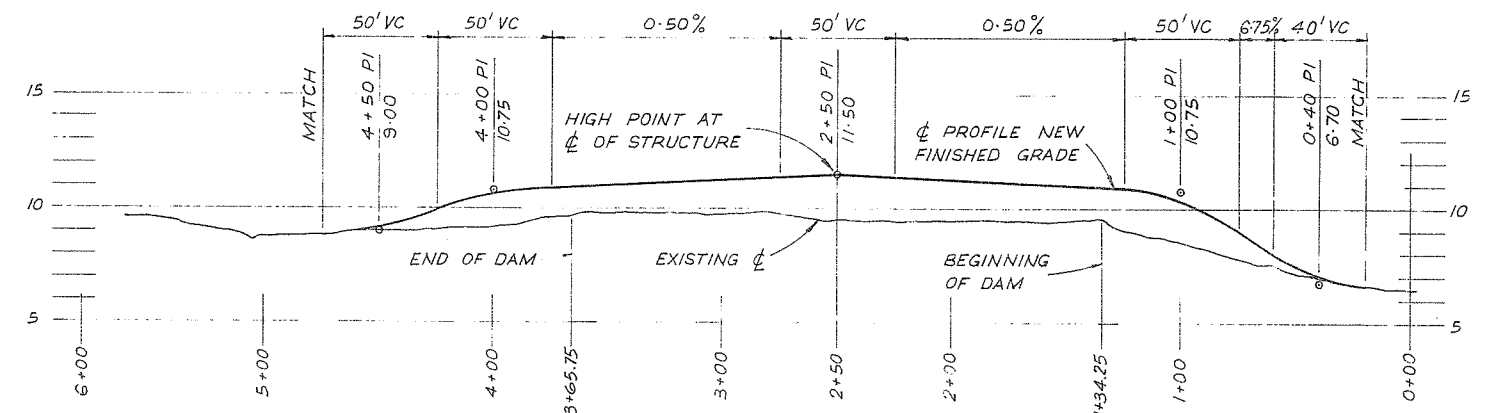


**ROAD PROFILE**  
SCALE - HORIZ. 1" = 40'-0"  
VERT. 1" = 4'-0"

PROJECT NO. 10-1	CONTRACT NO. 1	A.E.S.L. DRAWING NO. 4064-07-104
THE GOVERNMENT OF THE PROVINCE OF BRITISH COLUMBIA DEPT. OF LANDS, FORESTS AND WATER RESOURCES WATER RESOURCES SERVICE		<b>AESL</b> ASSOCIATED ENGINEERING SERVICES LTD. Consulting Engineers VANCOUVER, B.C.
CANADA - BRITISH COLUMBIA FRASER RIVER FLOOD CONTROL 1988 AGREEMENT DISTRICT OF SURREY		105329
TITLE NICOMEKL DAM RIVER AND ROAD CROSS SECTIONS		DESIGN <i>W.P.</i> DRAWN P.W. CHECKED <i>W.P.</i> DATE 11 Sept 72 APPROVED <i>W.P.</i> DATE 12 Sept 72 FOR THE PROVINCE OF BRITISH COLUMBIA
DRAWING NO. 4884-1-4		SCALE AS NOTED DATE AUGUST, 1972 APPROVED <i>W.P.</i> REV. 1

NO.	DATE	BY	REVISIONS	ENG.
1	16.6.75	J.A.V.	AS CONSTRUCTED	




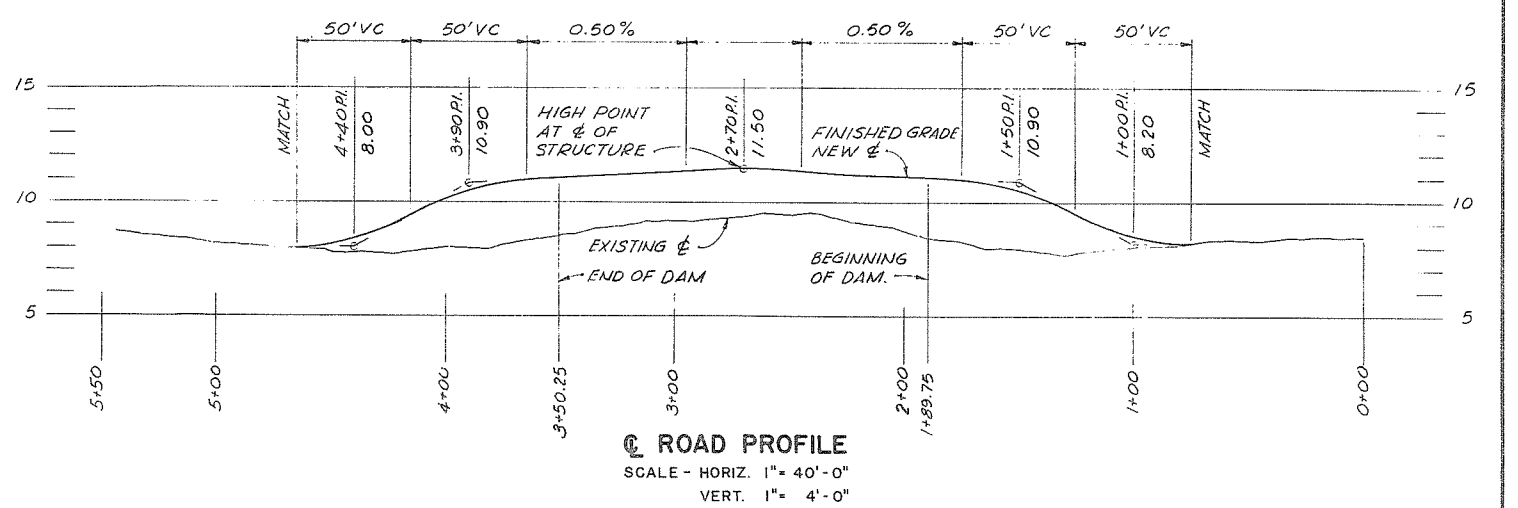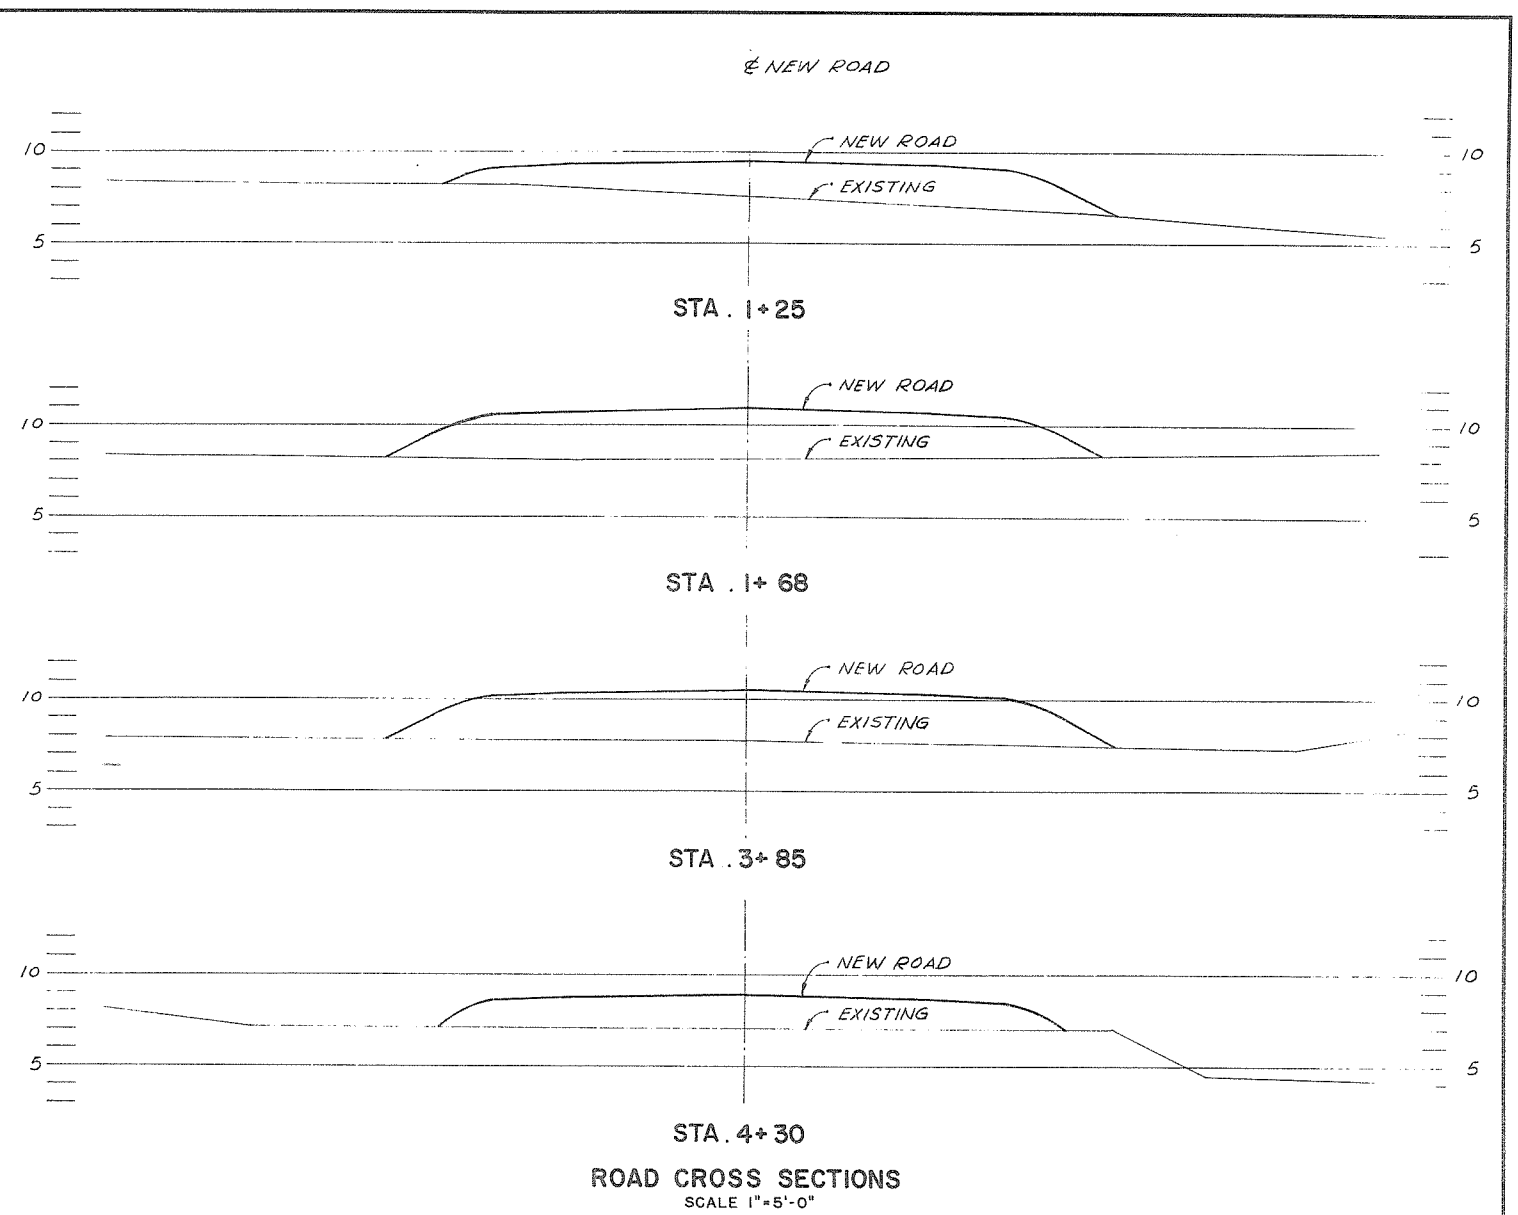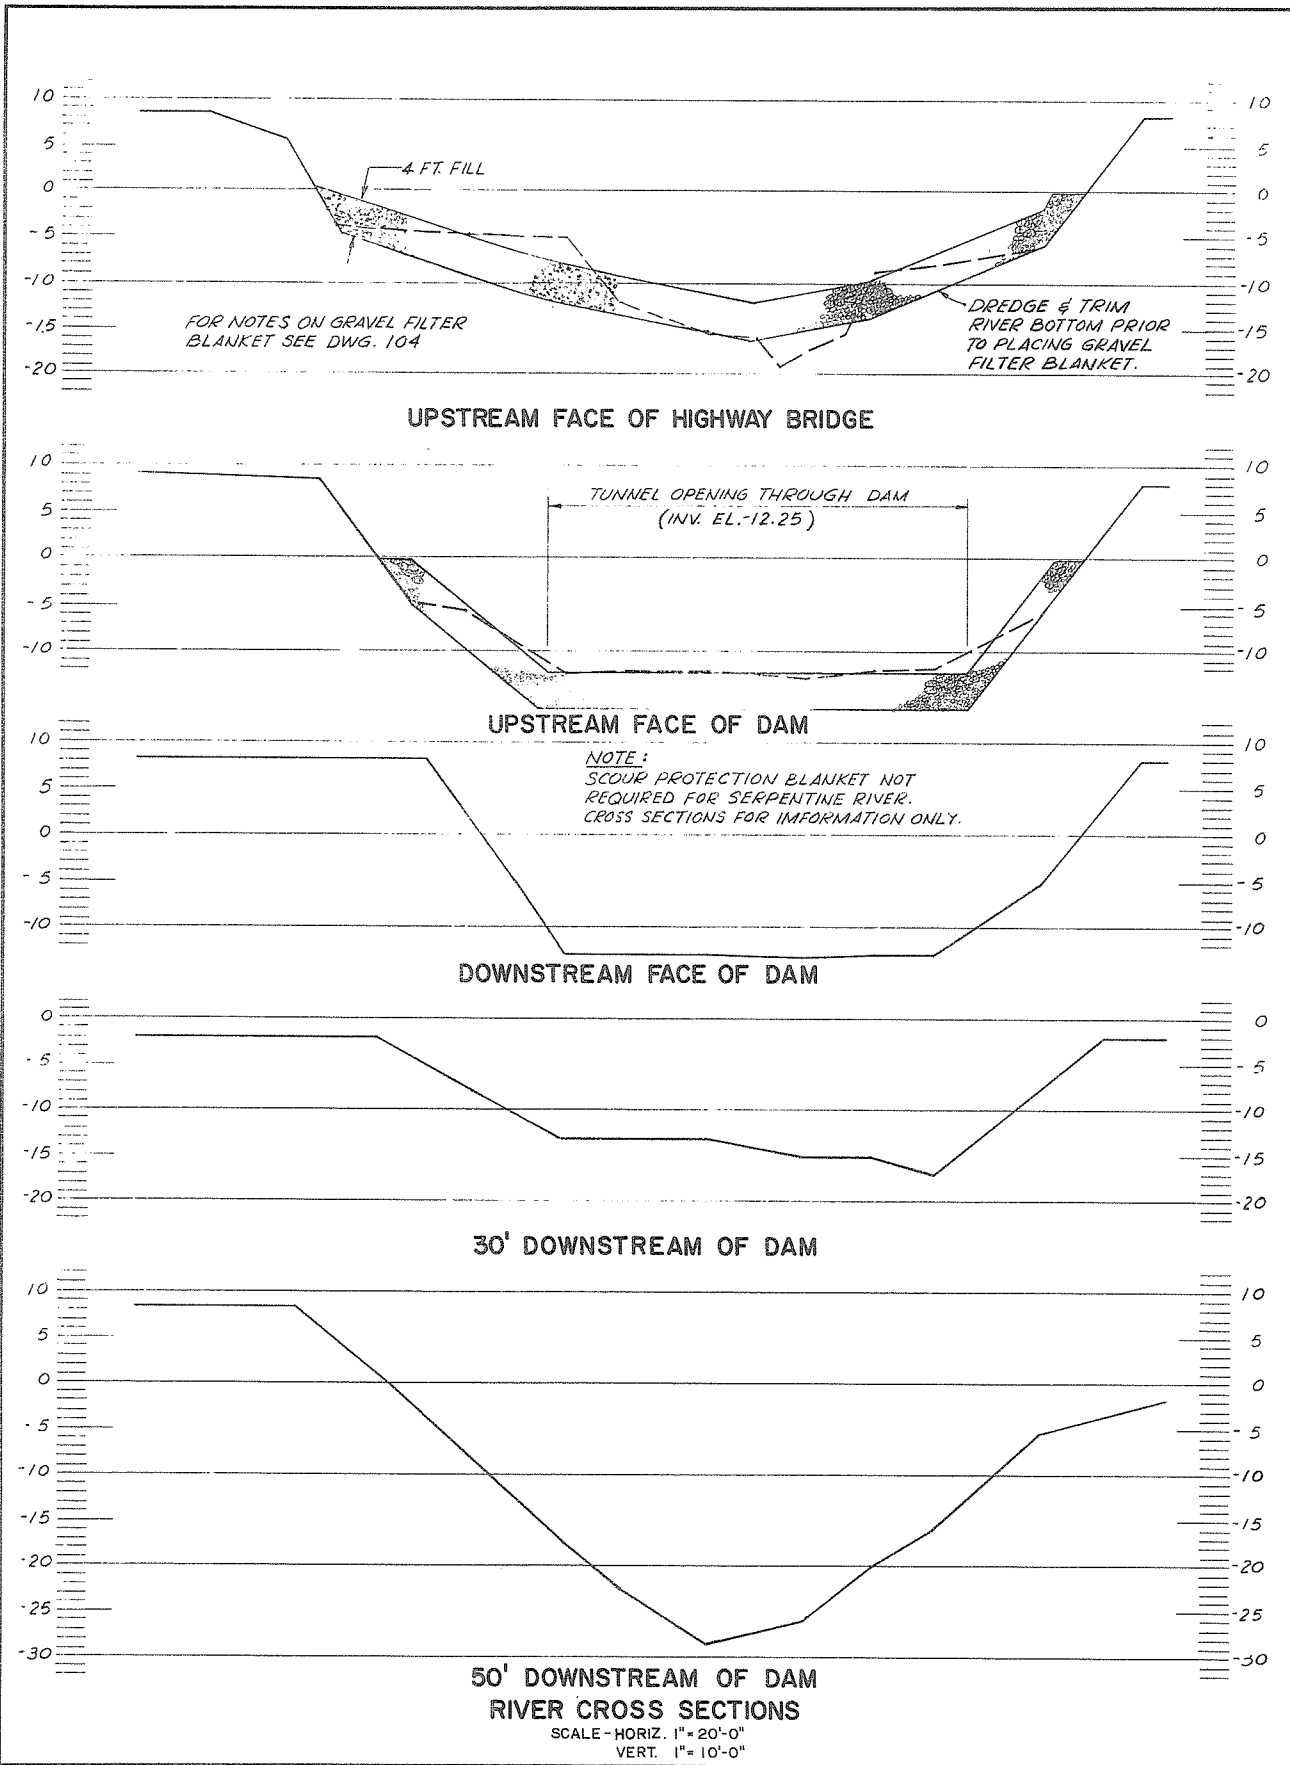

PROJECT NO. 10-1		CONTRACT NO. 1		A.E.S.L. DRAWING NO. 4064-07-105	
THE GOVERNMENT OF THE PROVINCE OF BRITISH COLUMBIA DEPT. OF LANDS, FORESTS AND WATER RESOURCES WATER RESOURCES SERVICE				<b>AESL</b> ASSOCIATED ENGINEERING SERVICES LTD. <small>Consulting Engineers</small> VANCOUVER, B.C.	
CANADA - BRITISH COLUMBIA FRASER RIVER FLOOD CONTROL 1965 AGREEMENT DISTRICT OF SURREY				DESIGN <i>LPF</i> SCALE AS NOTED DRAWN <i>G.J.Q.V.</i> DATE AUGUST 1972 CHECKED <i>LPF</i> APPROVED <i>[Signature]</i>	
TITLE SERPENTINE DAM RIVER AND ROAD CROSS SECTIONS				DRAWING NO. 4884-1-5 REV. 1	
DATE APPROVED 11 Sept 72 THE FRASER RIVER JOINT PROGRAM COMMITTEE		DATE APPROVED 10 Sept 1972 FOR THE PROVINCE OF BRITISH COLUMBIA		PROJECT NO. 10-1 CONTRACT NO. 1 A.E.S.L. DRAWING NO. 4064-07-105	


NO.	DATE	BY	REVISIONS	ENG.
1	16.6.75	V.W.	AS CONSTRUCTED	



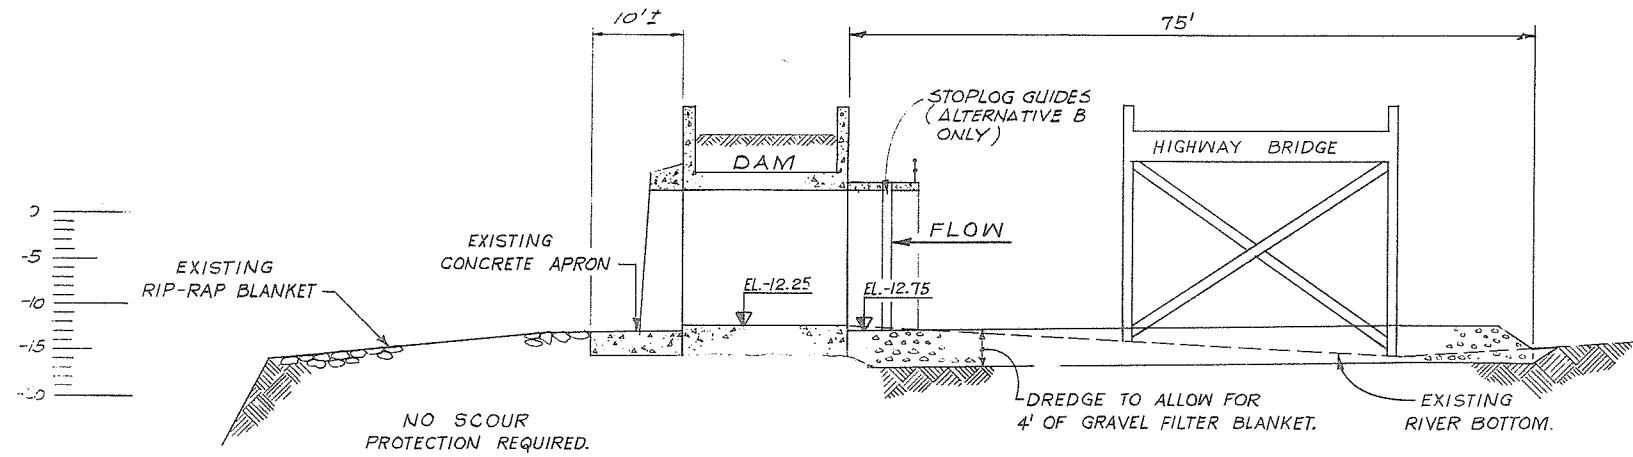


PROFILE SERPENTINE RIVER

SCALE: 1" = 10'

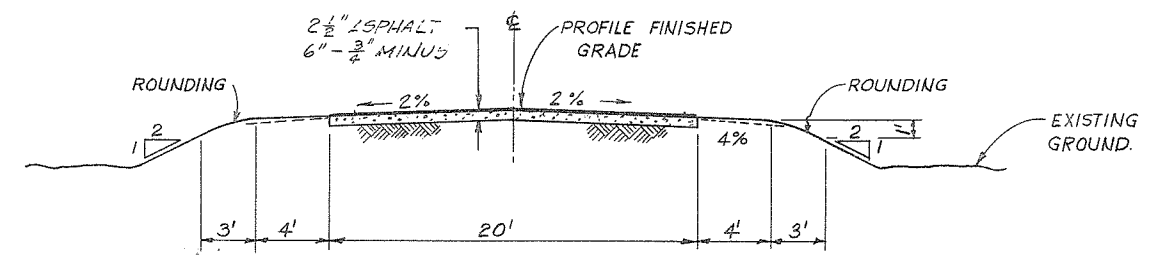


NICOMEKL CROSS SECTION TYPICAL APPROACH ROAD

SCALE: 1" = 5'

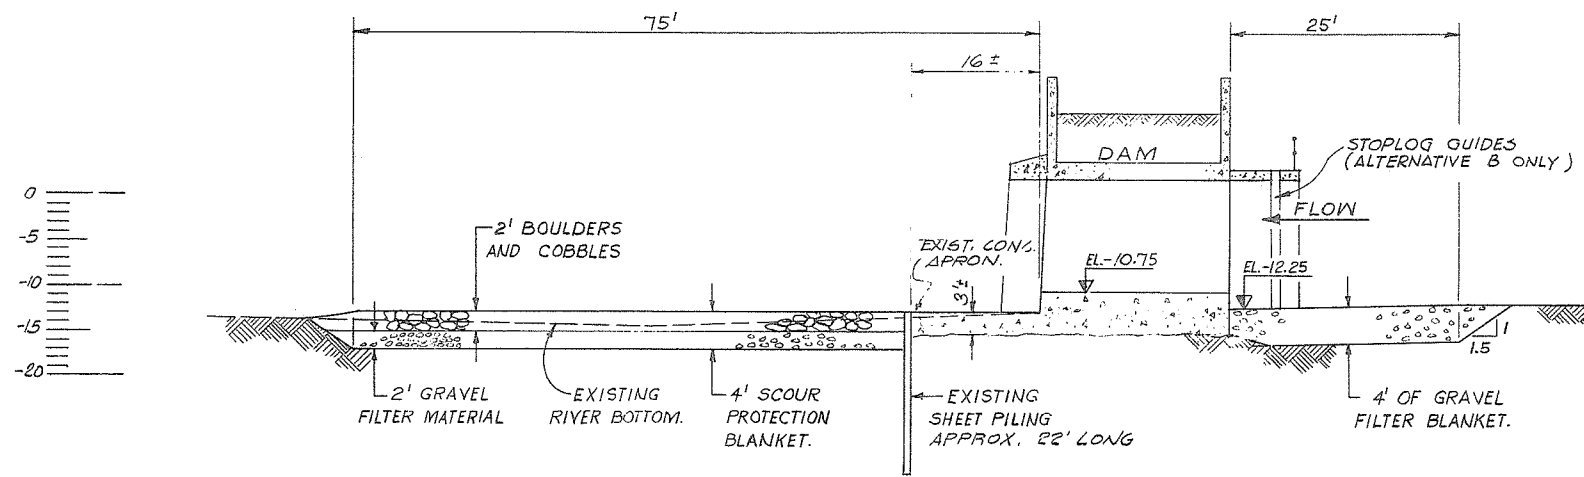

PROFILE NICOMEKL RIVER


SCALE: 1" = 10'

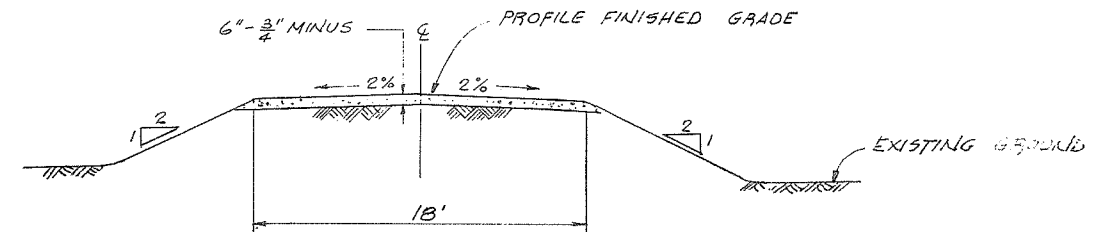



SERPENTINE CROSS SECTION TYPICAL APPROACH ROAD

SCALE: 1" = 5'


PROJECT NO. 10-1		CONTRACT NO. 1		A.E.S.L. DRAWING NO. 4064-07-106	
THE GOVERNMENT OF THE PROVINCE OF BRITISH COLUMBIA DEPT. OF LANDS, FORESTS AND WATER RESOURCES WATER RESOURCES SERVICE				AESL ASSOCIATED ENGINEERING SERVICES LTD. Vancouver, B.C.	
CANADA - BRITISH COLUMBIA FRASER RIVER FLOOD CONTROL 1969 AGREEMENT DISTRICT OF SURREY				DESIGN: LRF SCALE: AS NOTED	
TITLE: NICOMEKL AND SERPENTINE DAMS FILTER & SCOUR PROTECTION PROFILES ROAD CROSS SECTION				DRAWN: R.R.C. DATE: AUGUST, 1972	
DATE: 16.6.75 APPROVED: [Signature] FOR THE PROVINCE OF BRITISH COLUMBIA				CHECKED: LRF APPROVED: [Signature]	
NO. 1		DATE 16.6.75		BY [Signature]	
AS CONSTRUCTED		REVISIONS		ENG. [Signature]	

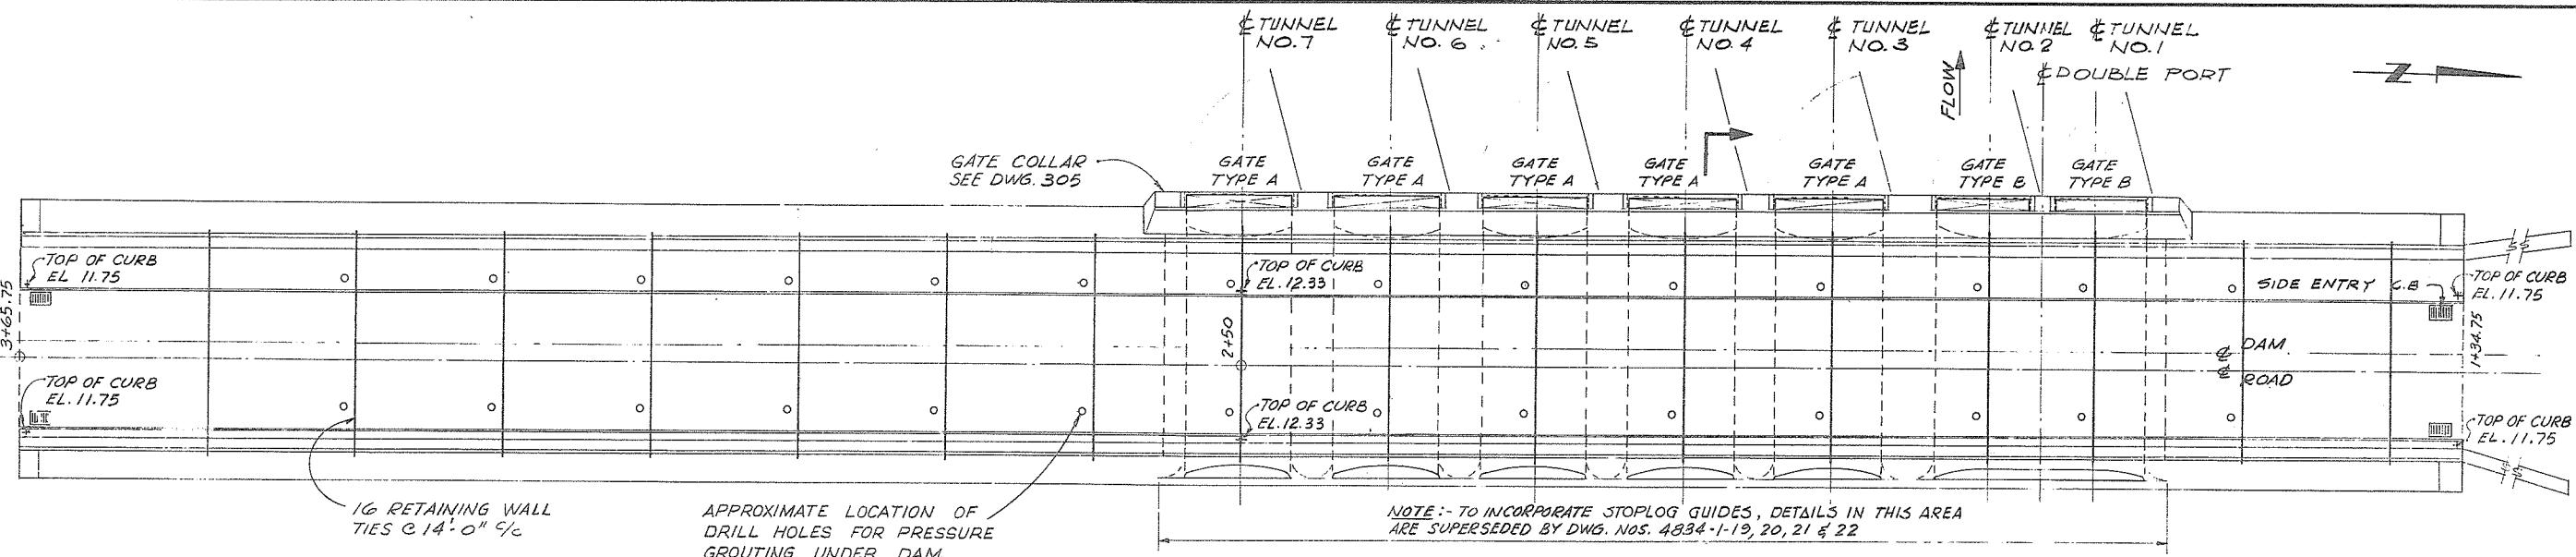

PLAN

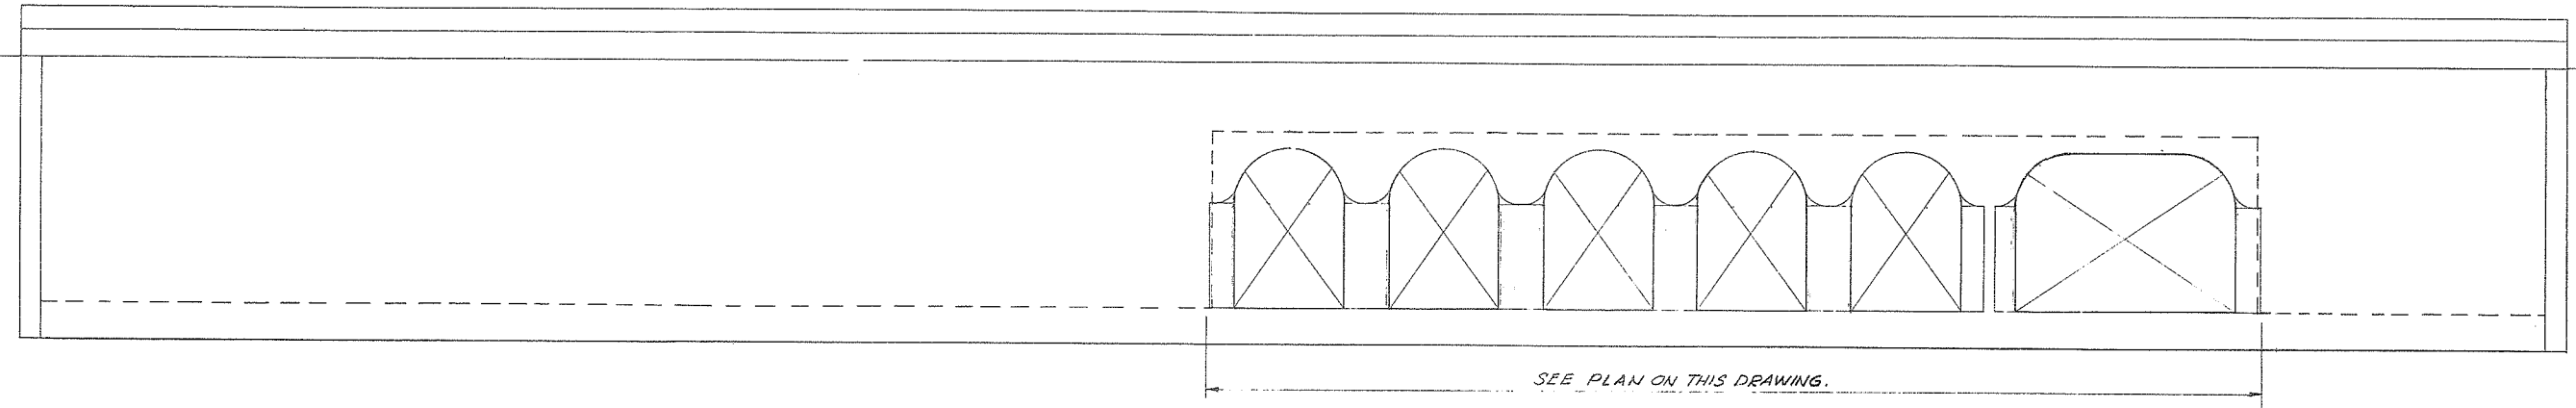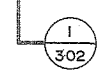


ELEVATION OF UPSTREAM FACE

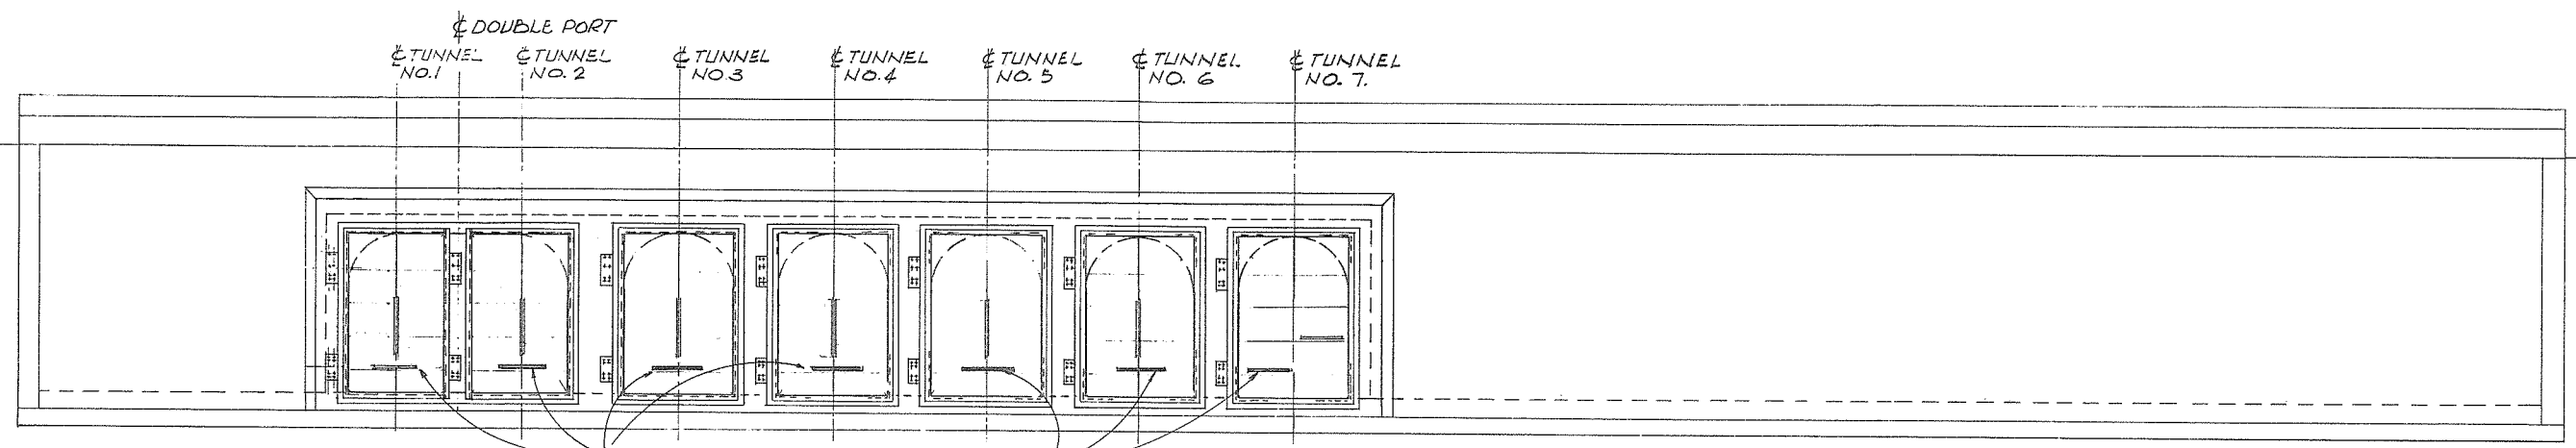

ELEVATION OF DOWNSTREAM FACE


PROJECT NO. 10.1		CONTRACT NO. 1		A.E.S.L. DRAWING NO. 4064-07-301	
THE GOVERNMENT OF THE PROVINCE OF BRITISH COLUMBIA DEPT. OF LANDS, FORESTS AND WATER RESOURCES WATER RESOURCES SERVICE				<b>AESL</b> ASSOCIATED ENGINEERING SERVICES LTD. Consulting Engineers VANCOUVER, B.C.	
CANADA - BRITISH COLUMBIA FRASER RIVER FLOOD CONTROL 1968 AGREEMENT DISTRICT OF SURREY				DESIGN: <i>W.P.L.</i> SCALE: 1/8" = 1'-0" DRAWN: R.W.W. - G.J.Q.V. DATE: AUGUST, 1972 CHECKED: <i>W.P.L.</i> APPROVED: <i>W.P.L.</i> DRAWING NO. 4884-1-7 REV. 1	
TITLE: NICOMEKL DAM GENERAL ARRANGEMENT PLAN AND SECTIONS					
1 16.675 <i>W.W.</i> AS CONSTRUCTED NO. DATE BY REVISIONS ENG.				DATE: 11 Sept 72 THE FRASER RIVER JOINT PROGRAM COMMITTEE DATE: 15 Jul 1972 APPROVED FOR THE PROVINCE OF BRITISH COLUMBIA	

SUPERSEDES ALL PREVIOUS PRINTS WITH A NUMBER LOWER THAN

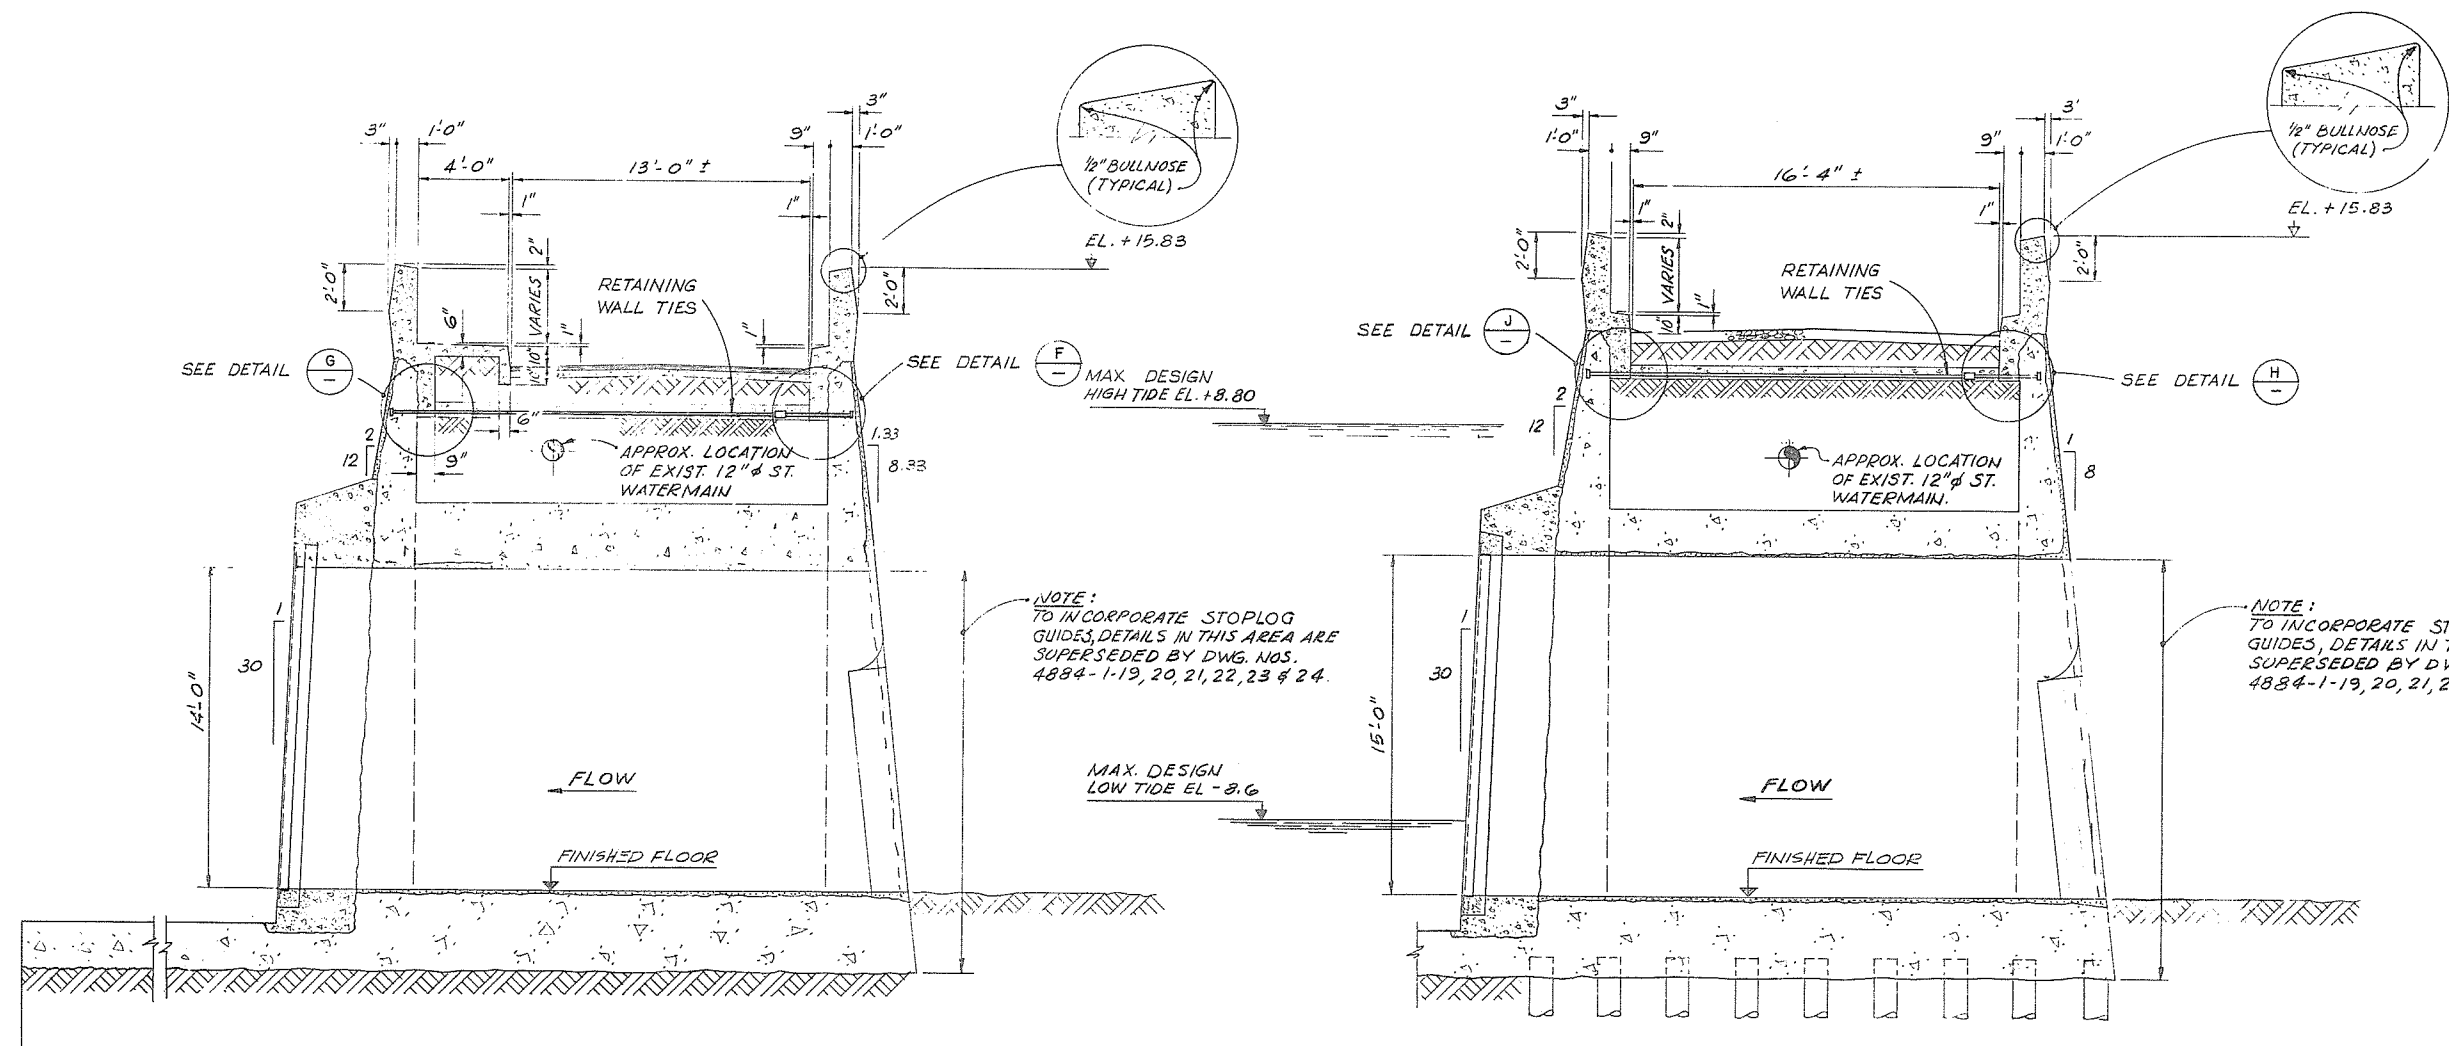


SECTION 1  
301  
NICOMEKL DAM

SECTION 2  
308  
SERPENTINE DAM

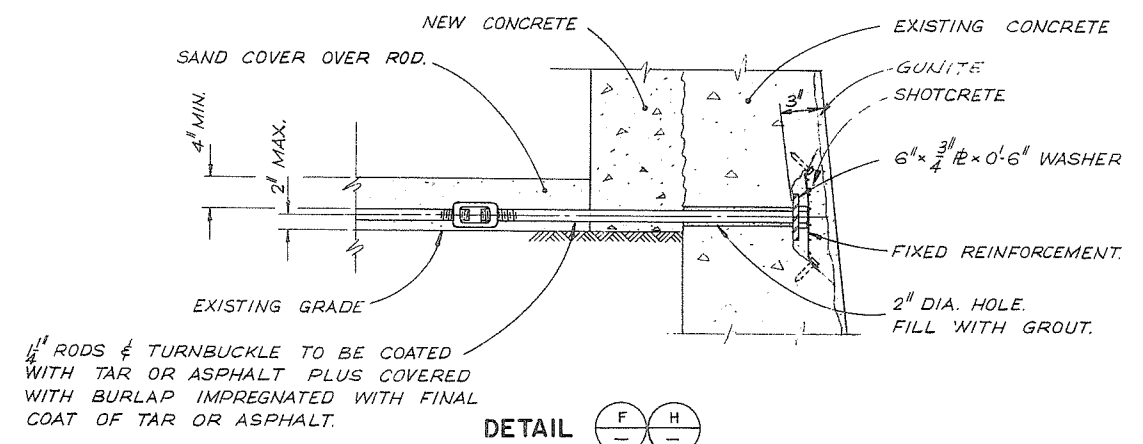

1/2" RODS & TURNBUCKLE TO BE COATED WITH TAR OR ASPHALT PLUS COVERED WITH BURLAP IMPREGNATED WITH FINAL COAT OF TAR OR ASPHALT.

DETAIL F H  
DETAIL G J (OPPOSITE HAND)  
1" = 1'-0"

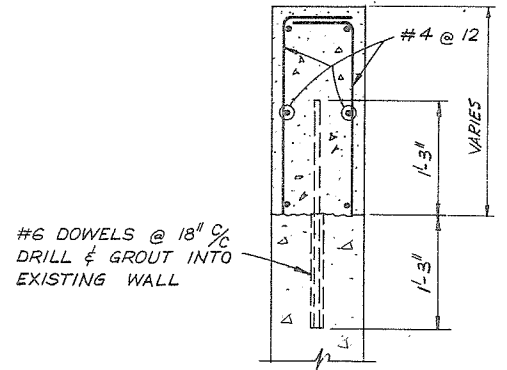


RETAINING WALL EXTENSION DETAIL  
1" = 1'-0"

LEGEND


	EXISTING CONCRETE
	NEW CONCRETE
	SHOTCRETE OR GUNITE

PROJECT NO. 10-1		CONTRACT NO. 1		A.E.S.L. DRAWING NO. 4064-07-302	
THE GOVERNMENT OF THE PROVINCE OF BRITISH COLUMBIA DEPT. OF LANDS, FORESTS AND WATER RESOURCES WATER RESOURCES SERVICE				AESL ASSOCIATED ENGINEERING SERVICES LTD. VANCOUVER, B.C.	
CANADA - BRITISH COLUMBIA FRASER RIVER FLOOD CONTROL 1988 AGREEMENT DISTRICT OF SURREY				DESIGN W.P.K. SCALE 1/4" = 1'-0"	
TITLE NICOMEKL AND SERPENTINE DAMS ROADWAY CROSS SECTIONS CONCRETE				DRAWN G.J.O.V. DATE AUGUST, 1972	
DATE 12 Sept 1972 APPROVED FOR THE PROVINCE OF BRITISH COLUMBIA				CHECKED W.P.K. APPROVED [Signature]	
NO. 1		DATE 16.6.75		BY [Signature]	
		AS CONSTRUCTED		ENG. [Signature]	

SUPERSEDES ALL PREVIOUS PRINTS WITH A NUMBER LOWER THAN 1

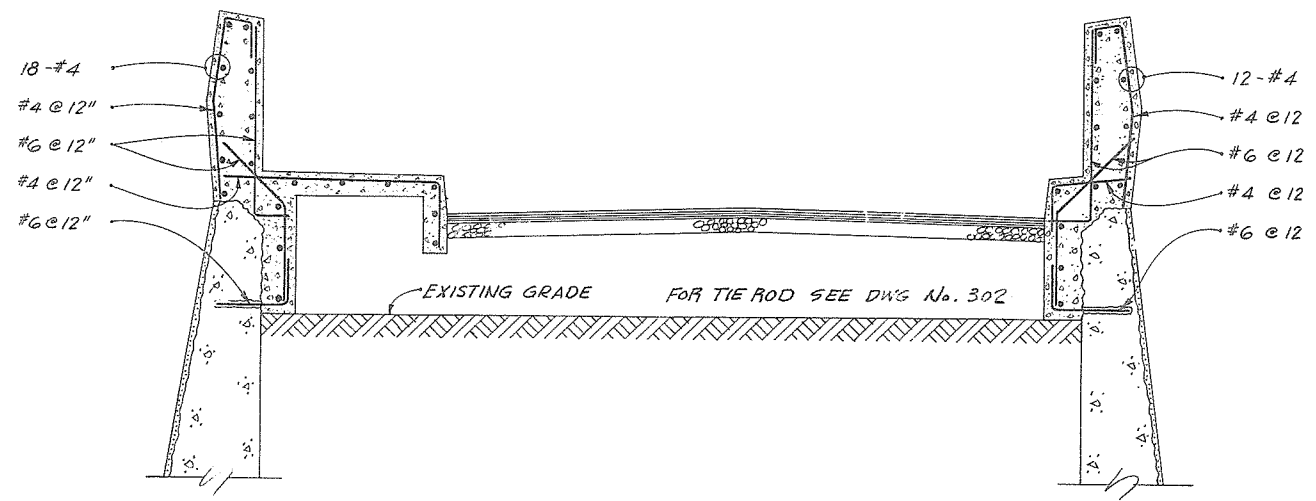

SECTION 1  
301  
NICOMEKL DAM

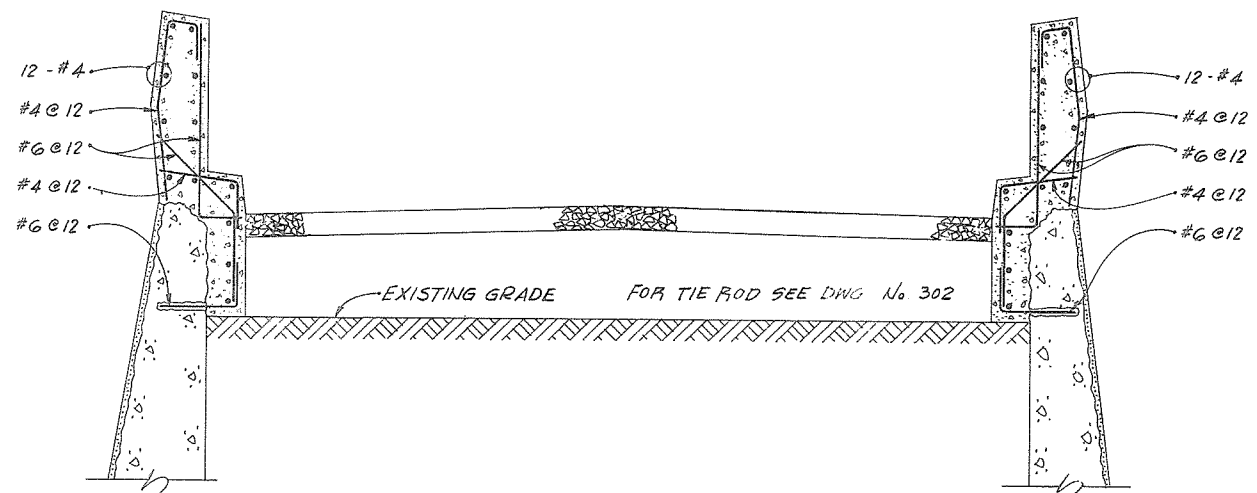

SECTION 2  
308  
SERPENTINE DAM

NO.	DATE	BY	REVISIONS	ENG.
1	16.6.75	4.74	AS CONSTRUCTED	



APPROVED  
DATE 11 Sept 72  
THE FRASER RIVER JOINT PROGRAM COMMITTEE  
DATE 12 Sept 1972  
APPROVED FOR THE PROVINCE OF BRITISH COLUMBIA


PROJECT NO. 10-1	CONTRACT NO. 1	A.E.S.L. DRAWING NO. 4064-07-303
THE GOVERNMENT OF THE PROVINCE OF BRITISH COLUMBIA DEPT. OF LANDS, FORESTS AND WATER RESOURCES WATER RESOURCES SERVICE		105334
CANADA - BRITISH COLUMBIA FRASER RIVER FLOOD CONTROL 1968 AGREEMENT DISTRICT OF SURREY		AESL ASSOCIATED ENGINEERING SERVICES LTD. VANCOUVER, B.C.
TITLE NICOMEKL AND SERPENTINE DAMS ROADWAY CROSS SECTIONS REINFORCEMENT		DESIGN W.P.K. SCALE 1/2" = 1'-0" DRAWN G.J.Q.V. DATE AUGUST, 1972 CHECKED W.P.K. APPROVED [Signature]
DRAWING NO. 4884-1-9		REV. 1

SUPERSEDES ALL PREVIOUS PRINTS WITH A NUMBER LOWER THAN 1








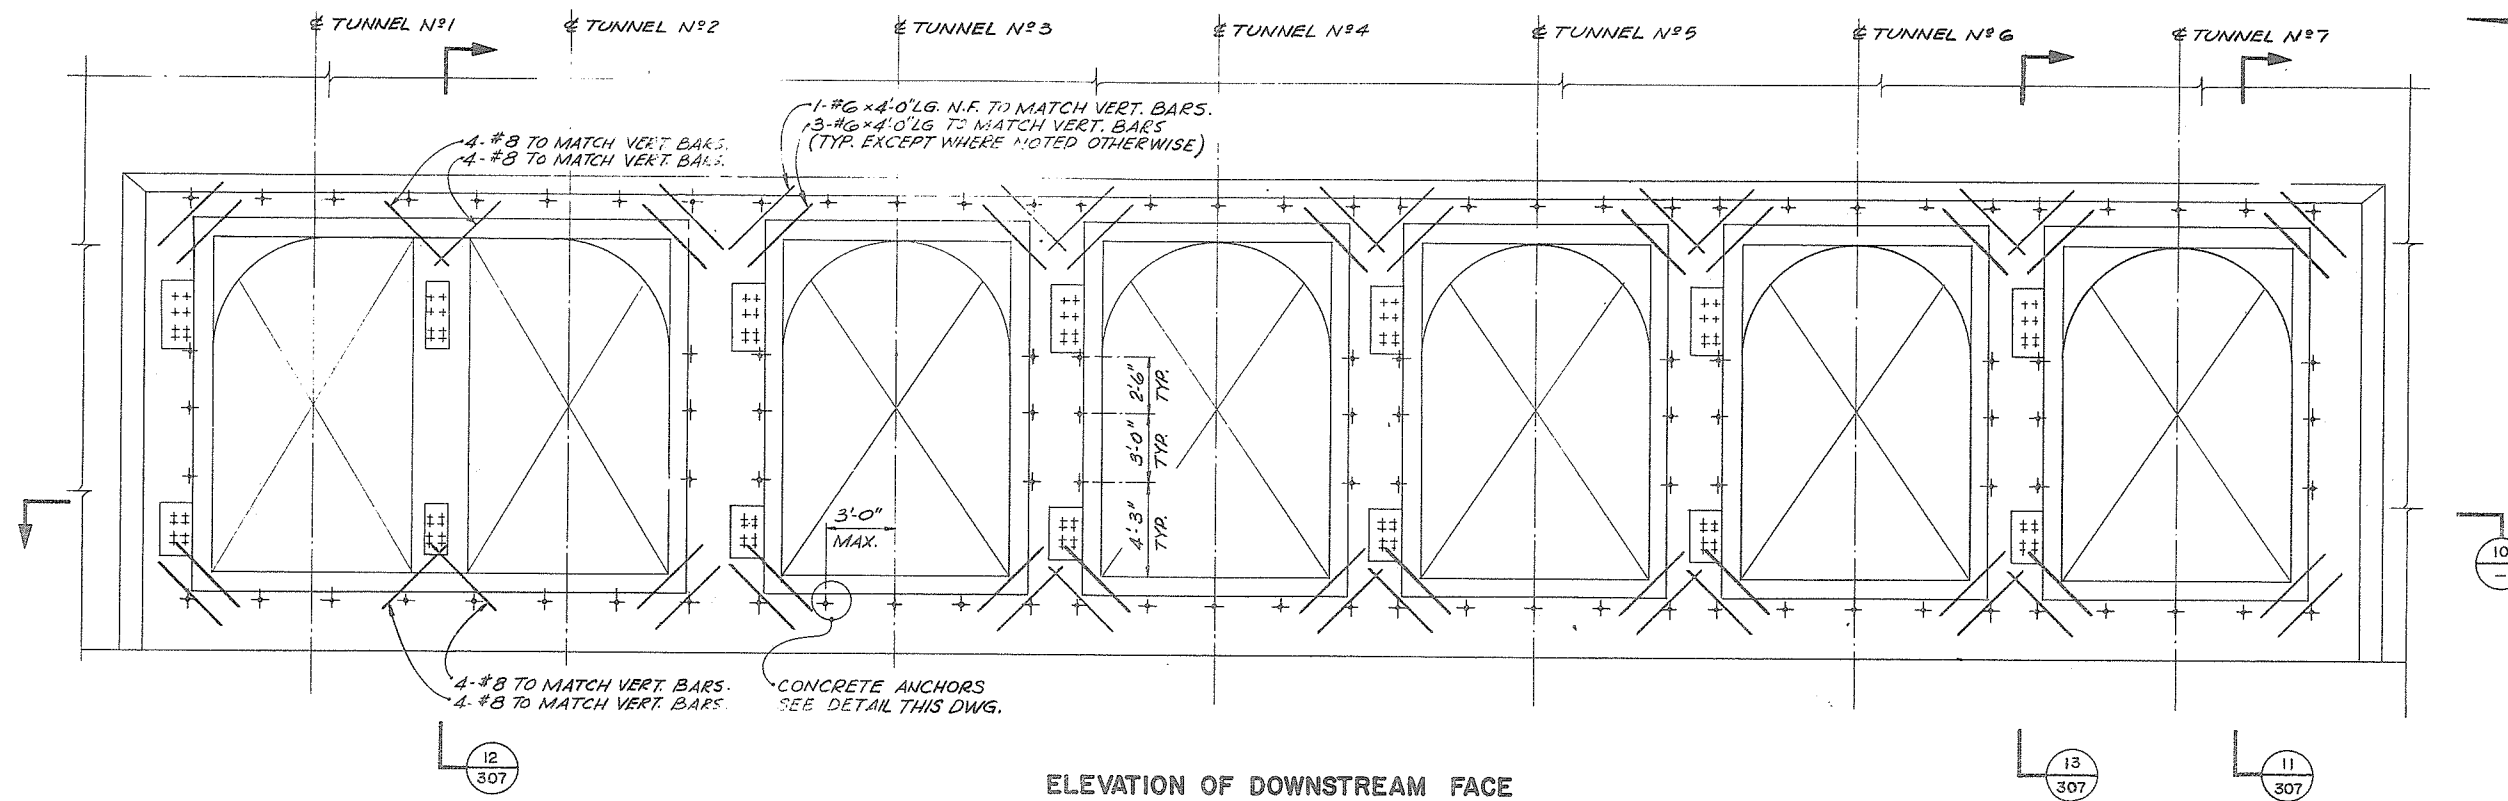


ELEVATION OF DOWNSTREAM FACE

SCALE  $\frac{1}{4}'' = 1'-0''$

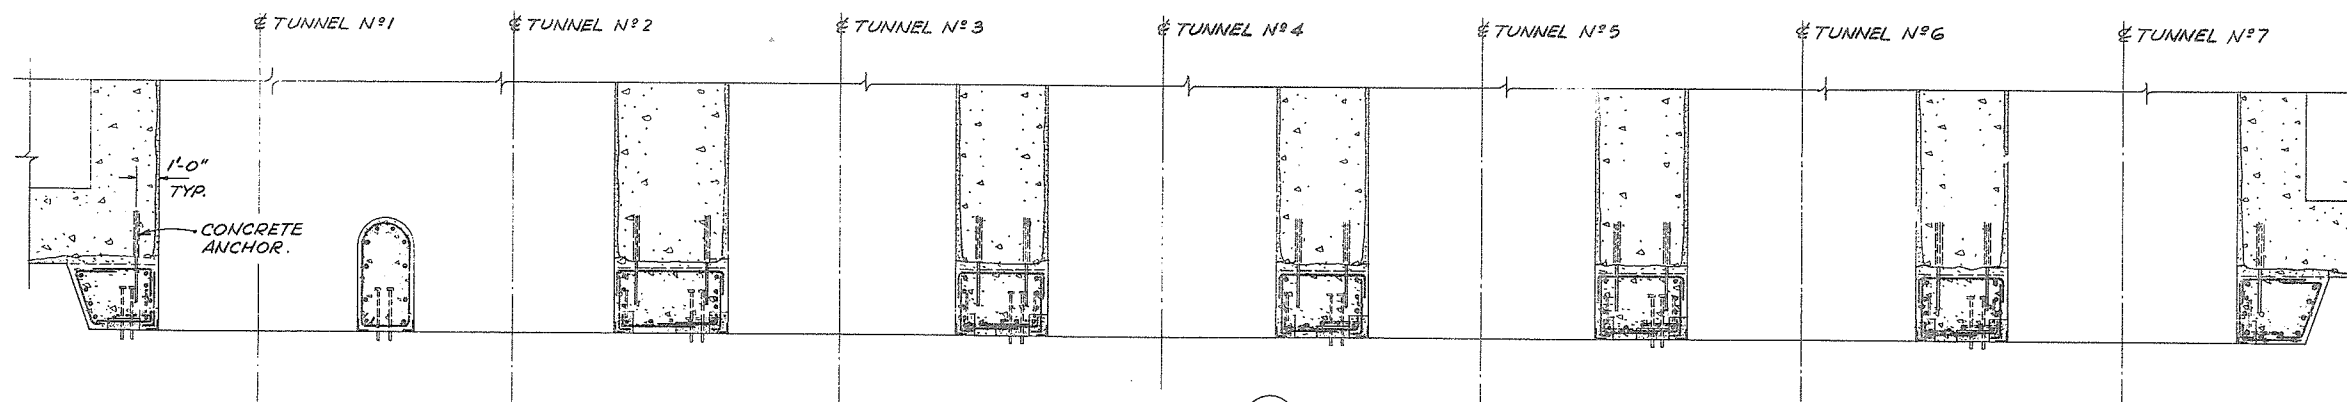

SECTION 10

SCALE  $\frac{1}{4}'' = 1'-0''$




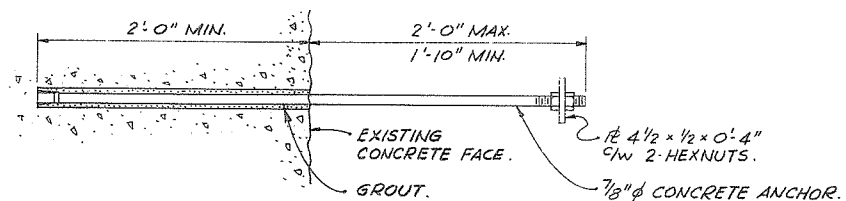


CONCRETE ANCHOR DETAIL



SCALE  $\frac{1}{2}'' = 1'-0''$

PROJECT NO. 10.1	CONTRACT NO. 1	A.E.S.L. DRAWING NO. 4064-07-306
THE GOVERNMENT OF THE PROVINCE OF BRITISH COLUMBIA DEPT. OF LANDS, FORESTS AND WATER RESOURCES WATER RESOURCES SERVICE		105337
CANADA - BRITISH COLUMBIA FRASER RIVER FLOOD CONTROL 1968 AGREEMENT DISTRICT OF SURREY		AESL ASSOCIATED ENGINEERING SERVICES LTD. VANCOUVER, B.C.
TITLE NICOMEKL DAM GATE COLLAR ELEVATION AND SECTION REINFORCEMENT		DESIGN: [Signature] DRAWN: G.J.Q.V. CHECKED: [Signature] DATE: AUGUST 1972 APPROVED: [Signature]
SCALE AS NOTED		DRAWING NO. 4884-1-12

NO.	DATE	BY	REVISIONS	ENG.
1	16.6.75	[Signature]	AS CONSTRUCTED	

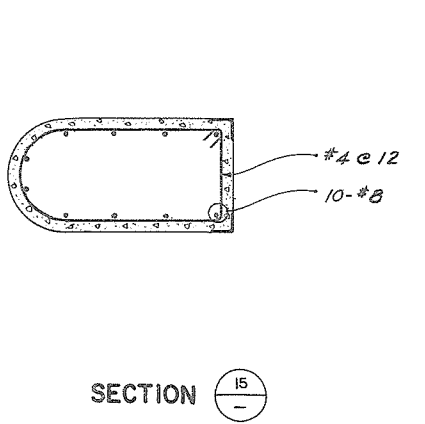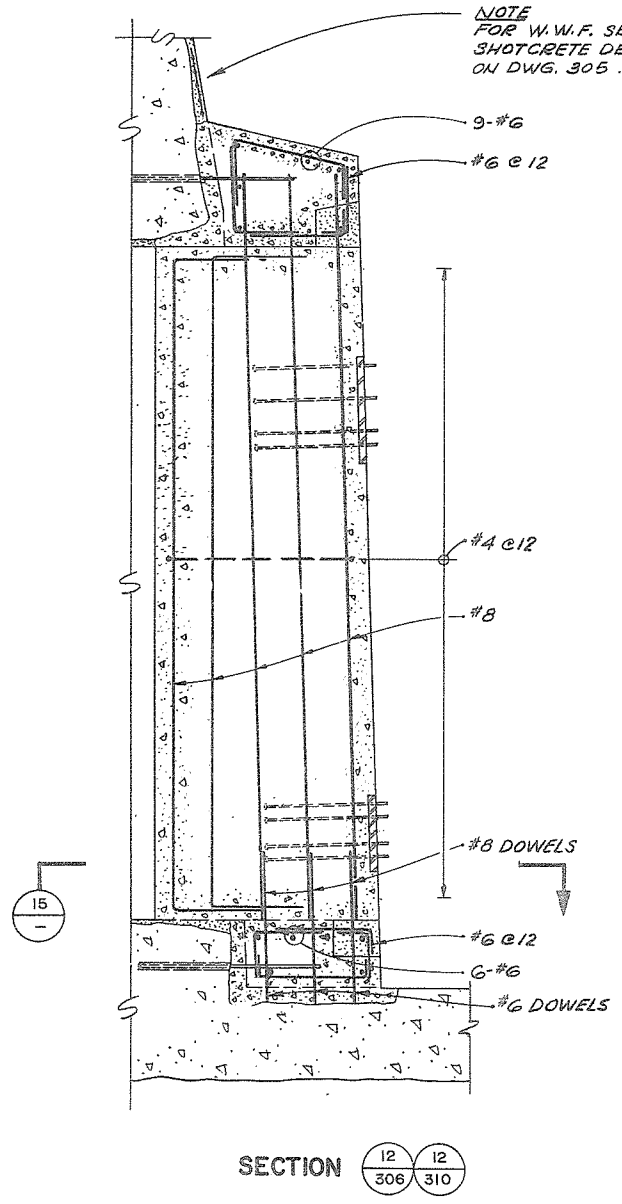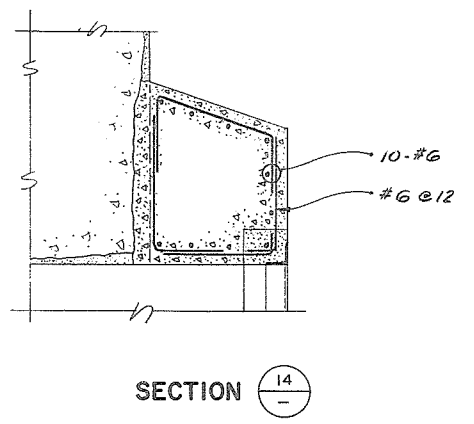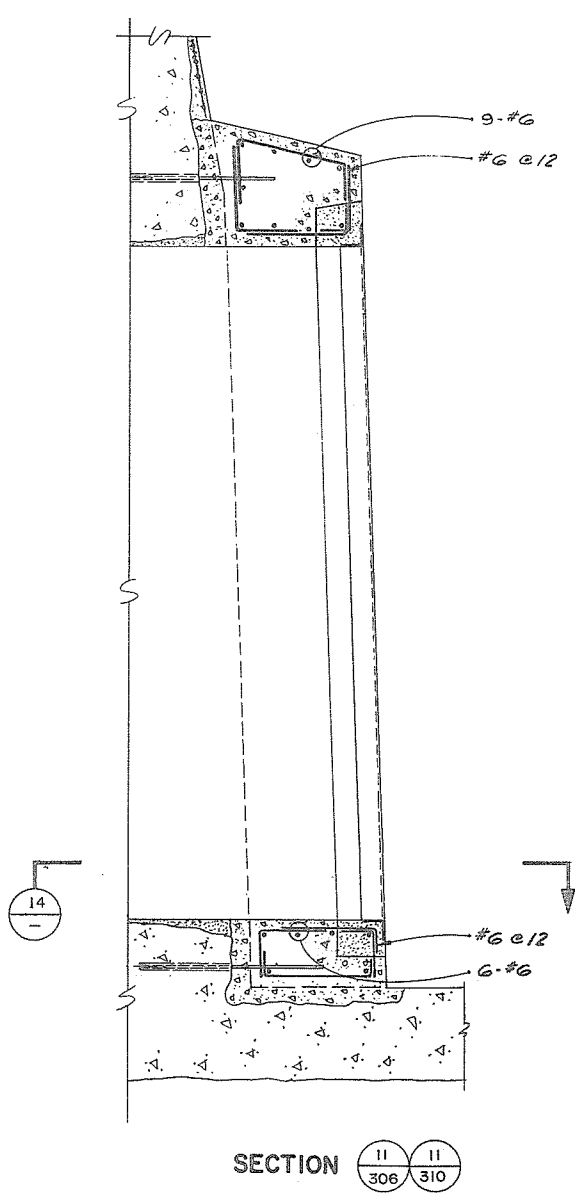

NOTE  
FOR W.W.F. SEE TYPICAL  
SHOTCRETE DETAIL  
ON DWG. 305.

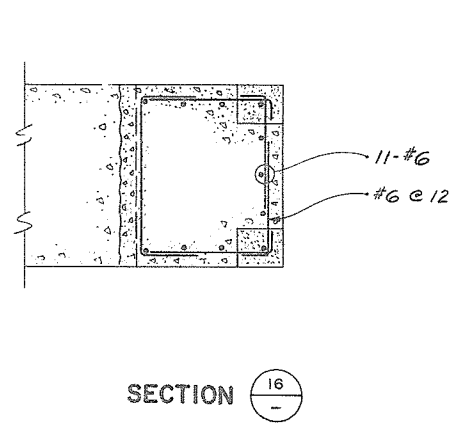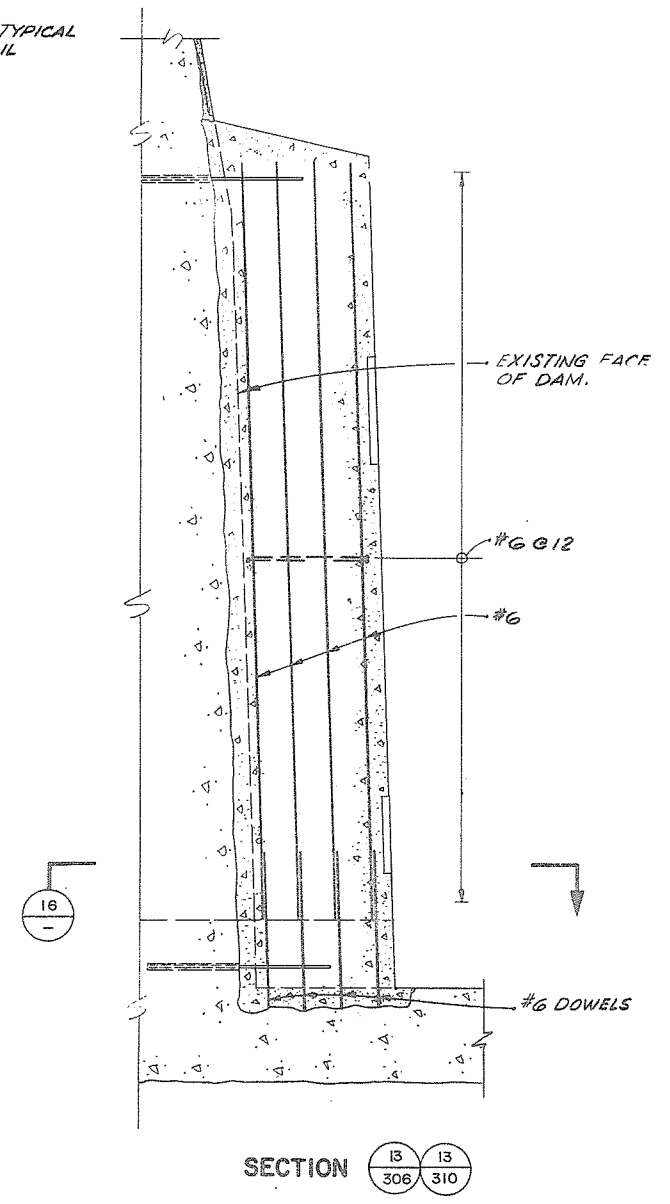




NO.	DATE	BY	REVISIONS	ENG.
1	16.6.75	W.W.	AS CONSTRUCTED	



APPROVED  
DATE 11 SEP 72  
THE FRASER RIVER JOINT PROGRAM COMMITTEE  
APPROVED  
DATE 12 SEP 1972  
FOR THE PROVINCE OF BRITISH COLUMBIA

PROJECT NO. 10.1	CONTRACT NO. 1	A.E.S.L. DRAWING NO. 4064-07-307
THE GOVERNMENT OF THE PROVINCE OF BRITISH COLUMBIA DEPT. OF LANDS, FORESTS AND WATER RESOURCES WATER RESOURCES SERVICE		105338 ASSOCIATED ENGINEERING SERVICES LTD. VANCOUVER, B.C.
CANADA - BRITISH COLUMBIA FRASER RIVER FLOOD CONTROL 1968 AGREEMENT DISTRICT OF SURREY		DESIGN W.W. SCALE 1/2" = 1'-0"
TITLE NICOMEKL AND SERPENTINE DAMS GATE COLLAR SECTIONS AND DETAILS REINFORCEMENT		DRAWN G.J.V. DATE AUGUST, 1972 CHECKED W.W. APPROVED W.W.
DRAWING NO. 4884-1-13		REV. 1

SUPERSEDES ALL PREVIOUS PRINTS WITH A NUMBER LOWER THAN .

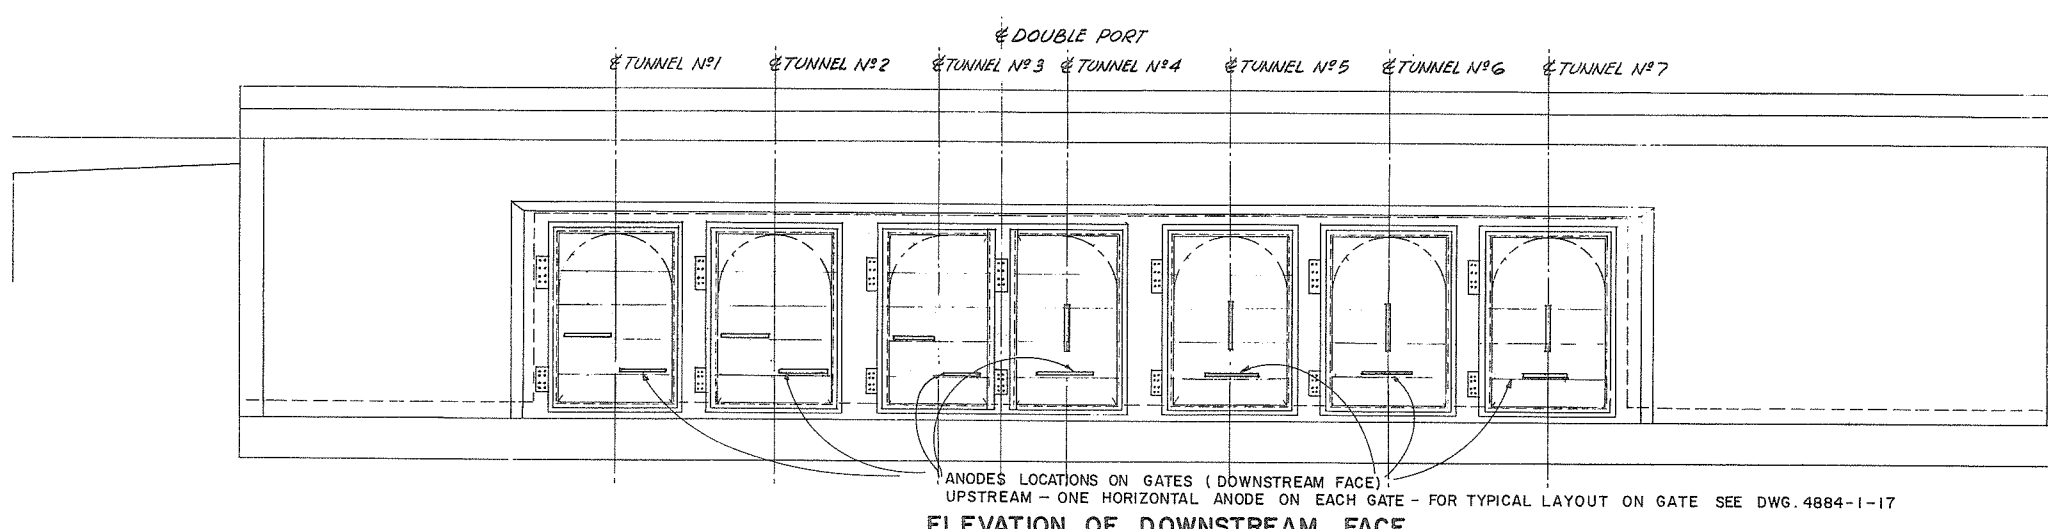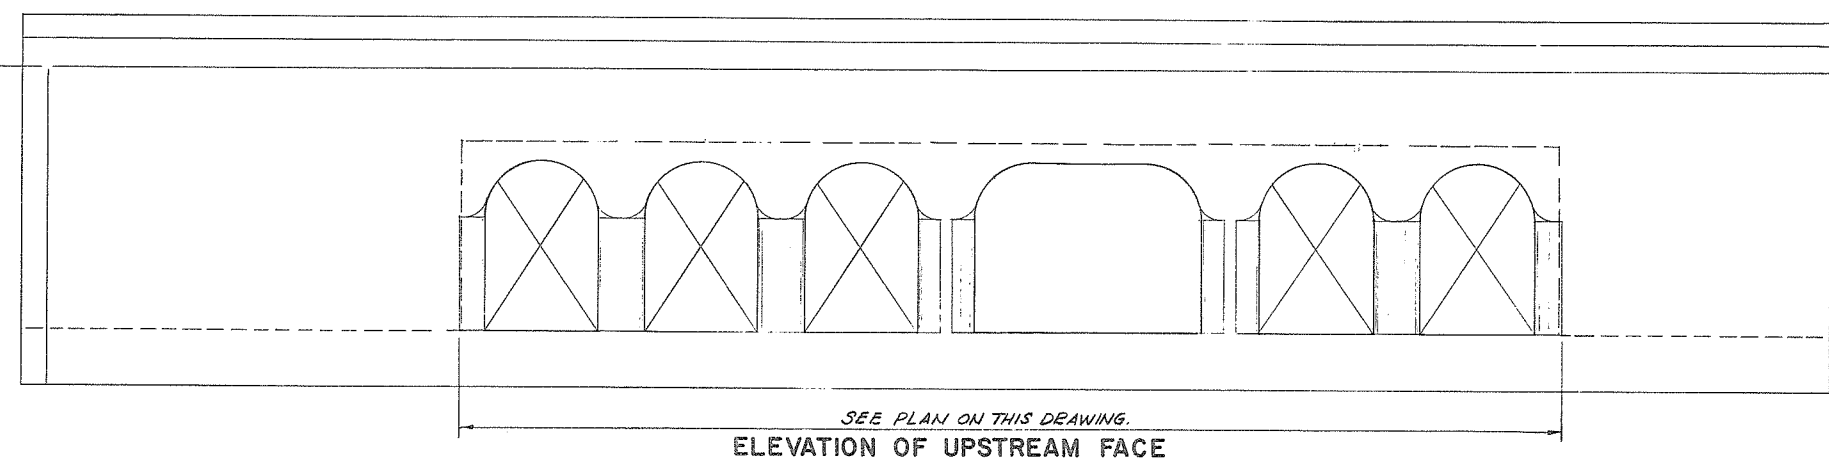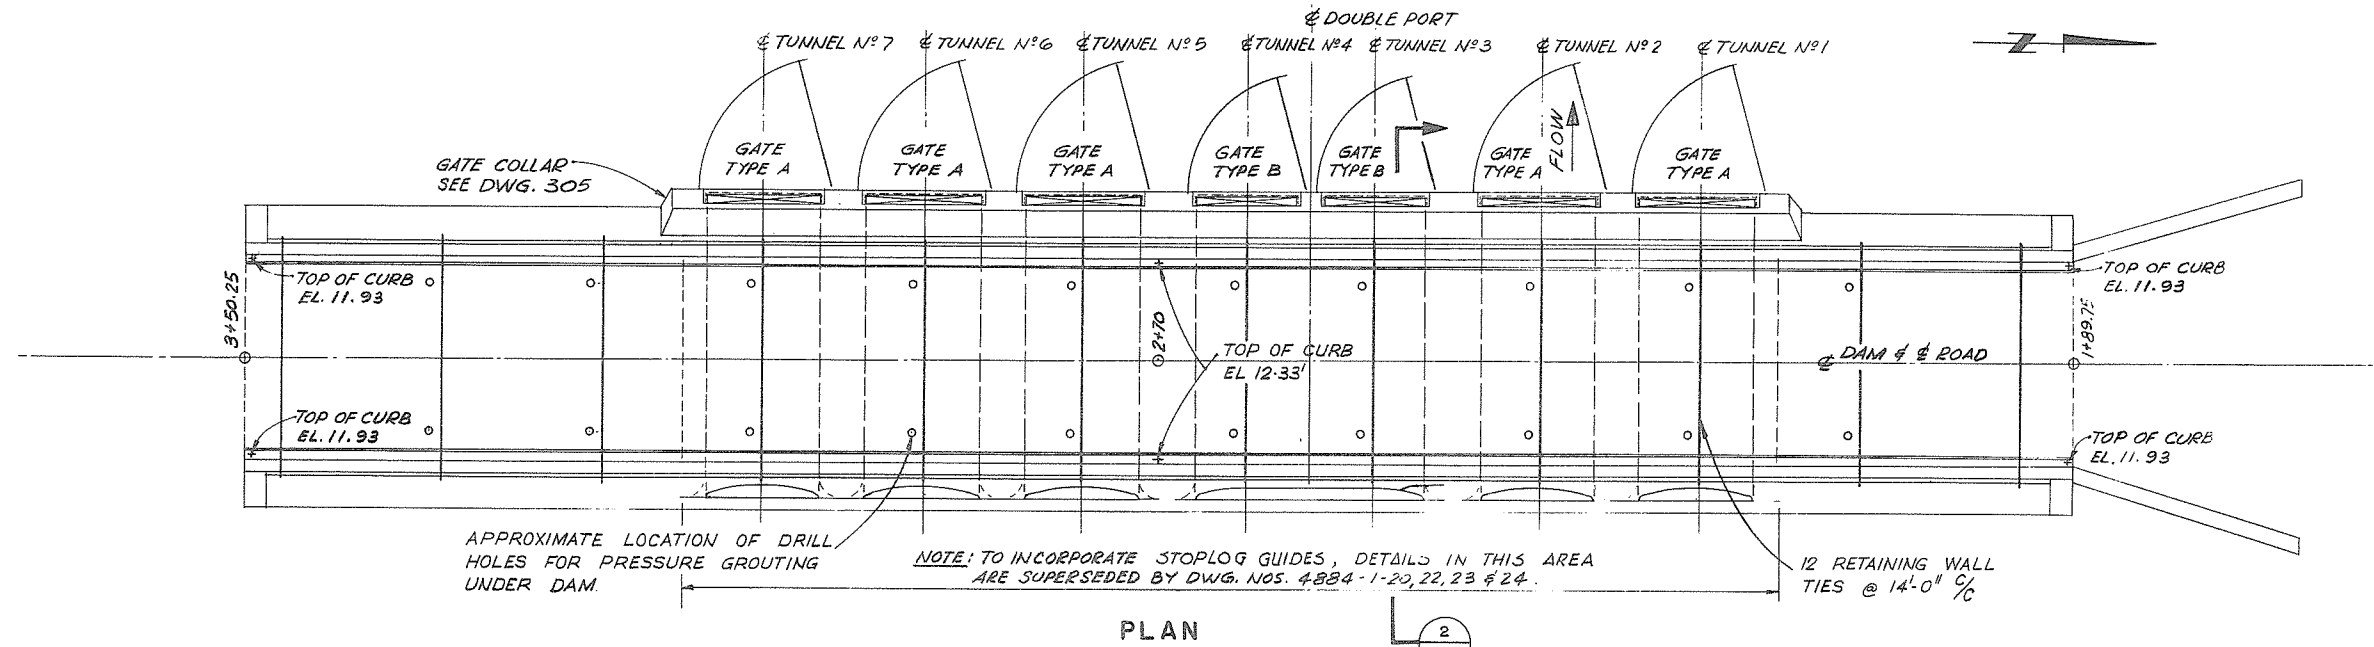




NO.	DATE	BY	REVISIONS	ENG.
1	16.6.75	VW	AS CONSTRUCTED	

APPROVED  
 THE FRASER RIVER JOINT PROGRAM COMMITTEE  
 DATE: 11.8.77  
 APPROVED  
 FOR THE PROVINCE OF BRITISH COLUMBIA  
 DATE: 11.8.77

PROJECT NO. 10-1	CONTRACT NO. 1	A.E.S.L. DRAWING NO. 4064-07-308
THE GOVERNMENT OF THE PROVINCE OF BRITISH COLUMBIA DEPT. OF LANDS, FORESTS AND WATER RESOURCES WATER RESOURCES SERVICE		<b>AESL</b> ASSOCIATED ENGINEERING SERVICES LTD. VANCOUVER, B.C.
CANADA - BRITISH COLUMBIA FRASER RIVER FLOOD CONTROL 1968 AGREEMENT DISTRICT OF SURREY		DESIGN: G.J.O.V. DRAWN: G.J.O.V. CHECKED: W.P.L. DATE: AUGUST 1972 DRAWING NO. 4884-1-14 REV. 1
TITLE: SERPENTINE DAM GENERAL ARRANGEMENT PLAN AND SECTIONS		

SUPERSEDES ALL PREVIOUS PRINTS WITH A NUMBER LOWER THAN 1



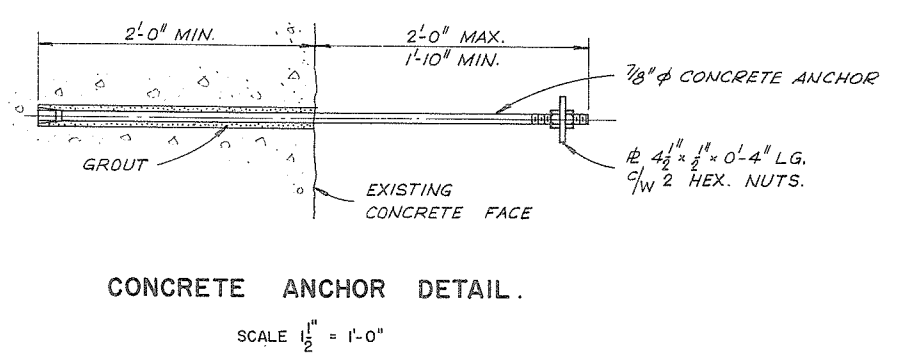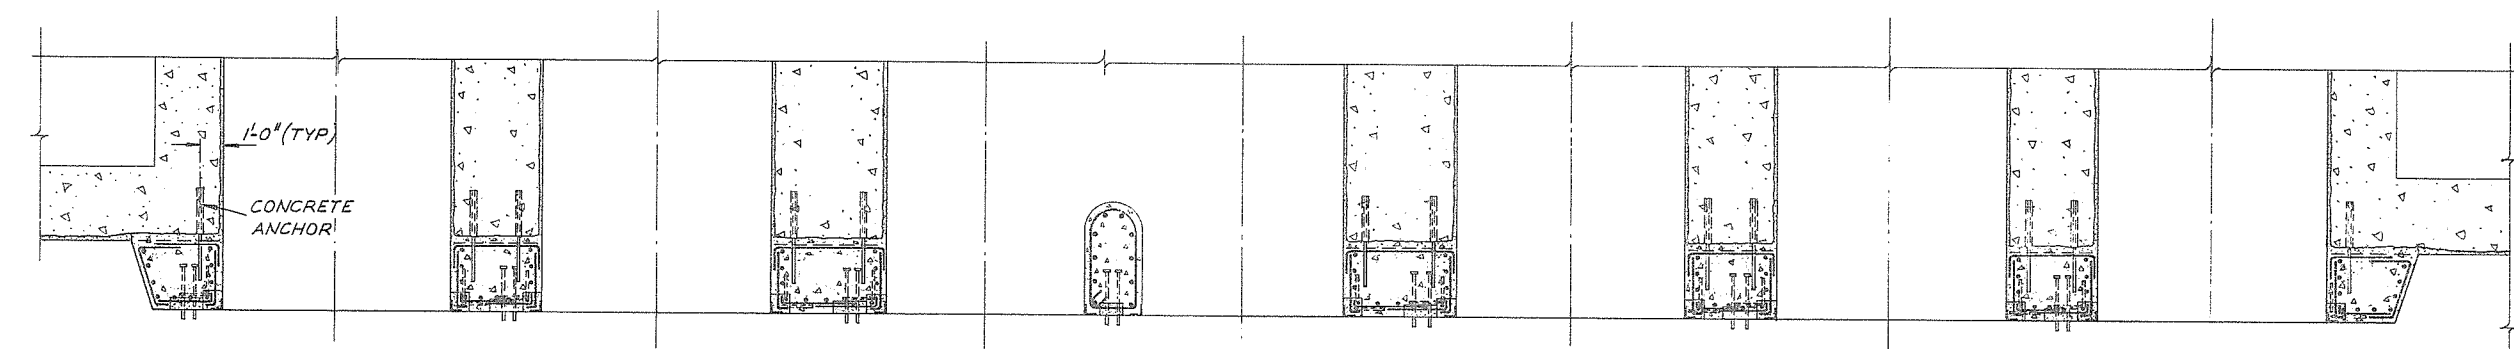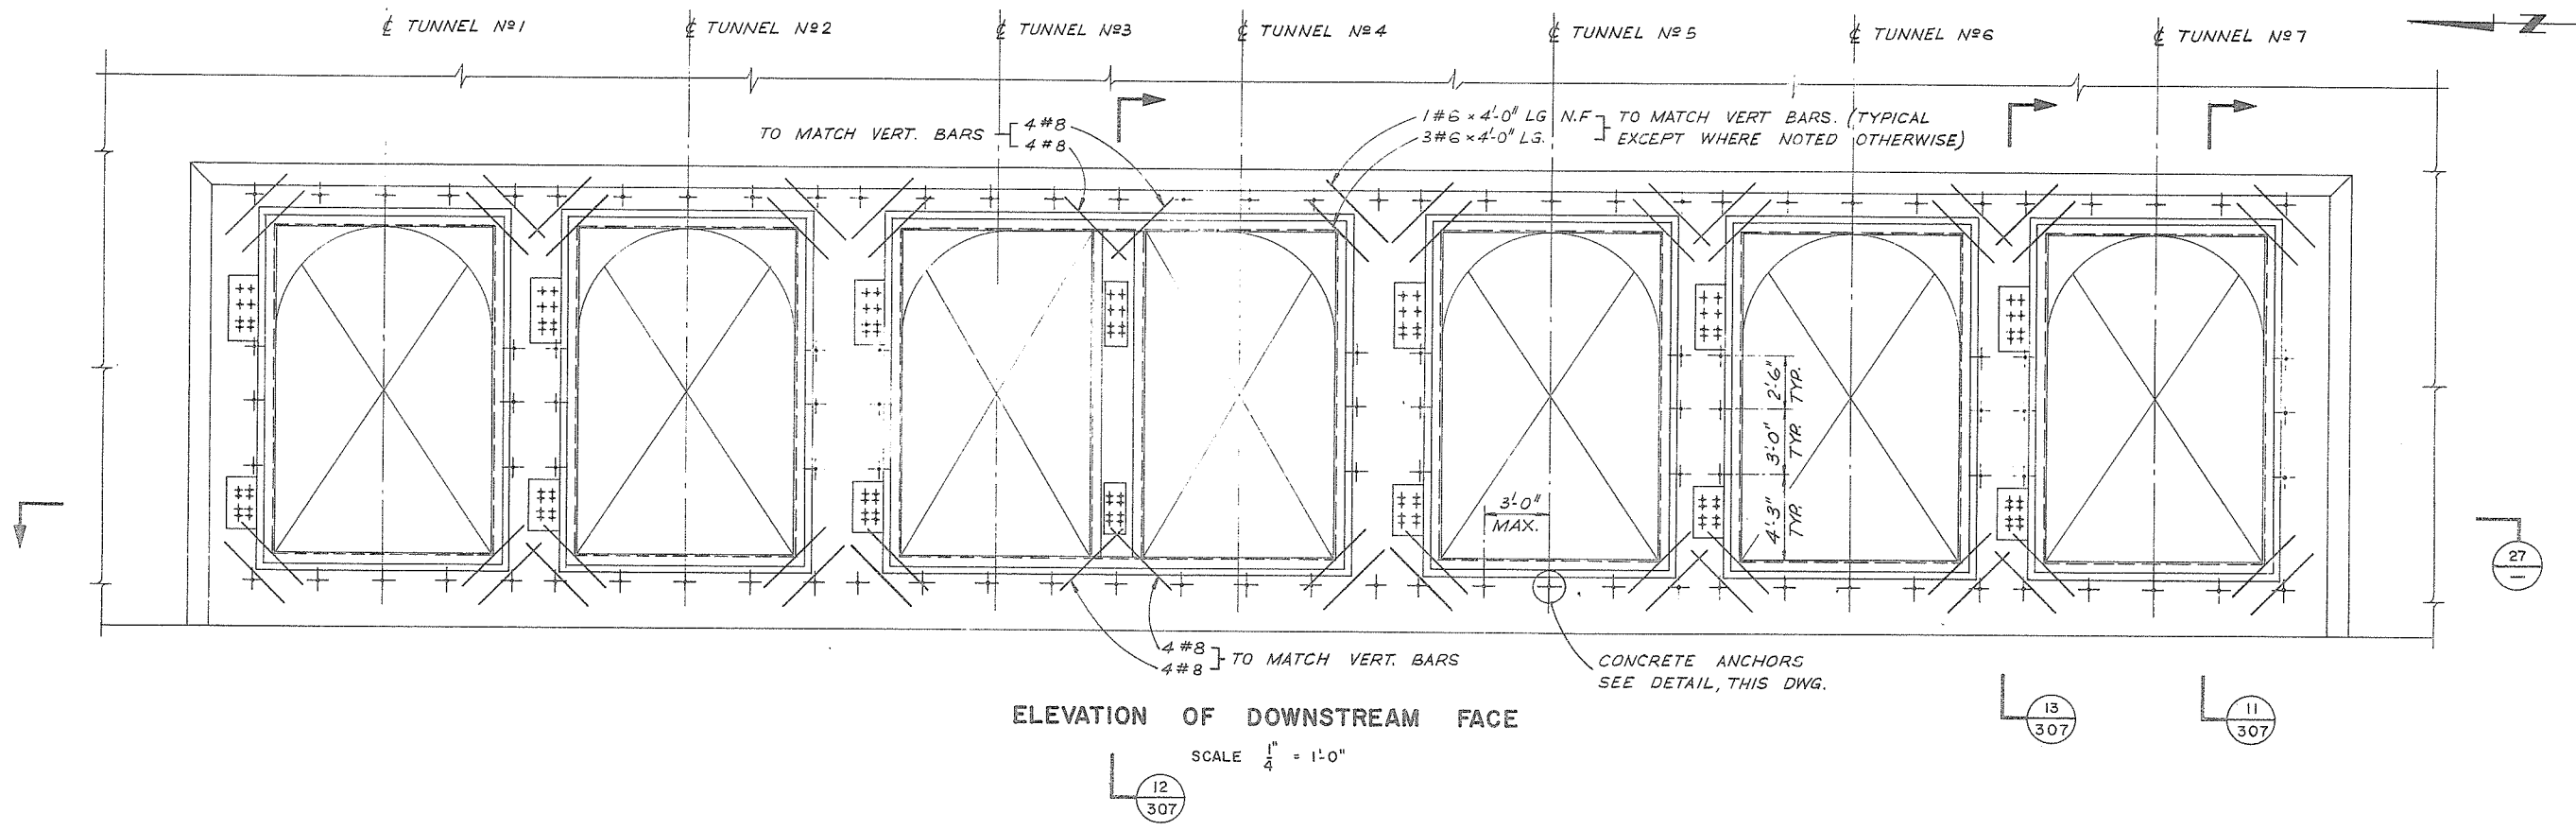


NO.	DATE	BY	REVISIONS	ENG.
1	16.6.75	WV	AS CONSTRUCTED	

DATE 11 Sept 72  
 APPROVED  
 THE FRASER RIVER JOINT PROGRAM COMMITTEE  
 DATE 10 Oct 72  
 APPROVED  
 FOR THE PROVINCE OF BRITISH COLUMBIA

PROJECT NO. 10-1	CONTRACT NO. 1	A.E.S.L. DRAWING NO. 4064-07-310
THE GOVERNMENT OF THE PROVINCE OF BRITISH COLUMBIA DEPT. OF LANDS, FORESTS AND WATER RESOURCES WATER RESOURCES SERVICE		105341
CANADA - BRITISH COLUMBIA FRASER RIVER FLOOD CONTROL 1968 AGREEMENT DISTRICT OF SURREY		AESL ASSOCIATED ENGINEERING SERVICES LTD. Consulting Engineers VANCOUVER, B.C.
TITLE	DESIGN	SCALE AS NOTED
SERPENTINE DAM GATE COLLAR ELEVATION AND SECTION REINFORCEMENT	W.F. Kelly	
	DRAWN PW	DATE AUGUST 1972
	CHECKED W.F.K.	APPROVED [Signature]
	DRAWING NO. 4884-1-16	REV. 1


SUPERSEDES ALL PREVIOUS PRINTS WITH A NUMBER LOWER THAN 1

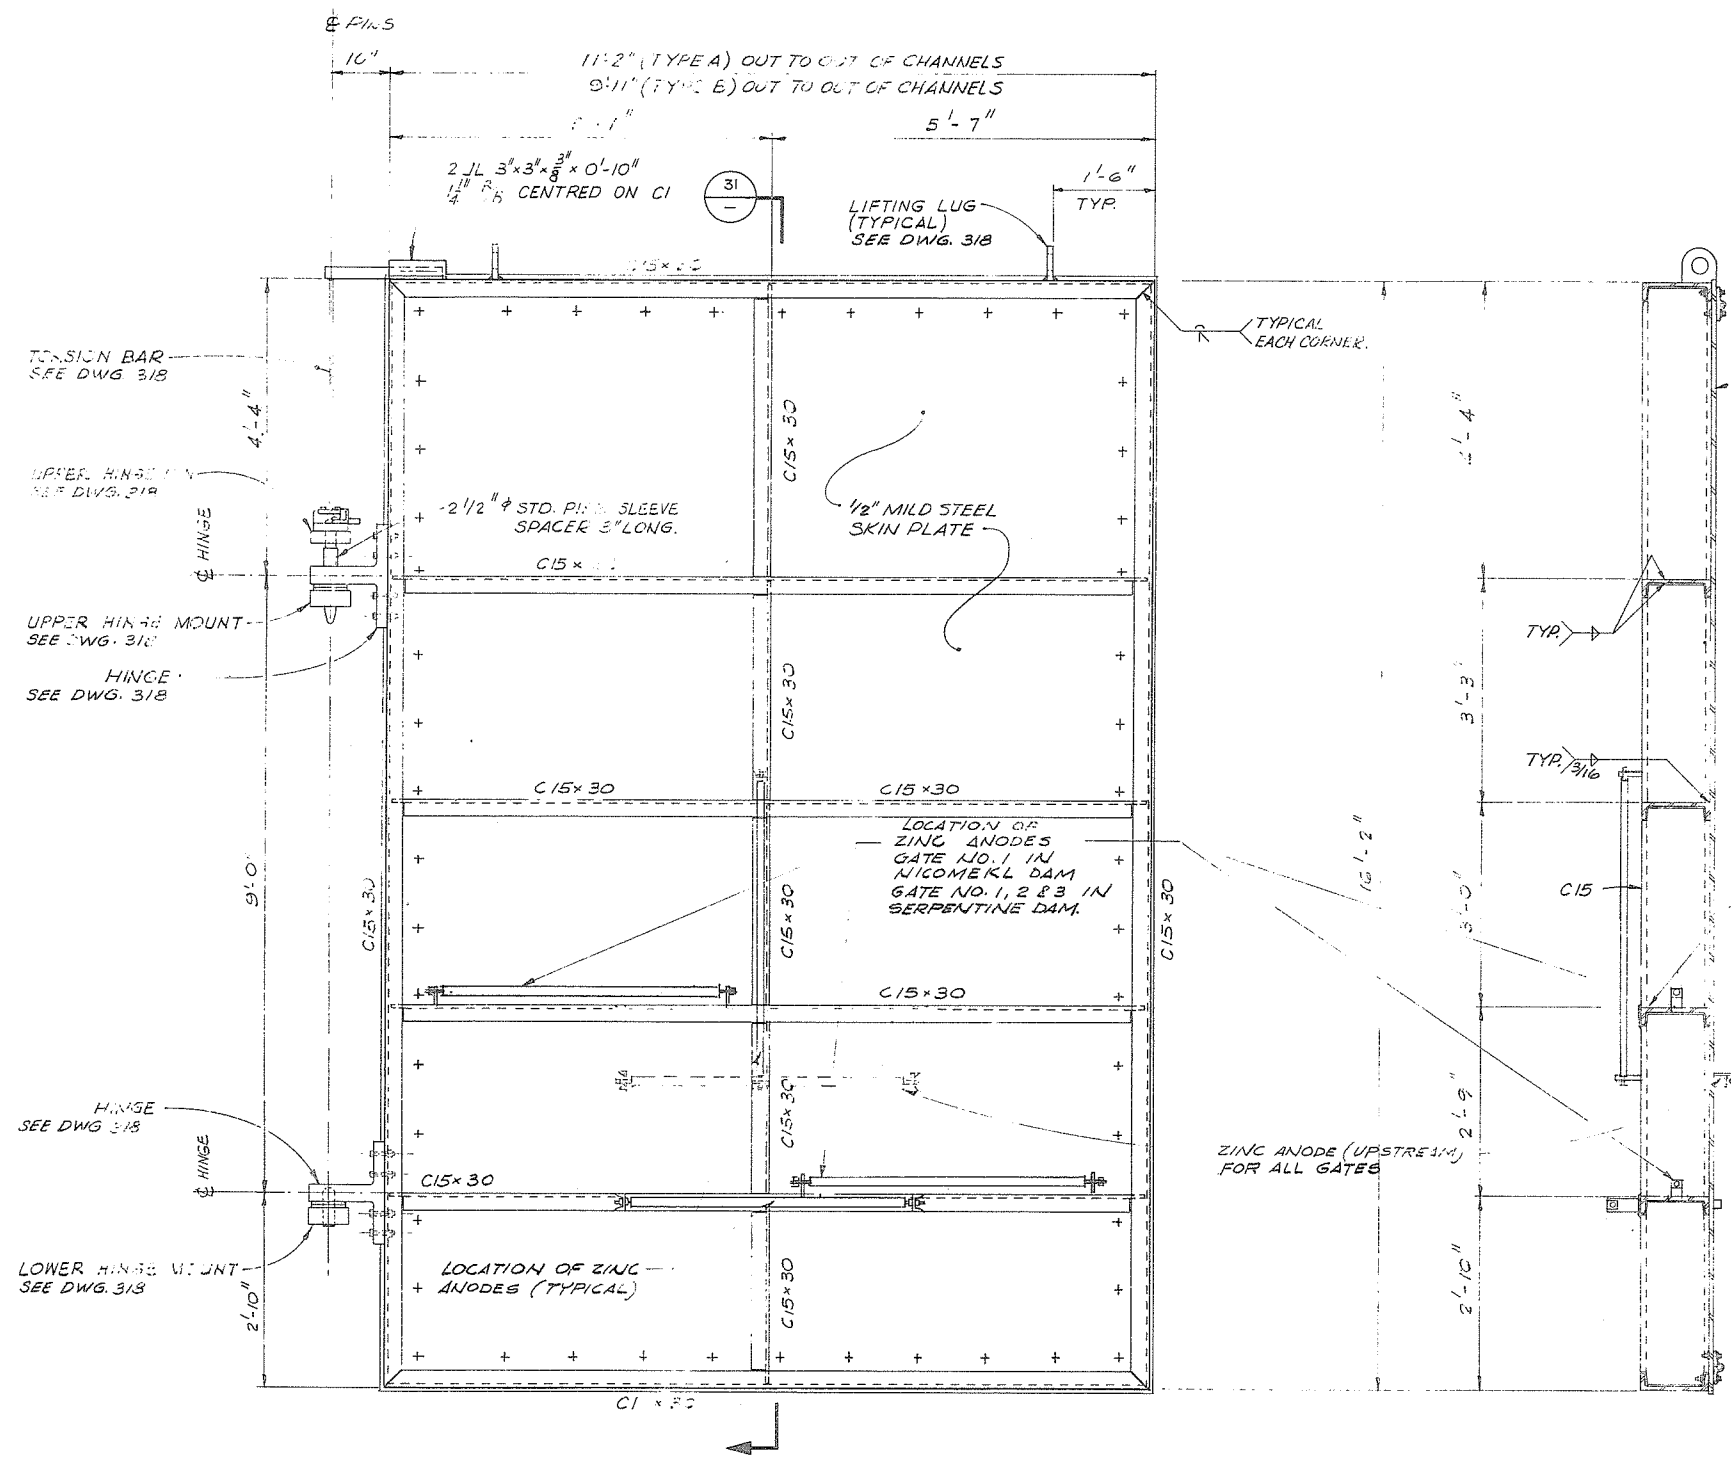

FLOOD GATE - ELEVATION.  
3/4" = 1'-0"

10 TYPE A REQD.  
4 TYPE B REQD.

NOTE: LOCATIONS OF ANODES FOR NICOMEKL DAM FLOOD GATES SEE DWG. 4884-1-7  
LOCATIONS OF ANODES FOR SERPENTINE DAM FLOOD GATES SEE DWG. 4884-1-14

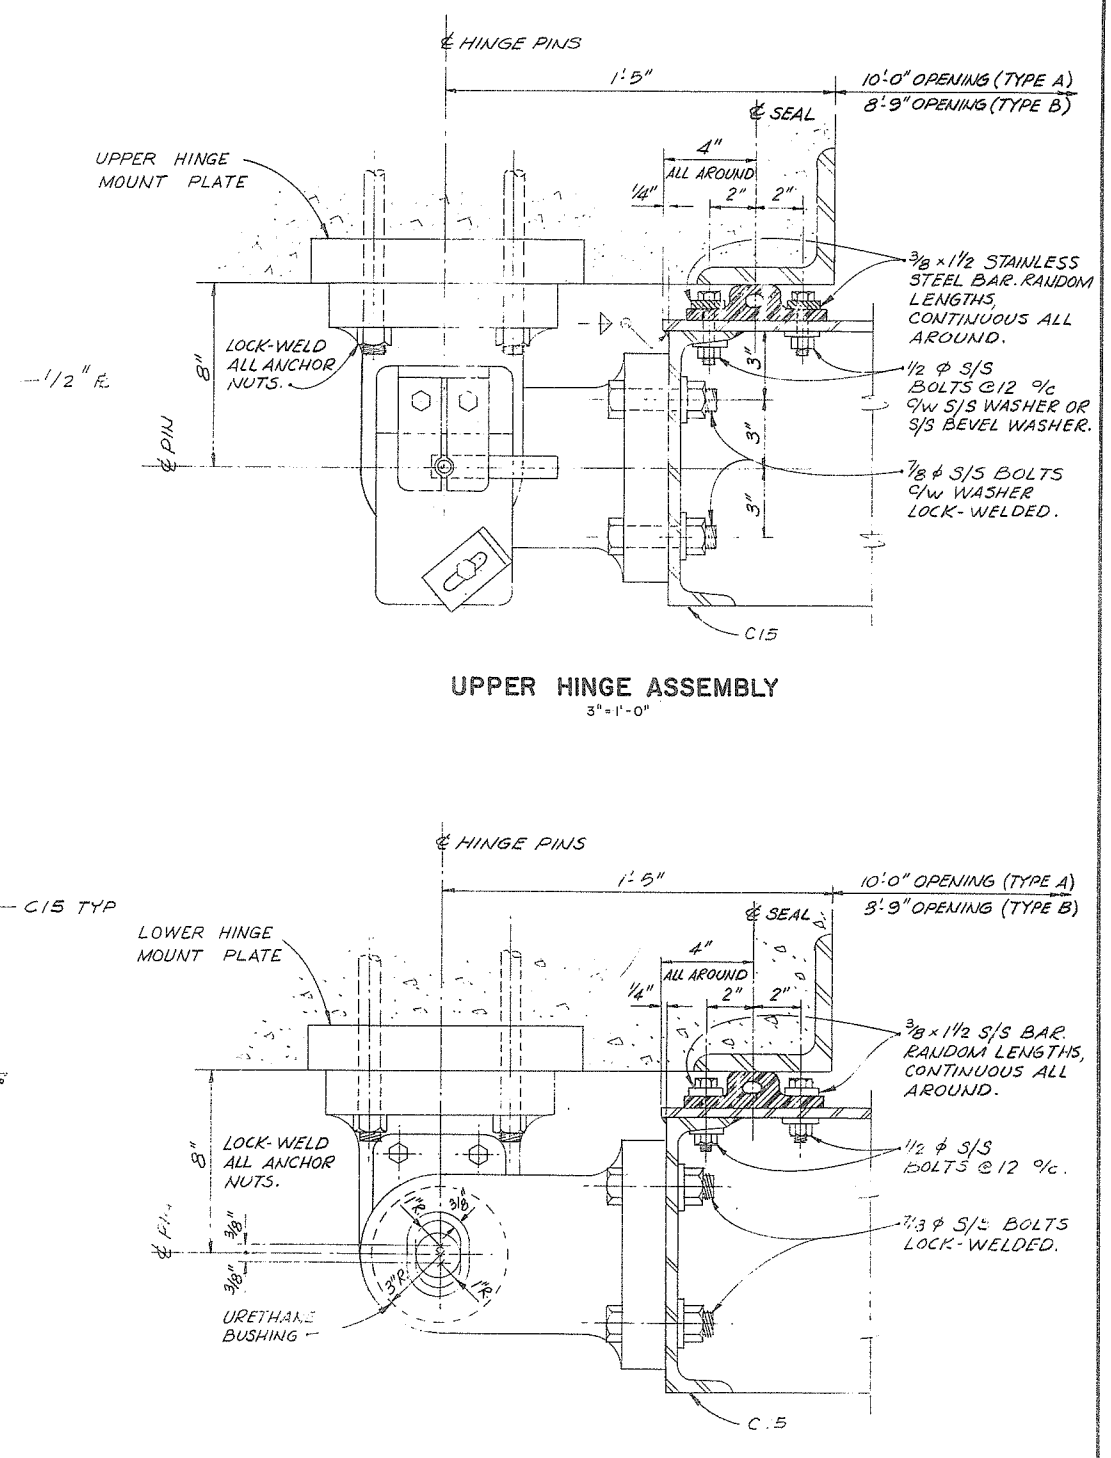

UPPER HINGE ASSEMBLY  
3'-1'-0"

LOWER HINGE ASSEMBLY  
3'-1'-0"

NOTES :-  
• ANODES AND SUPPORTING BRACKETS TO BE SUPPLIED AT SITE BY THE PROVINCE.  
• CONTRACTOR SHALL MOUNT ANODES AFTER GATES ARE INSTALLED AND SHALL TOUCH-UP PAINT AS REQUIRED.  
• ALL HINGE CONTACT SURFACES TO BE FINISHED TO 125/


PROJECT NO. 10-1		CONTRACT NO. 1		A.E.S.L. DRAWING NO. 4064-07-311	
THE GOVERNMENT OF THE PROVINCE OF BRITISH COLUMBIA DEPT. OF LANDS, FORESTS AND WATER RESOURCES WATER RESOURCES SERVICE				105342 AESL ASSOCIATED ENGINEERING SERVICES LTD. VANCOUVER, B.C.	
CANADA - BRITISH COLUMBIA FRASER RIVER FLOOD CONTROL 1968 AGREEMENT DISTRICT OF SURREY				DESIGN <i>W. F. Kelly</i> SCALE AS NOTED	
TITLE NICOMEKL AND SERPENTINE DAMS FLOOD GATE AND HINGE ELEVATION AND SECTION				DRAWN AT B.G.J.O.V. DATE AUGUST, 1972	
FOR THE PROVINCE OF BRITISH COLUMBIA				CHECKED <i>W.F.K.</i> APPROVED <i>[Signature]</i>	
DRAWING NO. 4884-1-17		REVISIONS		REV. 1	

SUPERSEDES ALL PREVIOUS PRINTS WITH A NUMBER LOWER THAN









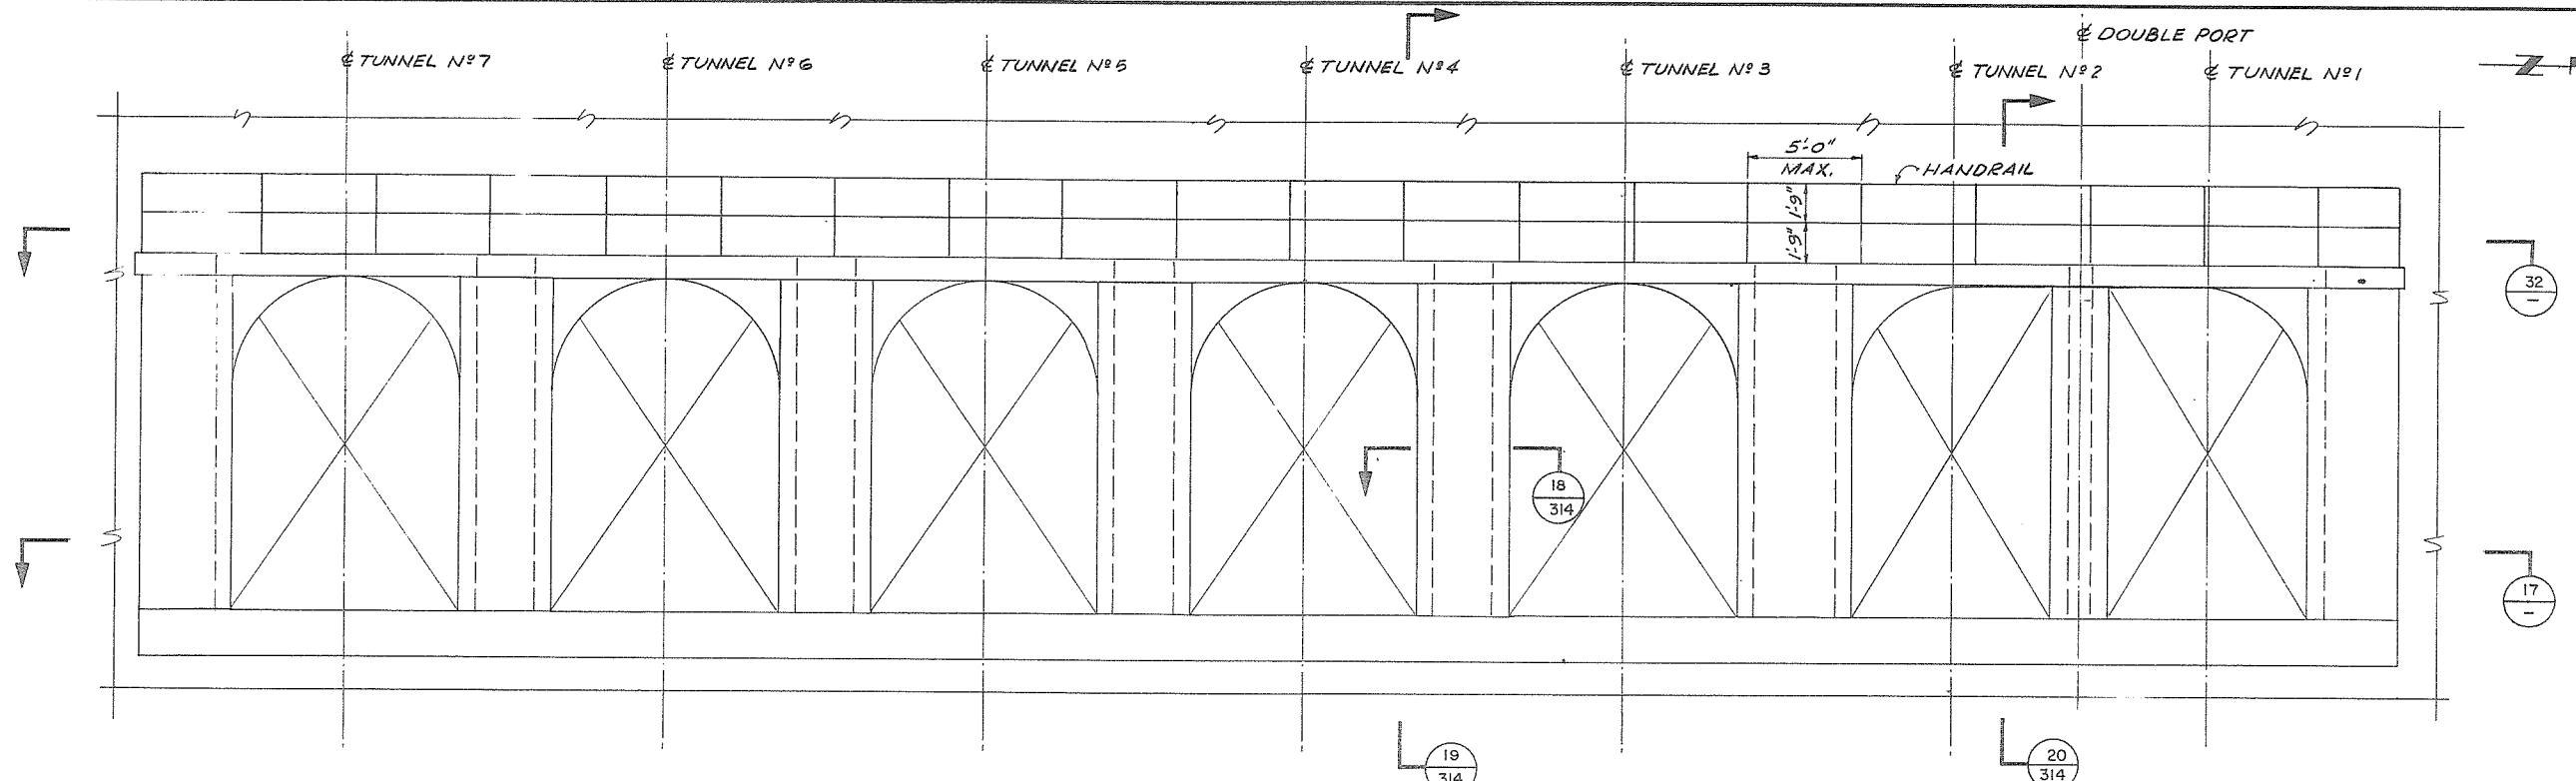

ELEVATION OF UPSTREAM FACE

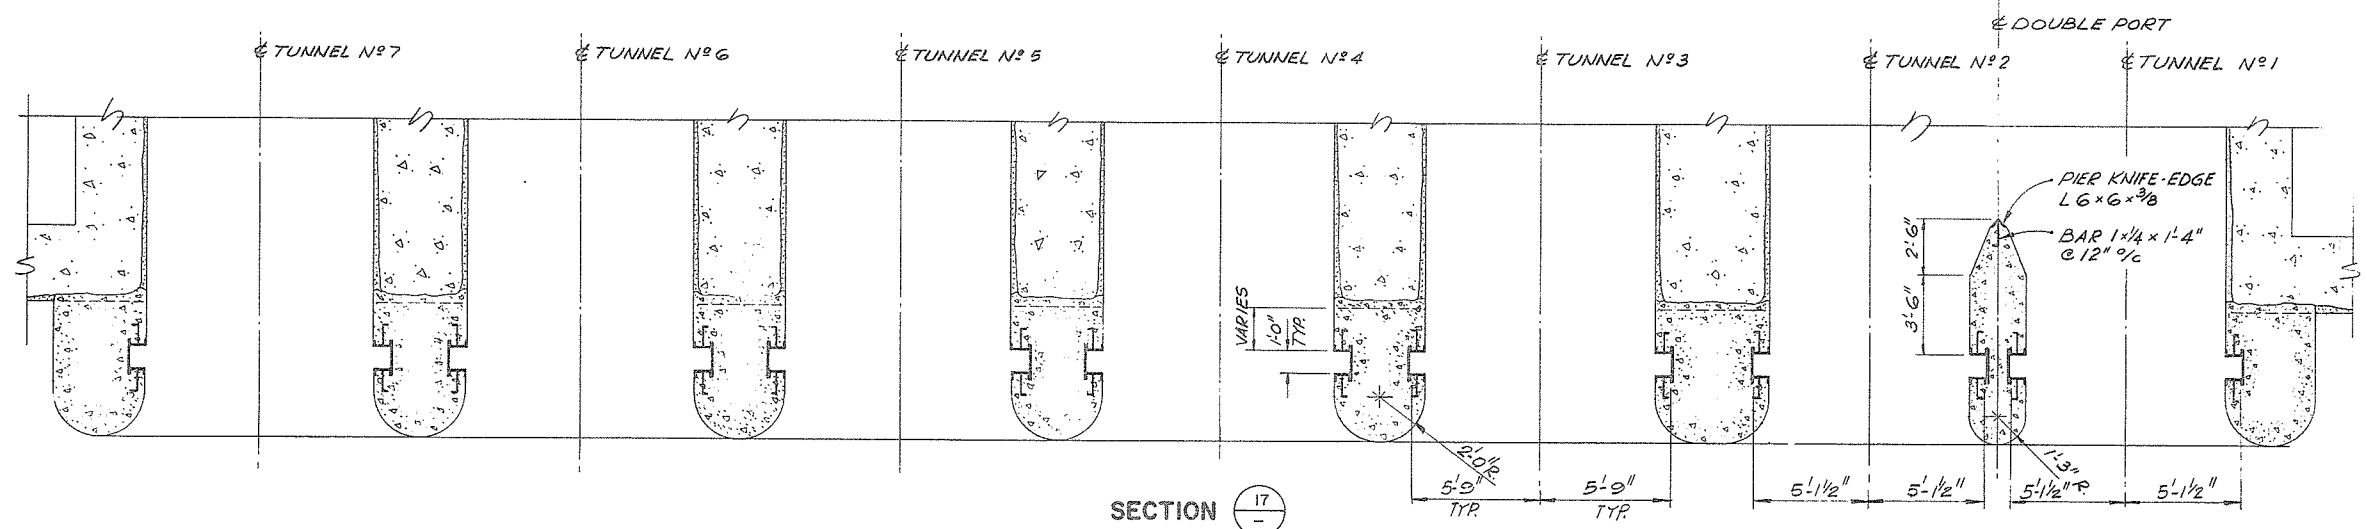

SECTION 17

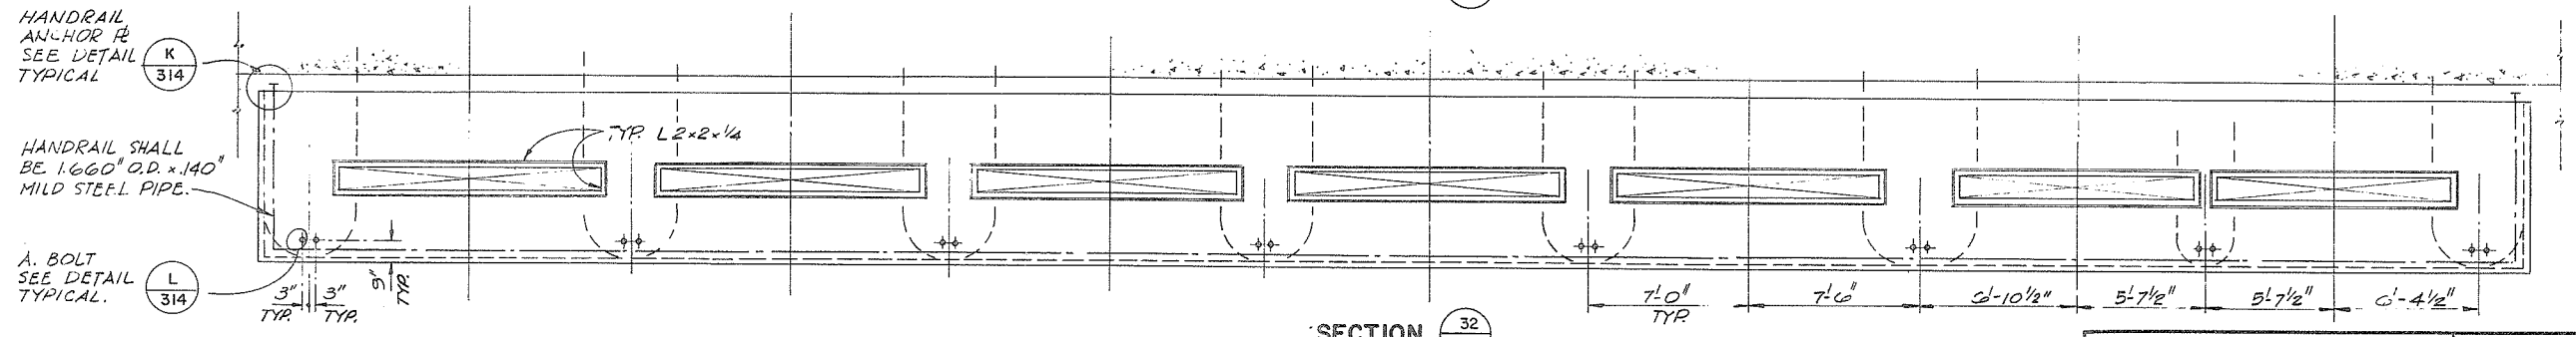

SECTION 32


HANDRAIL ANCHOR K SEE DETAIL TYPICAL

HANDRAIL SHALL BE 1.660\"/>


A. BOLT SEE DETAIL TYPICAL.

PROJECT NO. 10.1	CONTRACT NO. 1	A.E.S.L. DRAWING NO. 4064-07-313
THE GOVERNMENT OF THE PROVINCE OF BRITISH COLUMBIA DEPT. OF LANDS, FORESTS AND WATER RESOURCES WATER RESOURCES SERVICE		<b>AESL</b> ASSOCIATED ENGINEERING SERVICES LTD. VANCOUVER, B.C.
CANADA - BRITISH COLUMBIA FRASER RIVER JOINT PROGRAM COMMITTEE DISTRICT OF SURREY		DESIGN <i>WJK</i> DRAWN <i>G.J.Q.V.</i> CHECKED <i>W.P. Kelly</i> DATE <i>10.3.72</i> APPROVED <i>[Signature]</i> FOR THE PROVINCE OF BRITISH COLUMBIA
TITLE NICOMEKL DAM STOPLOG GUIDES ELEVATION AND SECTION CONCRETE		SCALE 1/4" = 1'-0" DATE SEPT. 1972 DRAWING NO. 4884-1-19 REV. 1


NO.	DATE	BY	REVISIONS	ENG.
1	16.6.75	[Signature]	AS CONSTRUCTED	

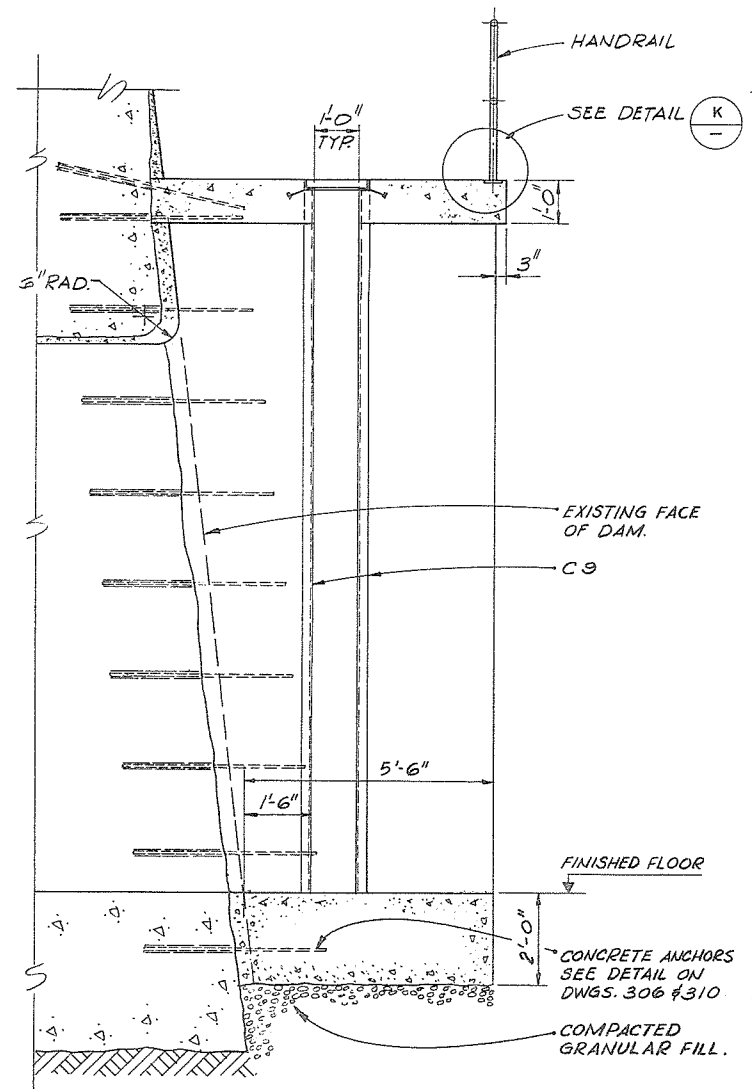


SECTION  $\frac{19}{313}$  -  $\frac{19}{317}$   
SCALE 1/2" = 1'-0"

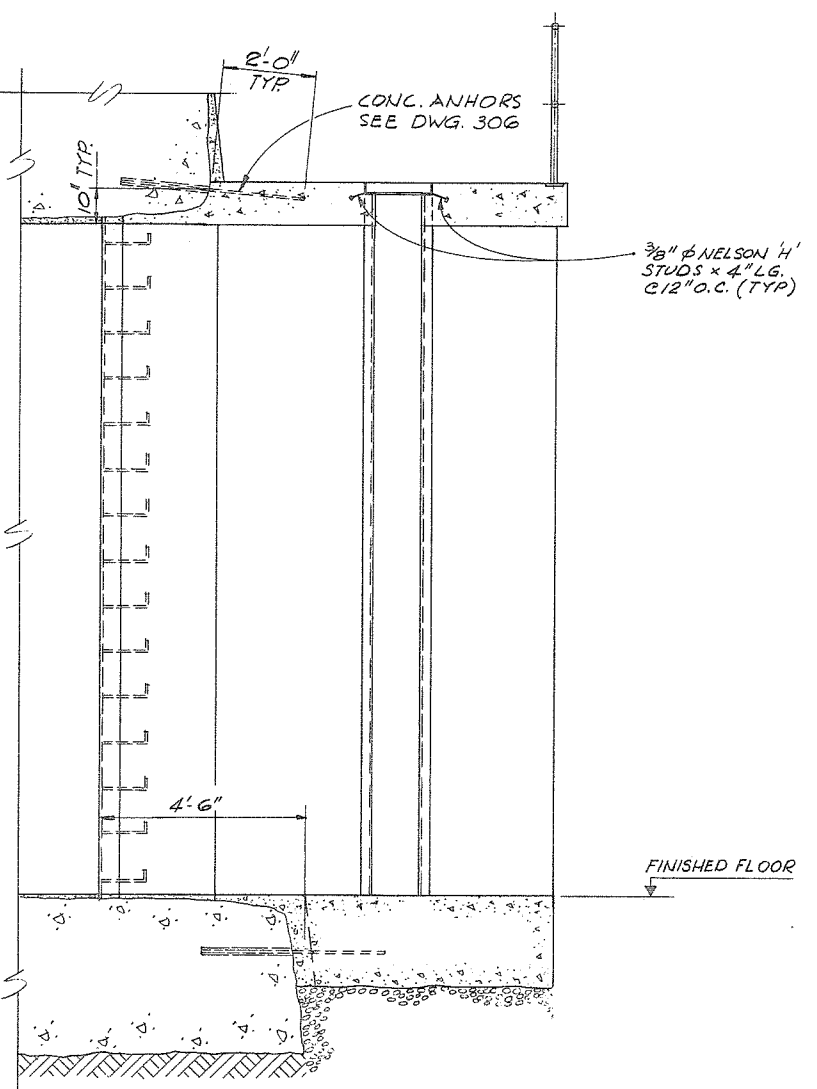


SECTION  $\frac{20}{313}$  -  $\frac{20}{317}$   
SCALE 1/2" = 1'-0"

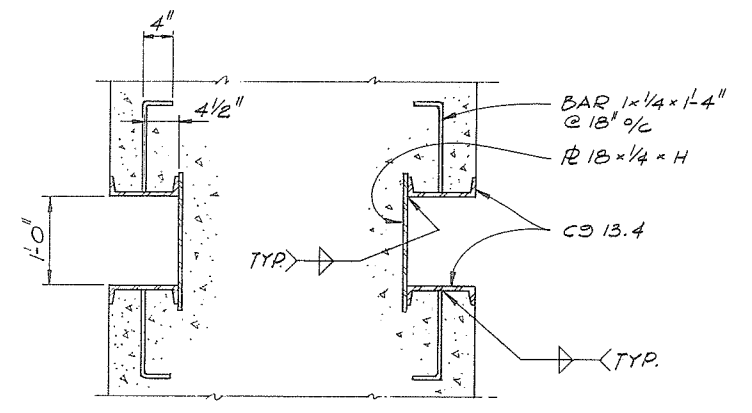


SECTION  $\frac{18}{313}$  -  $\frac{18}{317}$   
SCALE 1" = 1'-0"

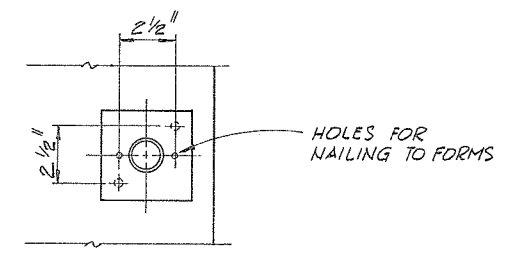

PLAN

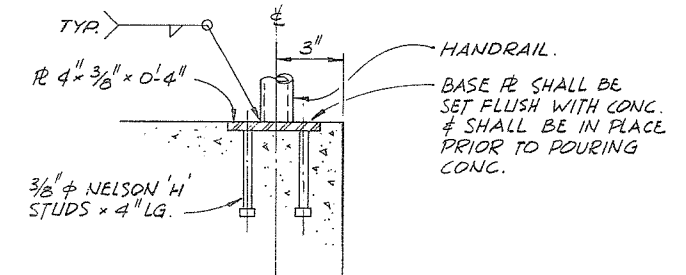


DETAIL  $\frac{K}{313}$  -  $\frac{K}{317}$   
SCALE 3" = 1'-0"

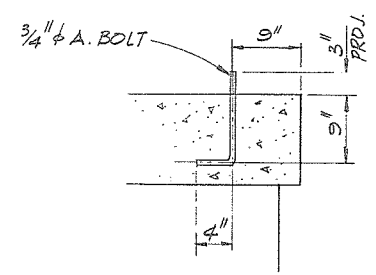


DETAIL  $\frac{L}{313}$  -  $\frac{L}{317}$   
SCALE 1" = 1'-0"

PROJECT NO. 10-1		CONTRACT NO. 1		A.E.S.L. DRAWING NO. 4064-07-314	
THE GOVERNMENT OF THE PROVINCE OF BRITISH COLUMBIA DEPT. OF LANDS, FORESTS AND WATER RESOURCES WATER RESOURCES SERVICE				<b>AESL</b> ASSOCIATED ENGINEERING SERVICES LTD. VANCOUVER, B.C.	
CANADA - BRITISH COLUMBIA FRASER RIVER FLOOD CONTROL 1968 AGREEMENT DISTRICT OF SURREY				DESIGN: <i>W.K.</i> DRAWN: G.J.O.V. CHECKED: <i>W.P. Kelly</i> DATE: 16.6.75 APPROVED: <i>[Signature]</i> FOR THE PROVINCE OF BRITISH COLUMBIA	
TITLE: NICOMEKL AND SERPENTINE DAMS STOPLOG GUIDES SECTIONS AND DETAILS CONCRETE				SCALE AS SHOWN DATE: SEPT. 1972 APPROVED: <i>[Signature]</i> DRAWING NO. 4864-1-20 REV. 1	
NO. 1 DATE 16.6.75 BY <i>[Signature]</i>		AS CONSTRUCTED		REVISIONS ENG. <i>[Signature]</i>	

SUPERSEDES ALL PREVIOUS PRINTS WITH A NUMBER LOWER THAN  $\Delta$

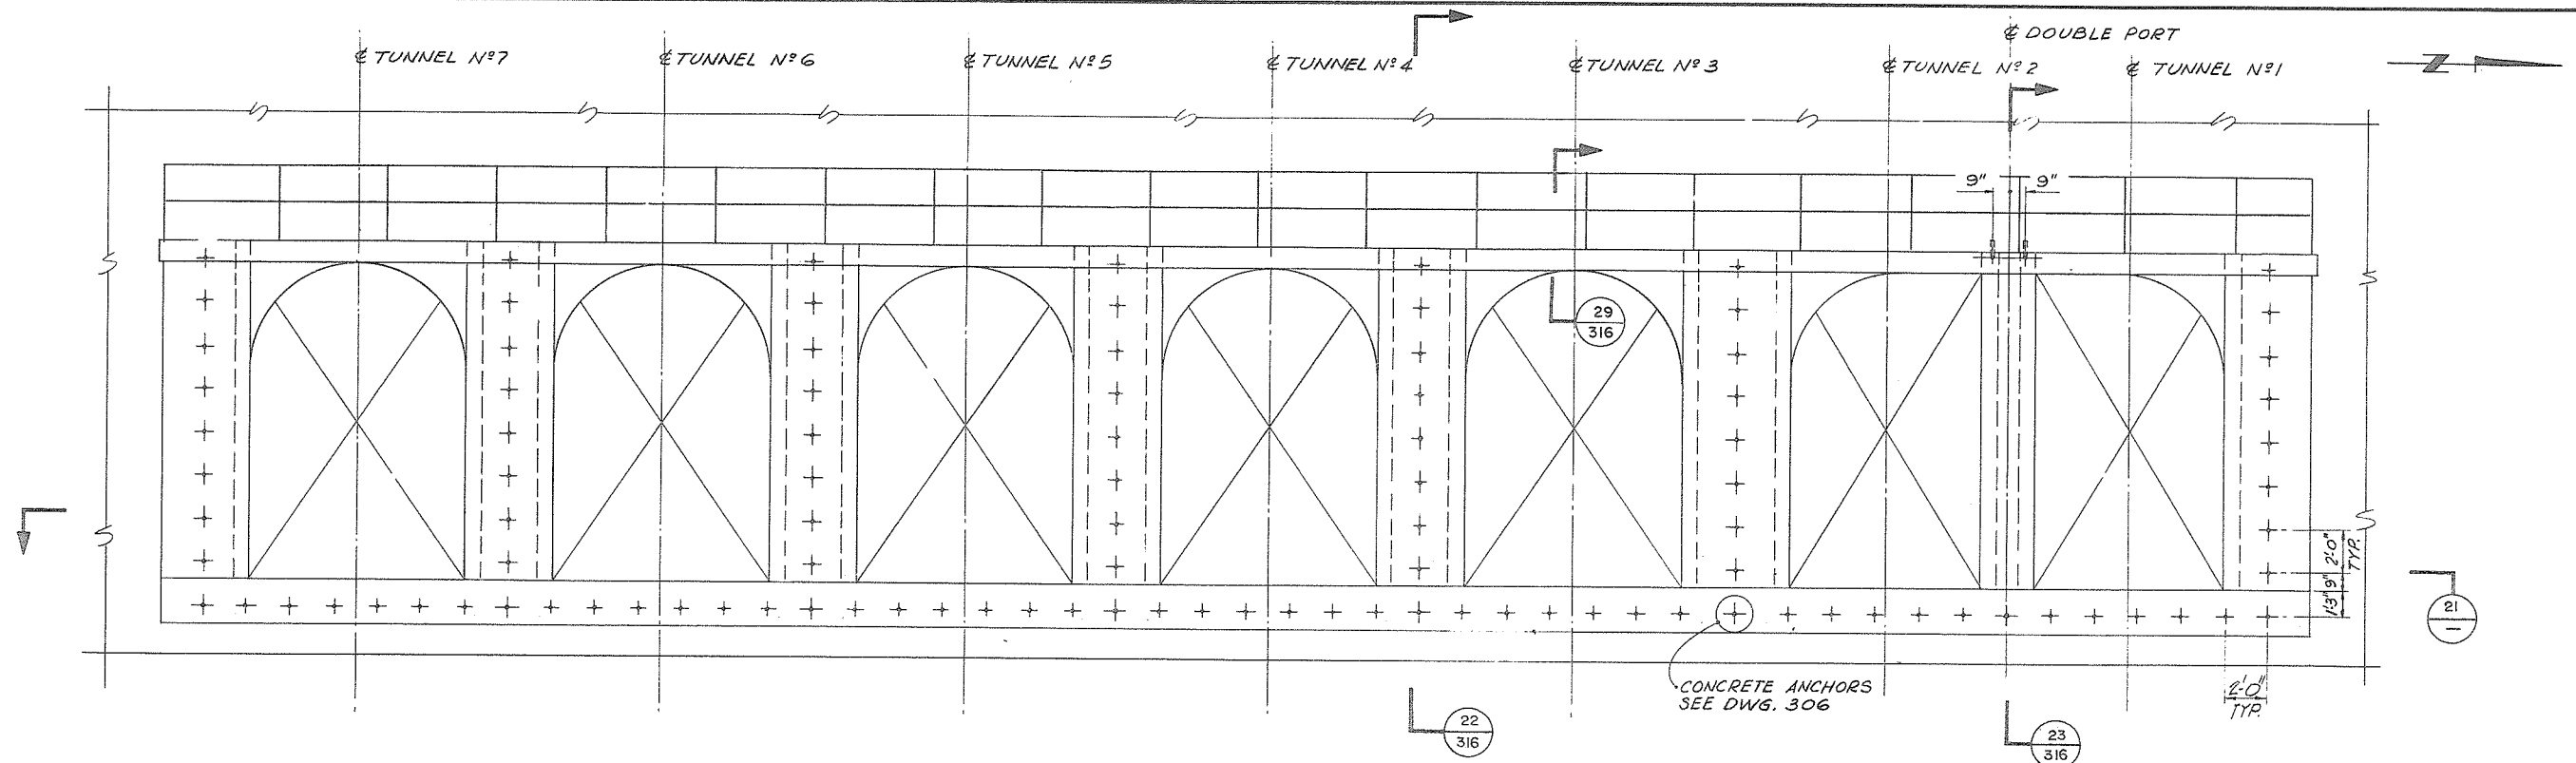

ELEVATION OF UPSTREAM FACE

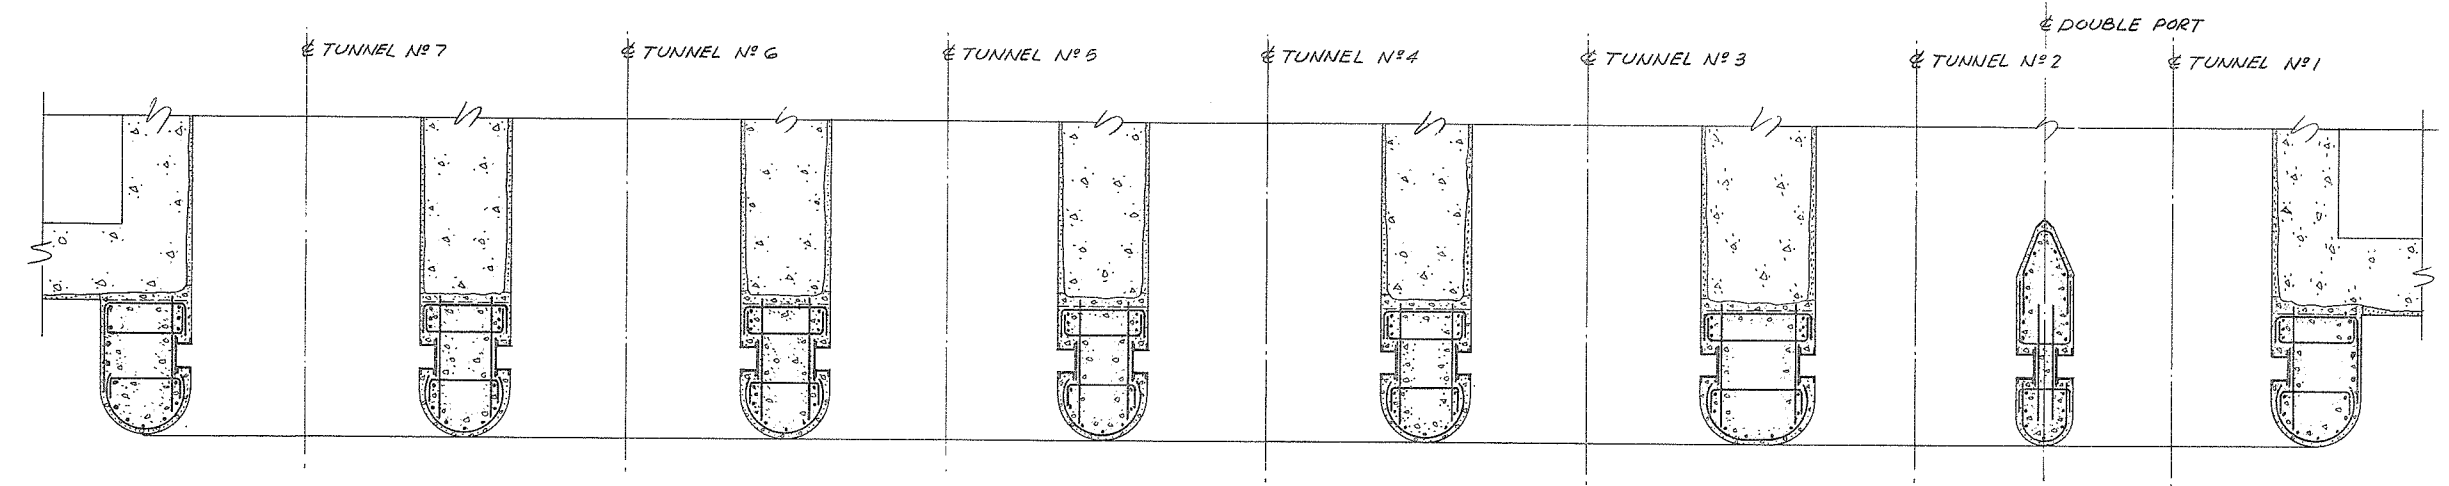


SECTION 21


FOR DETAILS OF REINFORCING  
SEE DWG 316.

		PROJECT NO. 10.1	CONTRACT NO. 1	A.E.S.L. DRAWING NO. 4064-07-315
		THE GOVERNMENT OF THE PROVINCE OF BRITISH COLUMBIA DEPT. OF LANDS, FORESTS AND WATER RESOURCES WATER RESOURCES SERVICE		<b>105346</b> ASSOCIATED ENGINEERING SERVICES LTD. <small>VANCOUVER, B.C.</small>
		CANADA - BRITISH COLUMBIA FRASER RIVER FLOOD CONTROL 1965 AGREEMENT DISTRICT OF SURREY		DESIGN <i>WJK</i> DRAWN <i>G.J.O.V.</i> CHECKED <i>W.P. Kelly</i>
		TITLE NICOMEKL DAM STOPLOG GUIDES ELEVATION AND SECTION REINFORCEMENT		SCALE 1/4" = 1'-0" DATE <b>SEPT, 1972</b> APPROVED <i>[Signature]</i> DRAWING NO. 4884-1-21
NO.	DATE	BY	REVISIONS	ENG.
1	16.6.75	<i>[Signature]</i>	AS CONSTRUCTED	<i>[Signature]</i>


SUPERSEDES ALL PREVIOUS PRINTS WITH A NUMBER LOWER THAN A

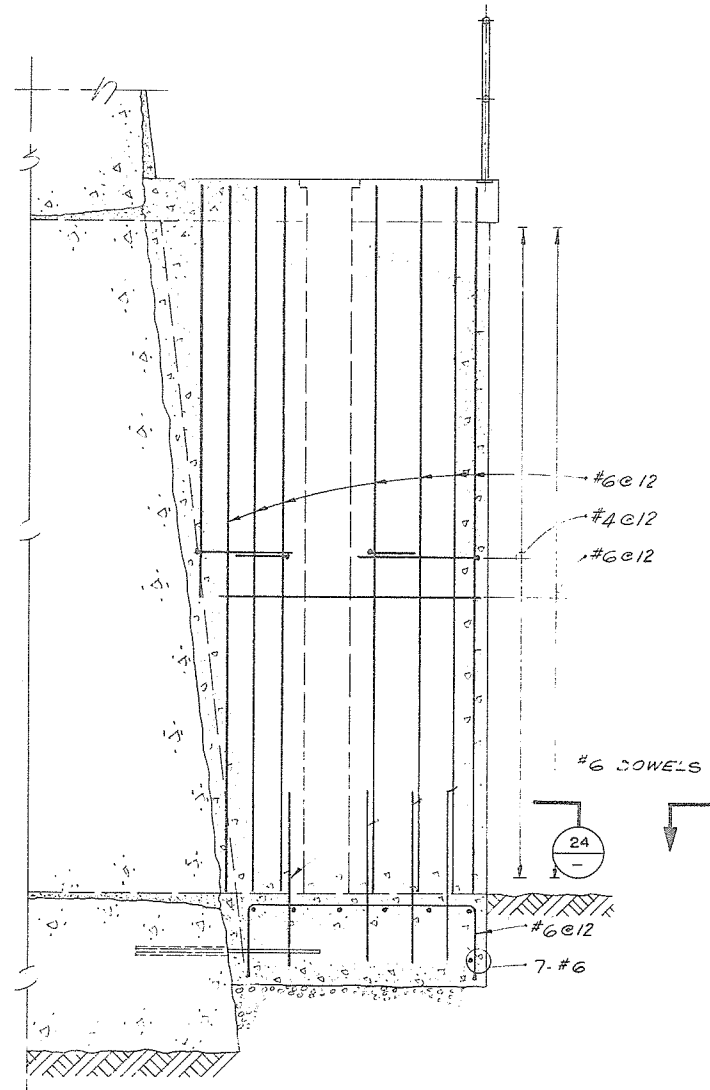


SECTION  $\frac{22}{315}$   $\frac{22}{318}$

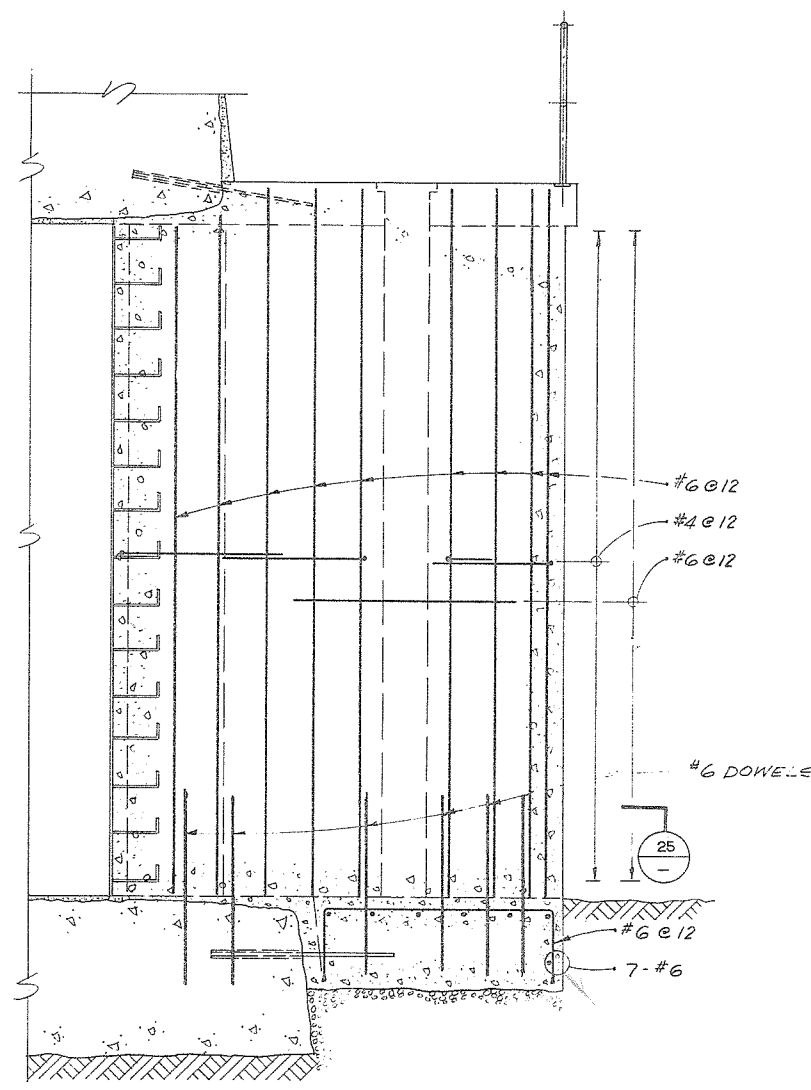


SECTION  $\frac{23}{315}$   $\frac{23}{318}$

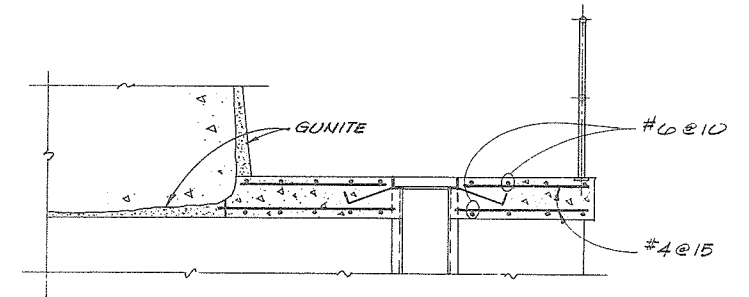

SECTION  $\frac{29}{315}$   $\frac{29}{318}$

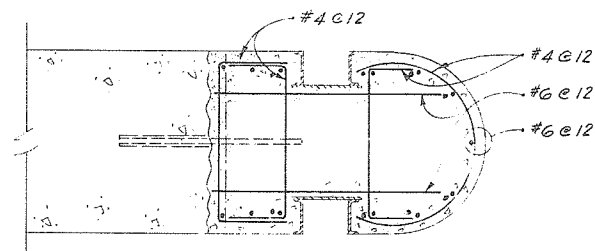

SECTION  $\frac{24}{-}$

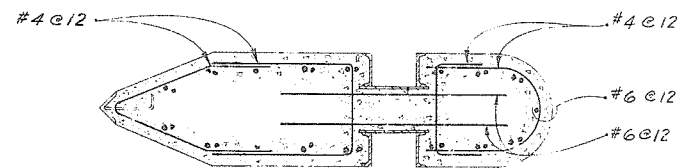

SECTION  $\frac{25}{-}$




NO.	DATE	BY	REVISIONS	ENG.
1	16.6.75	W.W.	AS CONSTRUCTED	



DATE	26 Sept 1972
APPROVED	<i>G. J. V.</i>
DATE	26 Sept 1972
APPROVED	<i>G. J. V.</i>


PROJECT NO. 10-1	CONTRACT NO. 1	A.E.S.L. DRAWING NO. 4064-07-316
THE GOVERNMENT OF THE PROVINCE OF BRITISH COLUMBIA DEPT. OF LANDS, FORESTS AND WATER RESOURCES WATER RESOURCES SERVICE		<b>AESL</b> ASSOCIATED ENGINEERING SERVICES LTD. VANCOUVER, B.C.
CANADA - BRITISH COLUMBIA FRASER RIVER FLOOD CONTROL 1968 AGREEMENT DISTRICT OF SURREY		DESIGN <i>W.K.</i> SCALE 1/2" = 1'-0" DRAWN <i>G.J.V.</i> DATE SEPT. 1972 CHECKED <i>W.K.</i> APPROVED <i>G.J.V.</i>
TITLE NICOMEKL AND SERPENTINE DAMS STOPLOG GUIDES SECTIONS AND DETAILS REINFORCEMENT		DRAWING NO. 4884-1-22 REV. 1

SUPERSEDES ALL PREVIOUS PRINTS WITH A NUMBER LOWER THAN A

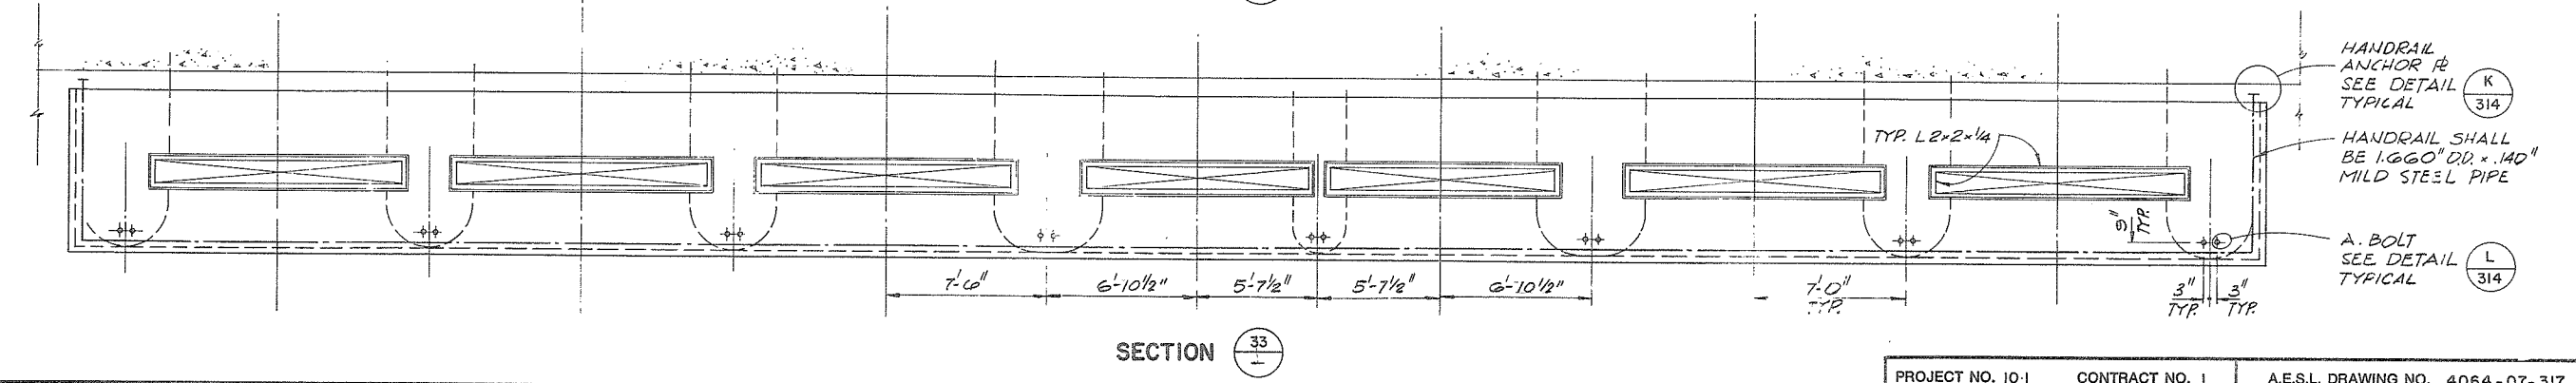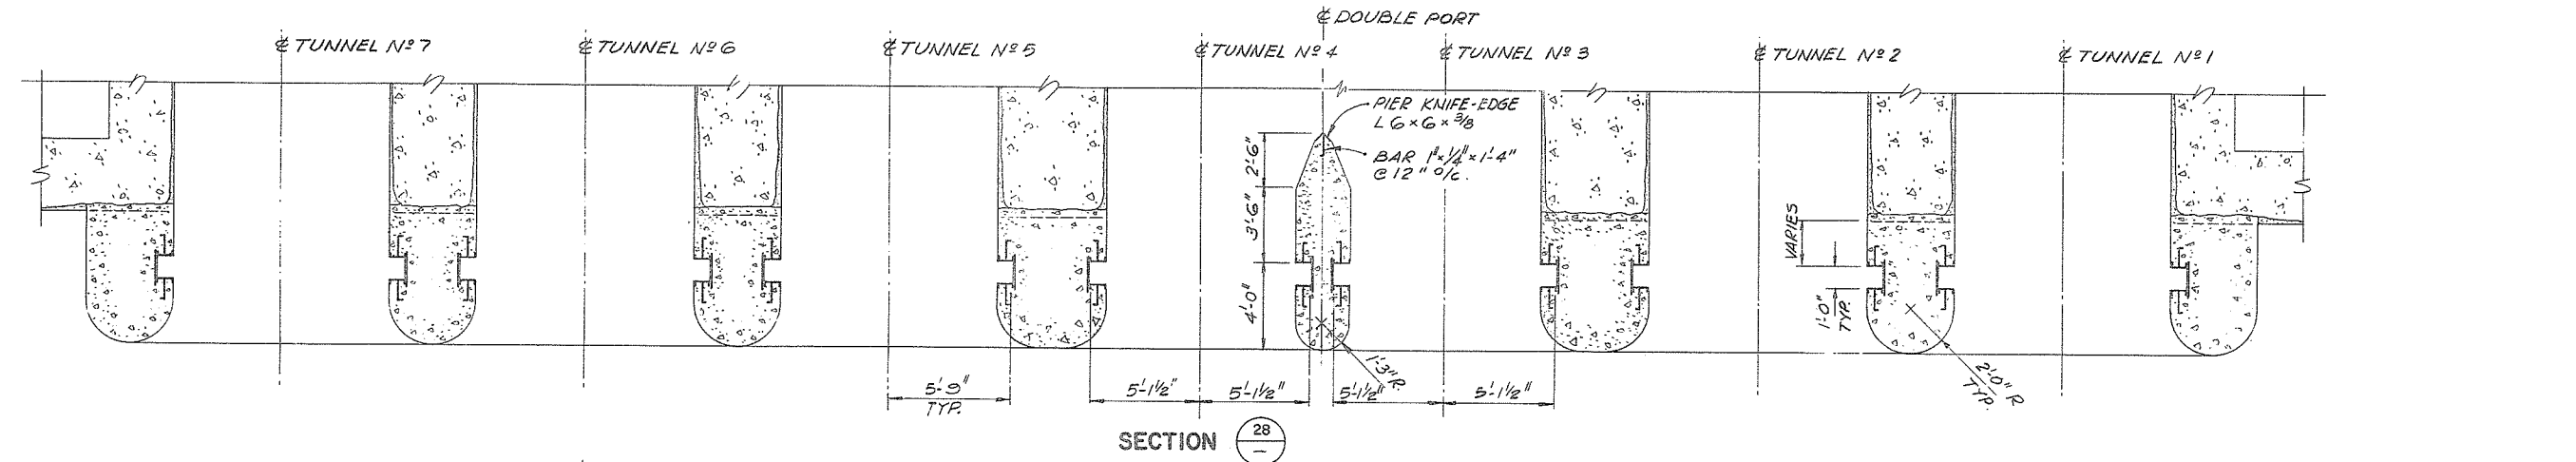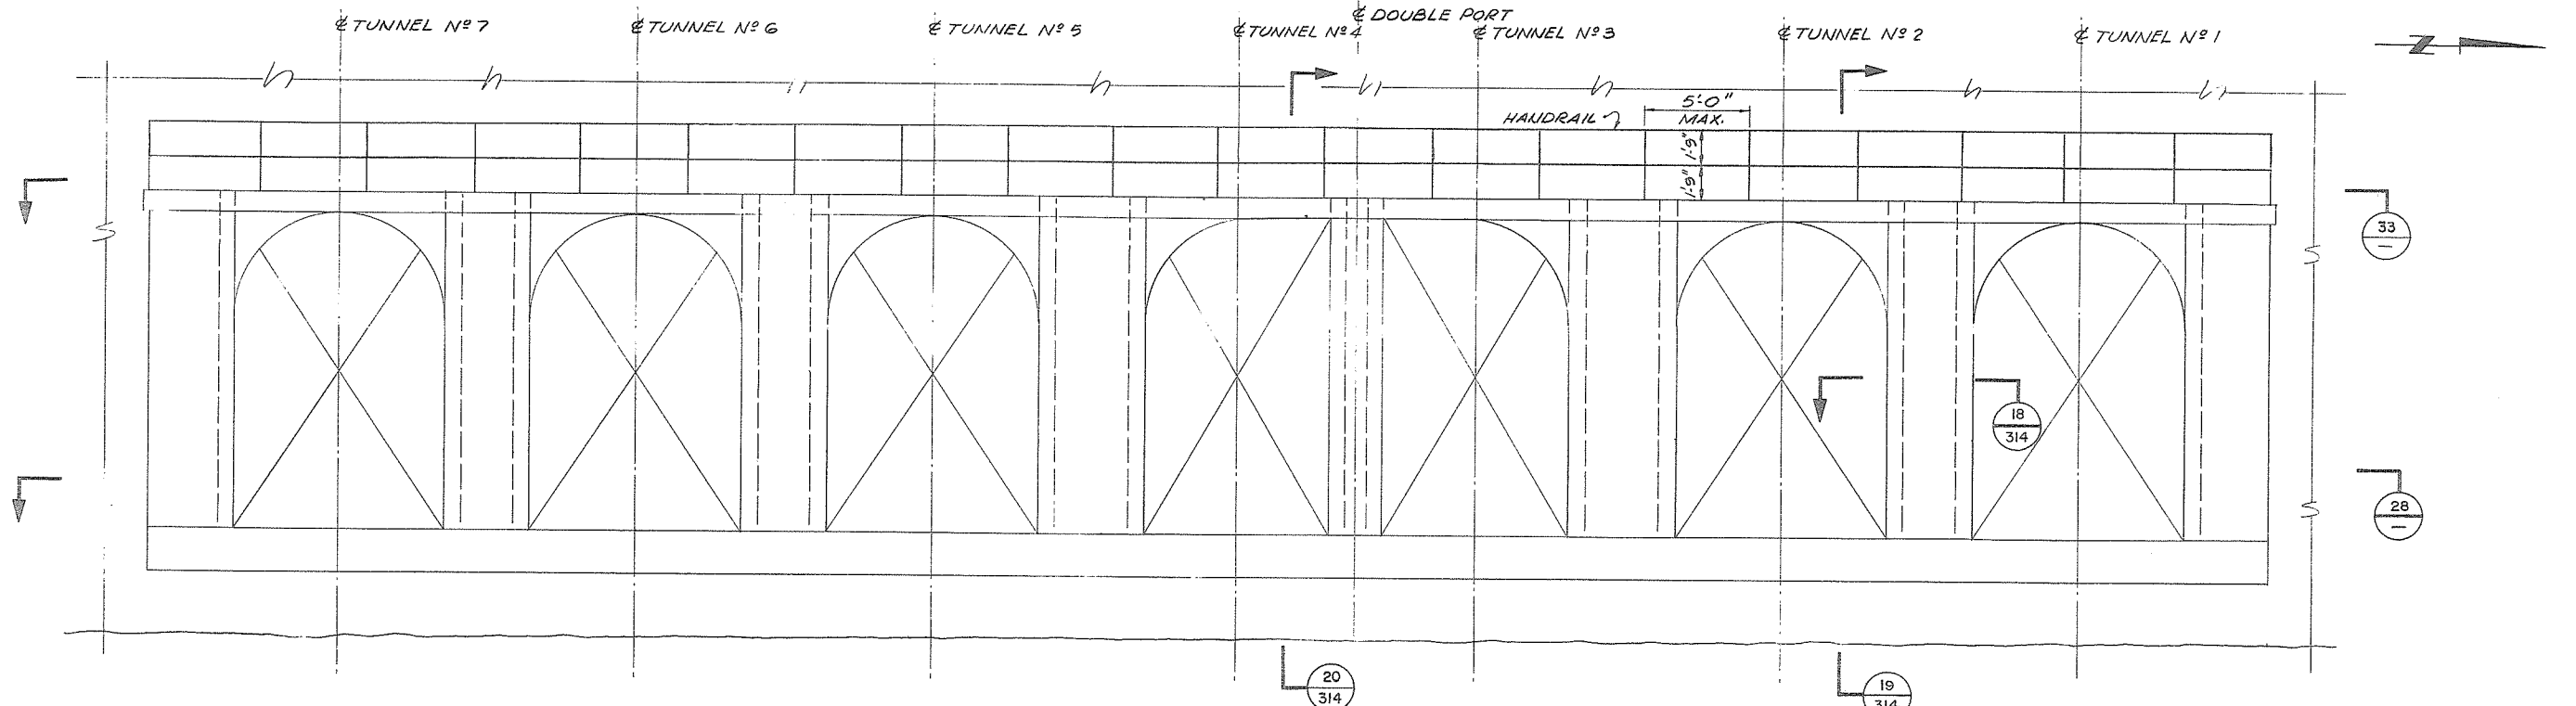


PROJECT NO. 10-1		CONTRACT NO. 1		A.E.S.L. DRAWING NO. 4064-07-317	
THE GOVERNMENT OF THE PROVINCE OF BRITISH COLUMBIA DEPT. OF LANDS, FORESTS AND WATER RESOURCES WATER RESOURCES SERVICE				105348	
CANADA - BRITISH COLUMBIA FRASER RIVER FLOOD CONTROL 1968 AGREEMENT DISTRICT OF SURREY				VANCOUVER, B.C.	
TITLE SERPENTINE DAM STOPLOG GUIDES ELEVATION AND SECTIONS CONCRETE				DESIGN G.J.O.V. SCALE 1/4" = 1'-0"	
DATE APPROVED FOR THE PROVINCE OF BRITISH COLUMBIA				DATE SEPT 1972	
DATE APPROVED FOR THE PROVINCE OF BRITISH COLUMBIA				CHECKED APPROVED	
DRAWING NO. 48841-23				REV. 1	


NO.	DATE	BY	REVISIONS	ENG.
1	16.6.75		AS CONSTRUCTED	

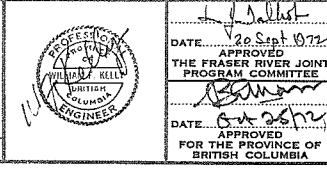

SUPERSEDES ALL PREVIOUS PRINTS WITH A NUMBER LOWER THAN 1

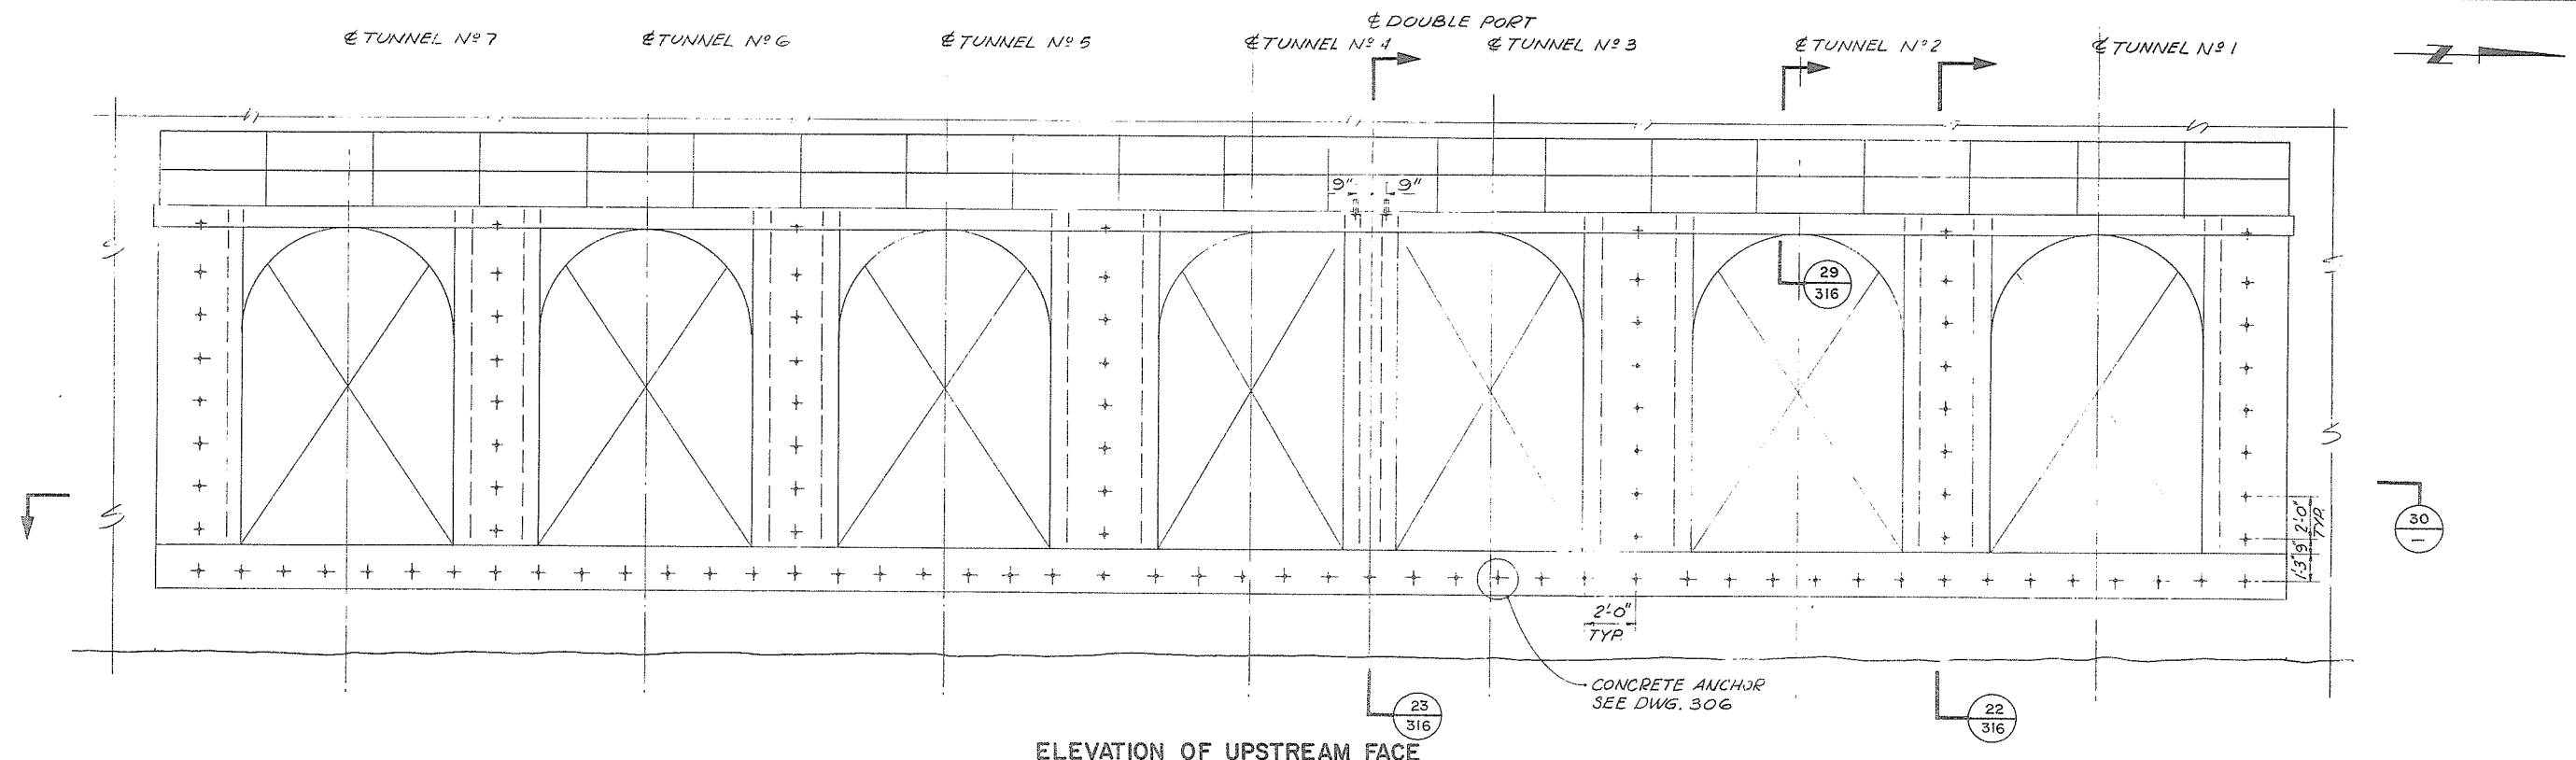

ELEVATION OF UPSTREAM FACE

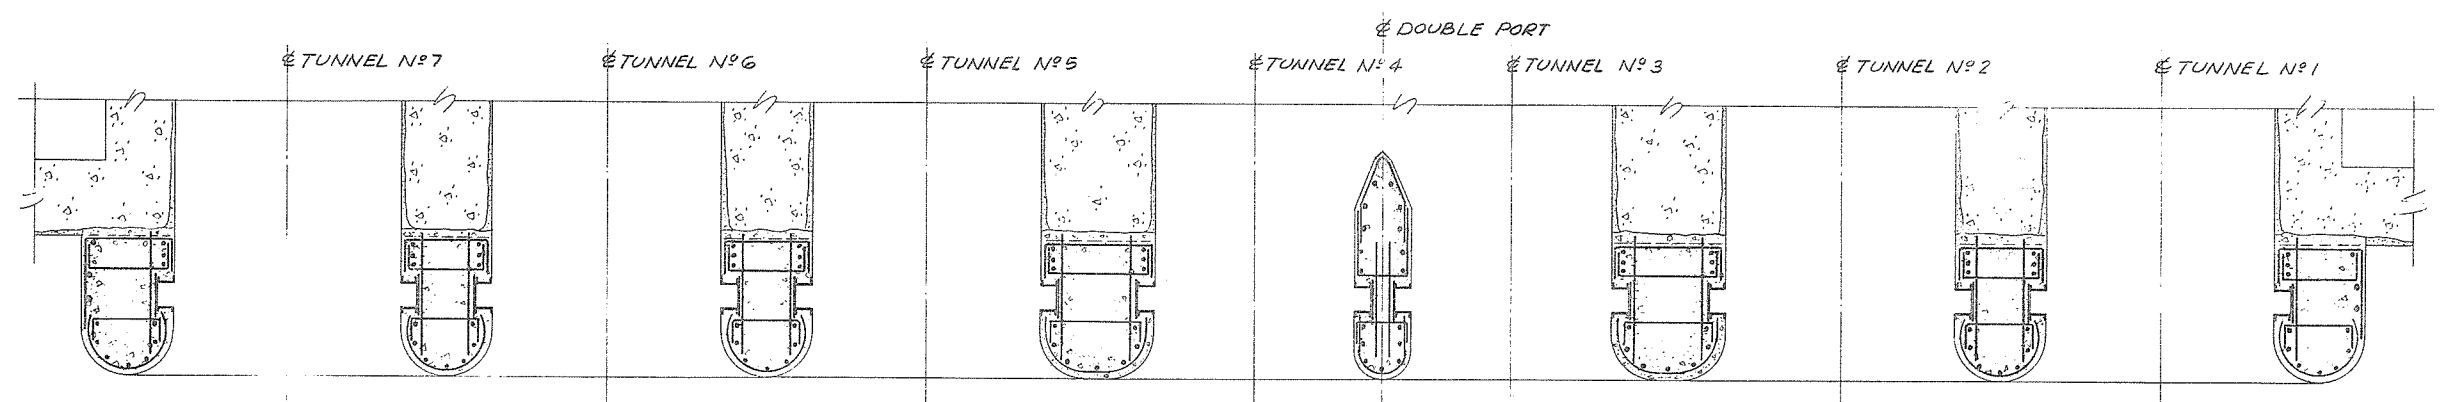

SECTION 30

FOR DETAILS OF REINFORCING  
SEE DWG. 316.

PROJECT NO. 10-1		CONTRACT NO. 1		A.E.S.L. DRAWING NO. 4064-07-318	
THE GOVERNMENT OF THE PROVINCE OF BRITISH COLUMBIA DEPT. OF LANDS, FORESTS AND WATER RESOURCES WATER RESOURCES SERVICE				<b>AESL</b> ASSOCIATED ENGINEERING SERVICES LTD. <small>Consulting Engineers</small> VANCOUVER, B.C.	
CANADA - BRITISH COLUMBIA FRASER RIVER FLOOD CONTROL 1968 AGREEMENT DISTRICT OF SURREY				DESIGN <i>MLK</i> SCALE 1/4" = 1'-0" DRAWN G.J.O.V. DATE SEPT., 1972 CHECKED <i>W.P. Kelly</i> APPROVED <i>W.P. Kelly</i>	
TITLE SERPENTINE DAM STOPLOG GUIDES ELEVATION AND SECTION REINFORCEMENT				DRAWING NO. 4884-1-24 REV. 1	
DATE: 20 Sept. 1972 APPROVED THE FRASER RIVER JOINT PROGRAM COMMITTEE		DATE: 20 Sept. 1972 APPROVED FOR THE PROVINCE OF BRITISH COLUMBIA		105349	
NO. 1 DATE 16.6.75 BY <i>W.P. Kelly</i>		REVISIONS AS CONSTRUCTED		ENG. <i>W.P. Kelly</i>	