

CANADA - BRITISH COLUMBIA

FRASER RIVER FLOOD CONTROL 1968 AGREEMENT

Water Management Branch
Ministry of Environment
Victoria, British Columbia

Water Planning and Management Branch
Inland Waters Directorate
Pacific Region
Department of the Environment
Vancouver, British Columbia

DISTRICT OF SURREY

Operation and Maintenance Instructions

Flood Control Works

Volume 4

As Constructed Works

for Contract No. 2

Crippen Consultants Ltd.
900 - 401 West Georgia Street
Vancouver, B.C.
V6B 5E1

RECORD of AMENDMENTS

ALL AMENDMENTS ARE TO BE ISSUED THROUGH THE INSPECTOR OF DYKES

| <u>AMENDMENT</u> | | DATE | ENTERED BY WHOM, REMARKS |
|------------------|------|---------|--------------------------|
| NO. | DATE | ENTERED | |

District of Surrey

Operation and Maintenance Instructions

Flood Control Works

THE MANUAL

- The operation and maintenance instructions for the flood control works for the District of Surrey are provided in three volumes:

| | |
|-----------|--|
| VOLUME 1 | GENERAL INSTRUCTIONS |
| *VOLUME 2 | NOT APPLICABLE |
| VOLUME 3 | DESCRIPTION OF WORKS AND LIST OF DRAWINGS FOR CONTRACT NO. 1 |
| VOLUME 4 | DESCRIPTION OF WORKS AND LIST OF DRAWINGS FOR CONTRACT NO. 2 |

*Note

The internal drainage component was removed from the Fraser River Flood Control Program subsequent to 1976; therefore Volume 2 is now no longer applicable.

District of Surrey

Operation and Maintenance Instructions

Flood Control Works

Contents of Manual

| | |
|----------|---|
| Volume 1 | General Instructions |
| Volume 2 | Not Applicable |
| Volume 3 | Description of Works and List of Record Drawings for Contract No. 1 |
| Volume 4 | Description of Works and List of Record Drawings for Contract No. 2 |

District of Surrey

Operation and Maintenance Instructions
Flood Control Works

Volume 4

AS CONSTRUCTED WORKS FOR CONTRACT NO. 2

Contents


| | <u>Page</u> |
|--|-------------|
| Title Page | i |
| Record of Amendments | ii |
| The Manual | iii |
| Contents of Manual | iv |
| Volume 4 - Contents | v |
| Volume 4 - List of Appendices | vi |
| Volume 1 - Key Plan | vii |
| | |
| 1. DESCRIPTION OF CONSTRUCTED WORKS | 1 - 1 |
| 1.1 Dyke | 1 - 1 |
| 1.1.1 General | 1 - 1 |
| 1.1.2 Embankment | 1 - 1 |
| 1.1.3 Concrete Wall | 1 - 4 |
| 1.1.4 Sheetpile Wall (Weldwood Mill Area) | 1 - 5 |
| 1.1.5 Weldwood Concrete Wall | 1 - 5 |
| 1.2 Floodbox Works | 1 - 5 |
| 1.2.1 General | 1 - 5 |
| 1.2.2 Concrete | 1 - 6 |
| 1.2.3 126A Street Pump Station | 1 - 7 |
| 1.2.4 124 Street Floodbox | 1 - 7 |
| 1.2.5 Pattullo Floodbox | 1 - 8 |
| 1.2.6 Manson Floodbox | 1 - 9 |
| | |
| 2. RECORD DRAWINGS | 2 - 1 |
| 2.1 List of record Drawings - Contract No. 2 | 2 - 1 |
| 2.1.1 Drawings | 2 - 1 |

LIST OF APPENDICES IN VOLUME 4

DISTRICT OF SURREY FLOOD CONTROL PROJECT

| | | No. of Pages |
|------------|-----------------------|--------------|
| APPENDIX 1 | Concrete Test Results | 10 |
| APPENDIX 2 | Dyke Materials | 5 |
| APPENDIX 3 | Instrumentation | 9 |

KEY PLAN

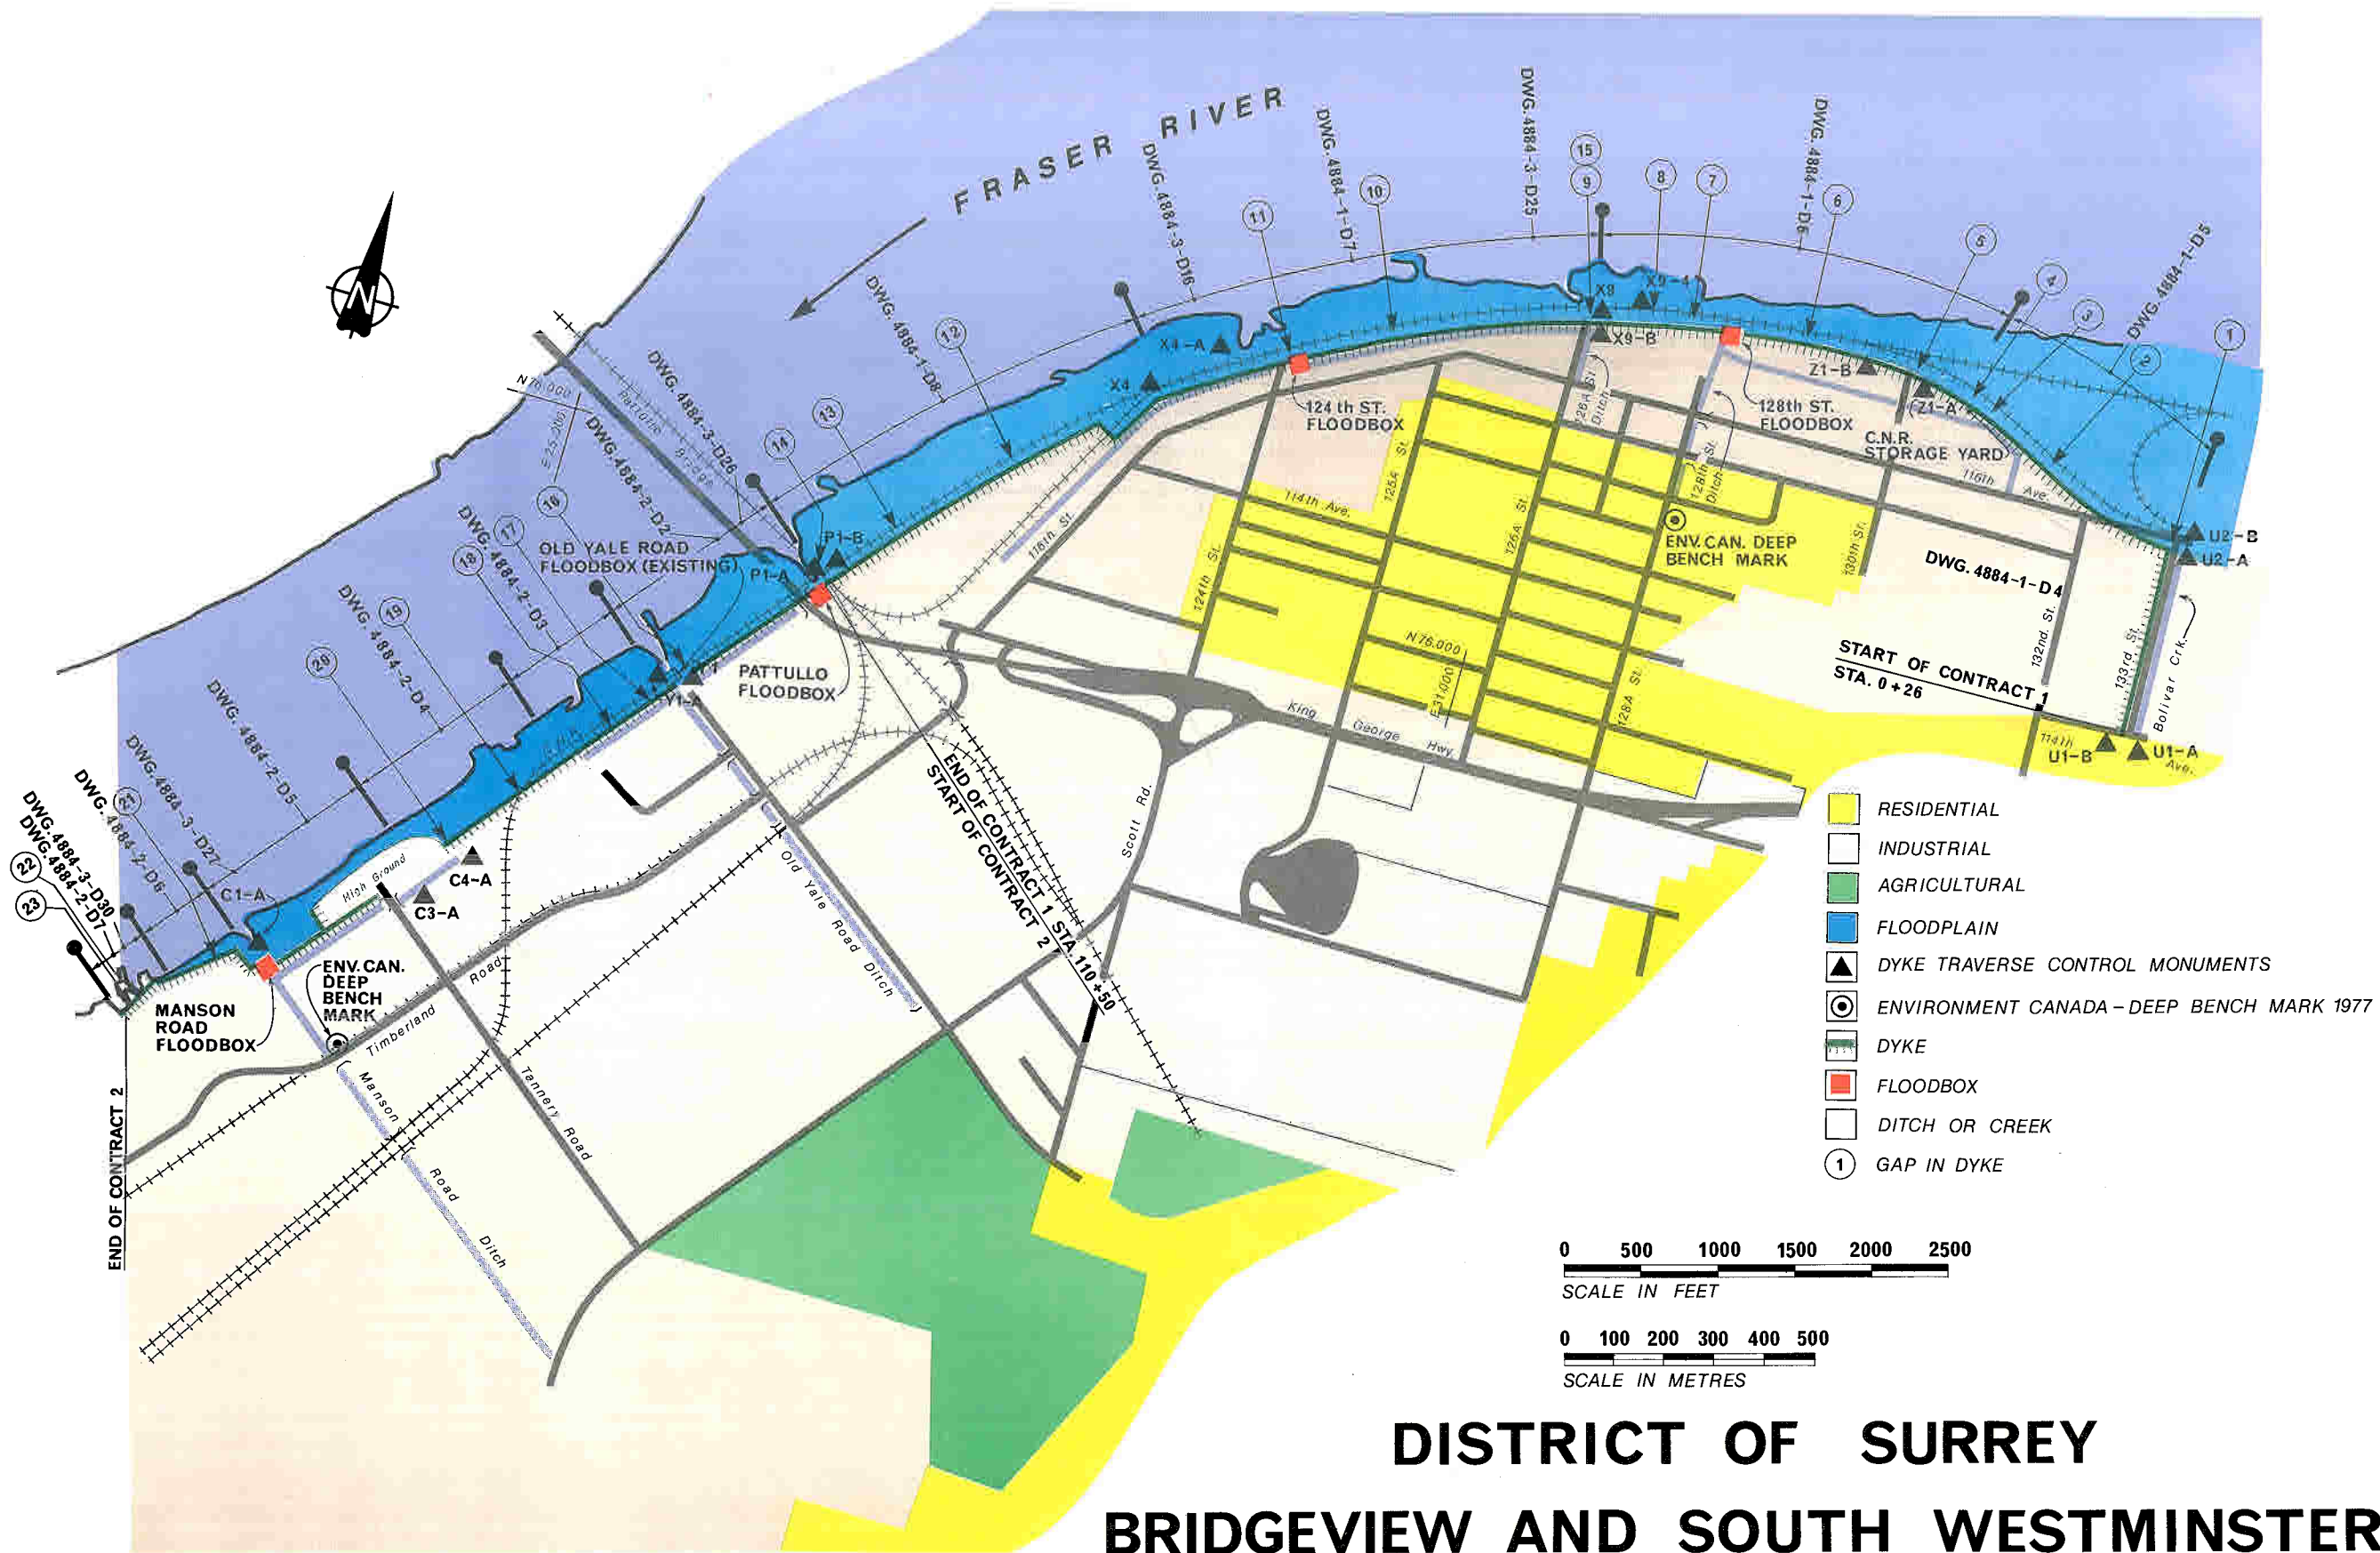

- RESIDENTIAL
- INDUSTRIAL
- AGRICULTURAL
- FLOODPLAIN
- DYKE TRAVERSE CONTROL MONUMENTS
- ENVIRONMENT CANADA - DEEP BENCH MARK 1977
- DYKE
- FLOODBOX
- DITCH OR CREEK
- GAP IN DYKE

0 500 1000 1500 2000 2500
SCALE IN FEET

0 100 200 300 400 500
SCALE IN METRES

DISTRICT OF SURREY BRIDGEVIEW AND SOUTH WESTMINSTER

I. DESCRIPTION OF CONSTRUCTED WORKS

I.1 Dyke

I.1.1 General

Because of the types of sub-surface soil, comprising peat, silt and silty clay, varying amounts of settlements were anticipated along some sections of the dyke. In order to monitor the settlement and detect lateral movements during construction, settlement plates, piezometers and lateral displacement gauges were installed prior to commencing dyke construction.

Settlement plates and piezometers were also installed to monitor the settlement and the piezometric pore pressures during the placing and removal of preload for the Manson Floodbox and the CNR Railway ditch crossing at Sta 23+15.

Lateral movement gauges were installed at the 124th Street and Pattullo Floodbox sites to monitor any effects of construction on the CNR line.

Approximately 30 settlement points were established on pile bents of the Public Works Railway Trestle adjacent to Pattullo Floodbox, in order to monitor any settlement of the piles during the construction of the Floodbox. The results of the readings recorded are shown in Appendix 3 - Instrumentation.

I.1.2 Embankment

a. Dyke Embankment

The dyke embankment was constructed from dredged Fraser River sand stockpiled at Mainland Sand and Gravels Site in South Westminister, Surrey, B.C.

Typical gradation curves and maximum dry (Proctor) density analyses are shown in Appendix 2 - Dyke Materials.

Filter gravel placed on filter cloth on the landside slopes consisted of a 3" minus, naturally rounded material.

Filter cloth -Typar 3401 was used under the filter gravel to prevent loss of dyke material by piping through the dyke fill.

The dyke crest was topped with a 6" thick layer of 1" minus dyke surfacing material consisting of a crushed or naturally occurring gravel-sand mixture.

b. Station -1+05 to -0+15 (Public Works Trestle)

The dyke in this area was built with typical dyke fill material and topped with 6" of dyke surfacing. The dyke was tied into the

existing concrete dyke wall east of the trestle and the new dyke wall east of Pattullo Floodbox. Both the riverside and the landside slopes were covered with 3" topsoil to be seeded later by the District.

c. Station -0+20 to 0+80 (Pattullo Floodbox)

The dyke consists of a low embankment built with typical dyke fill to the same elevation as the base of rail on the CNR line. The landside slope was covered with filter cloth and filter gravel.

d. Station 0+80 to 12+18

The dyke in this area was built with typical dyke fill topped with 6" of dyke surfacing to 6" below the level of the top of the concrete dyke wall to provide a 12' wide access road on the landside of the concrete dyke wall. The ditch between Old Yale Road crossing and Capilano Timber crossing was built up with typical dyke fill and covered with filter cloth and filter gravel. An existing wood stave culvert under Capilano Timber crossing was plugged and a new 18" diameter corrugated steel pipe (CSP) culvert was installed.

e. Station 12+18 to 19+72

The existing ditch in this area was backfilled with dyke fill after the ditch bottom had been stripped of all soft unsuitable material. The dyke embankment was constructed with typical dyke fill to a full crest width of 12'. The new ditch invert and slopes were covered with filter cloth and filter gravel. The dyke riverside slope was covered with topsoil. All slopes were seeded.

f. Station 15+24 to 16+47

The low dyke embankment in this area was constructed of typical dyke fill to the same elevation as base of rail. Ditch invert and slopes were covered with filter cloth and filter gravel. A concrete retaining wall, with an opening for a future spurline, was constructed on the embankment.

g. Station 19+72 to 30+72

The dyke was constructed with typical dyke fill after the ditch had been stripped of all soft, unsuitable material and backfilled with dyke fill. The open ditch was replaced with an 18" diameter CSP culvert to Sta 23+11 and by a 30" diameter CSP culvert with manholes to Sta 30+27. Concrete bag headwalls were constructed at each end of each culvert. The landside slope was covered with filter cloth and filter gravel. The riverside slope was covered with topsoil to be seeded later by the District.

h. Station 22+29 to 23+79

This section of the dyke crossed an existing CNR spurline on a wooden trestle across the ditch. The trestle was removed including the tracks, the area was preloaded and the tracks were replaced. The tracks and preload were removed after 3 months, a new 30" diameter CSP culvert was installed and dyke fill placed. The CNR spurline tracks were replaced and a concrete retaining wall built on the embankment with an opening for the tracks.

i. Station 30+27 to 30+72

A ramp was built of typical dyke fill as an access to Lindal Cedar Homes yard to freeboard elevation and topped with asphalt pavement.

j. Station 30+72 to 35+15

The ditch invert in this area was below the design invert and did not require any work. The high ground inside Imperial Lumber yard was as high as the dyke crest elevation and also did not require any work.

A new 30" diameter CSP culvert was installed across Tannery Road and bagged concrete head walls were built at both ends.

k. Station 35+15 to 39+25

A berm was excavated on the side of the existing ditch to tie in with the new berm towards Manson Floodbox and the ditch was trimmed to the required invert. The proposed dyke was deleted as the existing Imperial Lumber yard was already at flood protection level.

l. Station 39+25 to 43+97

A new ditch was excavated as a continuation of the existing ditch to Manson Floodbox. The dyke was built with typical dyke fill and filter cloth covered with filter gravel was placed on the landside. A considerable amount of hog fuel was removed during the excavation for the dyke. The riverside slopes were covered with topsoil for future seeding.

The existing drainage ditch from the old floodbox was filled in to the tops of the banks and the dyke alignment was turned perpendicular to the new dyke to tie into the high ground at the west end of Imperial Lumber yard. The dyke slopes were covered with topsoil for future seeding.

A 42" diameter CSP culvert was installed across the access ramp to the new floodbox from the new ditch to Manson Canal.

m. Station (43+97) 0+00 to 7+89

The dyke was constructed with typical dyke fill with both landside and riverside slopes covered with topsoil for future seeding, except between Sta 4+10 - 5+70 where a low embankment was built for a concrete dyke wall. This construction allowed the riverside toe of the dyke to be moved inland away from the riverbank and avoided destruction of fish feeding areas.

1.1.3 Concrete Wall

a. Foundations

Stripping and structural excavation for the concrete wall foundations revealed generally good conditions. The concrete wall is generally founded on compacted dyke fill material.

b. Concrete

The Contract called for a Class II, 21 MPa concrete for all dyke walls. The design requirements and concrete mix designs are shown in Table 1, Section 1.2.2 - Concrete.

c. Joints

The expansion joints in the concrete dyke wall were constructed using water stops, joint primer, joint filler, bond breaker and joint sealant. Movement at wall footing joints was controlled by using 32 mm diameter plain steel dowels with one end encased in 1-1/4" diameter standard Polyethylene pipe, Pacific Plastic Type 325, with a styrofoam plug.

Water stop material was PVC Durajoint Type 7C. The joint filler was Rodofam GR grade, while the joint sealant was Duoflex non-sag polysulphide. The bond breaker between the joint filler and joint sealant was ordinary polyethylene tape. The joint primer used was Polyprimer 2.

d. Station -0+20 to 0+80

The concrete dyke wall consists of 2 sections of 4'-6" high concrete wall each 50' long inside a low dyke fill embankment.

e. Station 0+80 to 10+32

The concrete dyke wall in this area consists of a 5'-0" high concrete wall made up of 16 - 50' sections, 3 - 40' sections and one 32.20' section.

f. Station 10+32 to 12+23

The 4'-6" high concrete wall in this area has two stoplog openings for Old Yale Road and Capilano Timber crossings.

g. Station 15+19 to 16+52

This section consists of 4 sections of 5'-9" high concrete retaining wall with one 16' wide stoplog opening for a future railway spurline to Fraser River Metals Depot.

h. Station 22+24 to 23+84

The concrete retaining wall in this area has 4 sections of 5'-9" high wall of various lengths and one 16' wide stoplog opening for the existing CNR-Brownsville track.

The crossings at Fraser River Metals and Brownsville are sealed off with cut-off zones consisting of a mixture of river sand and 5% Bentonite by weight.

i. Station 4+10 to 5+70

A 5'-8" high concrete dyke wall was built in this area in five sections of various lengths and with a 4' wide stoplog opening for access to the river.

j. Dyke Wall West of Weldwood Mill

A 5'-2" high concrete wall was built on a low dyke embankment of typical dyke fill from the west side of the Weldwood Mill to high ground with two 16' wide stoplog openings for access ramps to the river.

The riverside slope of the dyke was protected with a 12" thick layer of six inches minus rock material. The landside of the dyke was constructed with a filter cloth and filter gravel zone. The riverside of the two stoplog openings was made impervious with a cut-off zone consisting of a mixture of dyke fill river sand and 5% Bentonite by weight.

1.1.4 Sheetpile Wall (Weldwood Mill Area)

A steel sheetpile wall to a maximum depth of El -26.0' and topped with a concrete cap at El +14.0' was built from the end of the embankment dyke at Sta 7+89 and tied to the Weldwood Mill retaining wall 208.5' further west.

1.1.5 Weldwood Concrete Wall

A 12" thick concrete retaining wall with an 8'-6" wide spread-footing was built under the Weldwood Mill floor between two rows of existing pile caps.

The wall was built independent from the pile caps on fine silty clay foundation at El -2.00'. A 6" diameter perforated CSP culvert was installed on the landside in the dyke fill which was brought up to El +7.00'. The 6" perforated drain was connected to a 24" diameter

discharge pipe through the concrete wall. The 24" dia pipe was fitted with a 24" dia Armco medium duty flapgate.

1.2 Floodbox Works

1.2.1 General

Dewatering for the floodbox structures at 124th Street, Pattullo and Manson Road was done by means of wellpoint systems. Piezometers were installed inside the cofferdams to monitor the piezometric pore pressures during the excavation and the backfill operations.

The foundation for all three floodboxes consisted of very fine silty sand which was covered with a 3" thick layer of blinding concrete under the outlet concrete structures at 124th Street and Pattullo and over the whole floodbox foundation at Manson Road.

Lateral displacement gauges were installed at 124th Street and Pattullo floodboxes to monitor any movement during the jacking of the concrete pipes through the CNR railway embankment.

The channel slopes at the outlets were protected with a 12" thick layer of 6" minus rock to prevent washouts.

1.2.2 Concrete

The contract called for three different classes of concrete based on strength. A tabulation of the concrete design requirements and concrete mix designs are shown in Table I. The Class I concrete was used for the floodbox structures and the Class II concrete for the concrete dyke walls. The Class III concrete was used for the blinding concrete under the floodboxes.

Table I - Concrete Mix - Requirements and Design

| <u>Specifications</u> | <u>Class I</u> | <u>Class II</u> | <u>Class III</u> |
|------------------------------------|----------------|-----------------|------------------|
| Strength | 28 MPa | 21 MPa | 14 MPa |
| Cement (kg/m ³) | 310 | 270 | 210 |
| Concrete Sand (kg/m ³) | 840 | 870 | 925 |
| Coarse Aggregate | | | |
| 19 mm (kg/m ³) | 650 | 650 | 640 |
| 10 mm (kg/m ³) | 420 | 430 | 440 |
| Slump | 100 mm ± 20 | 75 mm ± 10 | 100 mm ± 20 |

| Admixture | Pozzolith | Pozzolith | Pozzolith |
|-------------------------------|-----------|-----------|-----------|
| Air Content (%) | 4 - 6 | 4 - 6 | 4 - 6 |
| Maximum Water Cement Ratio | 0.45 | 0.50 | 0.60 |

The concrete test cylinder results tabulated in Appendix I - Concrete Test Results, showed that the concrete had adequate strength.

1.2.3 126A Street Pump Station

The existing wooden floodbox was filled with Class III concrete for a distance of 4.5 m at the landside end.

A steel sheetpile wall was built between the pumphouse and the floodbox to support the backfill under a 4'-6" high concrete dyke wall built on dyke fill embankment.

The landside slope was protected by a concrete bag wall above the sheetpile wall.

Two 35' long sections of a 4'-6" high dyke wall were connected with the existing concrete dyke wall and one 50' long dyke wall section, with a 32' wide stoplog opening, was built across 126A Street.

The existing 24" diameter and 18" diameter forcemains from the pump station were extended at the outlet and backfilled to El +12.00'. The existing flapgates were relocated to ends of the extended pipes. The existing wooden bridge was removed.

1.2.4 124 Street Floodbox

a. Structure

This floodbox consists of Inlet and Outlet Concrete Structures connected by a single 72" diameter reinforced concrete pipe culvert.

b. Pipe Culvert

The total length of the pipe culvert is 169'-4" of which 90' was jacked under the CNR railroad embankment in dense sandy silt. Some settlement occurred during the jacking operation which was carried out from the outlet end. The reinforced Class V pipe was required within the CNR right-of-way. Outside the CNR right-of-way at both the Outlet and the Inlet end reinforced Class III pipe was used and was trench installed. Both pipes had tongue and groove type joints which were made waterproof by rubber gaskets.

c. Seepage Collars

Two seepage collars were built around the trench-installed pipes at the Inlet to increase the seepage distance.

d. Dyke Wall

A 3'-6" high concrete dyke wall was constructed on a low dyke fill embankment at the Inlet end and tied into the existing concrete dyke wall on both sides of the floodbox.

Filter cloth and filter gravel were placed around the Inlet structure and on the dyke slopes up to the concrete dyke wall.

e. Channels

The Inlet channel was constructed to connect with the existing 124th Street ditches. The Outlet channel was excavated with a base width of 20 ft for 340' until it met the river.

A security chain link fence, 6'-6" high, was erected around the Outlet structure from the Domtar fence and along the west side of the Outlet Channel for about 340' to the river edge.

1.2.5 Pattullo Floodbox

a. Structure

The floodbox consists of Inlet and Outlet concrete structures connected with twin 72" diameter reinforced concrete pipe culverts.

b. Pipe Culverts

The total length of each pipe culvert is 96'-10" of which 49' was jacked under the CNR railroad embankment for the culvert on the east side. Due to problems caused by unforeseen obstacles such as old piles and a wooden floodbox which prevented the pipes from being jacked, an open cut was made and the west side pipe culverts placed in the trench. Some settlement occurred during the jacking operation which was carried out from the outlet end. The pipe culverts outside the embankment were trench installed on a bedding of 12" thick dyke fill while the pipe culverts inside the embankment rested on dense, sandy silt. All pipe culverts were Class V precast concrete pipes with tongue and groove type joints.

c. Seepage Collars

Two seepage collars were built around the trench-installed pipes at the Inlet.

d. Discharge Pipes

The existing 24" diameter forcemain and the two existing 18" diameter forcemains from the pump station were extended through the embankment to the new Outlet structure.

e. Old Floodbox

The existing wooden floodbox was filled with compacted dyke fill material.

f. Channels

The outlet and the inlet channels were improved to suit the new structures.

1.2.6 Manson Floodbox

a. Foundation

The site was preloaded for 6 months in order to consolidate the foundation. Dyke fill material was used as preload fill. Three sets of settlement plates and piezometers were installed to control the piezometric pore pressure during the placing and removal of the preload and to record the settlement of the silty foundation. An average total settlement of 5' was recorded after a rebound of 0.5' was taken into account. The foundation was covered with a 3" layer of blinding concrete.

b. Structure

The floodbox consists of Outlet and Inlet structures connected with twin 7' x 7' reinforced concrete conduits, each one made up of 4 sections. Five seepage collars were built around the conduits at the expansion joints.

c. Dyke Embankment

The dyke embankment was constructed with typical dyke fill material with a 32' wide crest above the floodbox. The slopes above the floodbox were covered with 3" of topsoil.

d. Channels

The Inlet channel was excavated to tie in with the existing Manson canal and filter cloth and filter gravel were placed on the bottom and on the slopes.

The Outlet channel was excavated with a base width of 20' and tied in to the existing outlet channel after the old floodbox had been removed. The silty slopes were covered with filter cloth and a 12" thick layer of 6" minus rock material from the bottom up to El +10.00' between the new dyke and the old dyke.

LIST OF RECORD DRAWINGS

CONTRACT NO. 2

2. RECORD DRAWINGS

2.1 List of Record Drawings - Contract No. 2

Note: These drawings are listed by structure.
See also Volume 1, Appendix 3.2.


| <u>Drawing No.</u> | <u>Title</u> | <u>Provincial 105 mm Negative Number</u> |
|--|---|--|
| a. <u>GENERAL ARRANGEMENT</u> | | |
| 4884-2-D1/R2 | Location Plan and General Arrangement | 280085 |
| 4884-2-D11/R2 | Settlement Plate & Piezometer Details | 280094 |
| b. <u>EARTHFILL DYKES</u> | | |
| <u>Dyke at Public Works Canada Trestle at Pattullo Floodbox</u> | | |
| 4884-3-D26/R2 | Pattullo & Old Yale Road Dykes Plan, Profile and Sections | 280122 |
| <u>Dyke from Capilano Timber Crossing to Imperial Lumber Co. Yard</u> | | |
| 4884-2-D3/R3 | Dyke - Stations 12+44 to 19+94 Plan, Profile and Sections | 280087 |
| 4884-2-D4/R2 | Dyke - Stations 19+94 to 32+23.86 Plan, Profile and Sections | 280088 |
| <u>Dyke from Imperial Lumber Yard (Tannery Road) to Manson Road Floodbox</u> | | |
| 4884-2-D5/R2 | Dyke - Stations 32+23.86 to 44+19.33 Plan, Profile and Sections | 280089 |
| 4884-3-D27/R2 | Dyke Road Dyke Plan, Profile and Sections | 280123 |
| <u>Dyke from Manson Road to Weldwood Mill</u> | | |
| 4884-2-D6/R3 | Manson Road Dykes - Station 0+00 to 7+89 Plan, Profile and Sections | 280090 |

| <u>Drawing No.</u> | <u>Title</u> | <u>Provincial 105 mm Negative Number</u> |
|--|--|--|
| c. <u>CONCRETE DYKE WALL</u> | | |
| <u>Wall Between Pattullo Floodbox and Capilano Timber Crossing</u> | | |
| 4884-2-D2 | Dyke - Stations 0+00 to 12+44 Plan, Profile and Sections | 280086 |
| 4884-2-D12/R2 | Capilano Timber and Old Yale Road Road Crossings and Stoplog Walls | 280095 |
| 4884-2-D15/R2 | Dyke Wall & Culvert Headwall Concrete Outline and Reinforcement | 280097 |
| 4884-3-D26/R2 | Pattullo and Old Yale Road Dykes Plan, Profile and Sections | 280122 |
| 4884-3-D28/R2 | Miscellaneous Concrete Details | 280124 |
| <u>Wall at Proposed CNR Spurline for Fraser River Metal Depot and Existing CNR Spurline at Orchardson Yard</u> | | |
| 4884-2-D3/R3 | Dyke - Stations 12+44 to 19+94 Plan, Profile and Sections | 280087 |
| 4884-2-D4/R2 | Plan, Profile and Sections | 280088 |
| 4884-2-D12/R2 | Capilano Timber and Old Yale Road Road Crossings and Stoplog Walls | 280095 |
| 4884-2-D15/R2 | Dyke Wall & Culvert Headwall Concrete Outline and Reinforcement | 280097 |
| 4884-2-D33/R1 | Opening for CNR Spurline to Fraser River Metals Depot | 280083 |
| 4884-2-D13/R3 | CNR Track & Dyke Crossing - Station 23+15 Plan, Sections and Details | 280096 |
| <u>Wall at Manson Road Dyke by Weldwood's Dip Tank</u> | | |
| 4884-2-D6/R3 | Manson Road Dykes - 0+00 to 7+89 Plan, Profiles and Sections | 280090 |

| Drawing No. | Title | Provincial 105 mm Negative Number |
|--|--|--|
| <u>Retaining Wall and Dyke Wall at Weldwood Mill</u> | | |
| 4884-2-D7/R4 | Weldwood Mill Retaining Wall & Dyke Wall General Arrangement | 280091 |
| 4884-2-D8/R4 | Weldwood Mill Retaining Wall Concrete Outline and Reinforcement Sheet 1 | 280092 |
| 4884-2-D10/R3 | Weldwood - Dyke Wall Details | 280093 |
| 4884-2-D16/R2 | Dyke Wall Concrete Outline, Reinforcement and Details | 280098 |
| 4884-3-D28/R2 | Miscellaneous Concrete Details | 280124 |
| d. | <u>FLOODBOXES</u> | |
| | <u>126A Street</u> | |
| 4884-2-D16/R2 | Dyke Wall Concrete Outline, Reinforcement and Details | 280098 |
| 4884-3-D25/R2 | 126A Street Dyke Plan, Profile and Sections | 280121 |
| 4884-3-D29/R3 | 126A Street Dyke Sheetpile Wall Plan, Sections and Details | 280125 |
| | <u>124th Street Floodbox</u> | |
| 4884-3-D16/R3 | General Arrangement | 280113 |
| 4884-3-D17/R2 | Excavation and Backfill Sheet 1 of 2 | 280114 |
| 4884-3-D18/R2 | Excavation and Backfill Sheet 2 of 2 | 280115 |
| 4884-3-D19/R2 | Concrete Outline | 280116 |
| 4884-3-D20/R2 | Reinforcement | 280117 |

| Drawing No. | Title | Provincial 105 mm Negative Number |
|--------------------------|--|--|
| 4884-3-D21/R2 | 124th Street and Pattullo Floodboxes - Floodgates | 280118 |
| 4884-3-D22/R2 | 124th Street, Manson & Pattullo Floodboxes - Handrails | 280119 |
| 4884-3-D23/R2 | 124th Street, Manson & Pattullo Floodboxes Trashracks & Miscellaneous Metalwork | 280120 |
| <u>Pattullo Floodbox</u> | | |
| 4884-3-D9/R2 | General Arrangement | 280106 |
| 4884-3-D10/R2 | Excavation and Backfill Sheet 1 of 2 | 280107 |
| 4884-3-D11/R2 | Excavation & Backfill Sheet 2 of 2 | 280108 |
| 4884-3-D12/R2 | Concrete Outline Plan & Sections | 280109 |
| 4884-3-D13/R2 | Concrete Outline Sections & Details | 280110 |
| 4884-3-D14/R2 | Inlet Reinforcement | 280111 |
| 4884-3-D15/R2 | Outlet Reinforcement | 280112 |
| 4884-2-D34/R1 | Wingwall Extension | 280084 |
| 4884-2-D21/R2 | 124 Street & Pattullo Floodboxes & Floodgates | 280118 |
| 4884-3-D22/R2 | 124 Street, Manson & Pattullo Floodboxes - Handrails | 280119 |
| 4884-3-D23/R2 | 124 Street, Manson & Pattullo Floodboxes Trashracks & Miscellaneous Metalwork | 280120 |


| Drawing No. | Title | Provincial 105 mm Negative Number |
|------------------------|--|--|
| 4884-3-D26/R2 | Pattullo & Old Yale Road Dykes Plan Profile & Sections | 280122 |
| <u>Manson Floodbox</u> | | |
| 4884-3-D2/R2 | General Arrangement | 280099 |
| 4884-3-D3/R2 | Excavation and Backfill Sheet 1 of 2 | 280100 |
| 4884-3-D4/R2 | Excavation and Backfill Sheet 2 of 2 | 280101 |
| 4884-3-D5/R2 | Concrete Outline | 280102 |
| 4884-3-D6/R2 | Inlet - Reinforcement | 280103 |
| 4884-3-D7/R2 | Outlet - Reinforcement | 280104 |
| 4884-3-D8/R2 | Floodgates | 280105 |
| 4884-3-D22/R2 | 124 Street, Manson & Pattullo Floodboxes - Handrails | 280119 |
| 4884-3-D23/R2 | 124 Street, Manson & Pattullo Floodboxes Trashracks & Miscellaneous Metalwork | 280120 |
| 4884-3-D27/R2 | Dyke Road Dyke Plan Profile & Section | 280123 |
| e. | <u>WELDWOOD SHEETPILE WALL</u> | |
| 4884-3-D30/R4 | Weldwood Sheetpile Wall General Arrangement and Details | 280126 |

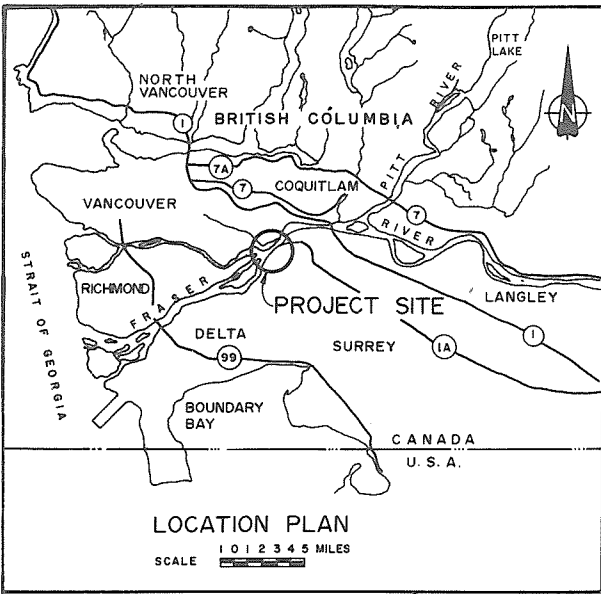

| MONUMENT COORDINATES & ELEVATIONS | | | |
|-----------------------------------|-----------|-----------|-----------|
| MONUMENT | N | E | ELEVATION |
| X4-A | 77,504.42 | 28,974.23 | 12.72 |
| X4 | 77,171.02 | 28,539.28 | 11.22 |
| PI-B | 75,487.62 | 26,893.37 | 13.09 |
| PI-A | 75,416.52 | 26,768.68 | 8.82 |
| Y1 | 74,492.26 | 26,135.80 | 11.36 |
| Y1-A | 74,469.57 | 26,028.30 | 10.39 |
| Crock IO | 73,084.73 | 24,785.36 | 10.60 |
| C4-A | 72,909.33 | 24,936.68 | 11.25 |
| C3-A | 72,644.89 | 24,673.96 | 10.71 |
| C1-A | 72,052.21 | 23,964.72 | 9.54 |

NOTE
• The coordinates are rectangular polyconic and their origin is 49°00'00" north latitude and 123°00'00" west longitude.

 - LEGEND**
- ===== New dyke
 - Existing dyke to remain
 - Proposed new ditch
 - Existing ditch to be filled
 - Existing ditch to remain
 - New floodbox
 - ⊠ Existing floodbox
 - ▲ Dyke traverse control monument (existing)
 - ⊙ Government of Canada, Department of Environment - Bench Mark 1977.
 - 0+00 Station



CRIPPEN ENGINEERING LTD.
NORTH VANCOUVER, B.C.
PROJECT NO. 10407

DEPARTMENT HEAD *J. B. ...*
PROJECT ENGINEER *M. A. Merlo*
CHIEF ENGINEER *M. A. Merlo*

2. Record Drawing
APPROVED FOR CONSTRUCTION
1. Floodboxes added & Prepared for Tender (Combined contracts)

NO. _____ DESCRIPTION _____ BY _____ CHD _____ APPR _____ DATE _____



RECOMMENDED *Eastbank* PROJECT MANAGER
DATE June 6 1984
APPROVED *M. A. Merlo* DIRECTOR, WATER INVESTIGATIONS
DATE June 6 1984

BRITISH COLUMBIA
MINISTRY OF ENVIRONMENT
WATER INVESTIGATIONS BRANCH
CANADA-BRITISH COLUMBIA
FRASER RIVER FLOOD CONTROL 1968 AGREEMENT


PROJECT 10.4 CONTRACT NO. 2
SOUTH WESTMINSTER FLOOD CONTROL WORKS
LOCATION PLAN AND
GENERAL ARRANGEMENT

DESIGNED FRB
DRAWN L.S.
CHECKED *merlo*
SCALE As shown
DWG NO 4884-2-DIR2 SHEET 1 OF 43 SHEETS


SURVEYED _____ DATE _____
FILE NO 0281550-C12D-2
DATE 29 February 1984

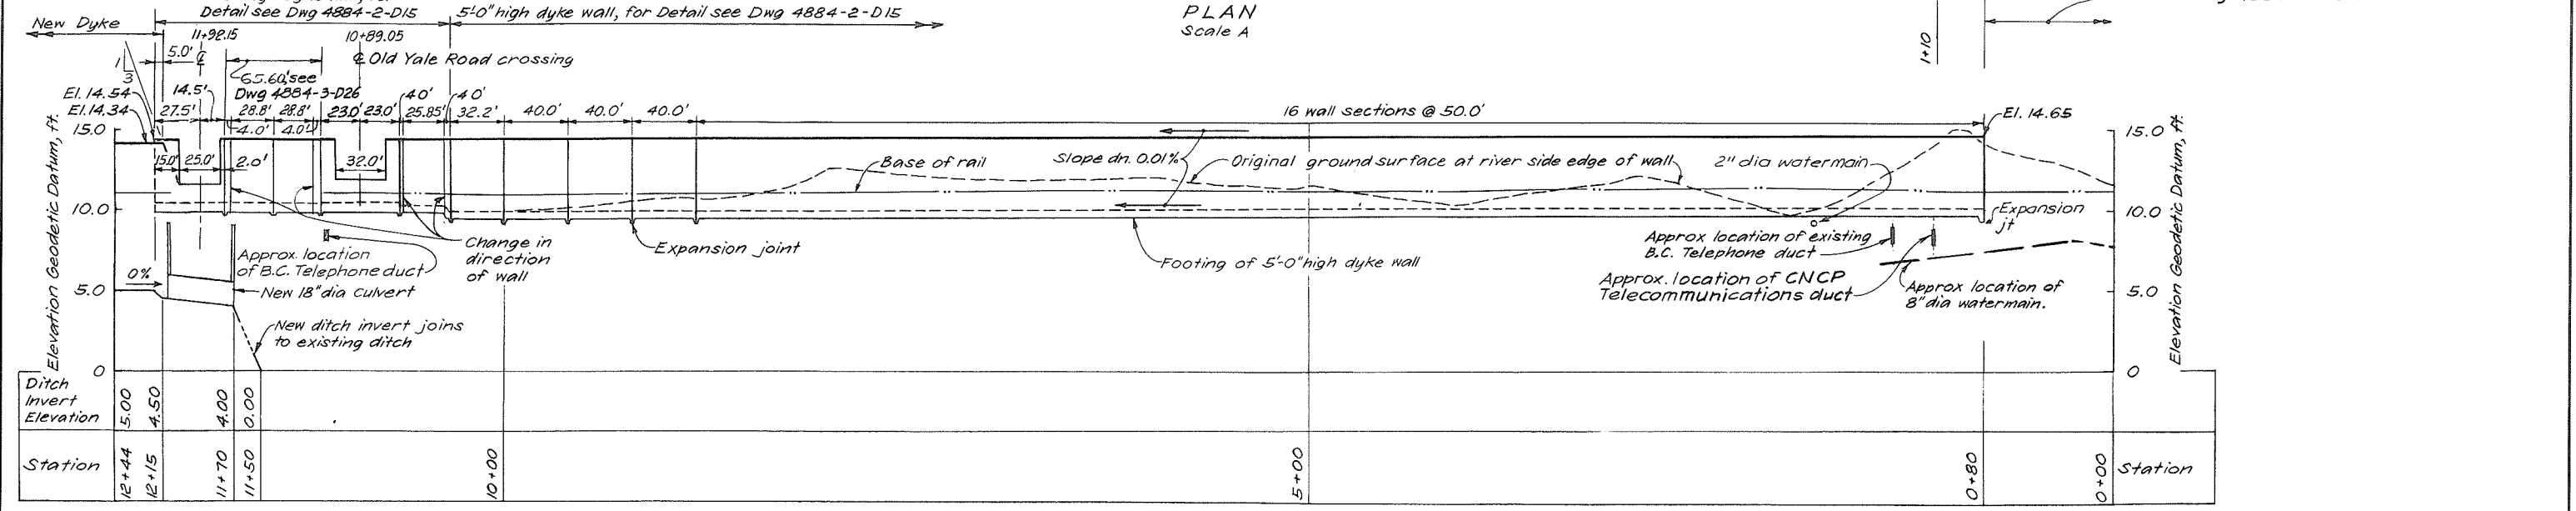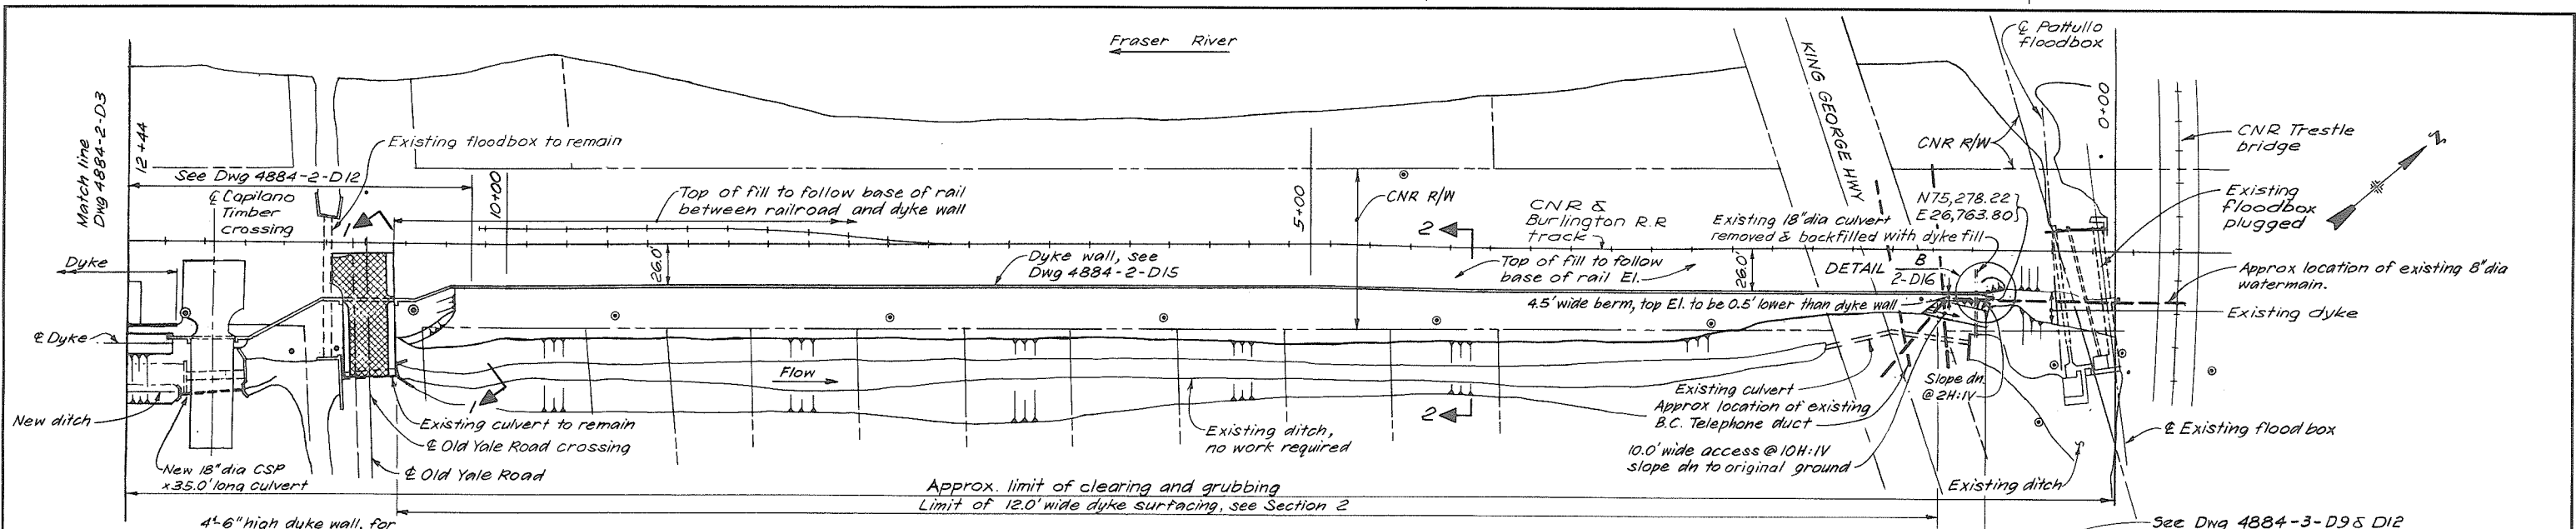

PROFILE
Hor. scale A
Vert. scale B


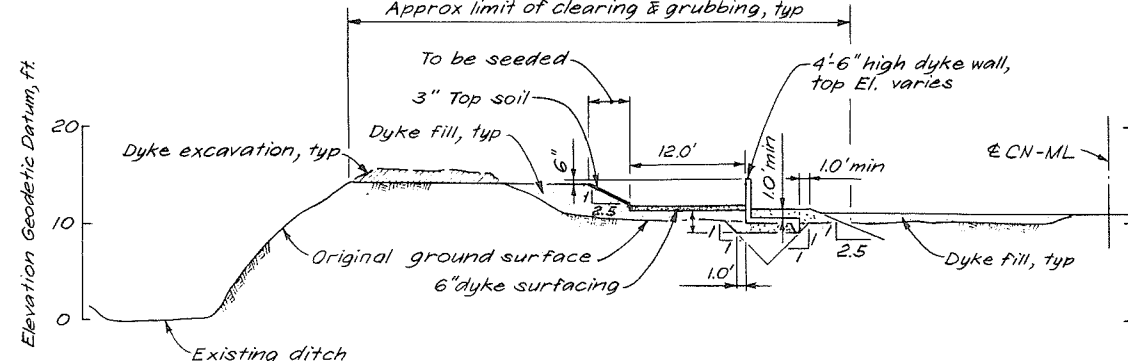


SECTION 1
Typical between Sta 10+35.79 and Sta 10+75
Scale C

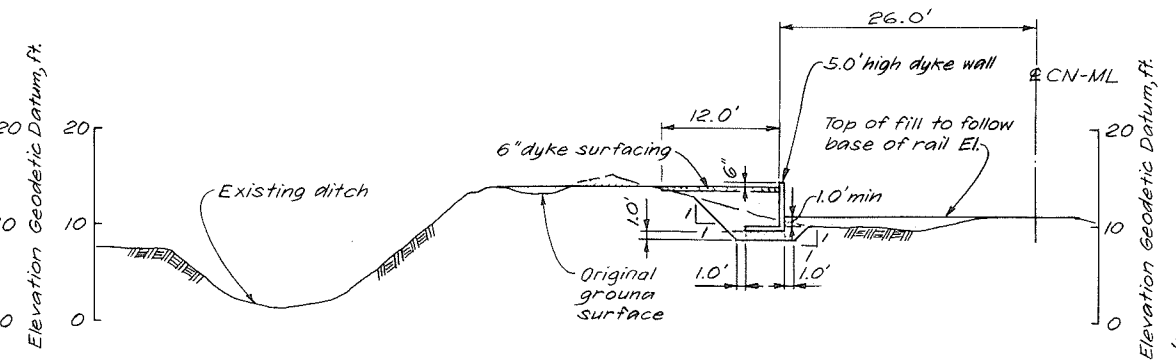

SECTION 2
Typical between Sta 0+80 and Sta 10+31.79
Scale C

- NOTES
1. For general notes and legend see Dwg 4884-2-D3.
 2. For typical detail of retaining wall excavation & structural fill payment lines see Dwg 4884-2-D13

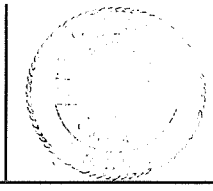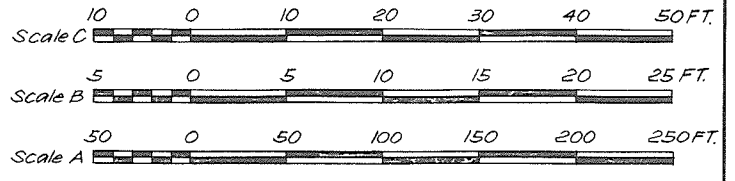

CRIPPEN ENGINEERING LTD.
NORTH VANCOUVER, B.C.
PROJECT NO. 10405

DEPARTMENT HEAD: *[Signature]*
PROJECT ENGINEER: *[Signature]*
CHIEF ENGINEER: *[Signature]*

2. Record Drawing
APPROVED FOR CONSTRUCTION JUL 23 84

1. Prepared for Tender (Combined contracts) FEB 23 84

NO. _____ DESCRIPTION _____ BY CHD APRR DATE _____


RECOMMENDED *[Signature]* PROJECT MANAGER
DATE June 6 1984

APPROVED *[Signature]* DIRECTOR, WATER INVESTIGATIONS
DATE June 6 1984

BRITISH COLUMBIA
MINISTRY OF THE ENVIRONMENT
WATER INVESTIGATIONS BRANCH
CANADA - BRITISH COLUMBIA
FRASER RIVER FLOOD CONTROL 1968 AGREEMENT




PROJECT 10.4 CONTRACT NO. 2
SOUTH WESTMINSTER FLOOD CONTROL WORKS
DYKE STATIONS: 0+00 TO 12+44
PLAN, PROFILE & SECTIONS

| | |
|-----------------------------|-------------------------|
| DESIGNED <i>[Signature]</i> | SURVEYED |
| DRAWN FL | DATE |
| CHECKED <i>[Signature]</i> | FILE NO. 0281550-C12D-2 |
| SCALE As shown | DATE 9 Jan 1979 |
| DWG NO. 4884-2-D2/R2 | SHEET 2 OF 43 SHEETS |

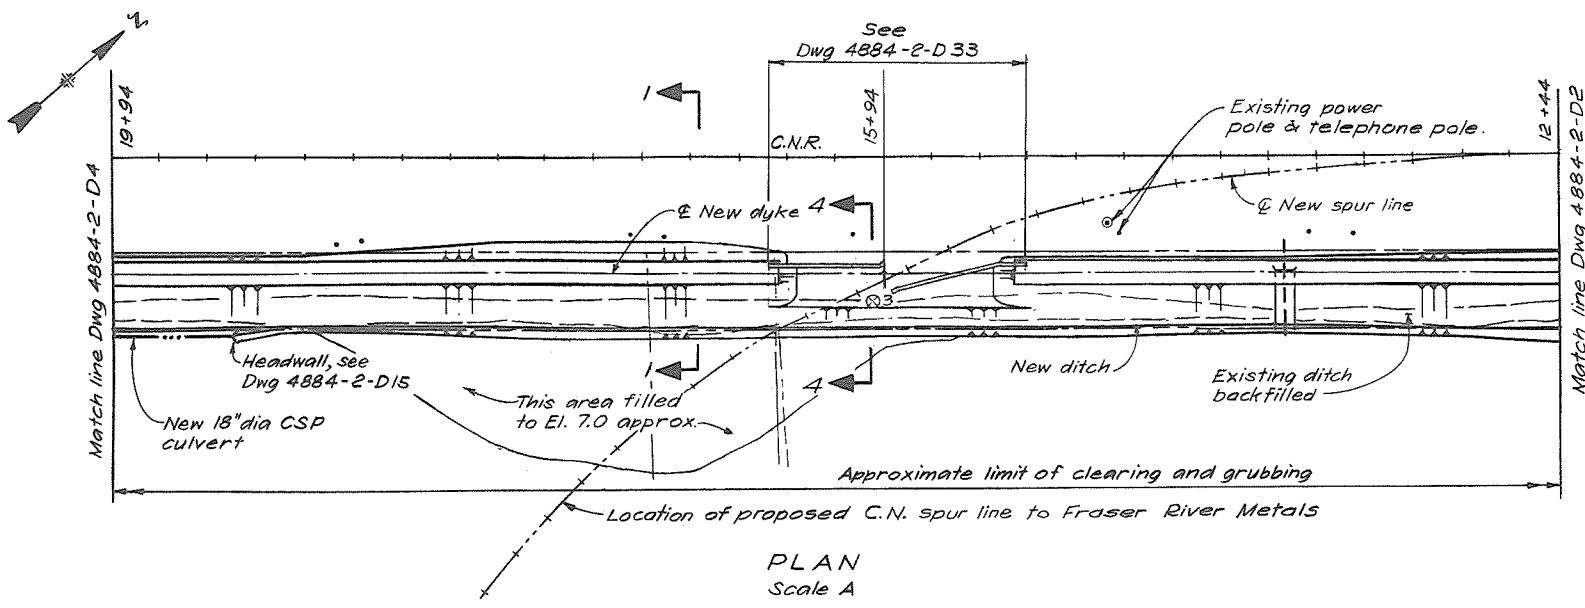


- LEGEND**
- R/W Right of way
 - CNR Canadian National Railroad
 - CN-ML CN - Main line
 - Railroad
 - Asphaltic concrete pavement
 - CSP Corrugated steel pipe, asphalt coated
 - New culvert on plan
 - Centreline
 - Legal boundary
 - Base of rail
 - New ditch invert
 - Settlement plate and piezometer on plan, nominal depth of piezometer below existing ground level in ft.
 - Settlement plate and piezometer in section
 - Excavation
 - Fill
 - Dyke coordinate
 - Fire hydrant
 - Power pole
 - Telephone pole
 - Lateral movement gauge location (Slope indicator casing on plan)
 - Lateral movement gauge location in section (Slope indicator casing in section)
 - Bottom El. of casing
 - B. V. C. Begin vertical curve
 - E. V. C. End vertical curve
 - V. P. I. Vertical point of intersection

- GENERAL NOTES**
1. Dyke station measured along land side edge of dyke wall or ϕ of new dyke.
 2. All sections taken normal to dyke wall centreline or new dyke centreline.
 3. Dyke outline shown in cross-section is section of dyke required. Additional settlement allowance not shown.
 4. Limits of clearing and grubbing as shown on sections are typical for areas as indicated on plans and are maximum limits. Actual limits will be determined in field by the Engineer.
 5. Dyke and dyke wall alignment have been set by coordinate points and for the dyke section adjacent to the CNR tracks by offsets measured at right angles to and from centreline of south railroad track.
 6. Seeding
Areas to be seeded by District of Surrey in Spring 1986 which were deleted from the Contract, are noted "to be seeded." Areas seeded are noted "Seeded."

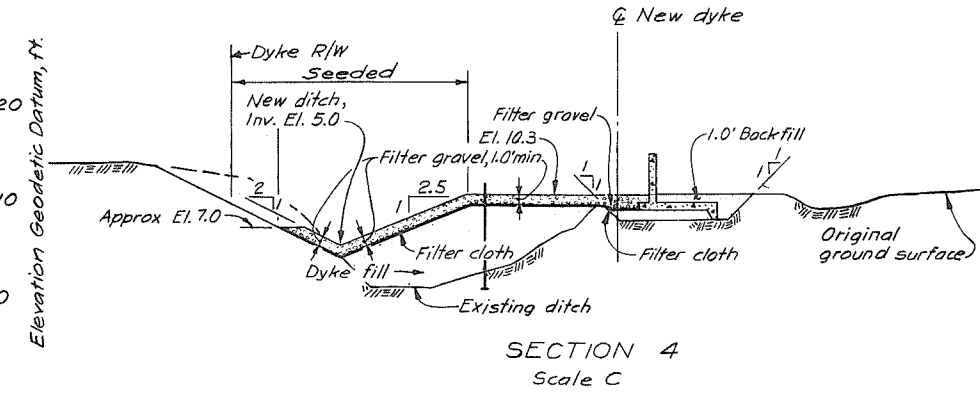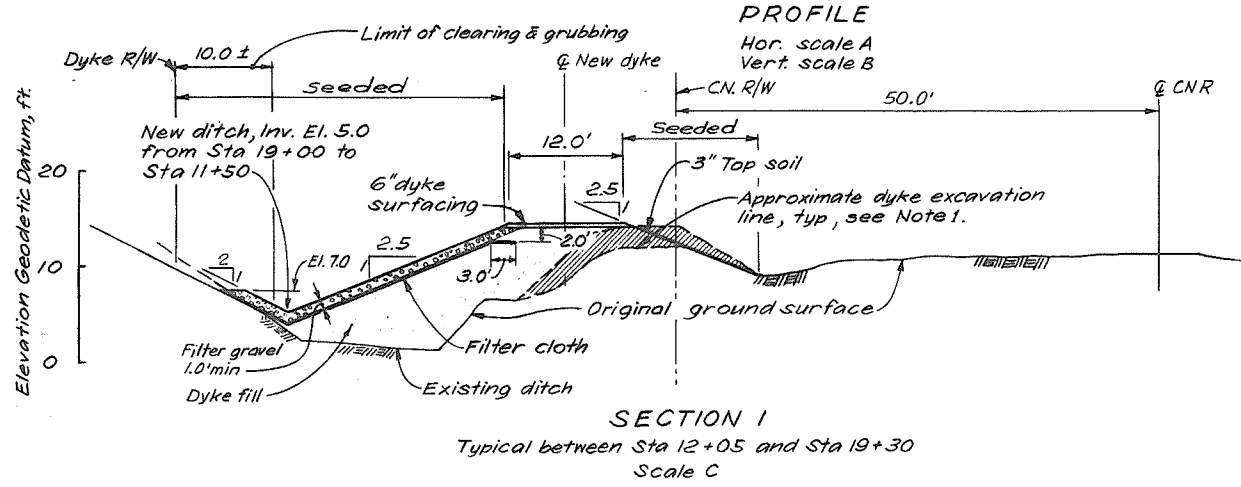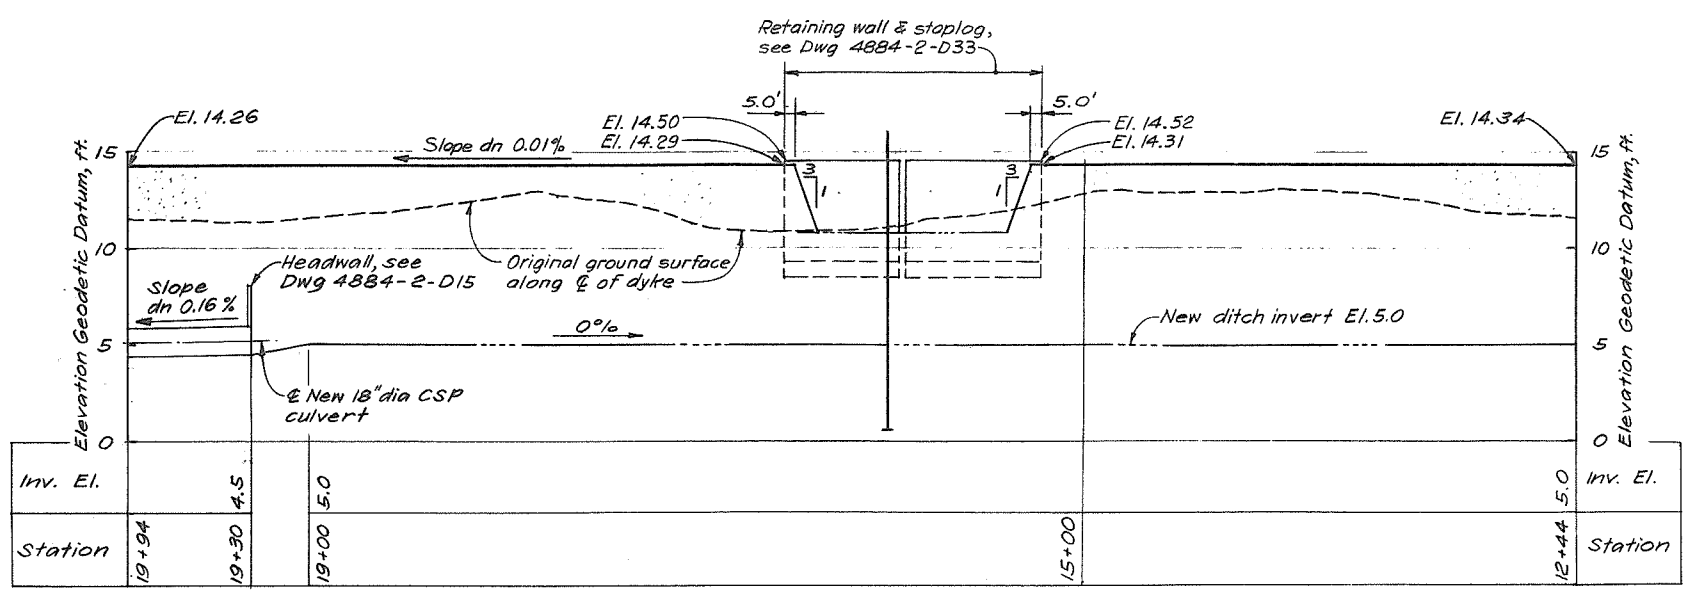

NOTE

1. Dyke excavation shall be determined in the field.
2. Spur line copied from C.N. Drawing 5720-2.377-1 dated 16-1-'85.

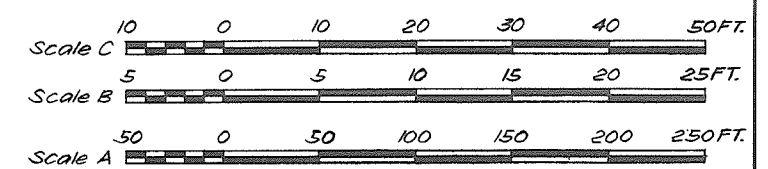

CRIPPEN ENGINEERING LTD.
NORTH VANCOUVER, B.C.
PROJECT NO. 10405

DEPARTMENT HEADS: *H. H. H. H. H.* *C.R. Blundell*

PROJECT ENGINEER: *[Signature]*

CHIEF ENGINEER: *[Signature]*

3. Record Drawing.
2. Opening for C.N.R. Spur line, Section 2 & Note 2 added.

APPROVED FOR CONSTRUCTION JUL 23 84

1. Prepared for Tender (combined contracts)

| NO. | DESCRIPTION | BY | CHKD | APPR | DATE |
|-----|-------------|----|------|------|--------|
| 1 | | MP | | | 4-4-85 |
| 2 | | MP | | | 5-6-84 |

RECOMMENDED *[Signature]* PROJECT MANAGER

DATE: June 6 1984




APPROVED *[Signature]* DIRECTOR, WATER INVESTIGATIONS

DATE: June 6/84


BRITISH COLUMBIA
MINISTRY OF THE ENVIRONMENT
WATER INVESTIGATIONS BRANCH
CANADA-BRITISH COLUMBIA
FRASER RIVER FLOOD CONTROL 1988 AGREEMENT

PROJECT 10.4 CONTRACT NO. 2
SOUTH WESTMINSTER FLOOD CONTROL WORKS
DYKE STATIONS: 12+44 TO 19+94
PLAN, PROFILE & SECTION


| DESIGNED | SURVEYED |
|-----------------------|-------------------------|
| <i>[Signature]</i> | |
| DRAWN FL | DATE |
| CHECKED NAC RCD | FILE NO. 0281550-C12D-2 |
| SCALE As shown | DATE 9 Jan 1979 |
| DWG. NO. 4884-2-D3/R3 | SHEET 3 OF 43 SHEETS |

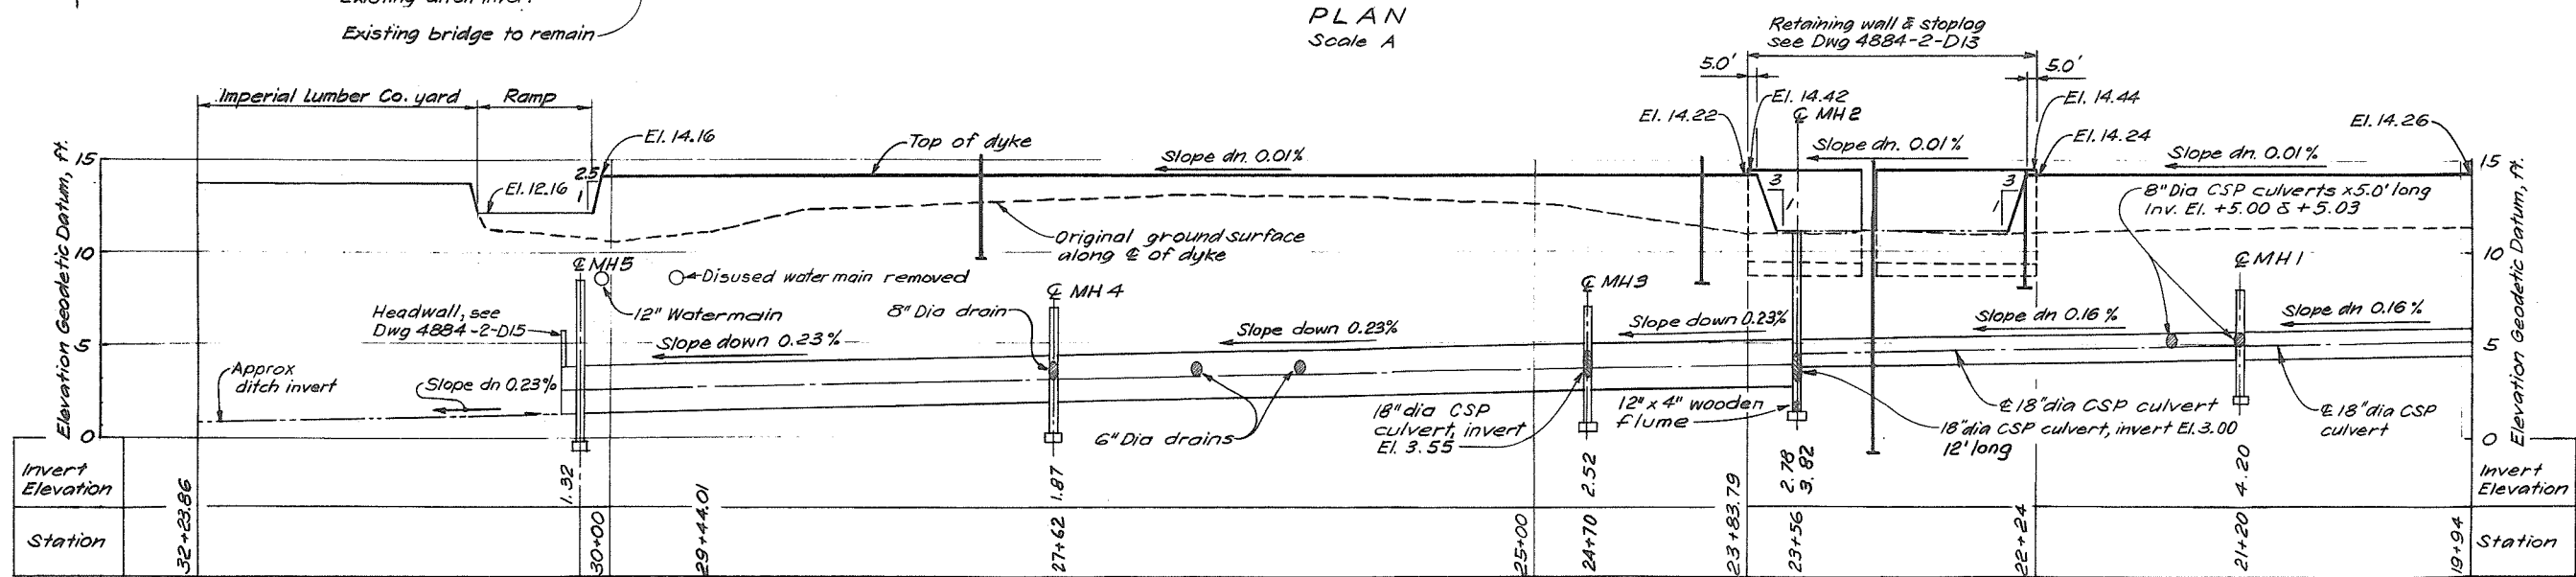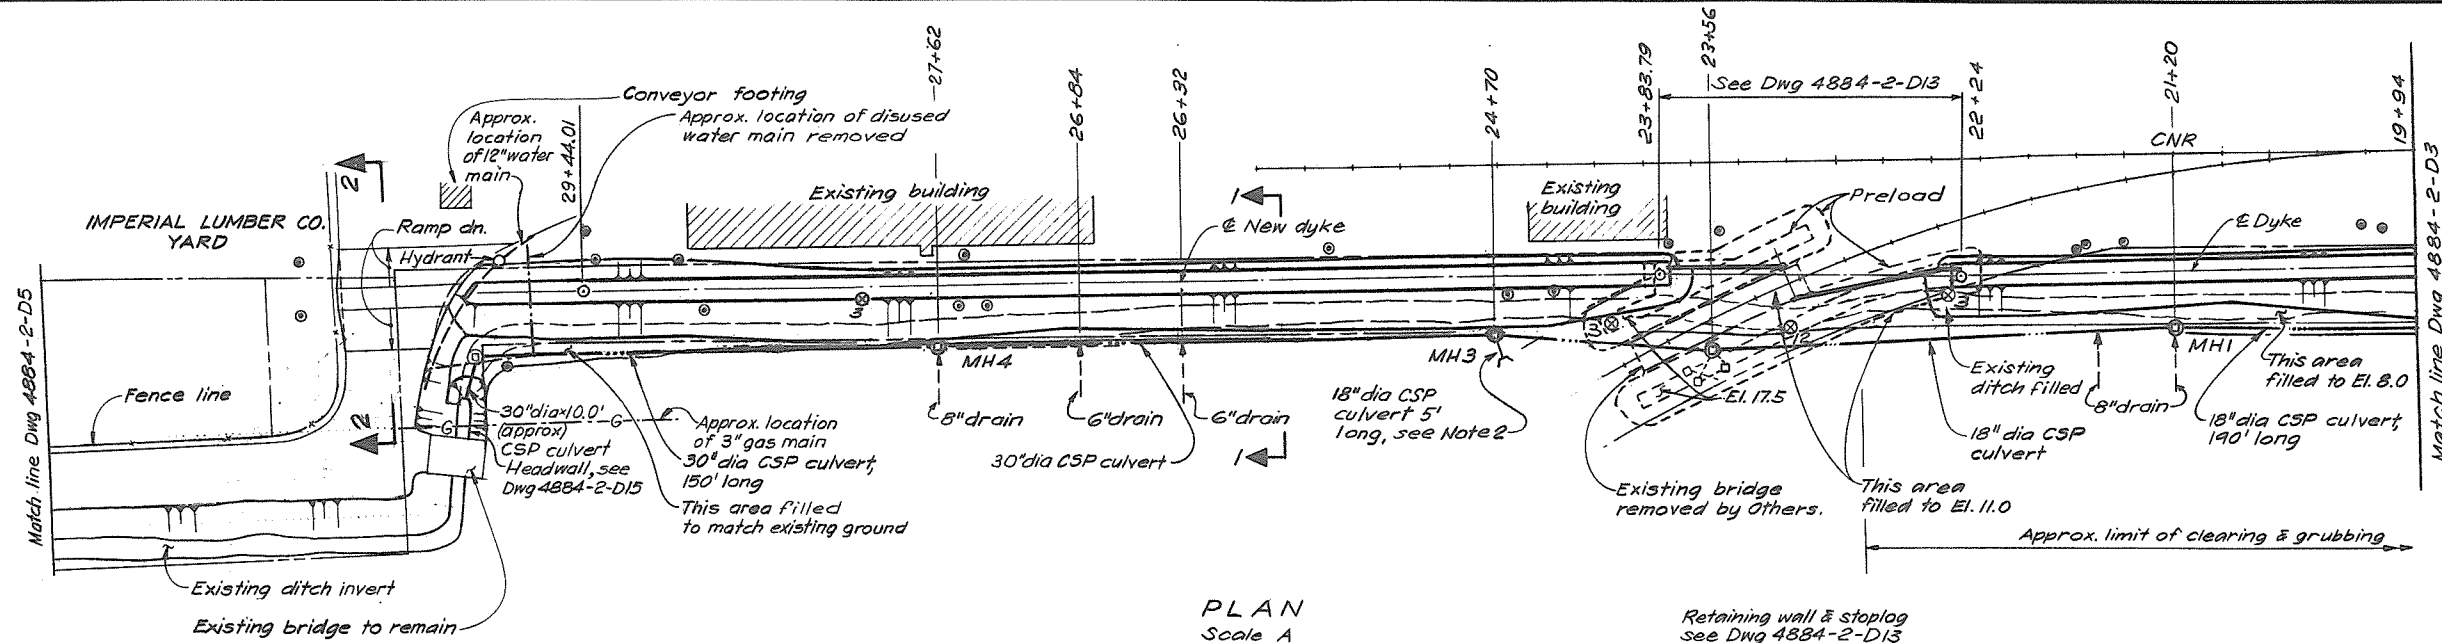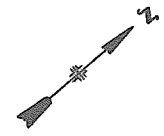

PROFILE
Hor. scale A
Vert. scale B

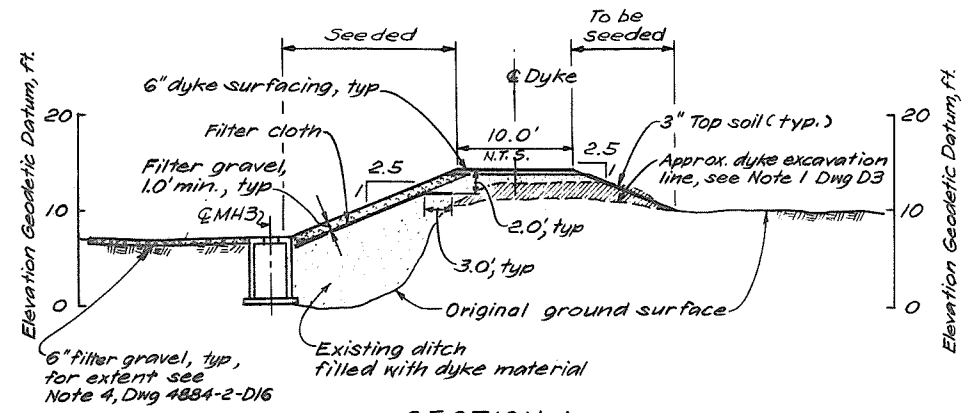


SECTION 1
Typical between Sta 19+30 and Sta 22+29
Sta 23+79 and Sta 30+02
Scale C

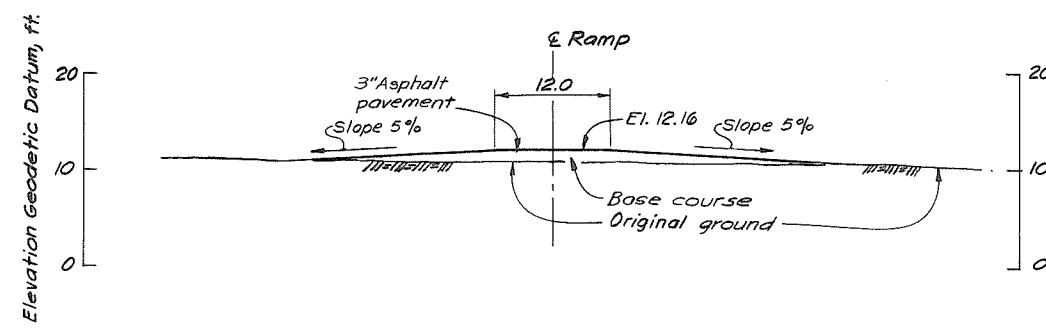

SECTION 2
Scale C

- NOTES
- For general notes and legend see Dwg 4884-2-D3.
 - For details of culvert and headwall see Dwg 4884-2-D15.

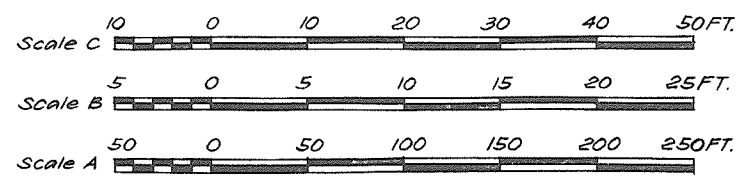

CRIPPEN ENGINEERING LTD.
NORTH VANCOUVER, B.C.
PROJECT NO. 10405

DEPARTMENT HEADS: *H. H. ...* *C. Bland*

PROJECT ENGINEER: *M. A. Merlo*

CHIEF ENGINEER: *J. ...*

2. Record Drawing
APPROVED FOR CONSTRUCTION JULY 1984

1. Prepared for Tender (Combined contracts)

| NO. | DESCRIPTION | BY | CHK | APPR | DATE |
|-----|-------------|-----|-----|------|---------|
| 1 | | FRS | MM | MM | 5-6-84 |
| 2 | | MM | MM | MM | 12-3-85 |

RECOMMENDED: *[Signature]*
PROJECT MANAGER

DATE: June 6, 1984




APPROVED: *[Signature]*
DIRECTOR, WATER INVESTIGATIONS

DATE: *[Signature]*

BRITISH COLUMBIA
MINISTRY OF THE ENVIRONMENT
WATER INVESTIGATIONS BRANCH
CANADA-BRITISH COLUMBIA
FRASER RIVER FLOOD CONTROL 1968 AGREEMENT


PROJECT 10.4 CONTRACT NO. 2
SOUTH WESTMINSTER FLOOD CONTROL WORKS
DYKE STATIONS: 19+94 TO 32+23.86
PLAN, PROFILE & SECTION

| DESIGNED | SURVEYED |
|------------------------|--------------------------|
| <i>[Signature]</i> | |
| DRAWN: FL | DATE: |
| CHECKED: NAC RCD | FILE NO.: 0281550-C12D-2 |
| SCALE: As shown | DATE: 9 Jan 1979 |
| DWG. NO.: 4884-2-D4/R2 | SHEET 4 OF 43 SHEETS |

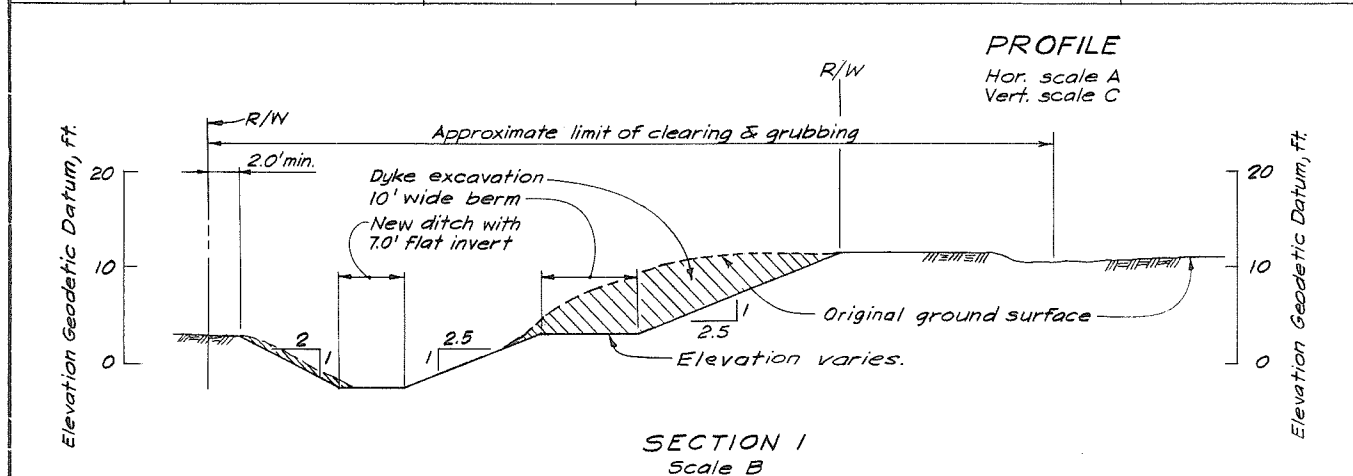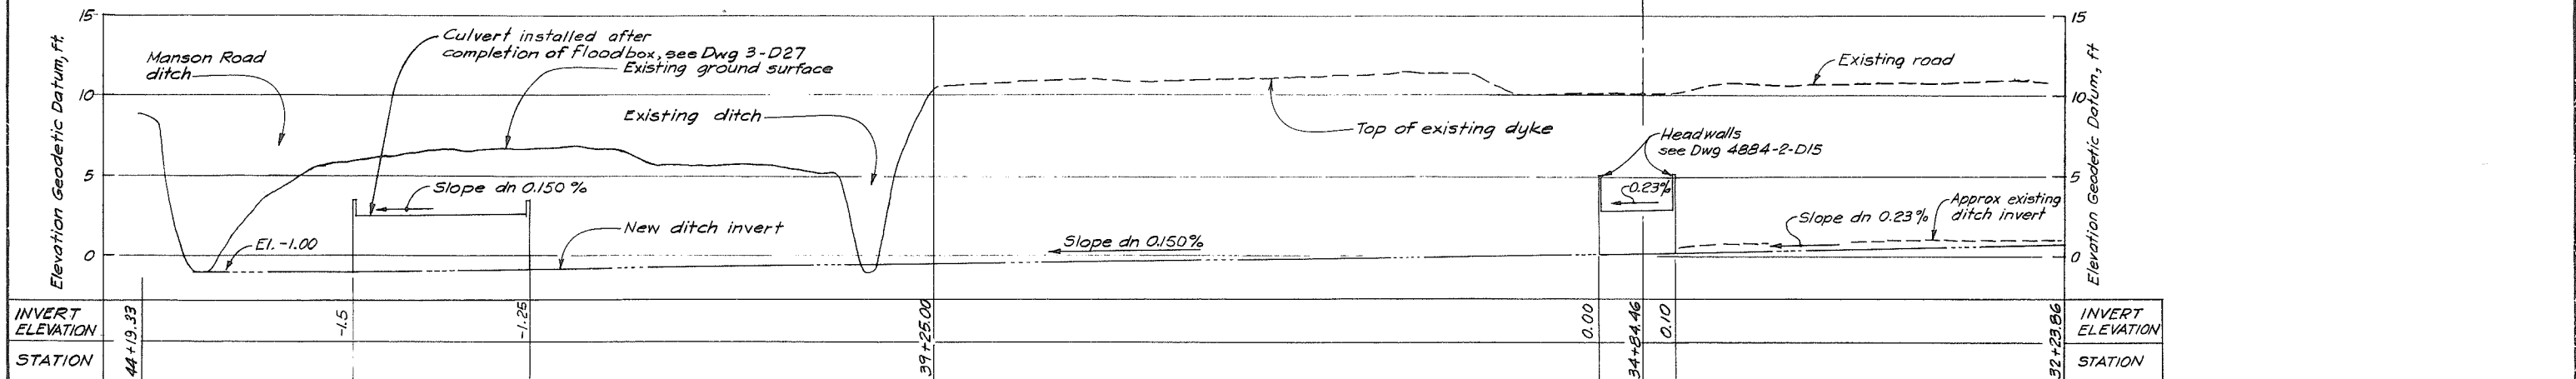
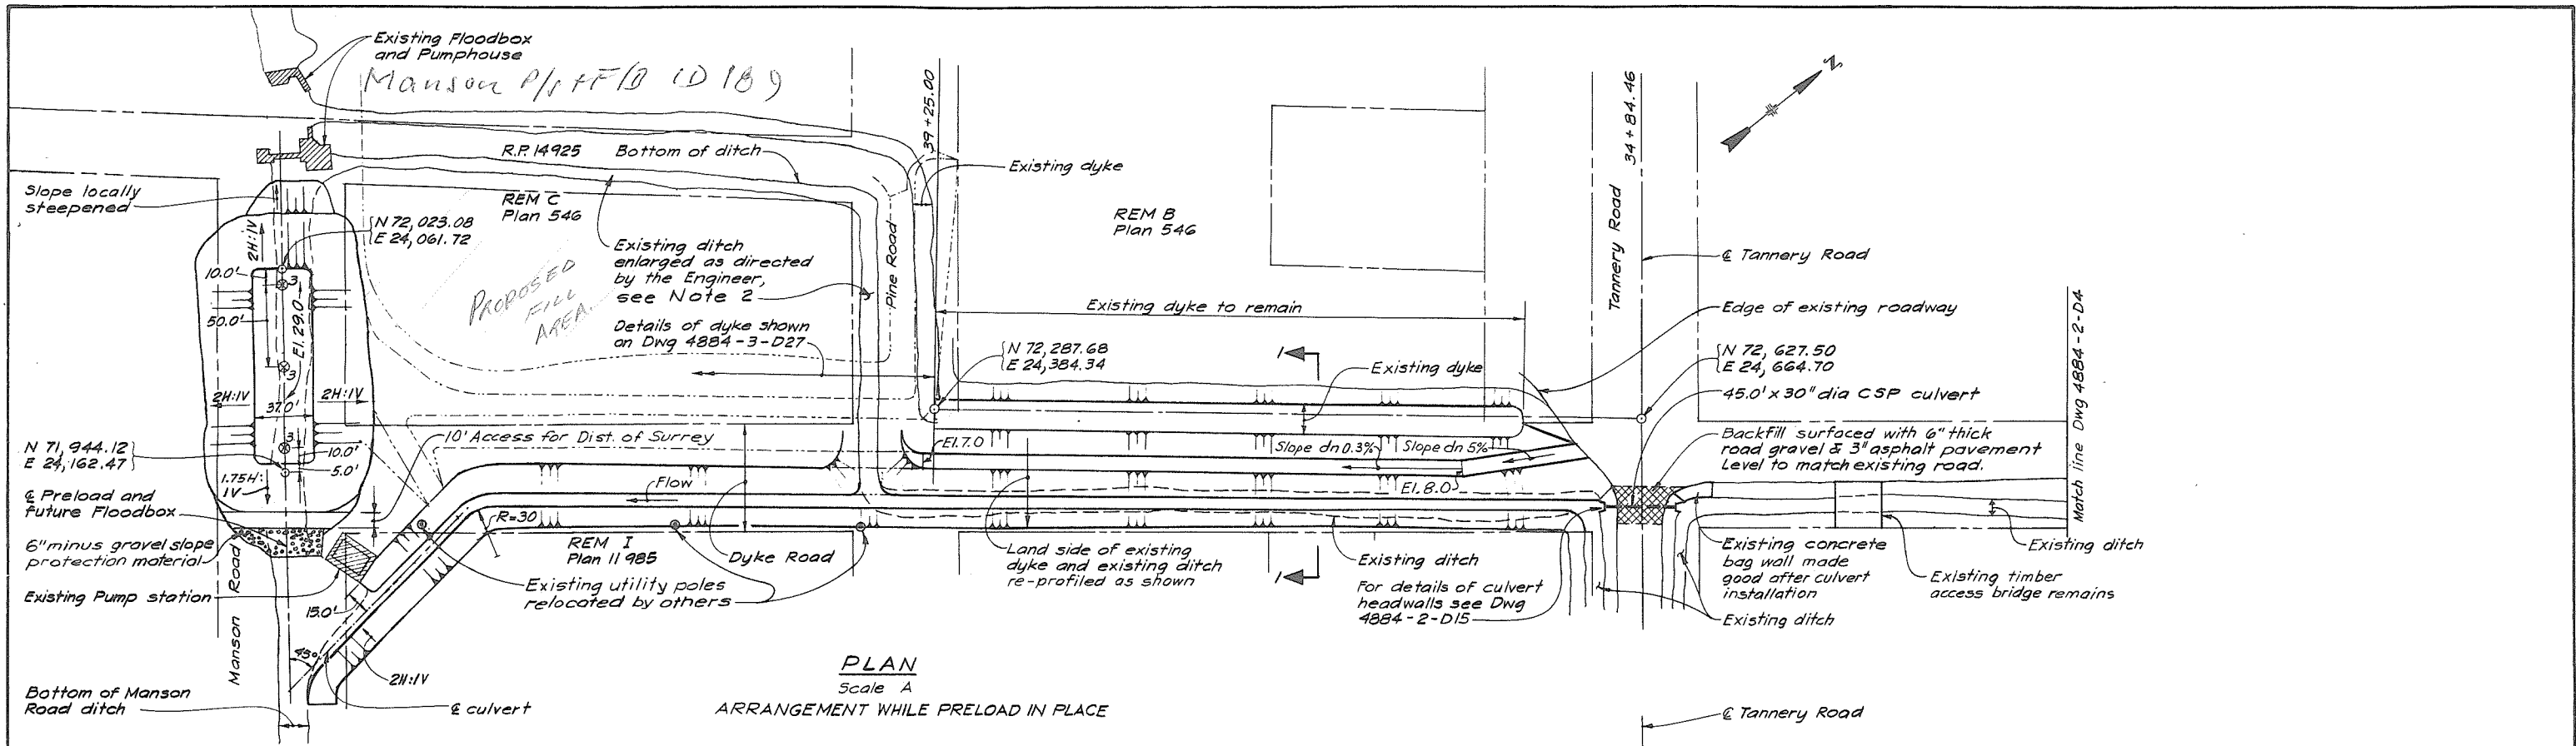


NOTES


- For general notes and legend see Dwg 4884-2-D3.
- The contractor enlarged this ditch to ensure adequate drainage of the Manson channel during the time that the Manson preload was in place.

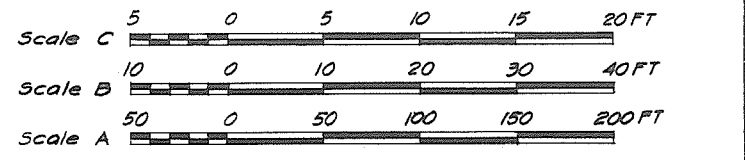


| | | | | | | | | |
|--|---|--|--|---|---|--|--|--|
| | CRIPPEN ENGINEERING LTD. NORTH VANCOUVER, B.C. PROJECT NO. 10407 | DEPARTMENT HEAD: <i>[Signature]</i> | 2 Record Drawing APPROVED FOR CONSTRUCTION JUL 25 84 1. Prepared for tender (Combined contracts) | BY: <i>[Signature]</i> CHD DATE: 12-9-85 | RECOMMENDED: <i>[Signature]</i> PROJECT MANAGER | BRITISH COLUMBIA MINISTRY OF ENVIRONMENT WATER INVESTIGATIONS BRANCH CANADA-BRITISH COLUMBIA FRASER RIVER FLOOD CONTROL 1988 AGREEMENT | DESIGNED: <i>[Signature]</i> | SURVEYED: |
| | | PROJECT ENGINEER: <i>[Signature]</i> CHIEF ENGINEER: <i>[Signature]</i> | | | DATE: June 6 1984 | | APPROVED: <i>[Signature]</i> DIRECTOR, WATER INVESTIGATIONS DATE: Jun 16/84 | DRAWN: L.S. CHECKED: <i>[Signature]</i> SCALE: As shown DWG. NO: 4884-2-D5/R2 |

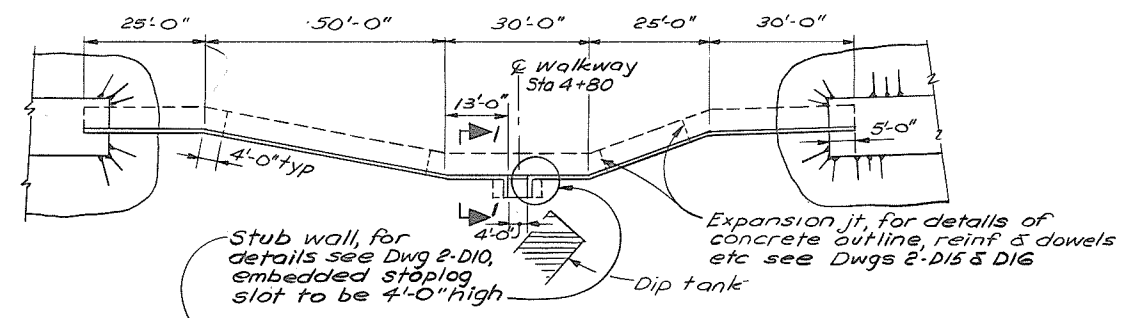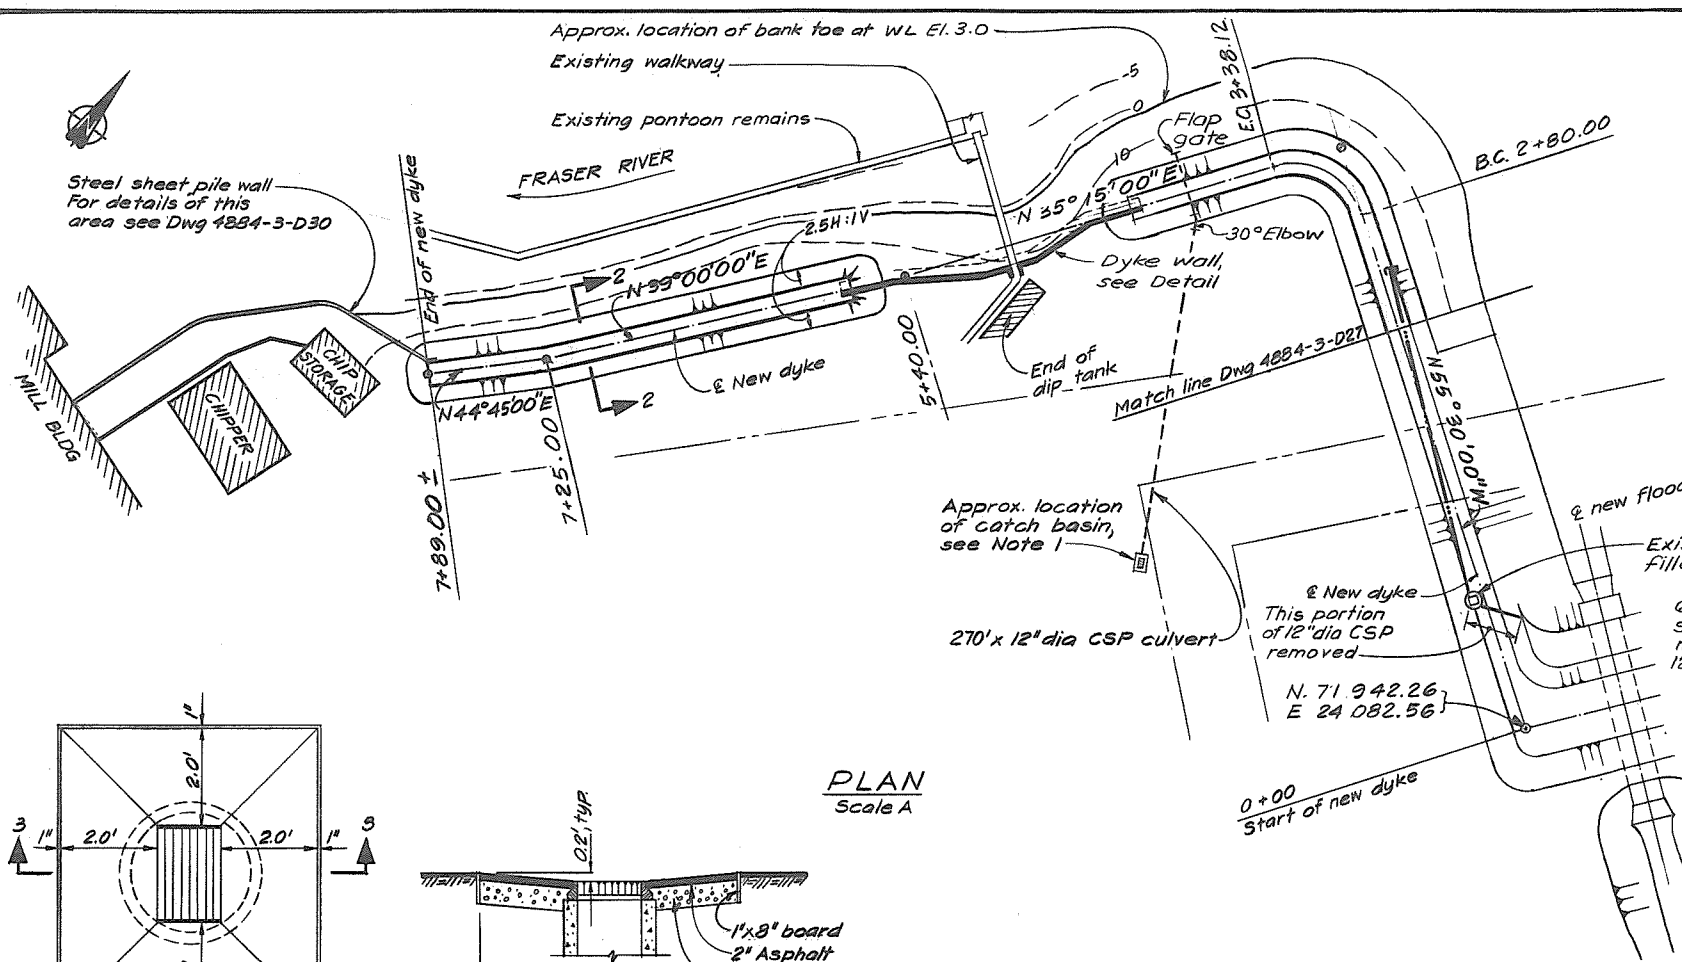


DYKE WALL
NTS

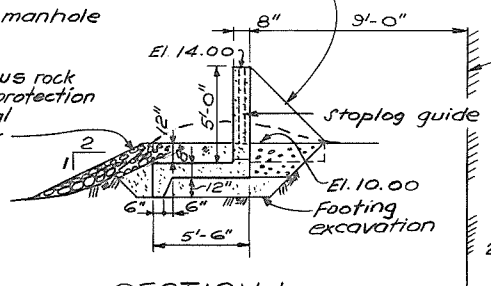


SECTION I
Reinf similar to Dyke Wall Dwg 2-D7 (Except height = 5'-0")
Backfill similar to Section 1 Dwg 2-D7.

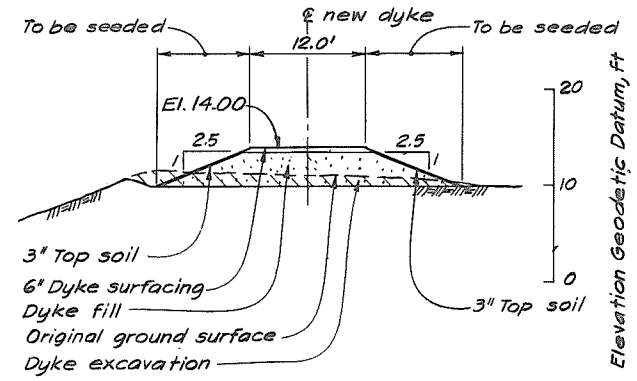


SECTION 2
Scale B

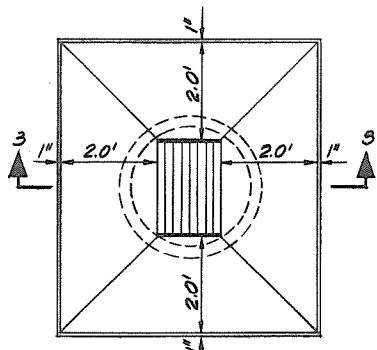


CATCH BASIN - PLAN
Scale NTS

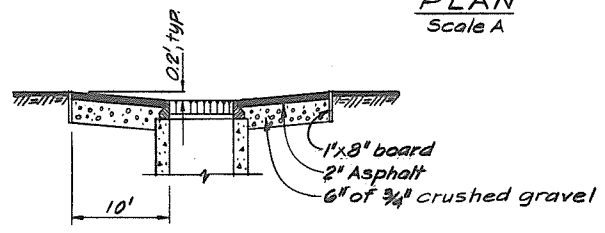


SECTION 3
Scale NTS

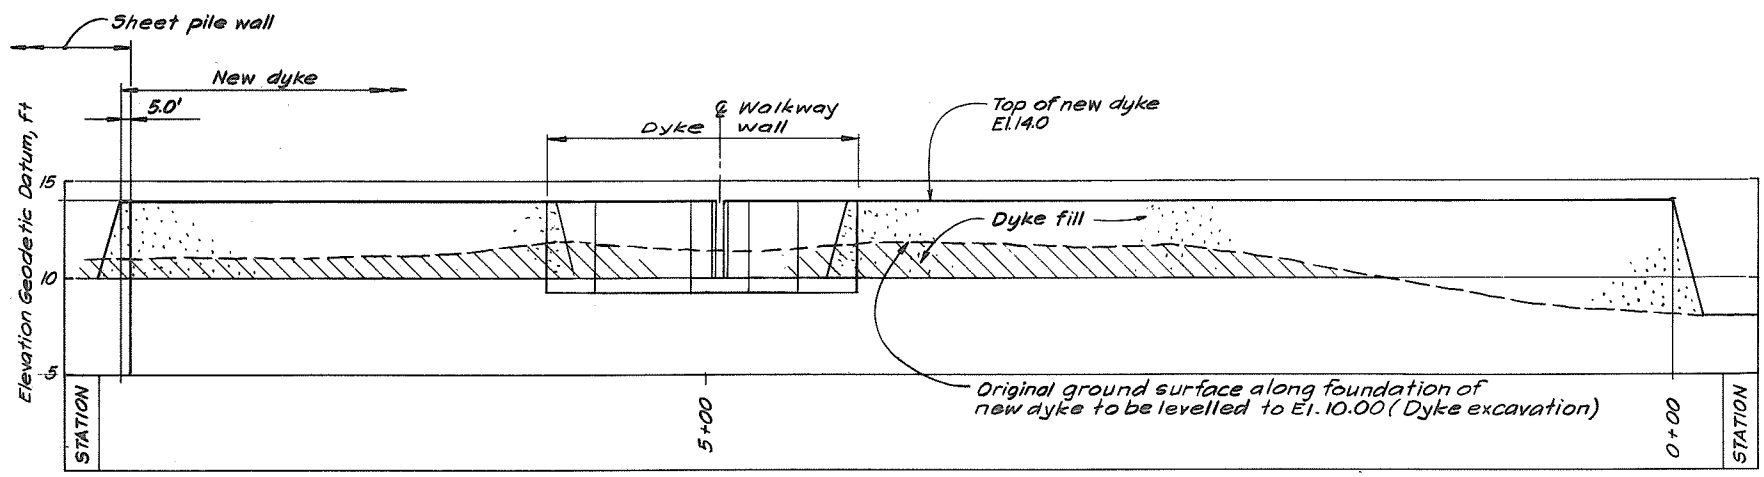

PROFILE
Hor. scale A
Vert. scale C

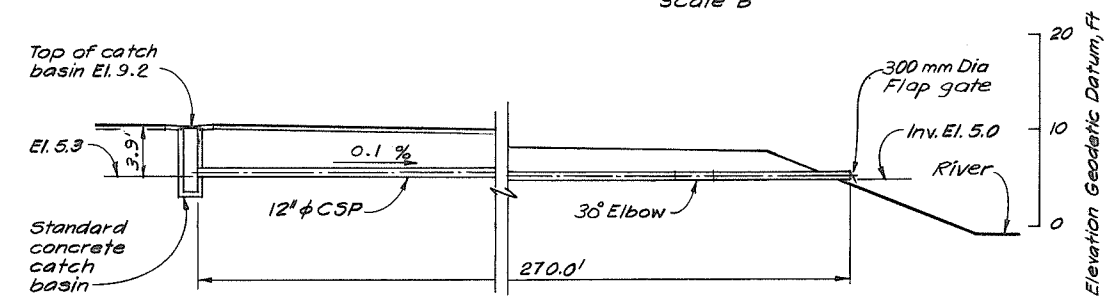

CULVERT PROFILE
Scale B

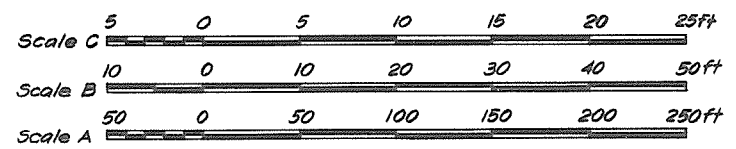


CRIPPEN ENGINEERING LTD.
NORTH VANCOUVER, B.C.
PROJECT NO. 10407
DEPARTMENT HEAD: *[Signature]*
PROJECT ENGINEER: *[Signature]*
CHIEF ENGINEER: *[Signature]*

| NO | DESCRIPTION | BY | CHK | APPR | DATE |
|----|--|------|-----|------|---------|
| 3 | Record Drawing | MHW | | | 23-9-83 |
| 2 | Dyke wall added | MHW | | | 2-7-84 |
| 1 | Combined Contracts & Alignment of dyke revised; redrawn. | L.S. | | | 5-6-84 |


RECOMMENDED: *[Signature]*
DATE: June 6 1984
APPROVED: *[Signature]*
DATE: *[Signature]*

BRITISH COLUMBIA
MINISTRY OF ENVIRONMENT
WATER INVESTIGATIONS BRANCH
CANADA-BRITISH COLUMBIA
FRASER RIVER FLOOD CONTROL 1968 AGREEMENT
PROJECT 10.4 CONTRACT NO. 2
SOUTH WESTMINSTER FLOOD CONTROL WORKS
MANSON ROAD DYKES - 0+00 TO 7+89
PLAN, PROFILES & SECTIONS


DESIGNED: FIB
DRAWN: L.S.
CHECKED: CR
SCALE: As shown
DWG. NO: 4884-2-D6/R3
SURVEYED: []
DATE: []
FILE NO: 0281550-CI2D-2
DATE: Feb. 29, 1984
SHEET 6 OF 43 SHEETS

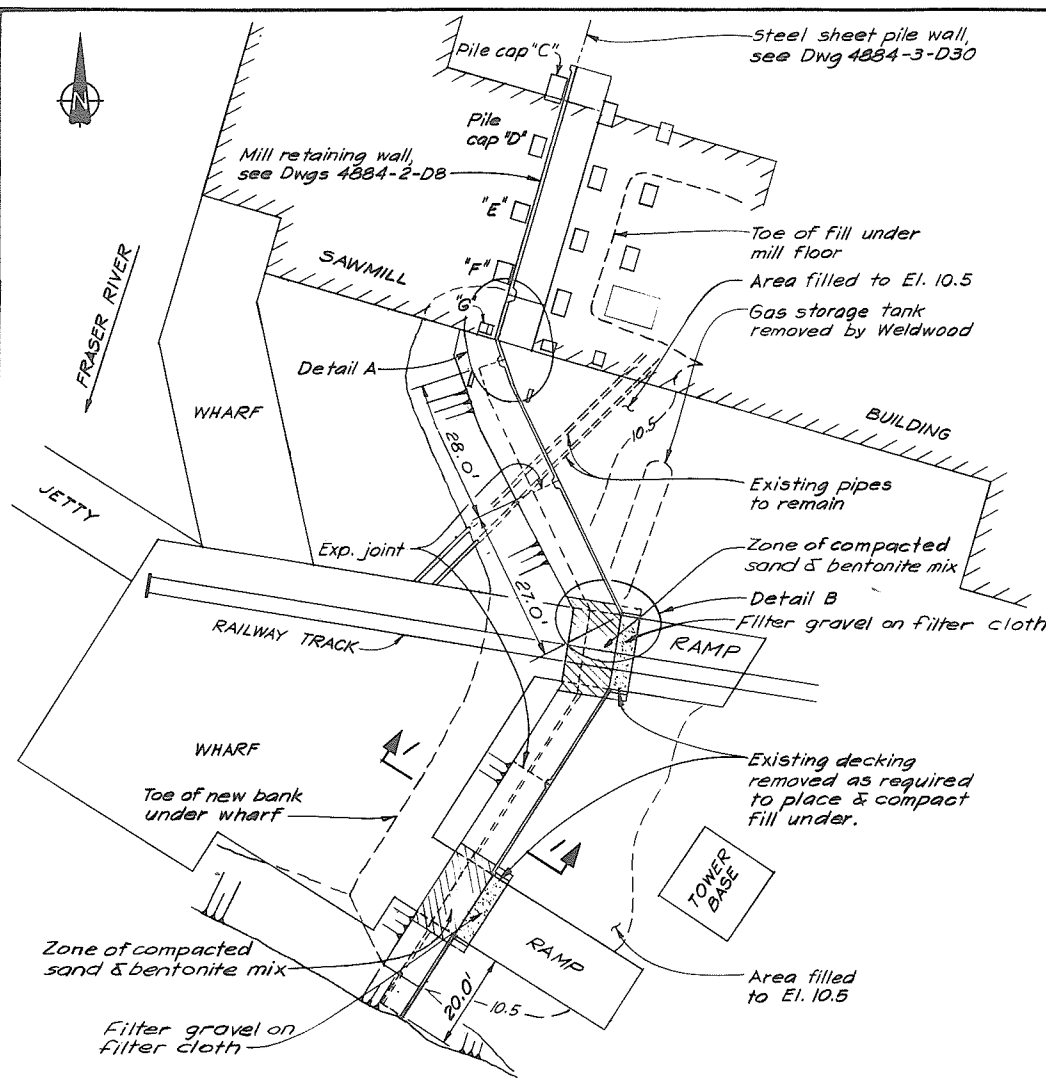

PLAN
Scale A

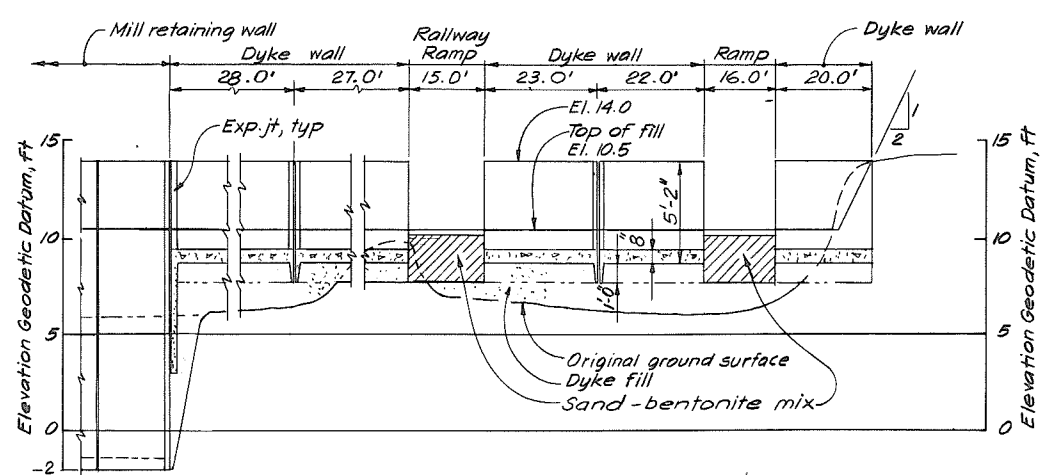


PROFILE
Hor. scale A
Vert. scale B

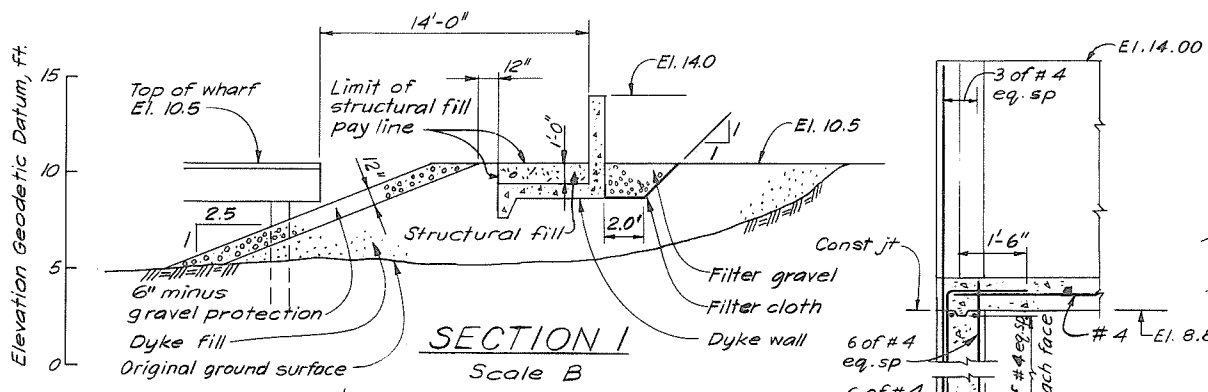


SECTION 1
Scale B

DETAIL C
N.T.S.


TYPICAL DYKE WALL SECTION
Scale D

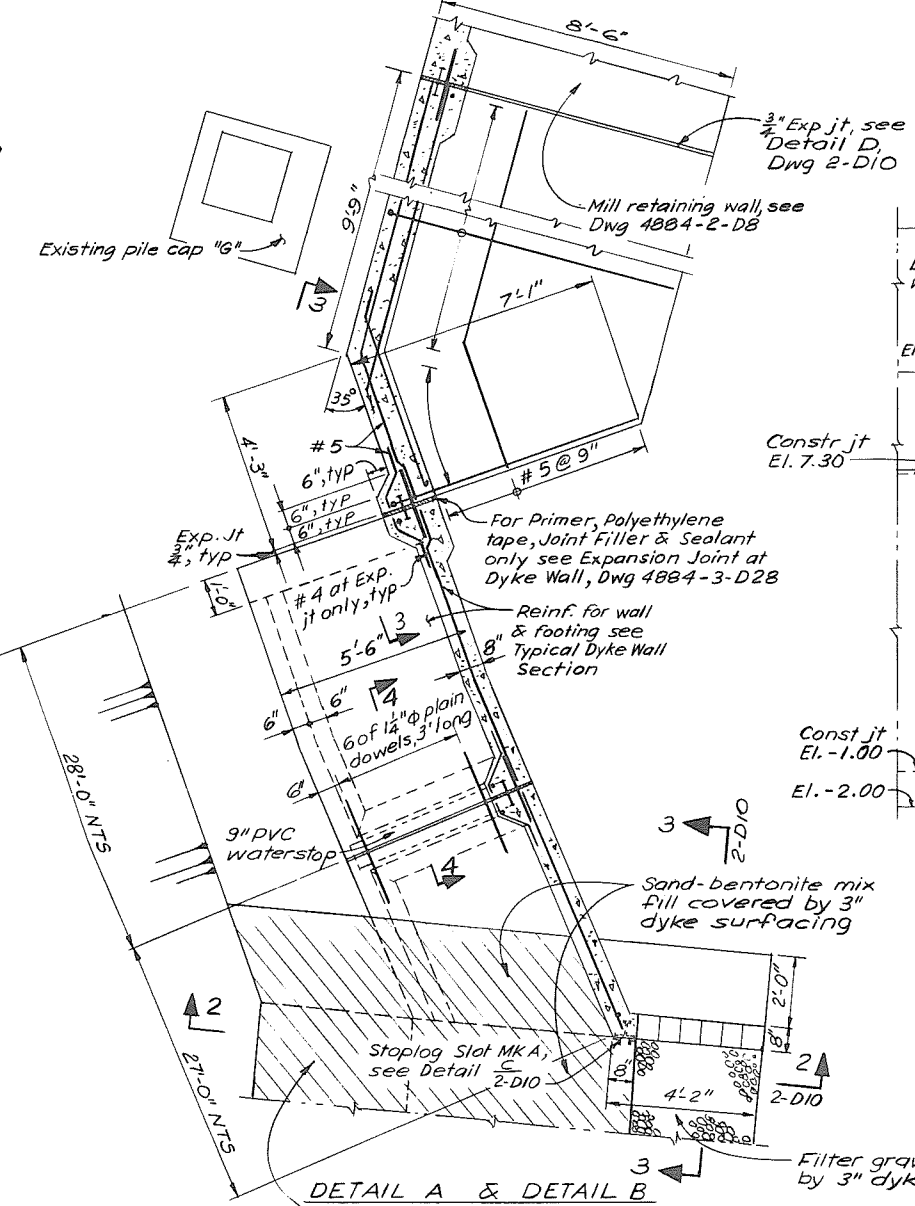



DETAIL A & DETAIL B
Scale C
(Dyke fill not shown)
Detail B at other ramp similar

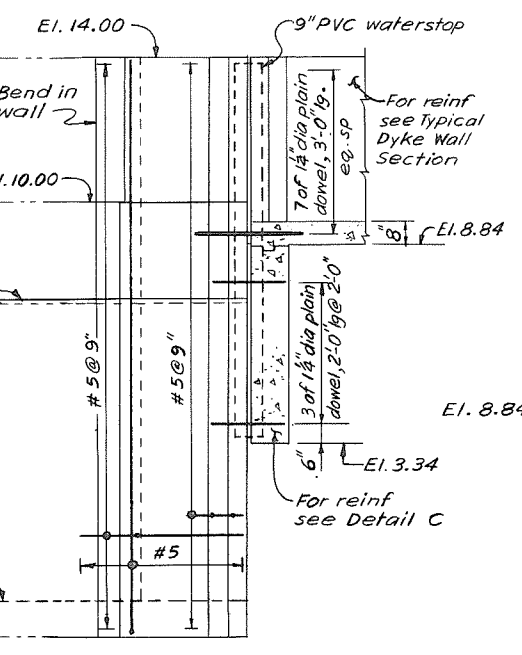

SECTION 3
Scale C

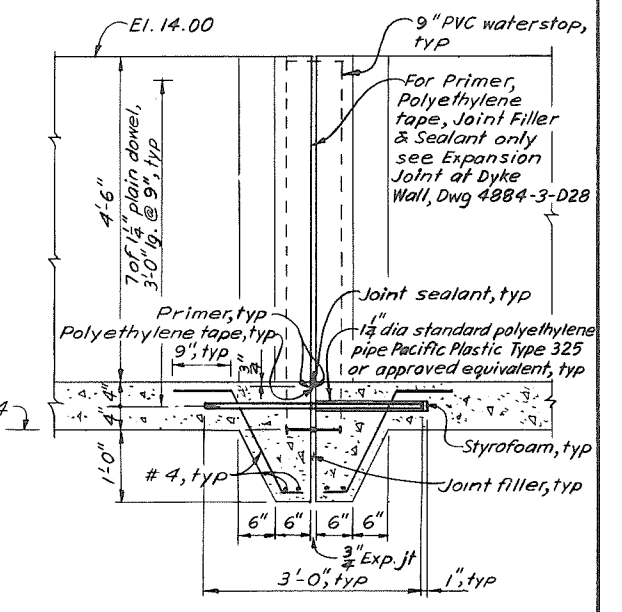

SECTION 4
N.T.S.

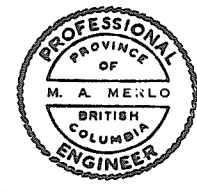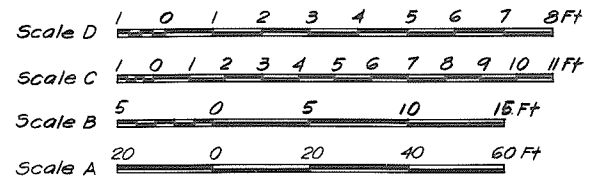

CRIPPEN ENGINEERING LTD.
NORTH VANCOUVER, B.C.
PROJECT NO. 10417
DEPARTMENT HEAD: J. Boyce
PROJECT ENGINEER: M. A. Merlo
CHIEF ENGINEER: M. A. Merlo

| | | | |
|---|---|------------|----------|
| 4 | Record Drawing | MAW/jm | 4-12-85 |
| 3 | Plan, Profile, Section 1, Typical Dyke Wall Section & Detail A modified. Sections 3 & 4 and Detail C added. | S.K.C./jms | 19-12-84 |
| 2 | Mill retaining wall extended & pile cap "C" added. APPROVED FOR CONSTRUCTION JUL 25 84 | MP/FRS/jm | 13-10-84 |
| 1 | Prepared for Tender (Combined Contracts) | MMW/MA | 5-6-84 |


RECOMMENDED: *EndoBank*
PROJECT MANAGER
DATE: June 6 1984
APPROVED: *John Miller*
DIRECTOR, WATER INVESTIGATIONS
DATE: June 6 1984

BRITISH COLUMBIA
MINISTRY OF ENVIRONMENT
WATER INVESTIGATIONS BRANCH
CANADA - BRITISH COLUMBIA
FRASER RIVER FLOOD CONTROL 1968 AGREEMENT
PROJECT 10.4 CONTRACT 2
SOUTH WESTMINSTER FLOOD CONTROL WORKS
WELDWOOD - MILL RETAINING WALL & DYKE
WALL - GENERAL ARRANGEMENT



| | | | | |
|-----------------------|---------------------|---------------------------|---------------------|----------------------|
| DESIGNED: FRB | DRAWN: L.S. | CHECKED: CRL | SCALE: As shown | DWG NO: 4884-2-D7 R4 |
| APPROVED: [Signature] | DATE: 20 March 1984 | FILE NO: 0 281 550-C12D-2 | DATE: 20 March 1984 | 7 OF 43 SHEETS |

Steel sheet pile wall, see Dwg 4884-3-D30

Dyke wall see Dwg 2-D7

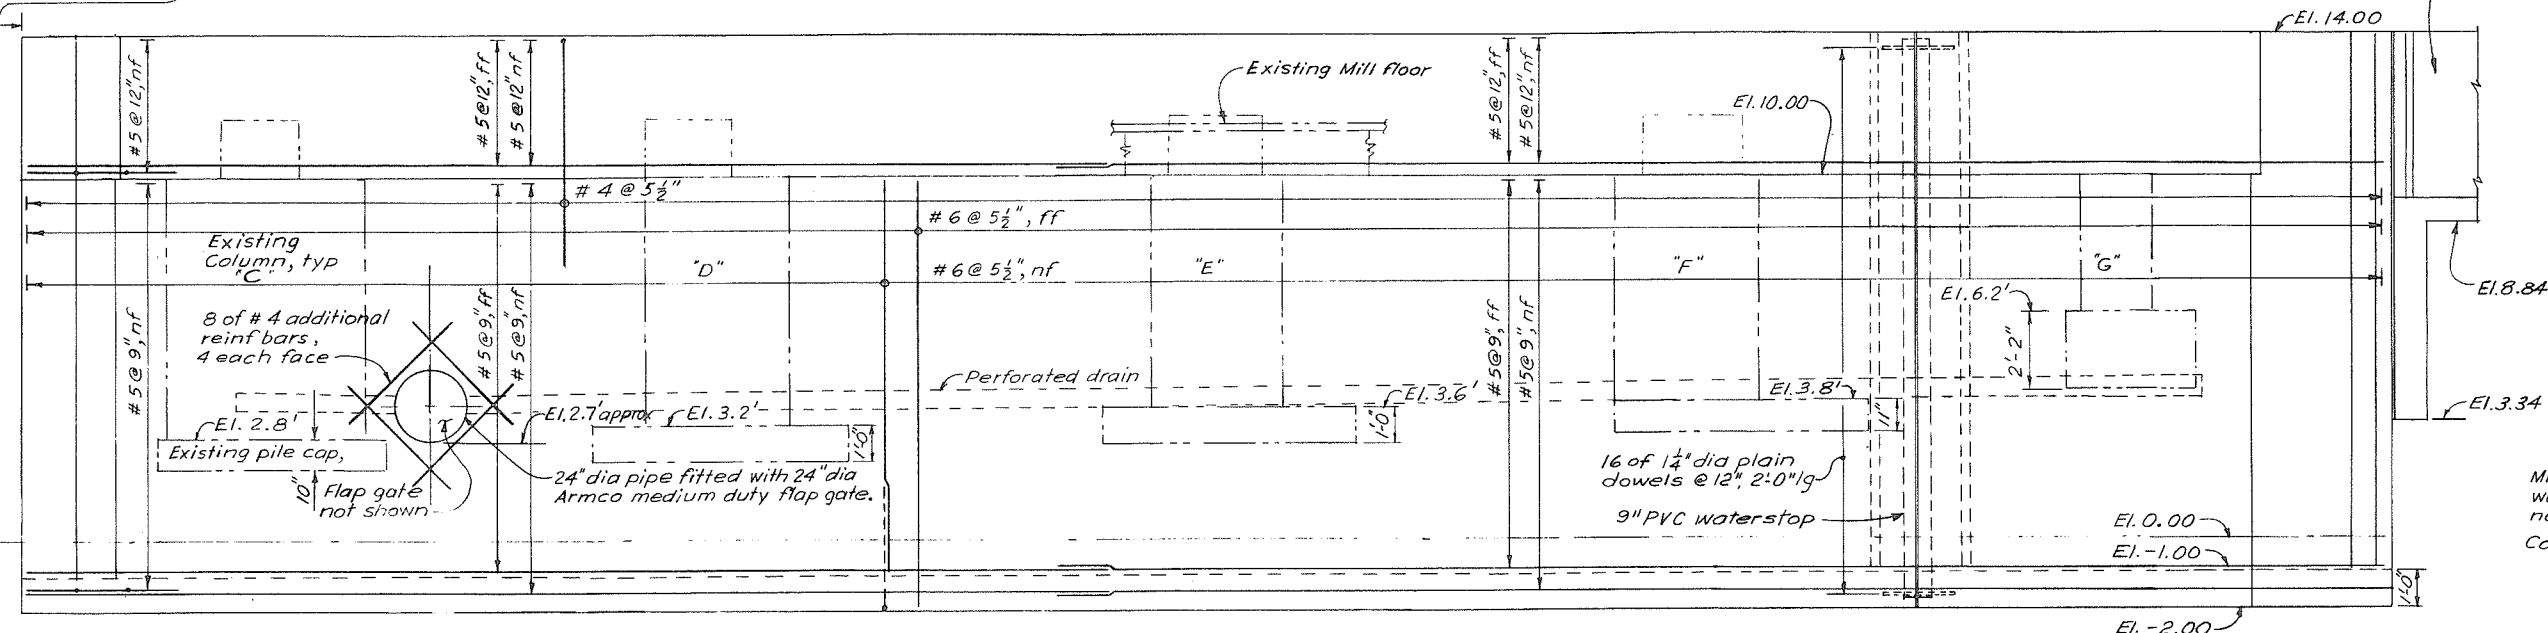


Note: Elevation of Pile cap/Column bases:-
 C1. +2.30; F1. +4.40;
 D1. +3.67; G1. +4.95;
 E1. +2.94;

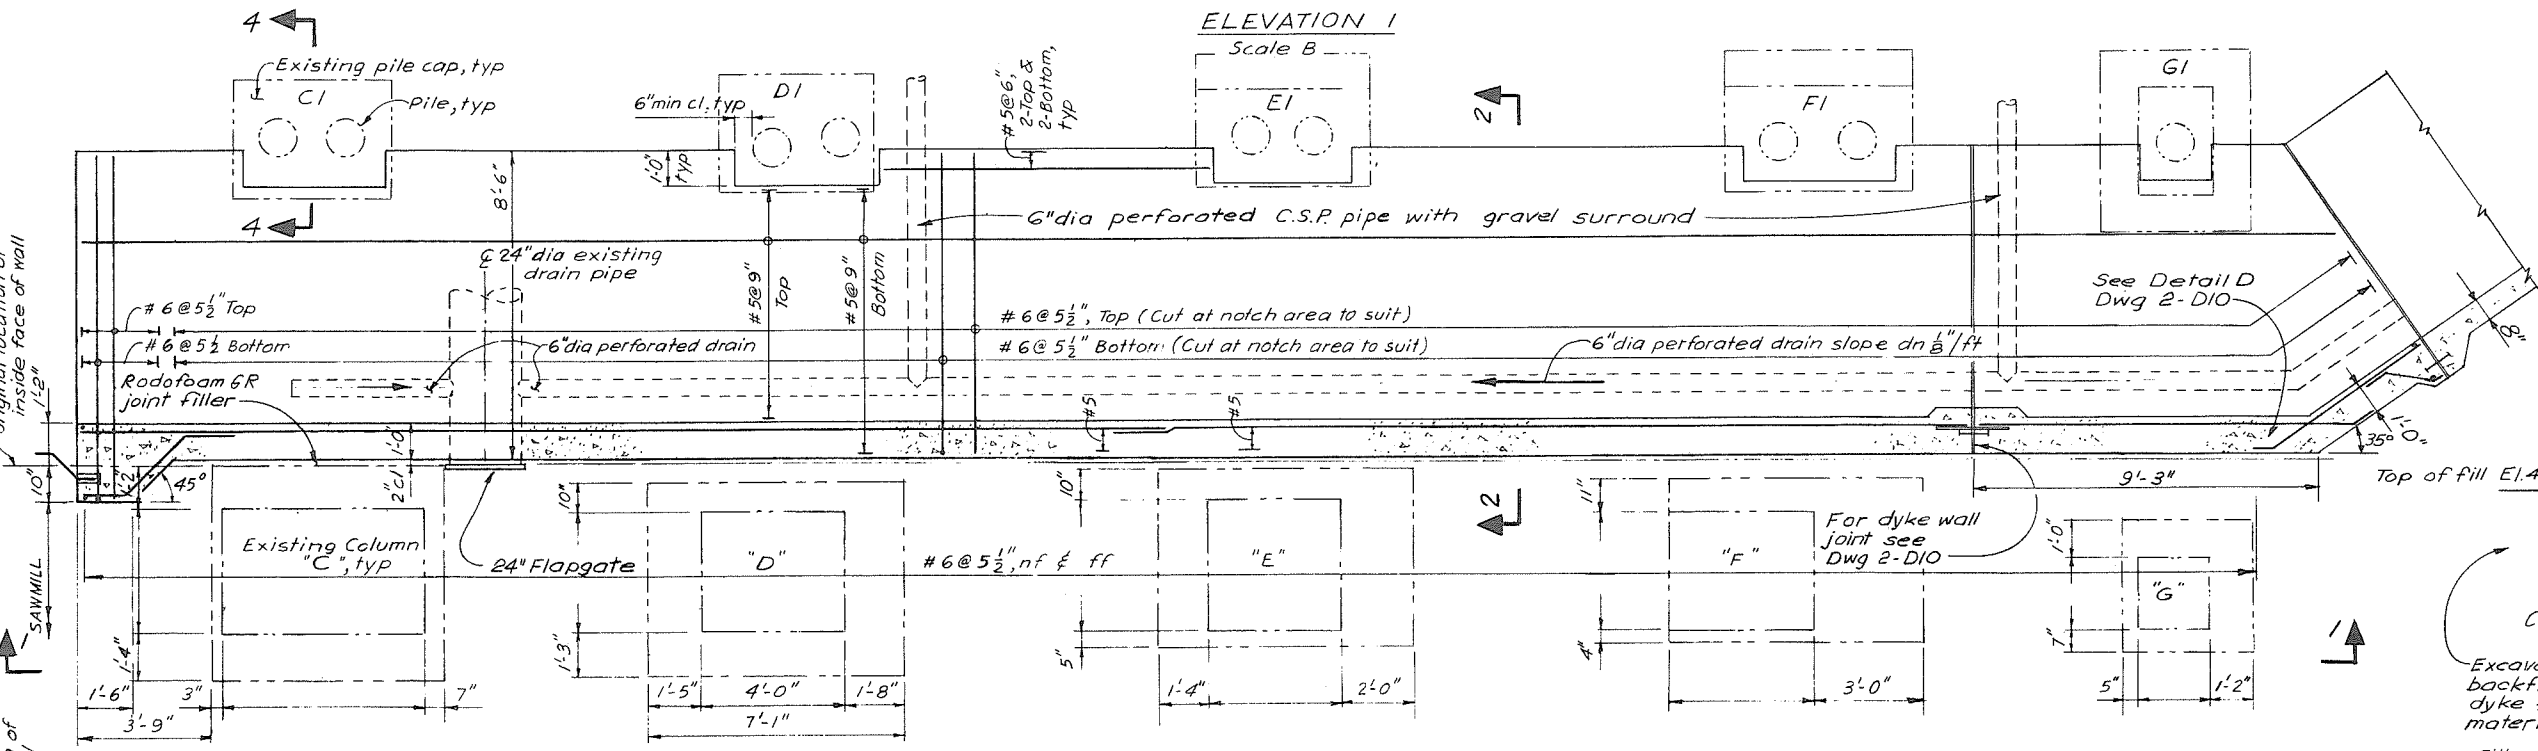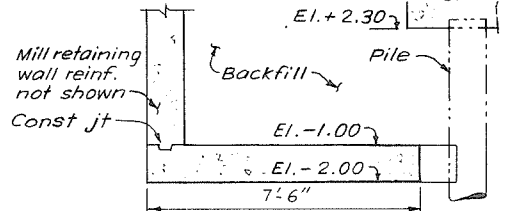

Original location of inside face of wall

Original location of inside face of wall

SECTIONAL PLAN
Scale B

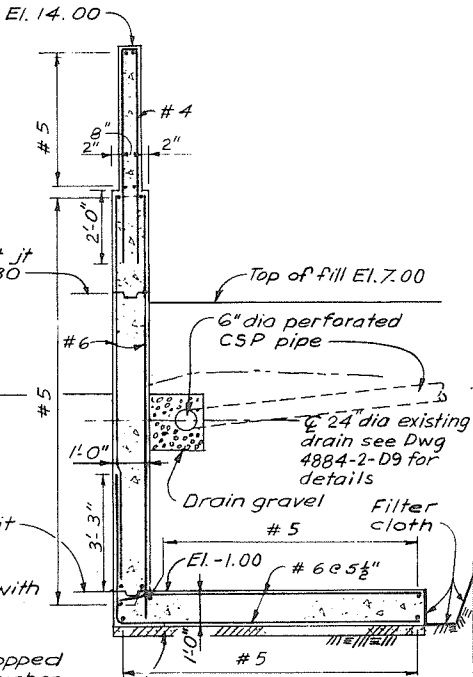

SECTION 2
Scale B

NOTES
 1. For key Plan see Dwg 4884-2-D7.
 2. Pile caps are shown for record.
 3. Dimensions to reinforcement are to \bar{c} bars unless otherwise shown.
 4. Concrete shall be Class II.
 5. Concrete cover to reinf. shall be 2" unless otherwise shown.
 6. ef, nf & ff denote each face, near face and far face respectively.
 7. MK letters to be prefixed DB and clearly painted on assemblies.

NOTES
 1. For key Plan see Dwg 4884-2-D7.
 2. Pile caps are shown for record.
 3. Dimensions to reinforcement are to \bar{c} bars unless otherwise shown.
 4. Concrete shall be Class II.
 5. Concrete cover to reinf. shall be 2" unless otherwise shown.
 6. ef, nf & ff denote each face, near face and far face respectively.
 7. MK letters to be prefixed DB and clearly painted on assemblies.



Present location of wall Original location of wall
 Sheet piling position not changed
 N.T.S.


CRIPPEN ENGINEERING LTD.
 PROJECT NO. 1040
 DEPARTMENT HEAD: *[Signature]*
 PROJECT ENGINEER: **J. B. Milne**
 CHIEF ENGINEER: *[Signature]*

| | | | | | |
|----|----------------|--------|------|----------|------|
| 4 | Record Drawing | MAN | JBM | 2-12-85 | |
| 3 | Re-drawn | S.K.C. | JBM | 11.12.84 | |
| NO | DESCRIPTION | BY | CHKD | APPR | DATE |


| | |
|-------------|--|
| RECOMMENDED | <i>John B. Milne</i> PROJECT MANAGER |
| DATE | 11. Dec. 1984 |
| APPROVED | <i>[Signature]</i> DIRECTOR, WATER INVESTIGATIONS |
| DATE | |

BRITISH COLUMBIA
 MINISTRY OF THE ENVIRONMENT
 WATER INVESTIGATIONS BRANCH
 CANADA - BRITISH COLUMBIA
 FRASER RIVER FLOOD CONTROL 1968 AGREEMENT
 PROJECT 10.4 CONTRACT NO. 2
**SOUTH WESTMINSTER FLOOD CONTROL WORKS
 WELDWOOD - MILL RETAINING WALL
 CONCRETE OUTLINE & REINFORCEMENT - SHEET 1**


| | | | |
|----------|----------------|----------|----------------|
| DESIGNED | JBM; J.L. | SURVEYED | |
| DRAWN | S.K.C. | DATE | 11 Dec. 1984 |
| CHECKED | C.T.L.; R.S.S. | FILE NO. | 0281550-C12D-2 |
| SCALE | As shown | DATE | 11 Dec. 1984 |
| DWG. NO. | 4884-2-D8/R4 | SHEET | 8 OF 43 SHEETS |

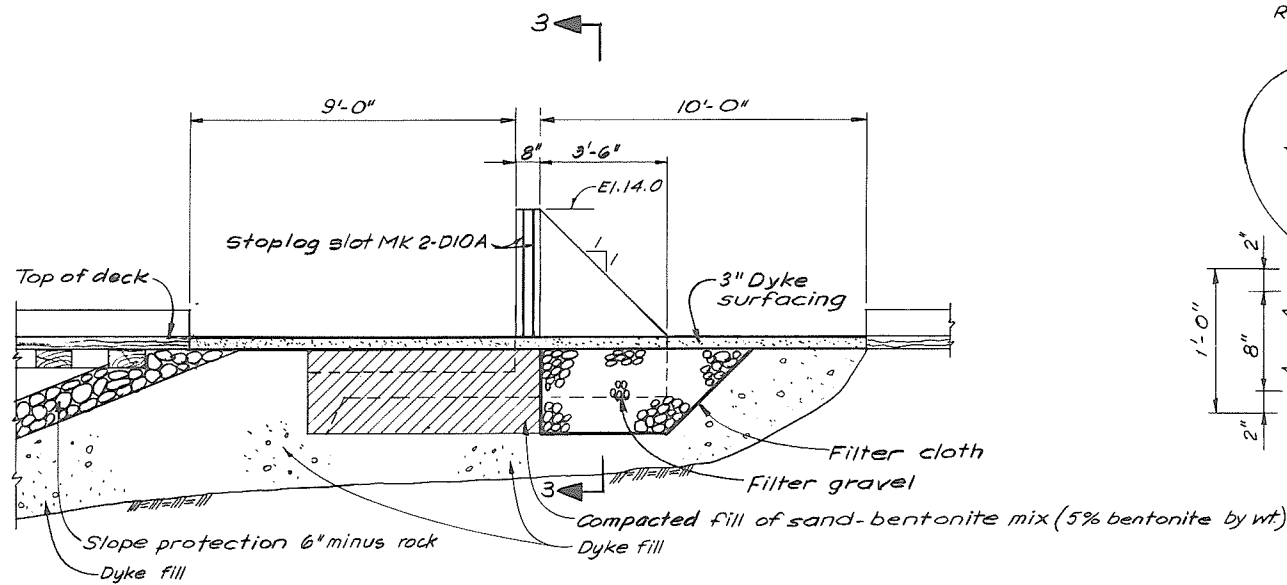


SECTION $\frac{2}{2-D7}$
Scale A

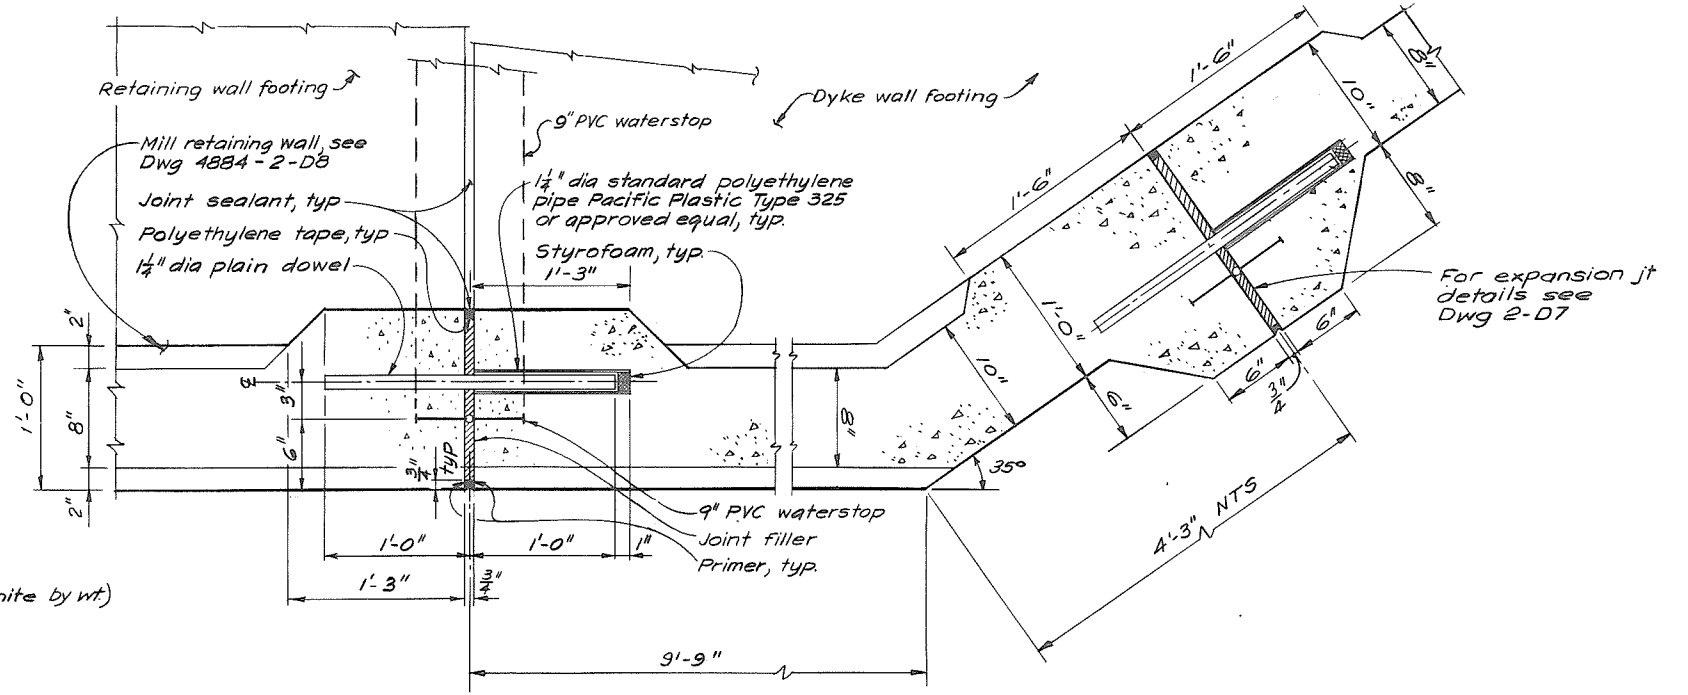


DETAIL $\frac{D}{2-D7}$
Scale C

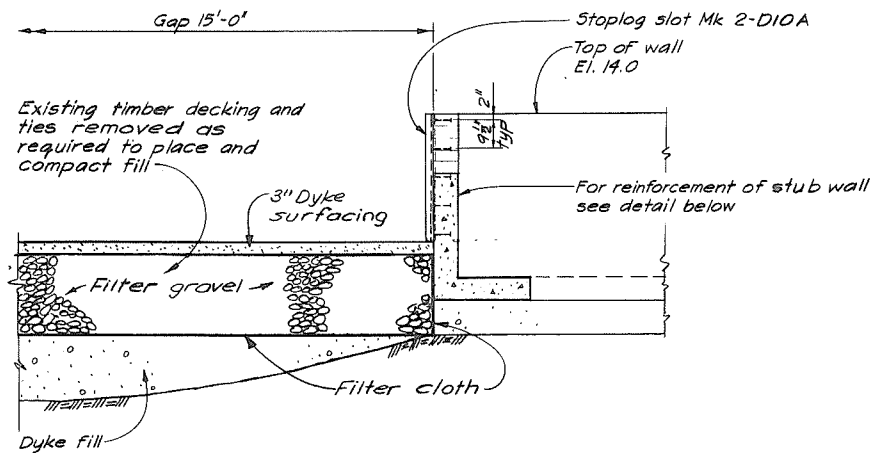


SECTION $\frac{3}{2-D7}$
Scale A

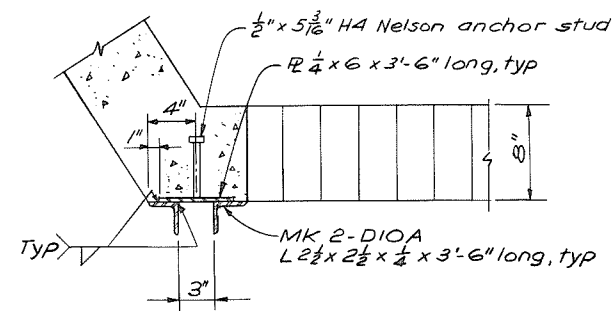

DETAIL $\frac{C}{2-D7}$
Scale C

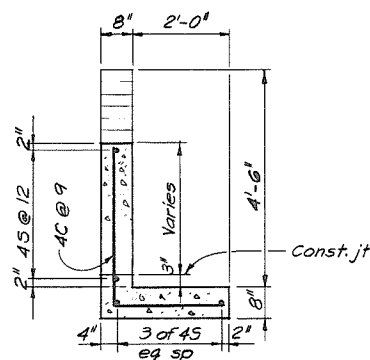

DETAIL OF STUB WALL
Scale B

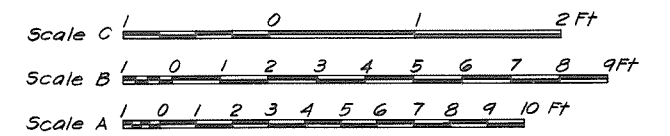




CRIPPEN ENGINEERING LTD
NORTH VANCOUVER, B.C.
PROJECT ENGINEER
M. A. Merlo

3 Record Drawing
2 Detail D revised
APPROVED FOR CONSTRUCTION
1 Prepared for Tender (Combined Contracts)

RECOMMENDED
DATE June 6 1984
APPROVED
DATE


BRITISH COLUMBIA
MINISTRY OF ENVIRONMENT
WATER INVESTIGATIONS BRANCH
CANADA - BRITISH COLUMBIA
FRASER RIVER FLOOD CONTROL 1968 AGREEMENT
PROJECT 10.4 CONTRACT 2
SOUTH WESTMINSTER FLOOD CONTROL WORKS
WELDWOOD - DYKE WALL
DETAILS

PRB
DRAWN L.S.
CHECKED CR
SCALE As shown
DWG NO 4884-2-D10/3

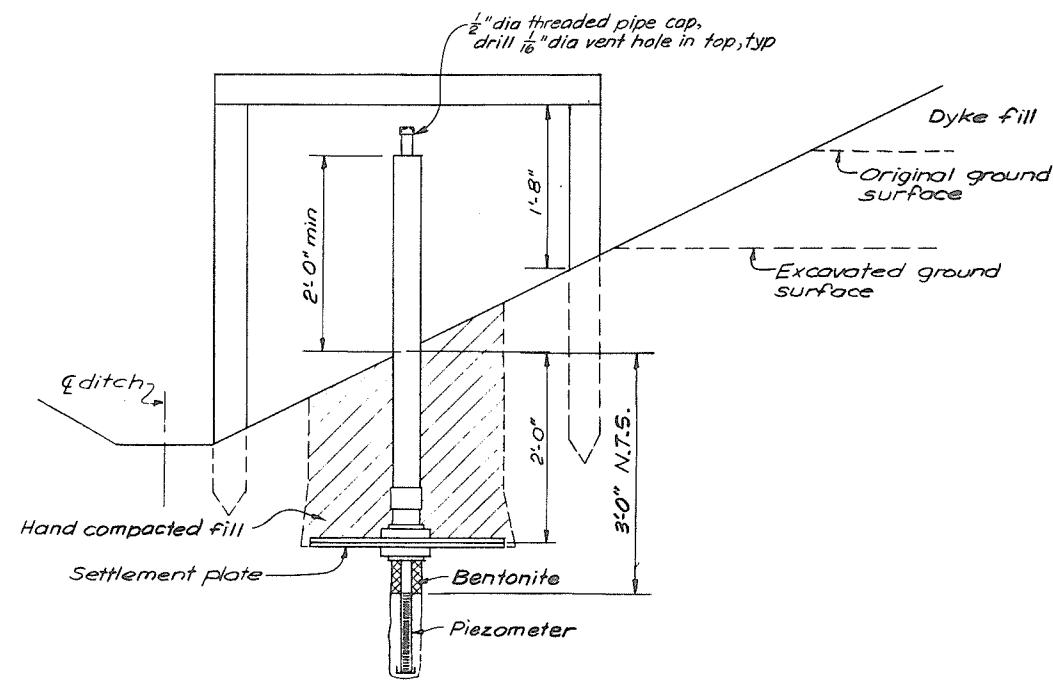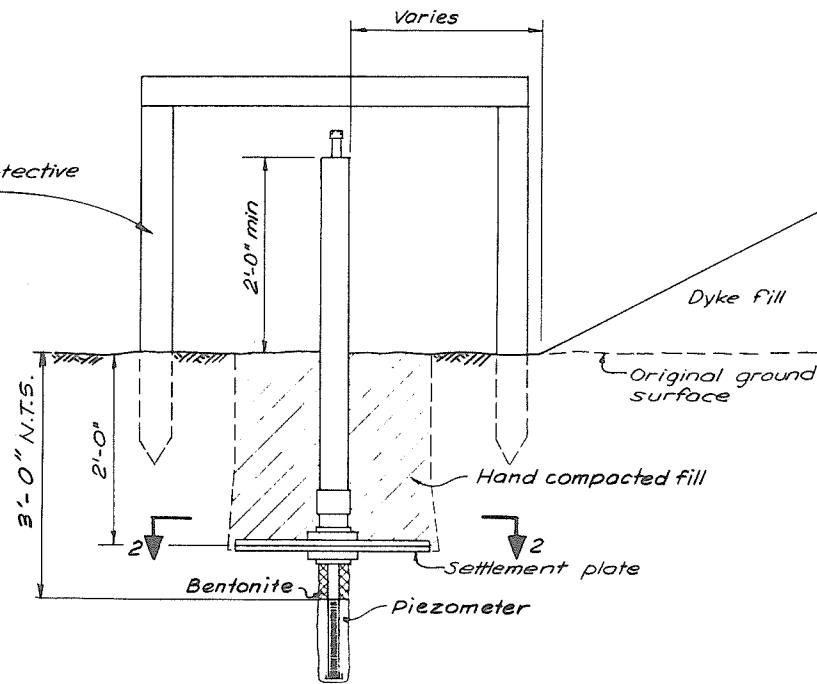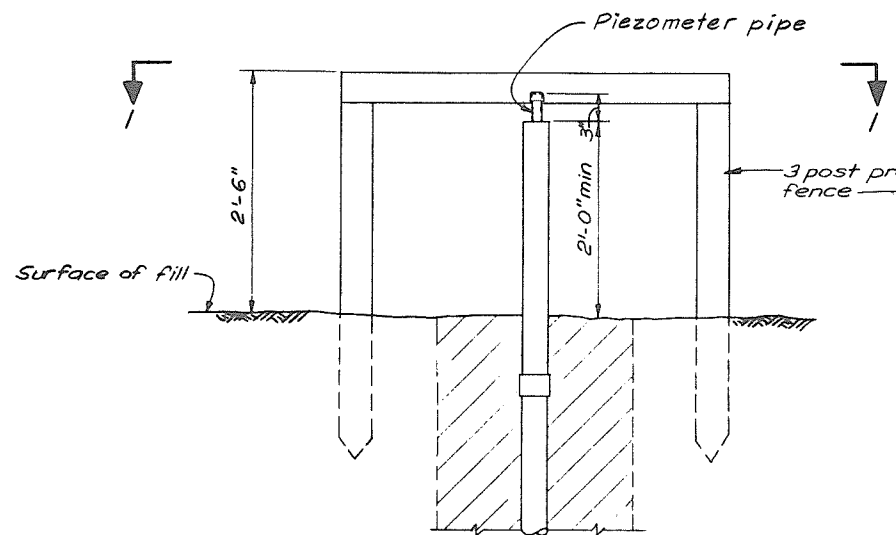


INSTALLATION OUTSIDE FILL


INSTALLATION NEAR DITCH

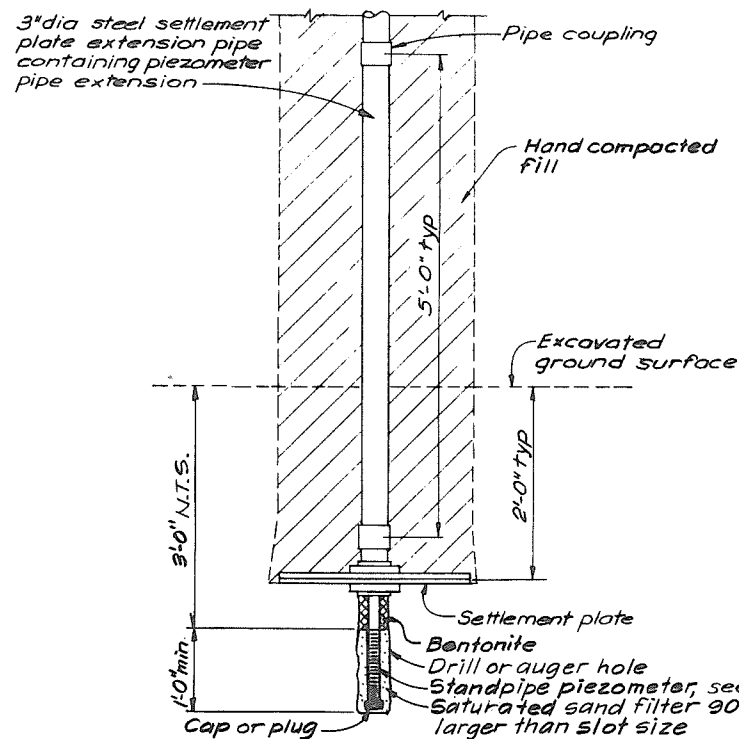

INSTALLATION AT DYKE & PIEZOMETER TIP, TYPICAL

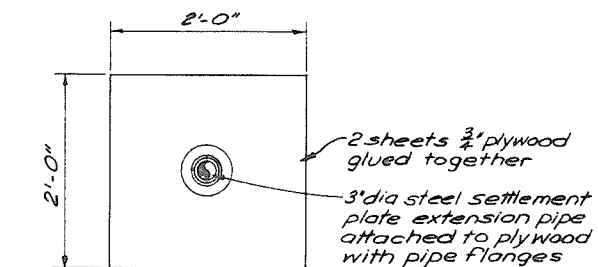

PLAN 2 TYPICAL SETTLEMENT PLATE

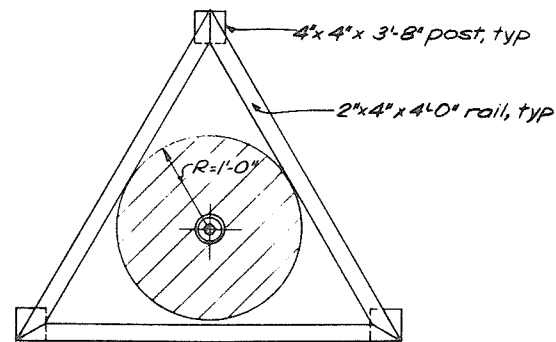

PLAN 1

NOTES

1. Surface settlement plate to be installed at approx 2'-0" depth below ground level.
2. Protective fence to be installed prior to any fill placement & raised as fill surface rises.
3. Locations of piezometer - settlement plate units are shown on Dwg 4884-2-D3, D4 & D6, and 4884-3-D26
4. All extension pipes to be clearly identified.
5. "R.S. Technical" type piezometer with 3/8" holes and filter cloth, typ.

NOTE ON DESIGN

Design adapted from Dwg 4884-1-D3
 By: FL
 Checked: *M.A.M.*
 Original designed by M.A.M. checked by R.C.D., 29 Aug 1978



CRIPPEN ENGINEERING LTD.
 NORTH VANCOUVER, B.C.
 PROJECT NO. 10405
 DEPARTMENT HEAD: *Herbert Nusbaum*
 PROJECT ENGINEER: *M.A. Merlo*
 CHIEF ENGINEER: *Johnston*

2. Record Drawing
 APPROVED FOR CONSTRUCTION
 1. Prepared for Tender (Combined contracts)


| NO. | DESCRIPTION | BY | CHK | APPR | DATE |
|-----|-------------|----|-----|------|------|
| | | | | | |

12-11-85
 5-6-84


RECOMMENDED: *EcoB...*
 PROJECT MANAGER
 DATE: June 6 1984
 APPROVED: *John Fuller*
 DIRECTOR, WATER INVESTIGATIONS
 DATE: June 6/84

BRITISH COLUMBIA
 MINISTRY OF THE ENVIRONMENT
 WATER INVESTIGATIONS BRANCH
 CANADA-BRITISH COLUMBIA
 FRASER RIVER FLOOD CONTROL 1988 AGREEMENT
 PROJECT 104 CONTRACT NO. 2
 SOUTH WESTMINSTER FLOOD CONTROL WORKS
 SETTLEMENT PLATE &
 PIEZOMETER DETAILS


| | |
|------------------------|------------------------|
| DESIGNED: See Note | SURVEYED: |
| DRAWN: <i>FL</i> | DATE: |
| CHECKED: See Note | FILE NO: 028550-C12D-2 |
| SCALE: Not to scale | DATE: 9 Jan 1979 |
| DWG. NO: 4884-2-D11/R2 | SHEET 11 OF 43 |

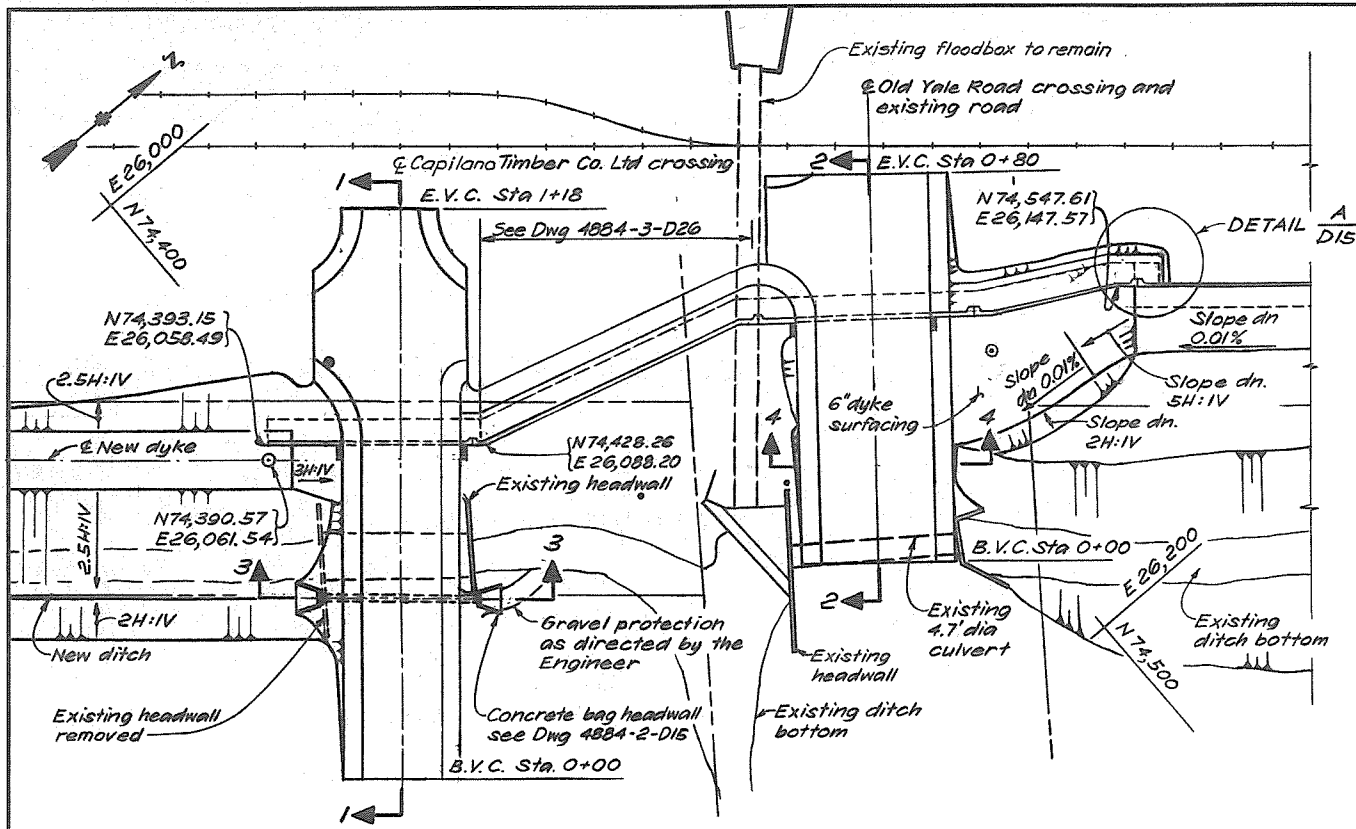


PLAN Scale A

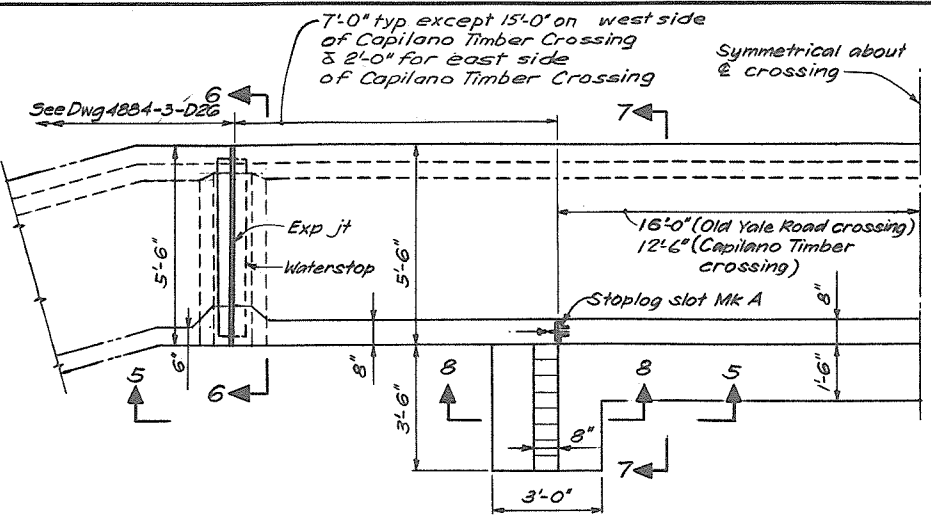


PLAN - CROSSING AT DYKE WALL Scale E

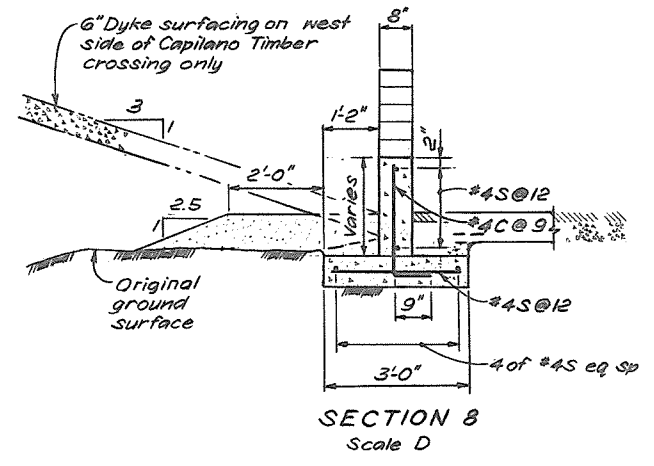


SECTION 8 Scale D

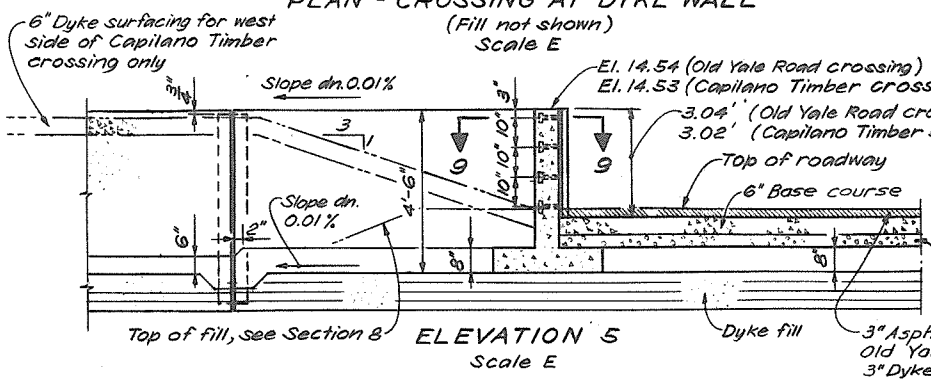


ELEVATION 5 Scale E

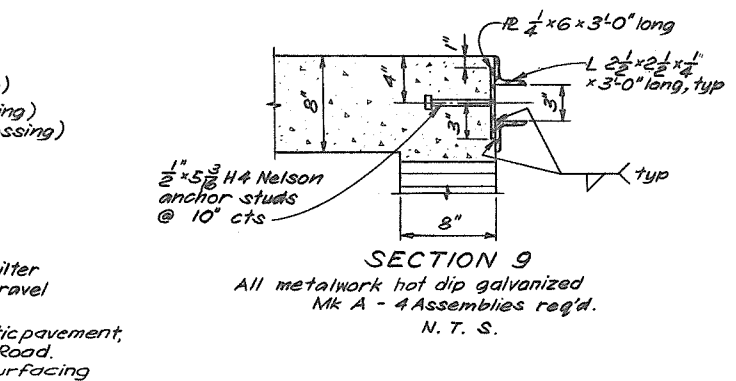


SECTION 9
All metalwork hot dip galvanized
Mk A - 4 Assemblies req'd.
N. T. S.

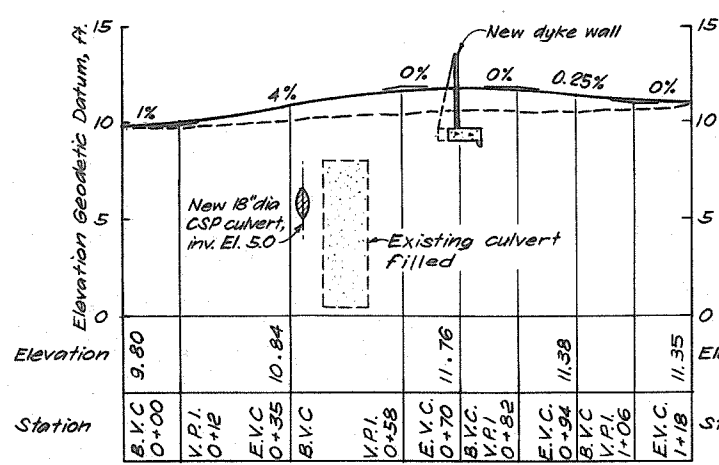


SECTION 1
Hor. scale A
Vert. scale B

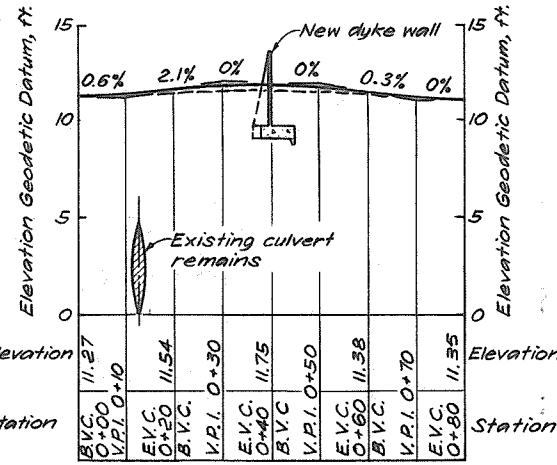


SECTION 2
Hor. scale A
Vert. scale B

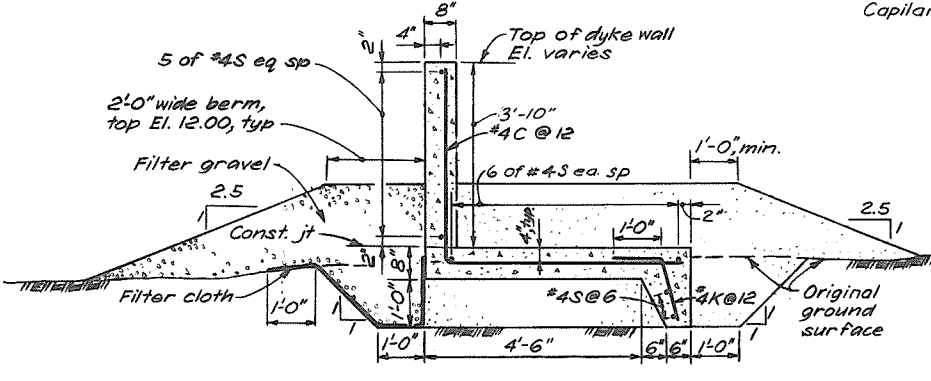


SECTION 6 Scale D

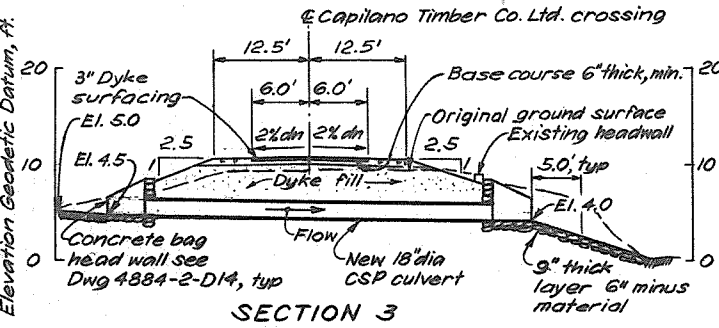

SECTION 3 Scale C

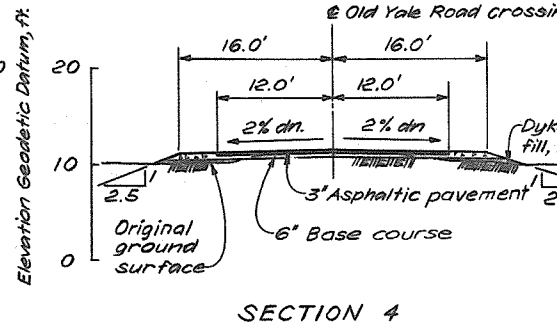



SECTION 4 Scale C

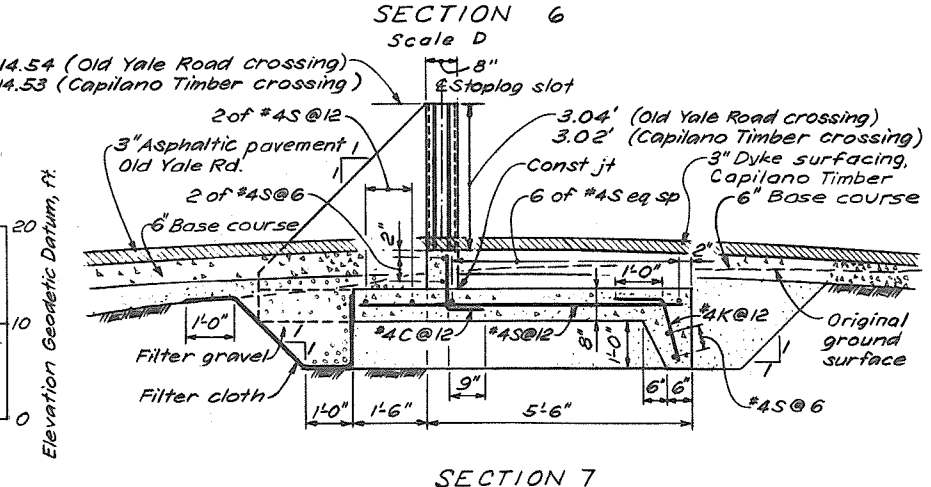

SECTION 7 Scale D

- NOTES
1. For general notes and legend see Dwg 4884-2-D3.
 2. For typical reinforcement bends see Dwg 4884-2-D16.
 3. For notes on concrete & reinforcement see Dwg 4884-3-D15.
 4. Mk letter to be prefixed D12 and clearly painted on embedded metalwork.
 5. For detail of expansion joint see Dwg 4884-2-D15.
 6. For structural fill & excavation payment line see Dwg 4884-2-D13.

NOTE ON DESIGN
Design adapted from Dwg 4884-1-D15, D2, D18 & D9
By FL & M.A.M.
Checked: *[Signature]*
Original designed by C.Ma checked by S.S., 29 Aug 1978

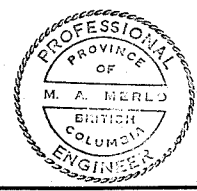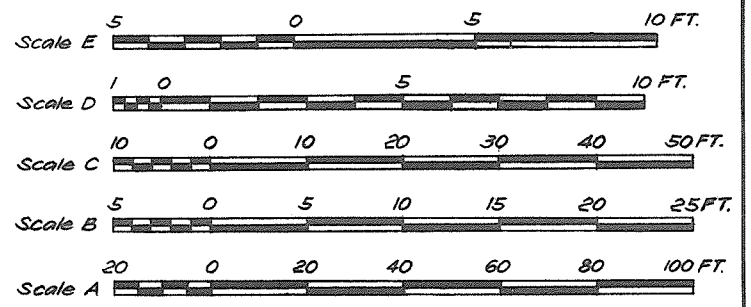

CRIPPEN ENGINEERING LTD.
NORTH VANCOUVER, B.C.
PROJECT NO. 10406

DEPARTMENT HEAD: *[Signature]*
PROJECT ENGINEER: *[Signature]*
CHIEF ENGINEER: *[Signature]*

2 Record Drawing
APPROVED FOR CONSTRUCTION JUL 25 1978
1 Prepared for Tender (Combined Contracts) FEB 11 1978

NO. _____ DESCRIPTION _____ REVISIONS _____

RECOMMENDED *[Signature]*
PROJECT MANAGER
DATE: June 6 1984



APPROVED *[Signature]*
DIRECTOR, WATER INVESTIGATIONS
DATE: *[Signature]*

BRITISH COLUMBIA
MINISTRY OF THE ENVIRONMENT
WATER INVESTIGATIONS BRANCH
CANADA - BRITISH COLUMBIA
FRASER RIVER FLOOD CONTROL 1968 AGREEMENT


PROJECT 10.4 CONTRACT NO. 2
SOUTH WESTMINSTER FLOOD CONTROL WORKS
CAPILANO TIMBER & OLD YALE ROAD
ROAD CROSSINGS & STOPLOG WALLS

DESIGNED: See Note
DRAWN: FL
CHECKED: See Note
SCALE: As shown
DWG. NO: 4884-2-D12/R2

SURVEYED: _____
DATE: _____
FILE NO: 0281550-C12D-2
DATE: 9 Jan 1979
SHEET 12 OF 43 SHEETS




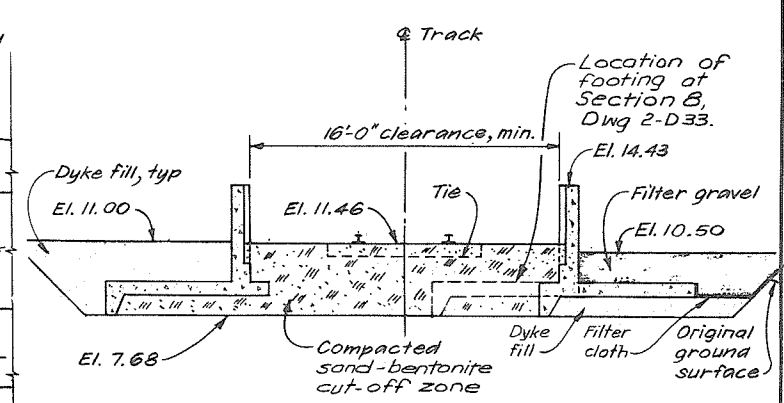
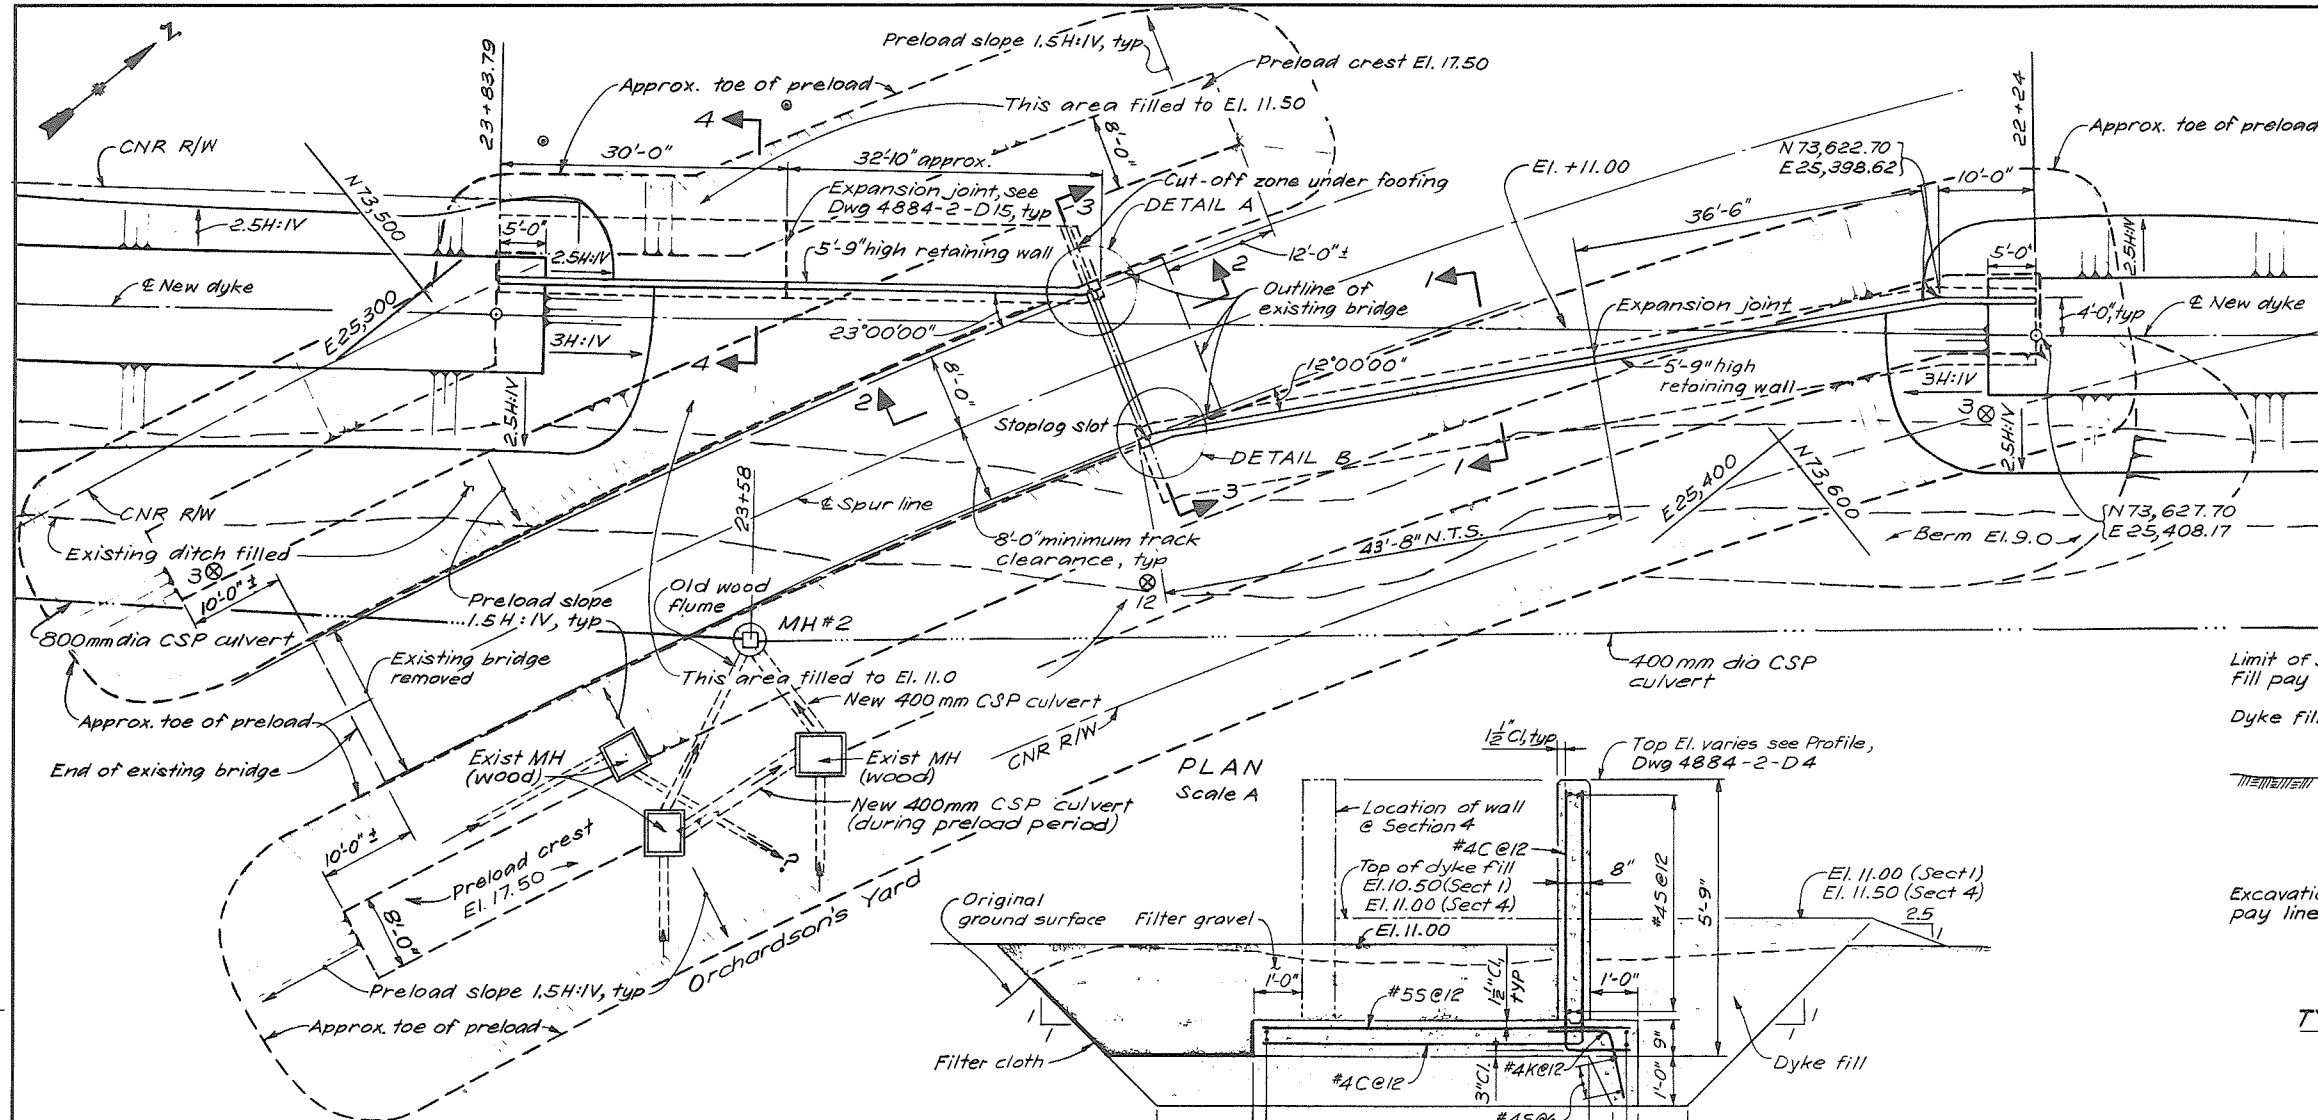


SECTION 3 Shown
SECTION 8 (Dwg 2-D33) Similar except as noted.

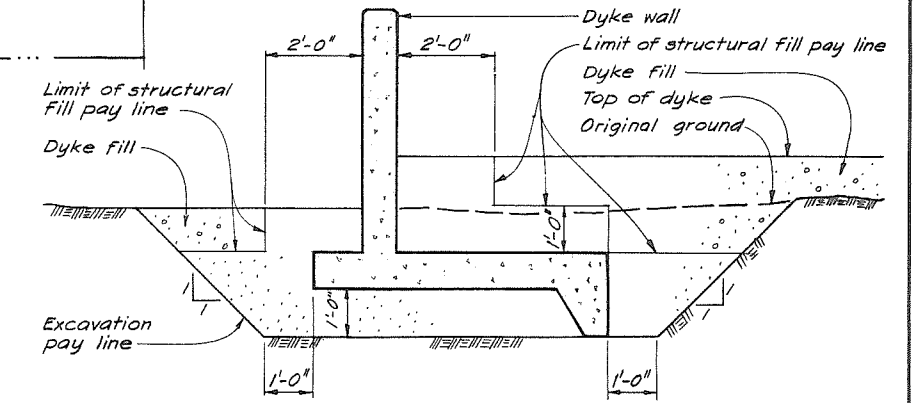

TYPICAL DETAIL OF DYKE WALL EXCAVATION AND STRUCTURAL FILL PAYMENT LINES
Scale C

- NOTES:
1. For general notes and legend see Dwg 4884-2-D3.
 2. For typical reinforcement bends see Dwg 4884-2-D16
 3. For notes on concrete & reinforcement see Dwg 4884-2-D15
 4. For note on design see Dwg 4884-2-D12

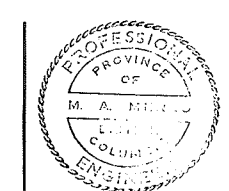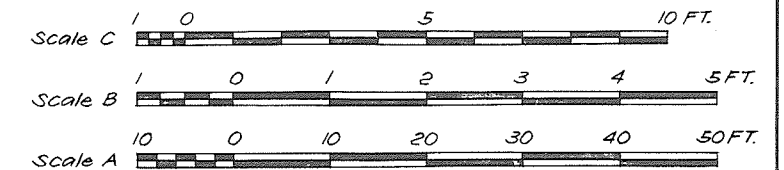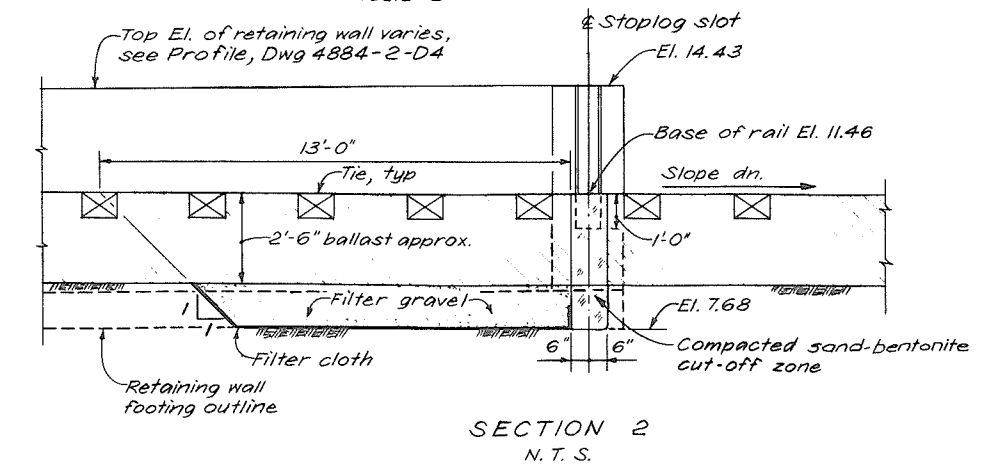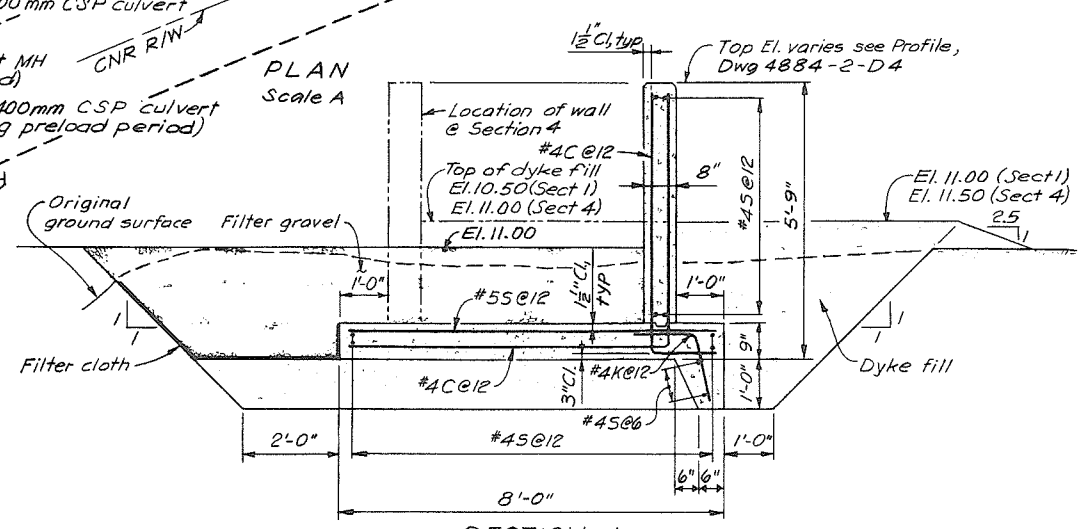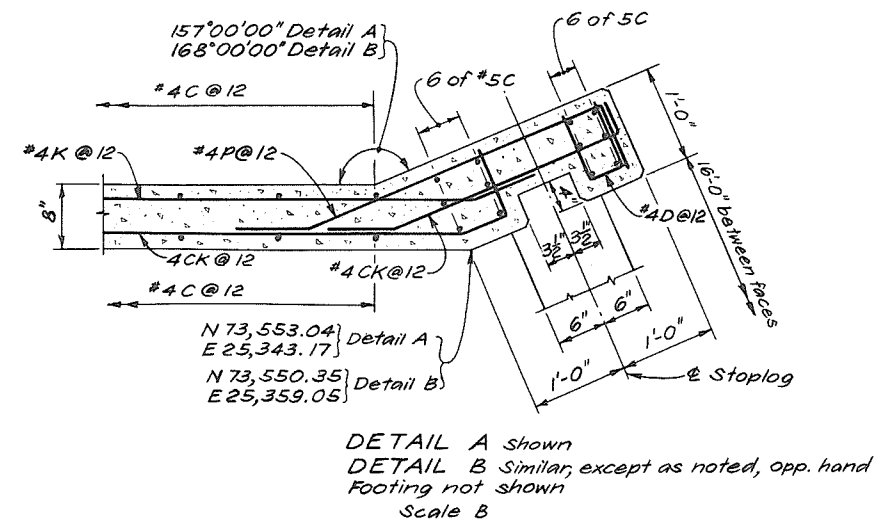

CRIPPEN ENGINEERING LTD.
NORTH VANCOUVER, B.C.
PROJECT NO. 10405


DEPARTMENT HEAD: *[Signature]*
PROJECT ENGINEER: *[Signature]*
CHIEF ENGINEER: *[Signature]*

3. Record Drawing
2. East wall slab revised to clear rail line. Section 4 added, Section 3 revised.
APPROVED FOR CONSTRUCTION JUL 25 1984


1. Prepared for Tender (Combined Contracts)

| NO | DESCRIPTION | BY | CHK | APPR | DATE |
|----|-------------|-----|-----|------|---------|
| | | MW | | | 11-9-85 |
| | | NP | | | 6-5-85 |
| | | FRB | | | 5-2-84 |


| | | | |
|---|--|------------------------|-------------------------|
| RECOMMENDED <i>[Signature]</i> PROJECT MANAGER | BRITISH COLUMBIA MINISTRY OF THE ENVIRONMENT WATER INVESTIGATIONS BRANCH CANADA-BRITISH COLUMBIA FRASER RIVER FLOOD CONTROL 1968 AGREEMENT | DESIGNED See Note 8 | SURVEYED |
| DATE June 6 1984 | PROJECT 10.4 CONTRACT NO 2 SOUTH WESTMINSTER FLOOD CONTROL WORKS C.N.R. TRACK & DYKE CROSSING STA. 23 +15 PLAN, SECTIONS & DETAILS | DRAWN FL | DATE |
| APPROVED <i>[Signature]</i> DIRECTOR, WATER INVESTIGATIONS | | CHECKED See Note 8 | FILE NO. 0281550-C12D-2 |
| DATE June 6 1984 | | SCALE As shown | DATE 9 Jan 1979 |
| | | DWG. NO. 4884-2-D13/R3 | SHEET 13 OF 43 SHEETS |

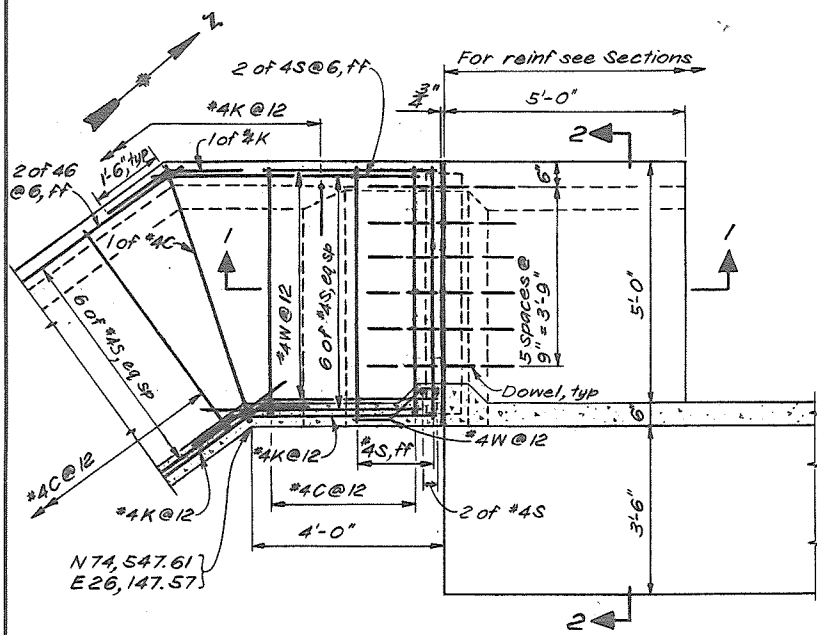


DETAIL A
D12
Excavation & fill not shown
Scale A

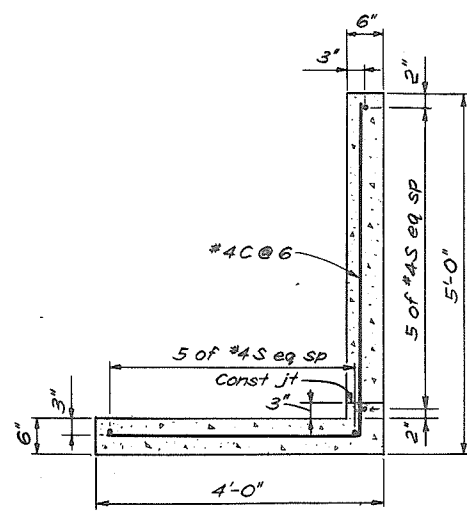

SECTION 5'-0" HIGH DYKE WALL
Scale B

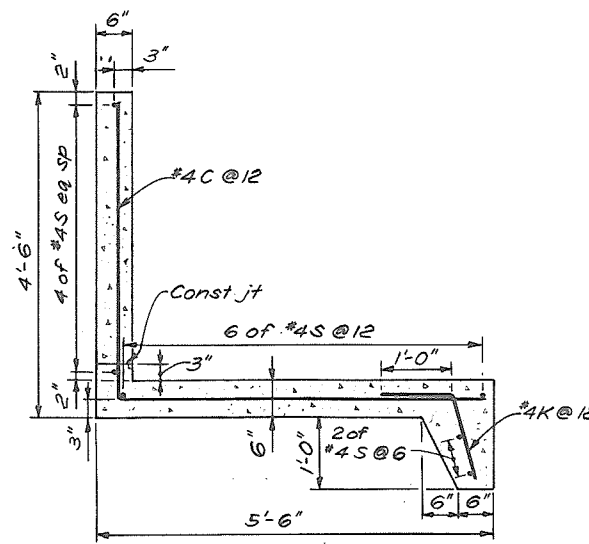


SECTION 4'-6" HIGH DYKE WALL

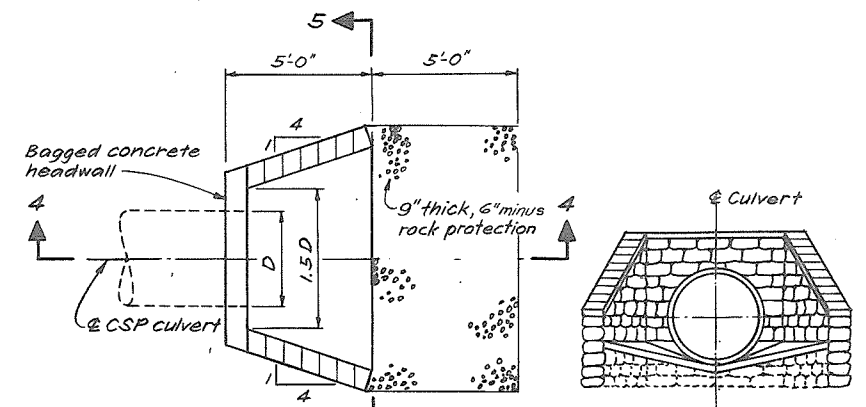


PLAN
BAGGED CONCRETE HEADWALL
N. T. S.


ELEVATION 5
N. T. S.

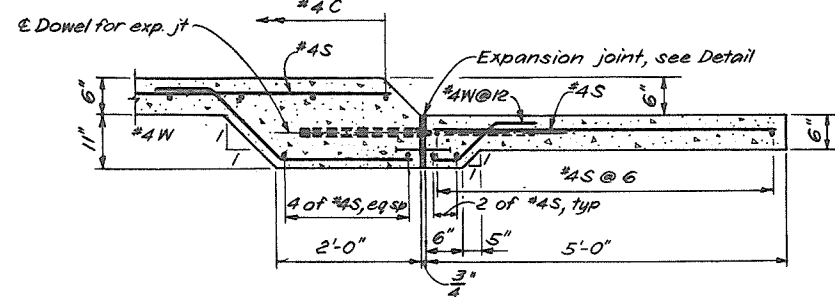


SECTION 1
Scale B

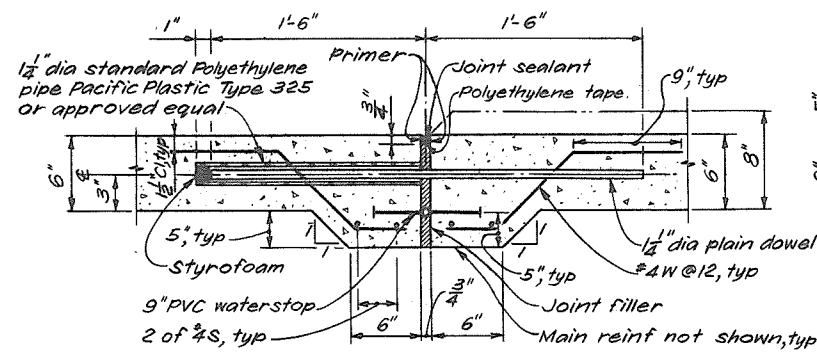


DYKE WALL FOOTING
Typical for 6" to 6" x 6" to 8" thick footings

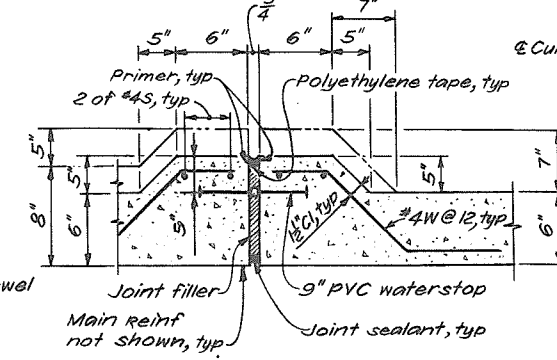


DYKE WALL
Typical for 6" to 6" x 6" to 8" thick walls

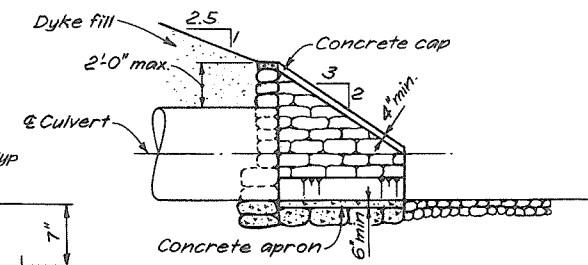


SECTION 4
N. T. S.

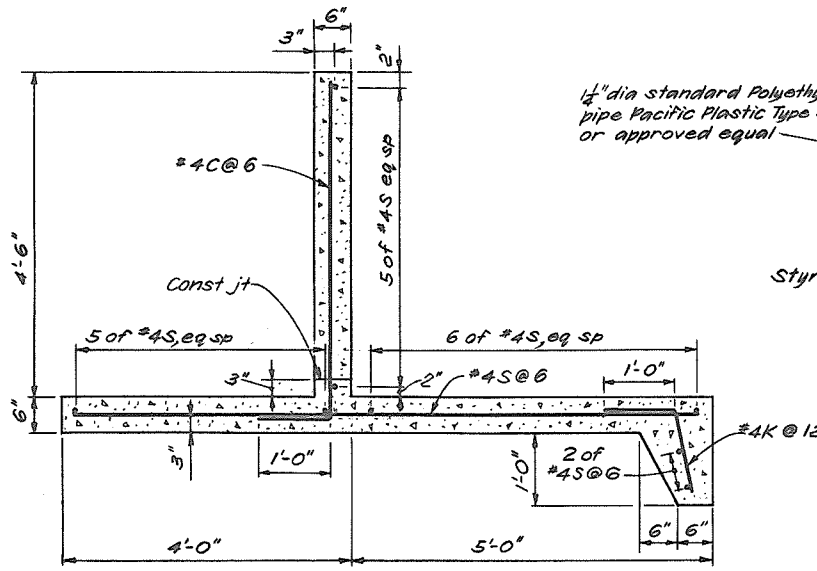

SECTION 2
Scale B

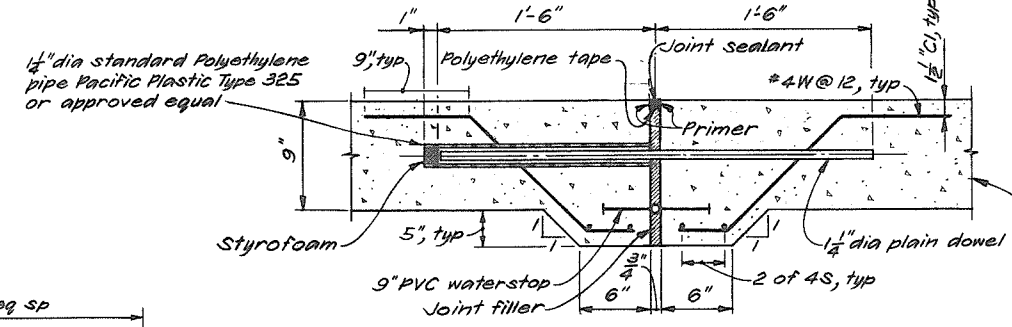

RETAINING WALL FOOTING


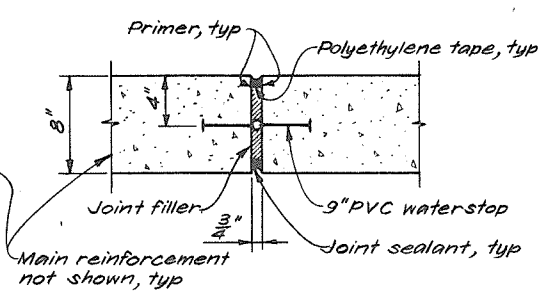


RETAINING WALL

TYPICAL EXPANSION JOINT DETAILS
N. T. S.

NOTES

1. For general notes and legend see Dwg 4884-2-D3.
2. For typical reinforcement bends see Dwg 4884-2-D16.
3. Dimensions to reinforcement are to ϵ bars unless otherwise shown.
4. Concrete shall be Class II except as noted.
5. Concrete cover to reinforcement to be 3" unless otherwise shown.
6. For typical footing dowel details see Dwg 4884-2-D16.
7. For note on design see Dwg 4884-2-D12.

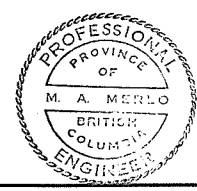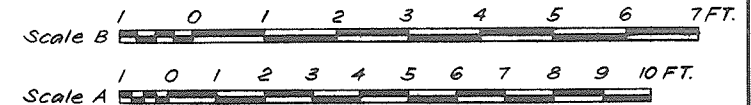


CRIPPEN ENGINEERING LTD.
NORTH VANCOUVER, B.C.
PROJECT NO. 10405
DEPARTMENT HEAD: [Signature]
PROJECT ENGINEER: [Signature]
CHIEF ENGINEER: [Signature]

2 Record Drawing
APPROVED FOR CONSTRUCTION
1. Prepared for tender (Combined Contracts)
NO. DESCRIPTION REVISIONS

RECOMMENDED: [Signature]
PROJECT MANAGER
DATE: June 6 1984
APPROVED: [Signature]
DIRECTOR, WATER INVESTIGATIONS
DATE: [Signature]


BRITISH COLUMBIA
MINISTRY OF THE ENVIRONMENT
WATER INVESTIGATIONS BRANCH
CANADA - BRITISH COLUMBIA
FRASER RIVER FLOOD CONTROL 1968 AGREEMENT
PROJECT 10.4 CONTRACT NO. 2
SOUTH WESTMINSTER FLOOD CONTROL WORKS
DYKE WALL & CULVERT HEADWALL
CONCRETE OUTLINE & REINFORCEMENT

DESIGNED: See Note 7
DRAWN: FL
CHECKED: See Note 7
SCALE: As shown
DWG. NO. 4884-2-D15/R2
SURVEYED: [Signature]
DATE: [Signature]
FILE NO. 0281550-C12D-2
DATE: 9 Jan 1979
SHEET 14 OF 43 SHEETS

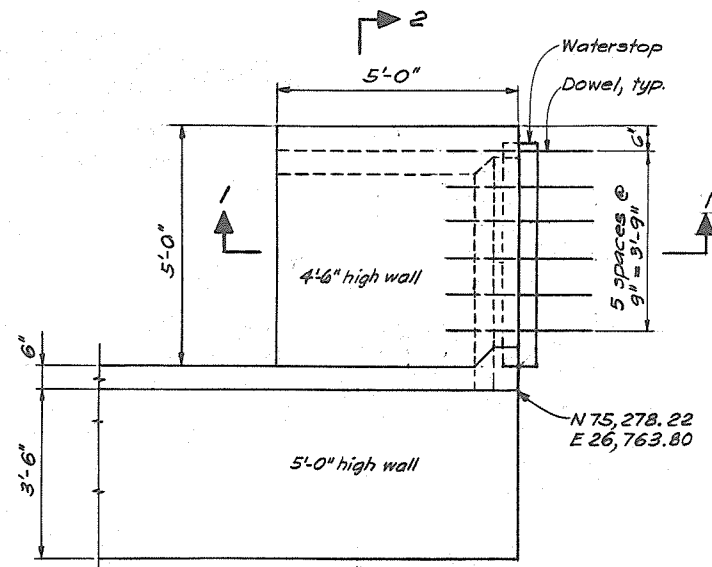


DETAIL $\frac{B}{D2}$


Excavation, fill & reinforcement not shown
Scale A

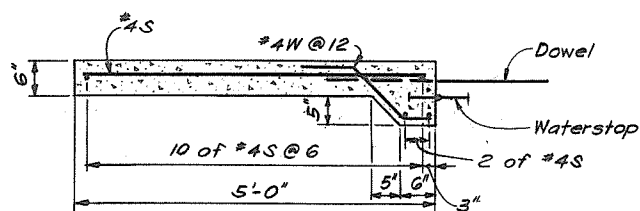


SECTION 1
Scale B

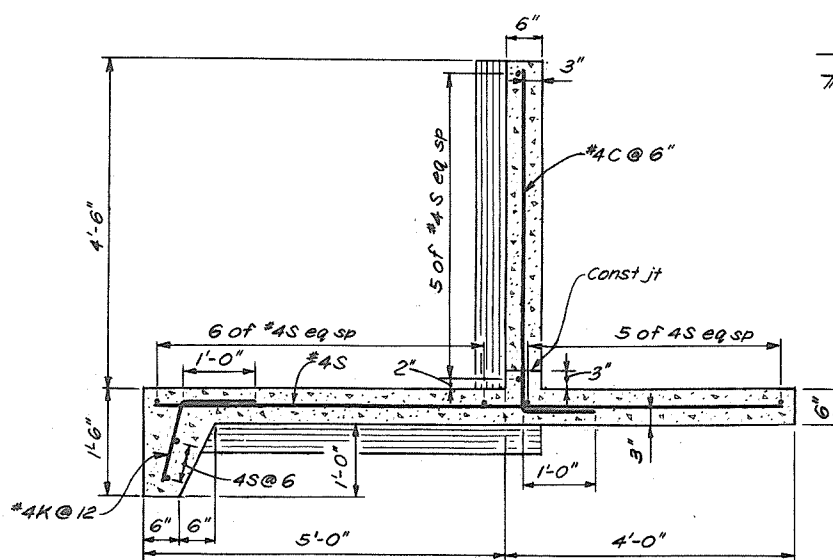


SECTION 2
Scale B

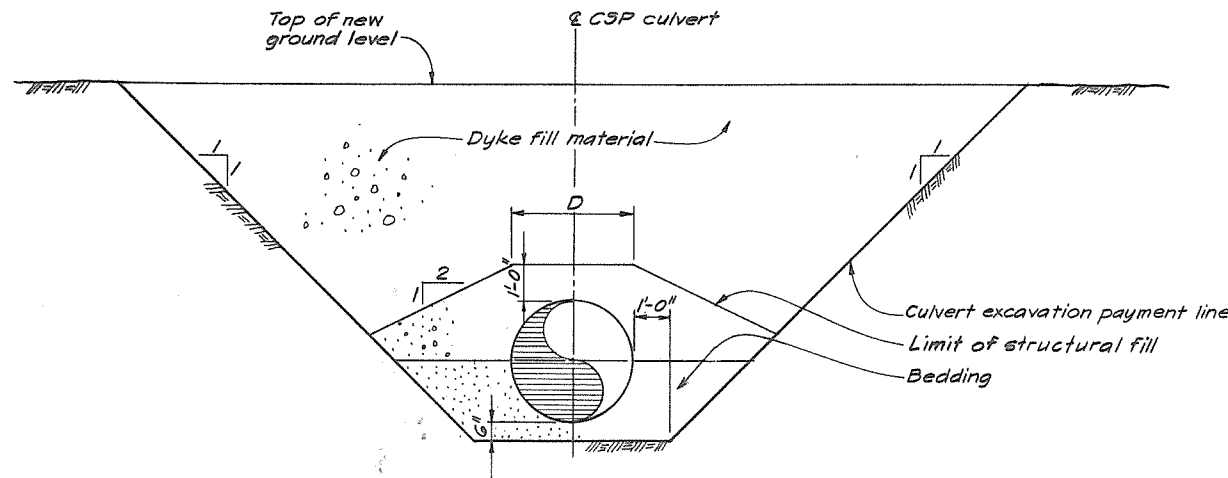

CULVERT EXCAVATION AND FILL PAYMENT LINES - SECTION
Scale N.T.S.

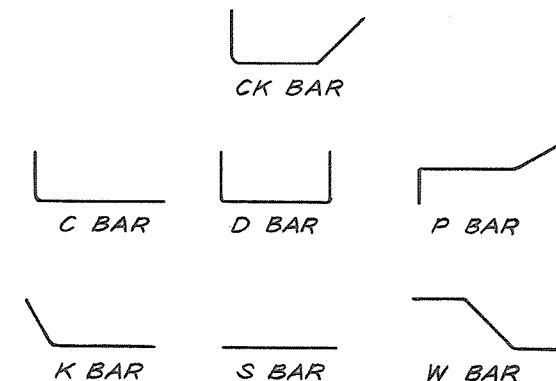


TYPICAL REINFORCEMENT BENDS

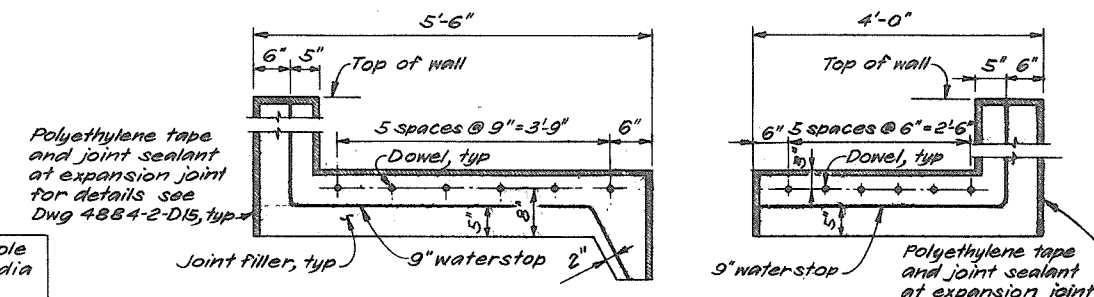

RETAINING WALL
Scale A
TYPICAL DETAILS - FOOTING DOWELS AT EXPANSION JOINTS
(Showing sections of joints)


NOTES

- For notes of reinforcement and concrete see Dwg 4884-2-D15.
- Filter gravel around manhole to extend up to dyke toe and 10.0' at the other 3 sides.
- For note on design see Dwg 4884-2-D12.

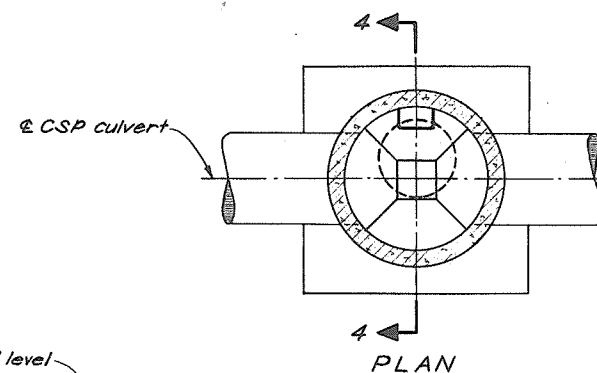


PLAN

| CSP Inside dia "C" | Manhole Inside dia "D" |
|--------------------|------------------------|
| 18" | 3'-6" |
| 30" | 4'-6" |

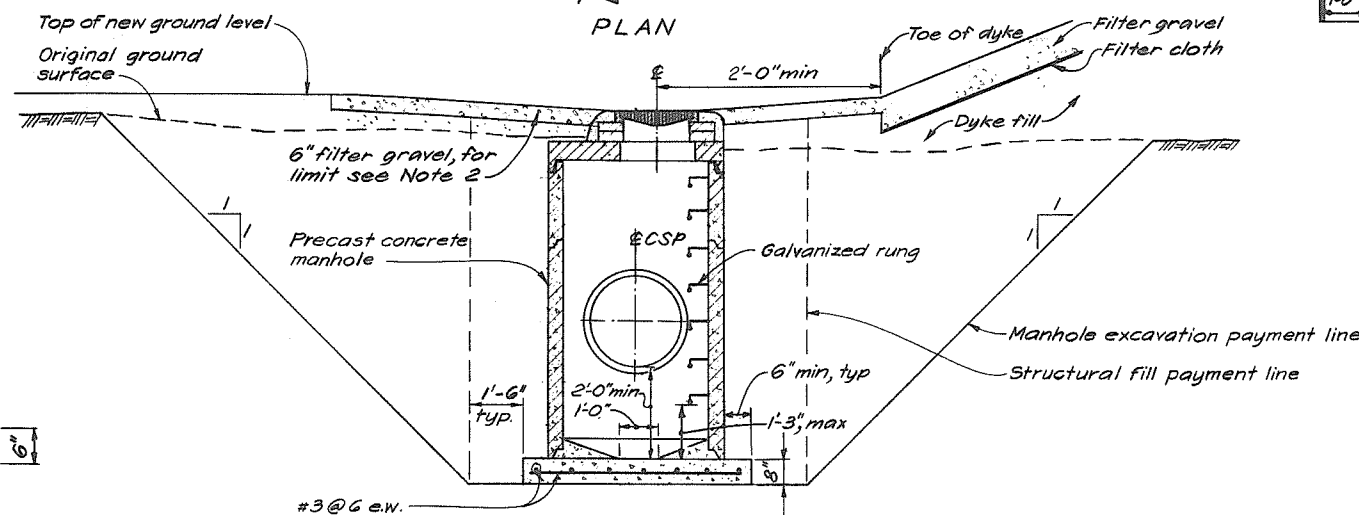

SECTION 4
TYPICAL MANHOLE AND CATCH BASIN
Scale N.T.S.

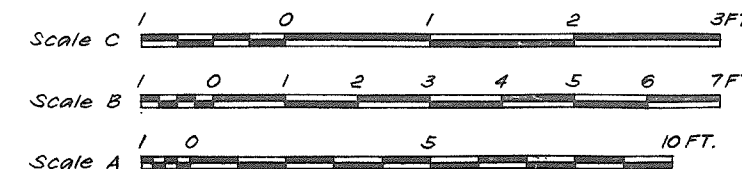


CRIPPEN ENGINEERING LTD.
NORTH VANCOUVER, B.C.
PROJECT NO. 10405
DEPARTMENT HEAD: *[Signature]*
PROJECT ENGINEER: *[Signature]*
CHIEF ENGINEER: *[Signature]*

2. Record Drawing
APPROVED FOR CONSTRUCTION JUL 20 1984
1. Prepared for Tender. (Combined Contracts)
NO. _____ DESCRIPTION _____ REVISIONS _____
BY: *[Signature]* CHD APPR: *[Signature]* DATE: 5-6-84


RECOMMENDED: *[Signature]* PROJECT MANAGER
DATE: June 6, 1984
APPROVED: *[Signature]* DIRECTOR, WATER INVESTIGATIONS
DATE: Jan 6/84

BRITISH COLUMBIA
MINISTRY OF THE ENVIRONMENT
WATER INVESTIGATIONS BRANCH
CANADA-BRITISH COLUMBIA
FRASER RIVER FLOOD CONTROL 1968 AGREEMENT
PROJECT 10.4 CONTRACT NO. 2
SOUTH WESTMINSTER FLOOD CONTROL WORKS
DYKE WALL - CONCRETE OUTLINE,
REINFORCEMENT AND DETAILS

DESIGNED: See Note 3
DRAWN: FL
CHECKED: See Note 3
SCALE: As shown
DWG. NO: 4884-2-D16/R2
SURVEYED: _____
DATE: _____
FILE NO: 0281550-CI2D-2
DATE: 9 Jan 1979
SHEET 15 OF 43 SHEETS

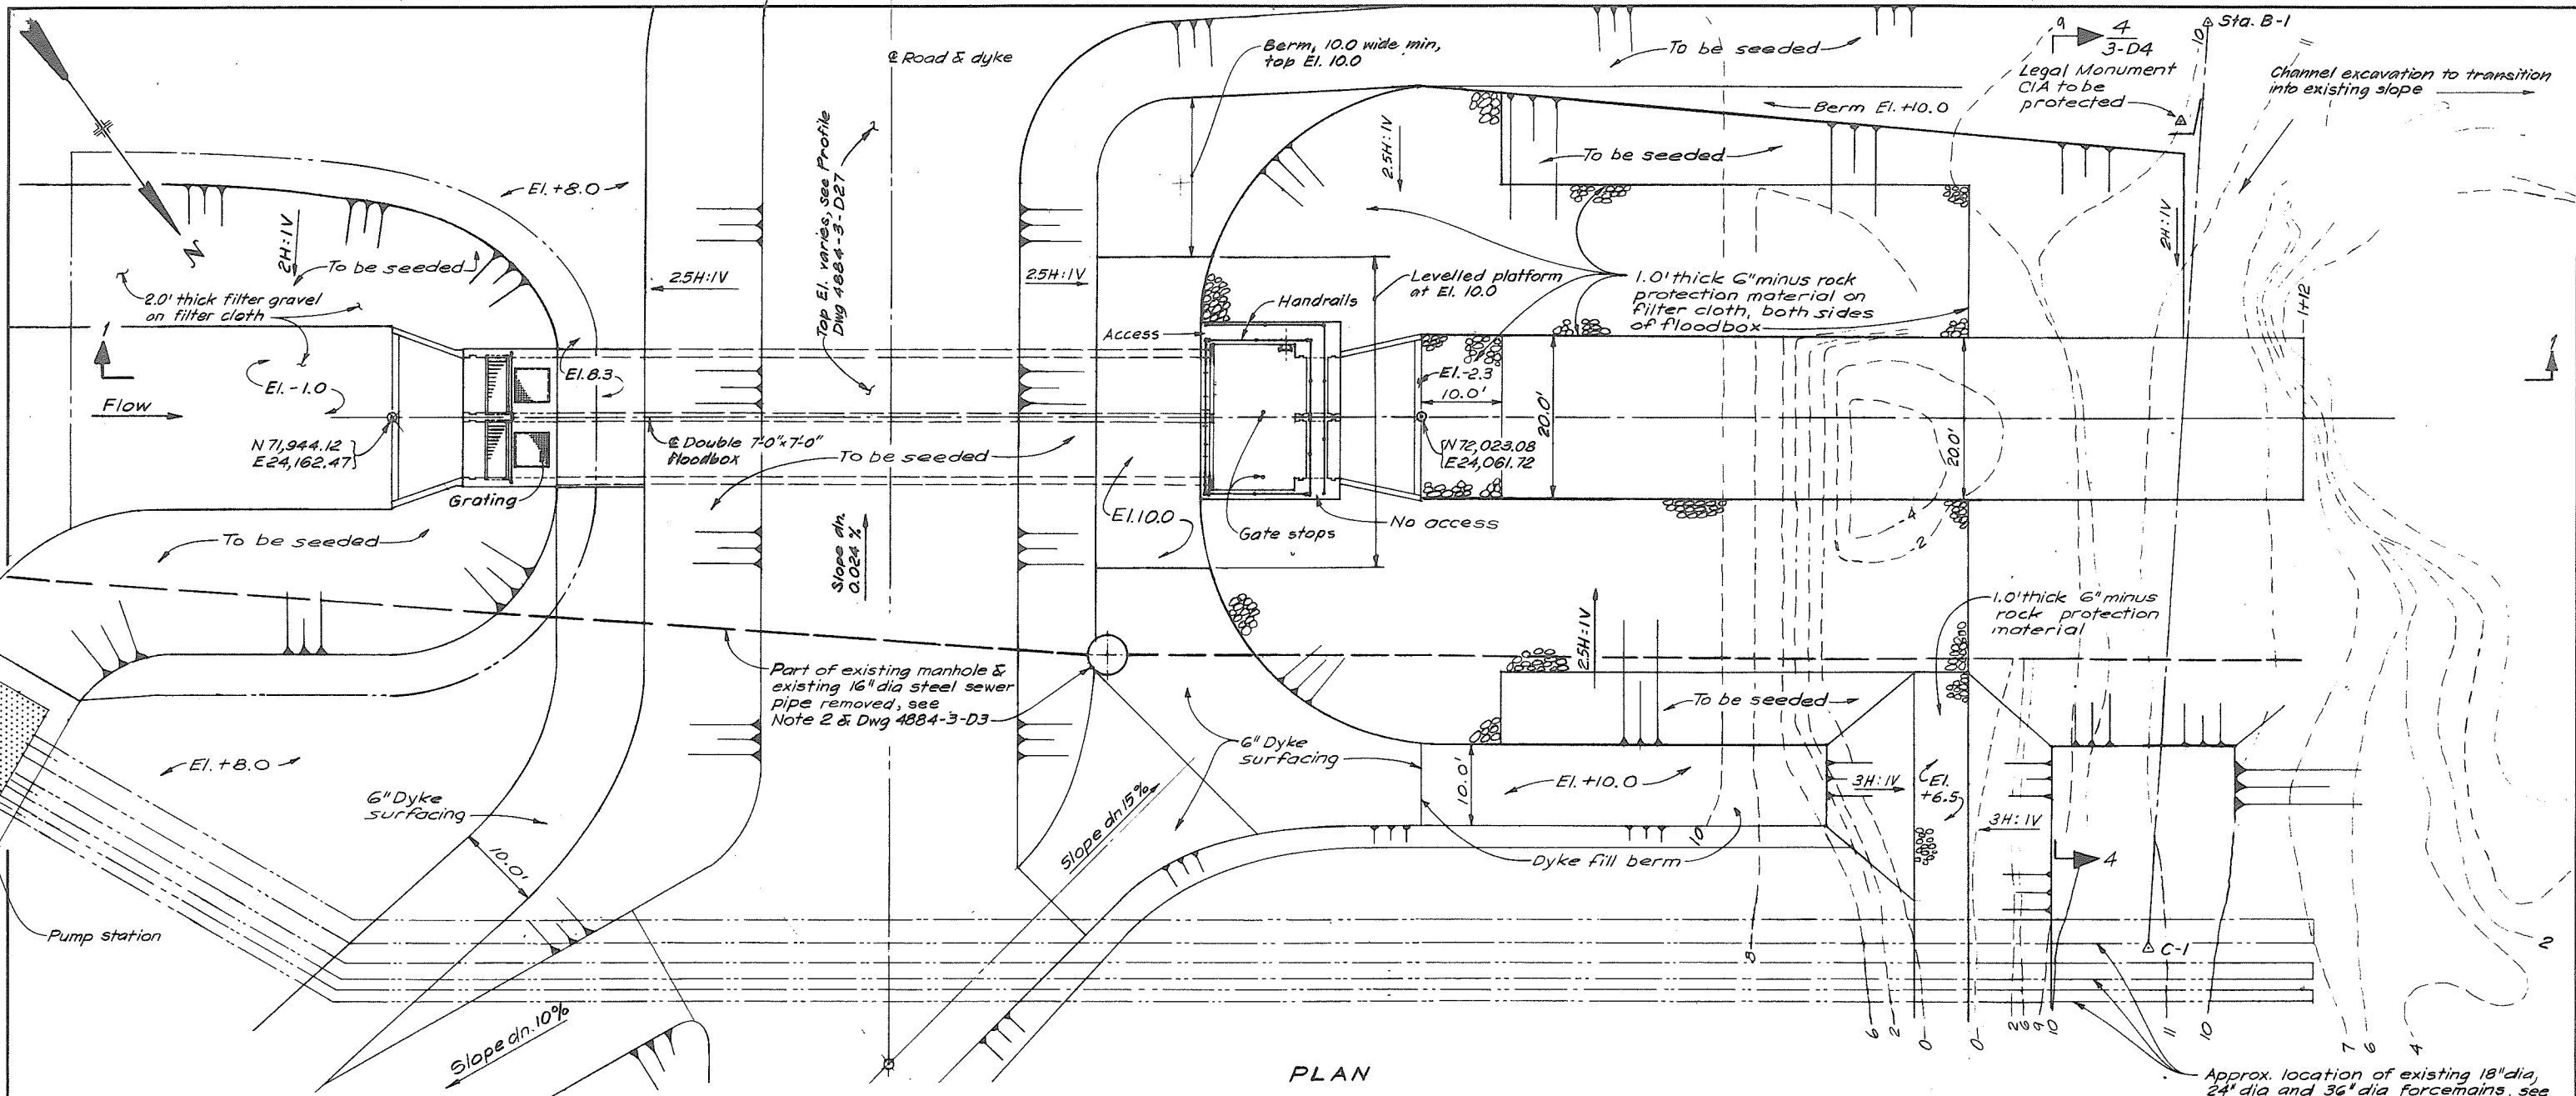


PLAN

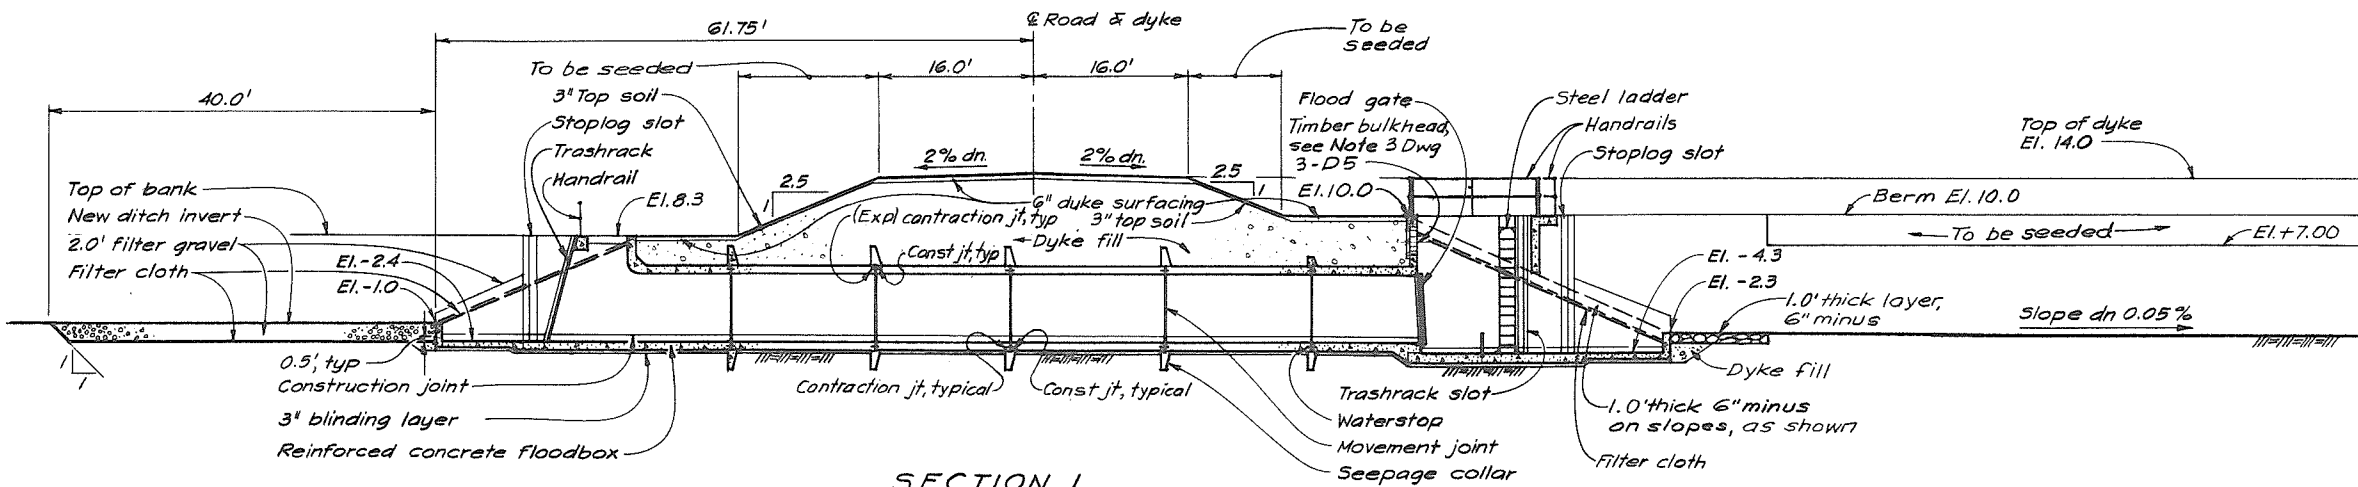

SECTION I

- NOTES**
1. For general notes, legend and adjacent dyke arrangement see Dwg 4884-3-D27.
 2. Existing manhole removed above the top of existing 16" dia steel sewer inlet pipe. Both the excavation for the existing manhole and the existing pipe were backfilled with dyke fill.

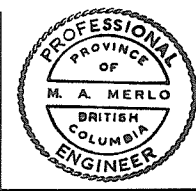

CRIPPEN ENGINEERING LTD.
 NORTH VANCOUVER, B.C.
 PROJECT NO. 10405
 DEPARTMENT HEAD *C.R. Blund*
 PROJECT ENGINEER *M.A. Merlo*
 CHIEF ENGINEER *John S. ...*


2. Record Drawing
 APPROVED FOR CONSTRUCTION JUL 25 84
 1. Prepared for Tender (Combined Contracts)
 NO. DESCRIPTION REVISIONS

RECOMMENDED *Eusob*
 PROJECT MANAGER
 DATE June 6 1984
 APPROVED *John Fuller*
 DIRECTOR, WATER INVESTIGATIONS
 DATE June 6 1984


BRITISH COLUMBIA
 MINISTRY OF THE ENVIRONMENT
 WATER INVESTIGATIONS BRANCH
 CANADA - BRITISH COLUMBIA
 FRASER RIVER FLOOD CONTROL 1968 AGREEMENT
 PROJECT 10.4 CONTRACT NO. 2
**SOUTH WESTMINSTER FLOOD CONTROL WORKS
 MANSON ROAD FLOODBOX
 GENERAL ARRANGEMENT**

DESIGNED *NAC*
 DRAWN *H.N.C., L.S.*
 CHECKED *R.D., LVS*
 SCALE As shown
 DWG. NO. 4884-3-D2R2

SURVEYED E.S.
 DATE Nov, 1974.
 FILE NO. 0281550-C12D-3
 DATE 14 Feb, 1979.
 SHEET 16 OF 43 SHEETS
 280099

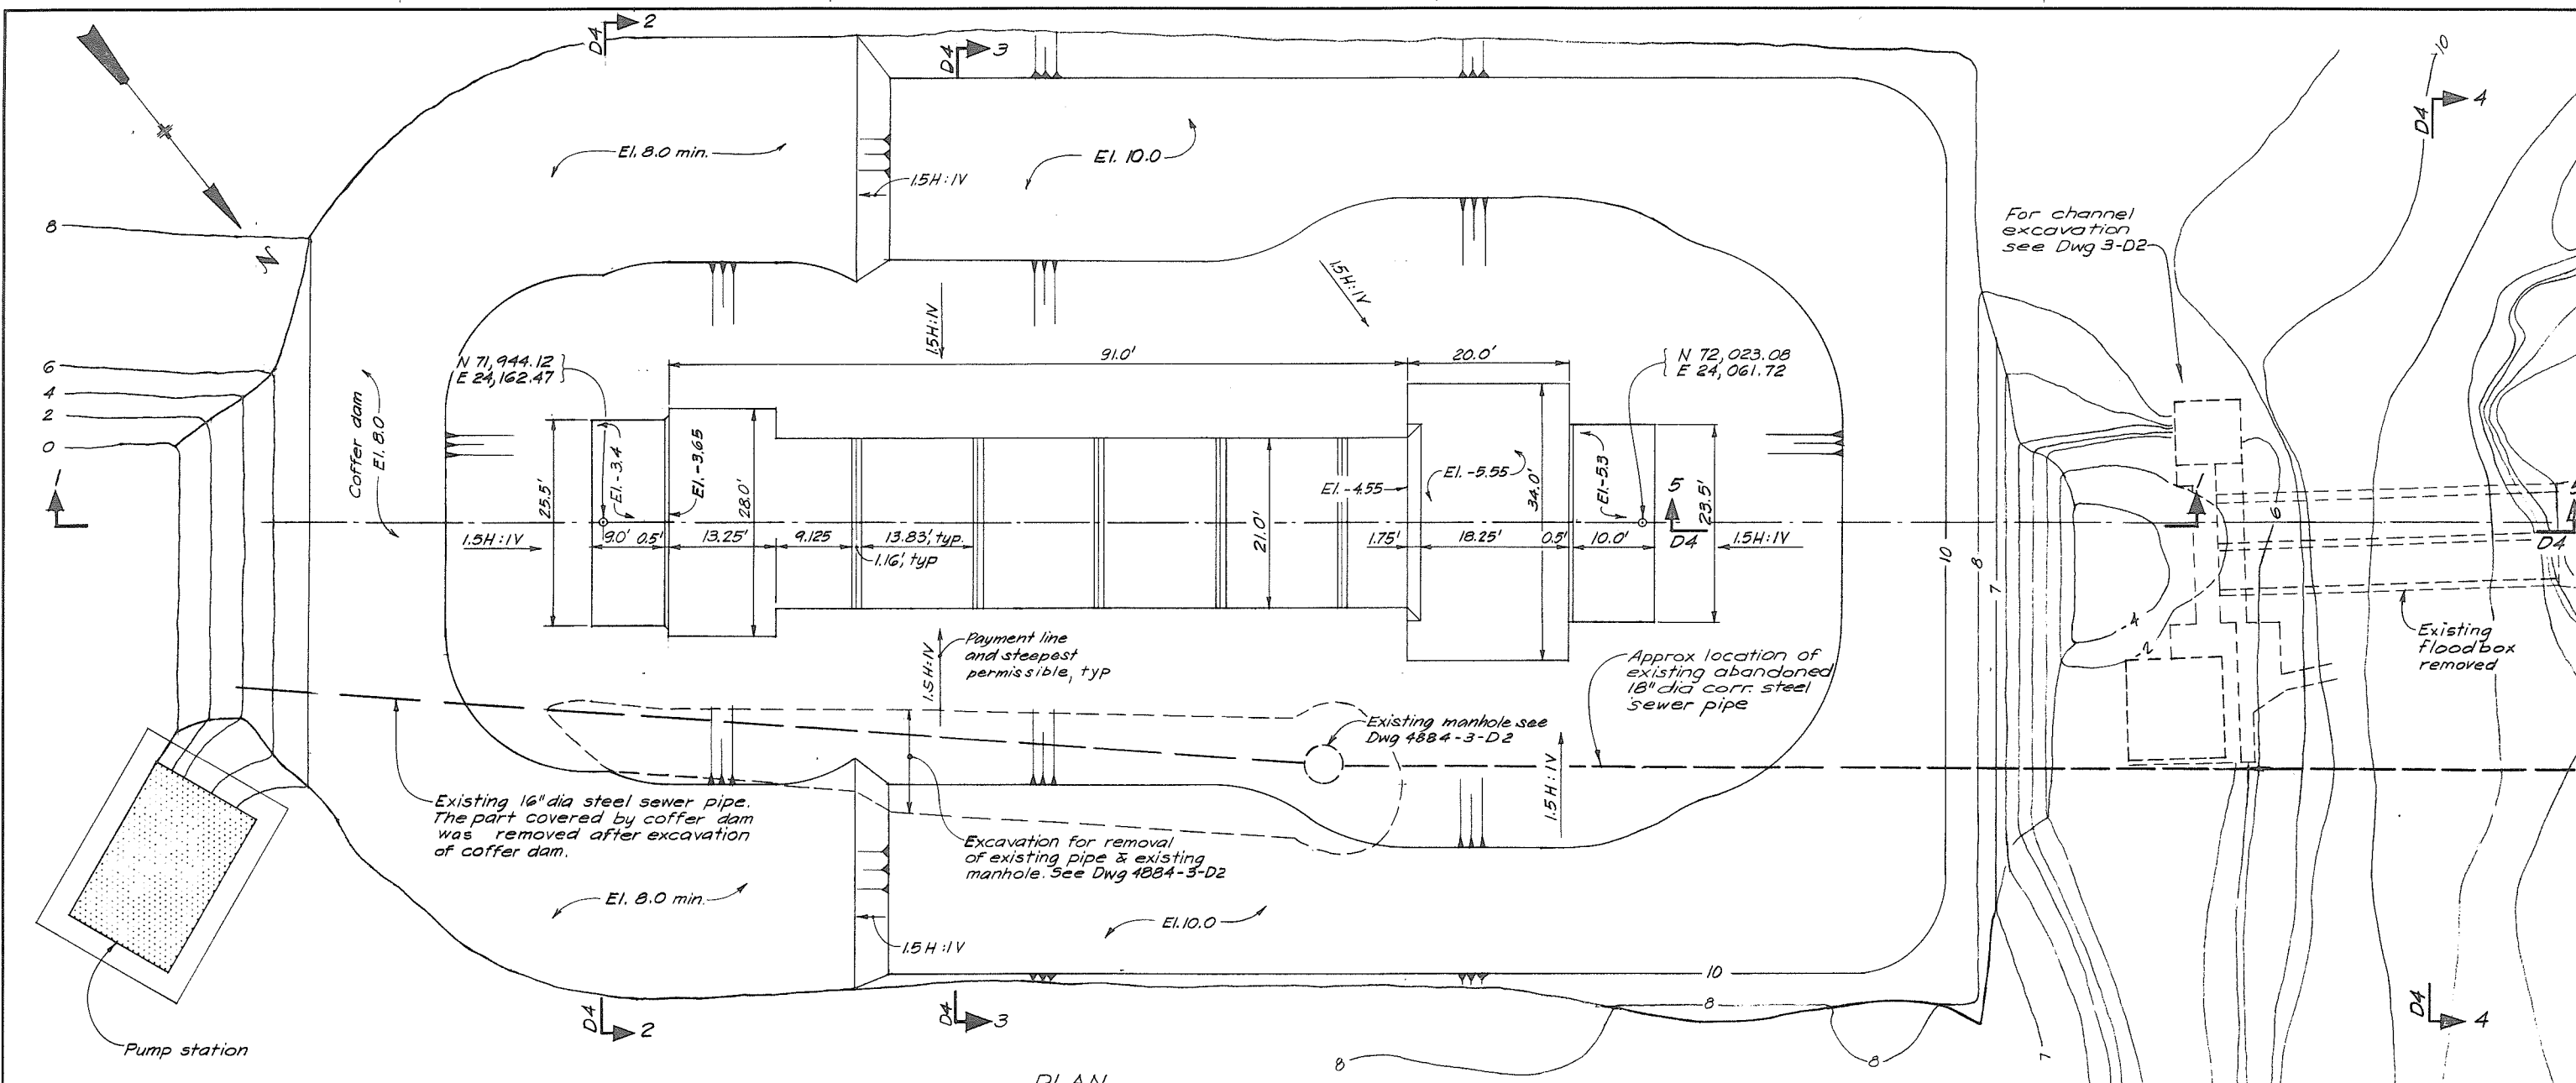

PLAN

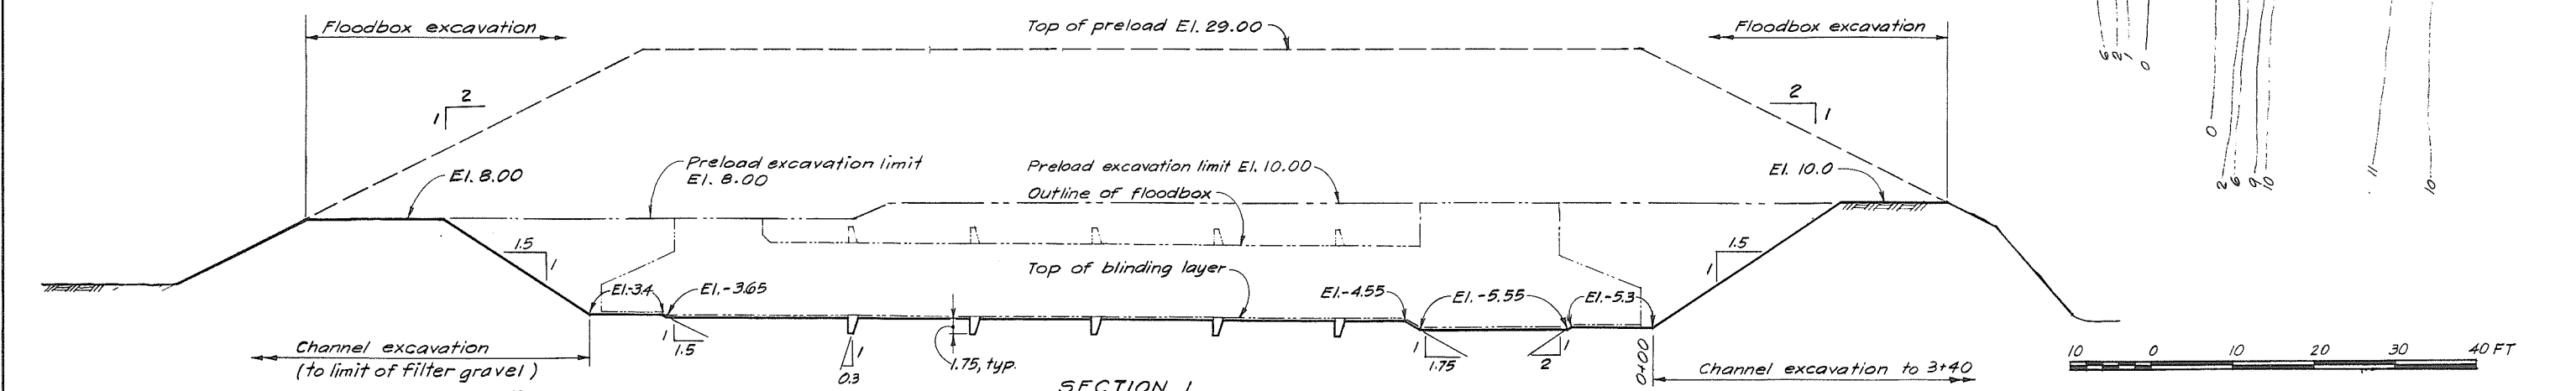

SECTION I



CRIPPEN ENGINEERING LTD.
 NORTH VANCOUVER, B.C.
 PROJECT NO. 10405

DEPARTMENT HEAD: *C. R. Blair*
 PROJECT ENGINEER: *M. A. Merlo*
 CHIEF ENGINEER: *John B. Lewis*

2. Record Drawing
 APPROVED FOR CONSTRUCTION JUL 23 84

1. Prepared for Tender (Combined Contracts). PRB *M. A. Merlo* 5-6-84

| NO. | DESCRIPTION | BY | CHK | APPR | DATE |
|-----|-------------|----|-----|------|------|
| | | | | | |






RECOMMENDED *Subal* PROJECT MANAGER
 DATE June 6 1984

APPROVED *W. J. Miller* DIRECTOR, WATER INVESTIGATIONS
 DATE June 6/84

BRITISH COLUMBIA
 MINISTRY OF THE ENVIRONMENT
 WATER INVESTIGATIONS BRANCH
 CANADA - BRITISH COLUMBIA
 FRASER RIVER FLOOD CONTROL 1968 AGREEMENT

PROJECT 10.4 CONTRACT NO. 2
SOUTH WESTMINSTER FLOOD CONTROL WORKS
MANSON ROAD FLOODBOX
EXCAVATION & BACKFILL - SHEET 1 OF 2

| | |
|------------------------------|-------------------------------------|
| DESIGNED: <i>NAC</i> | SURVEYED: <i>E. S.</i> |
| DRAWN: <i>L.B.</i> | DATE: <i>Nov, 1974.</i> |
| CHECKED: <i>R.D., LVS</i> | FILE NO.: <i>0281550-C120-3</i> |
| SCALE: <i>As shown</i> | DATE: <i>14 Feb, 1979</i> |
| DWG. NO.: <i>4884-3-D3R2</i> | SHEET <i>17</i> OF <i>43</i> SHEETS |

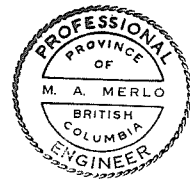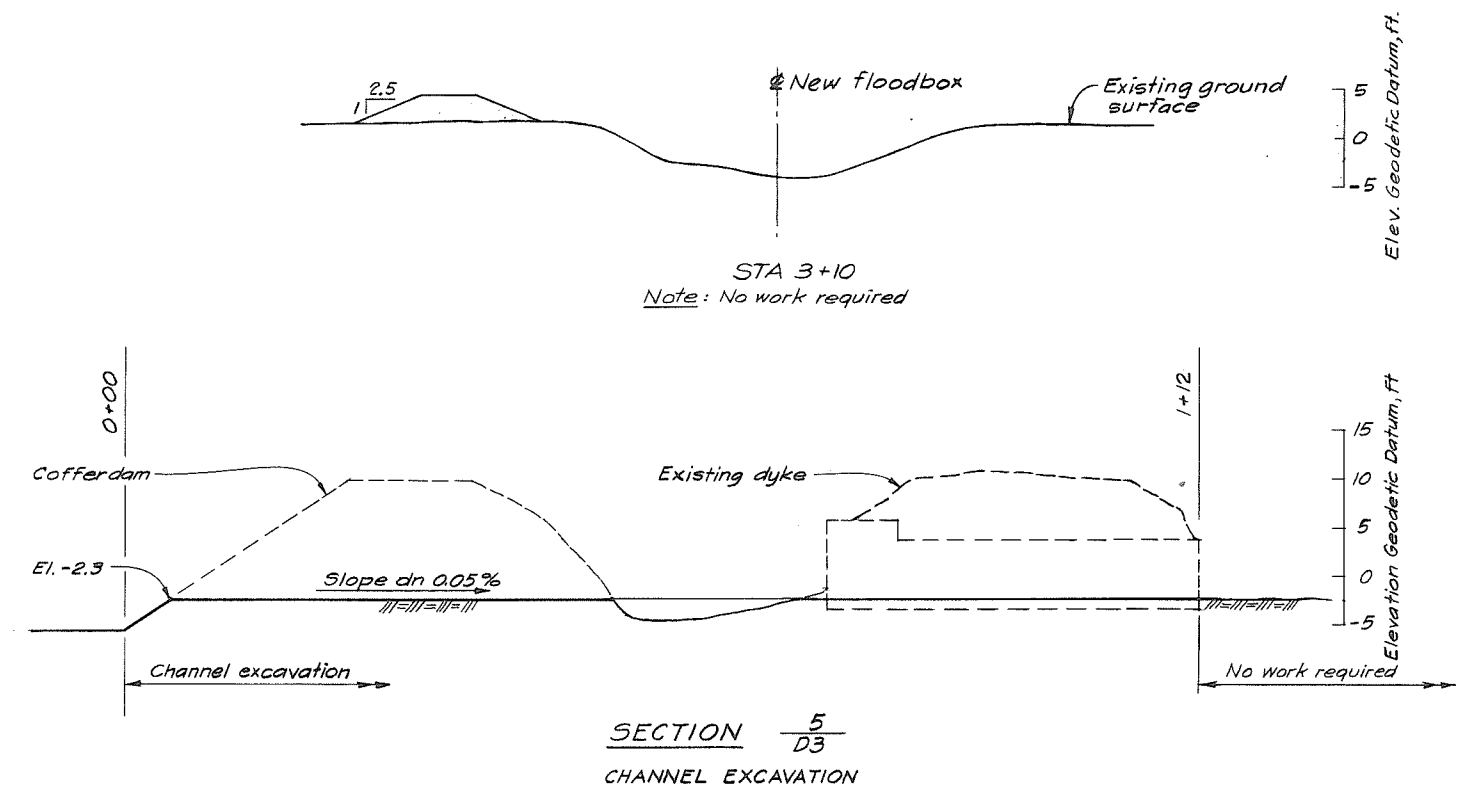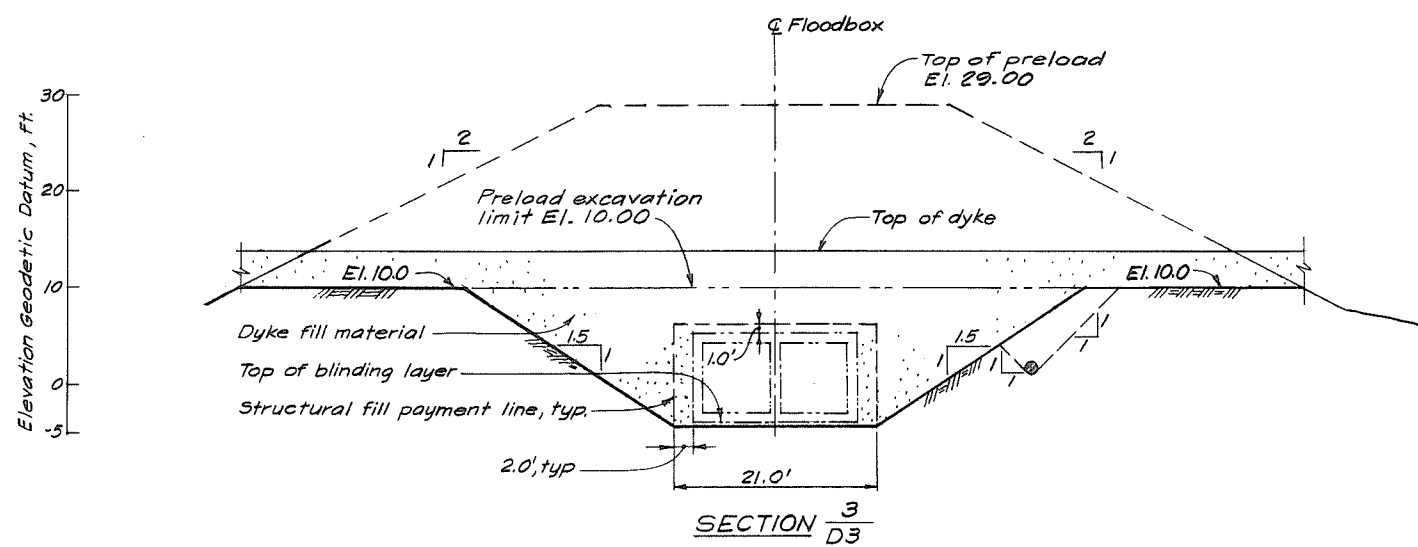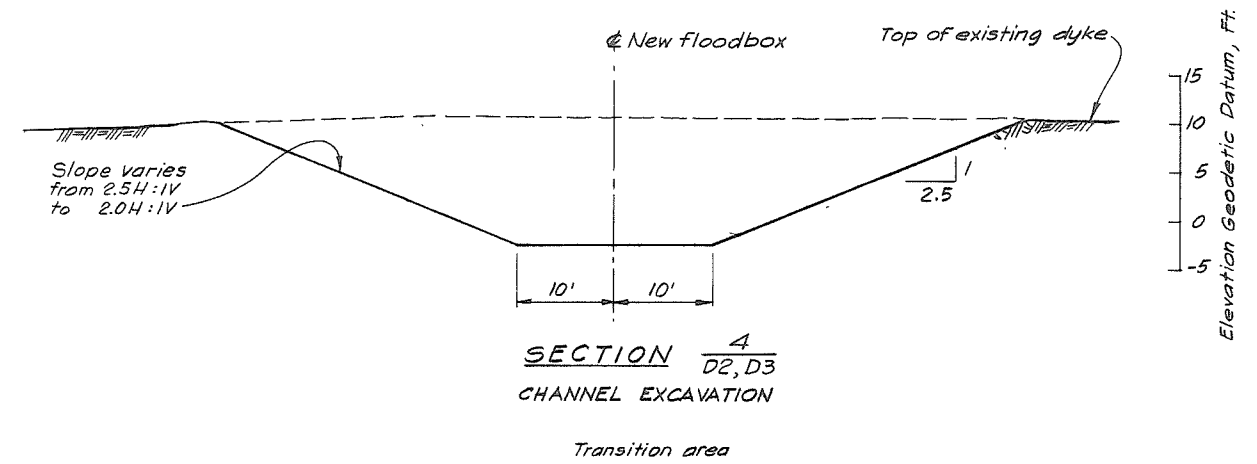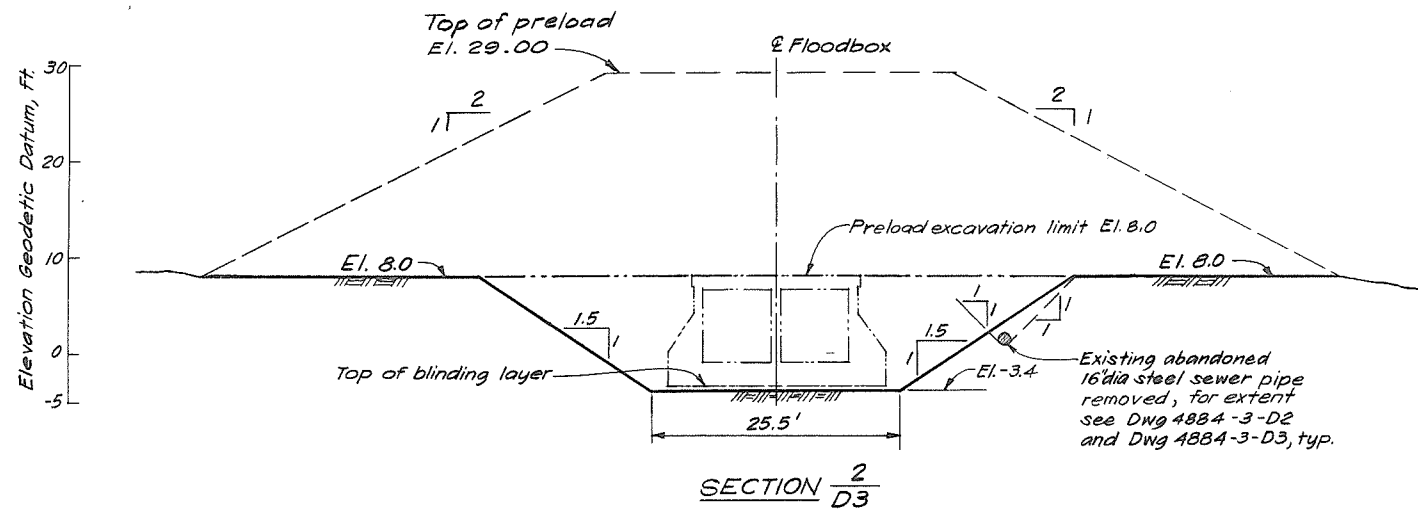

CRIPPEN ENGINEERING LTD.
 NORTH VANCOUVER, B.C.
 PROJECT NO. 10405

DEPARTMENT HEAD: *C.R. Bland*
 PROJECT ENGINEER: *M.A. Merlo*
 CHIEF ENGINEER: *John B. Hillan*

2. Record Drawing.
 APPROVED FOR CONSTRUCTION JUL 23 84

1. Prepared for Tender (Combined Contracts)

NO. DESCRIPTION REVISIONS BY CHD APPR DATE

RECOMMENDED: *E. B. ...* PROJECT MANAGER

DATE: *June 6 1984*

APPROVED: *John B. Hillan* DIRECTOR, WATER INVESTIGATIONS

DATE: *June 6/84*

BRITISH COLUMBIA
 MINISTRY OF THE ENVIRONMENT
 WATER INVESTIGATIONS BRANCH
 CANADA-BRITISH COLUMBIA
 FRASER RIVER FLOOD CONTROL 1968 AGREEMENT

PROJECT 10.4 CONTRACT NO. 2
**SOUTH WESTMINSTER FLOOD CONTROL WORKS
 MANSON ROAD FLOODBOX
 EXCAVATION & BACKFILL - SHEET 2 OF 2**

DESIGNED: *NRC*


DRAWN: *HNC*

CHECKED: *R.D., LVS*


SCALE: *As shown*

DWG. NO.: *4884-3-D4R2*


SHEET 18 OF 43 SHEETS

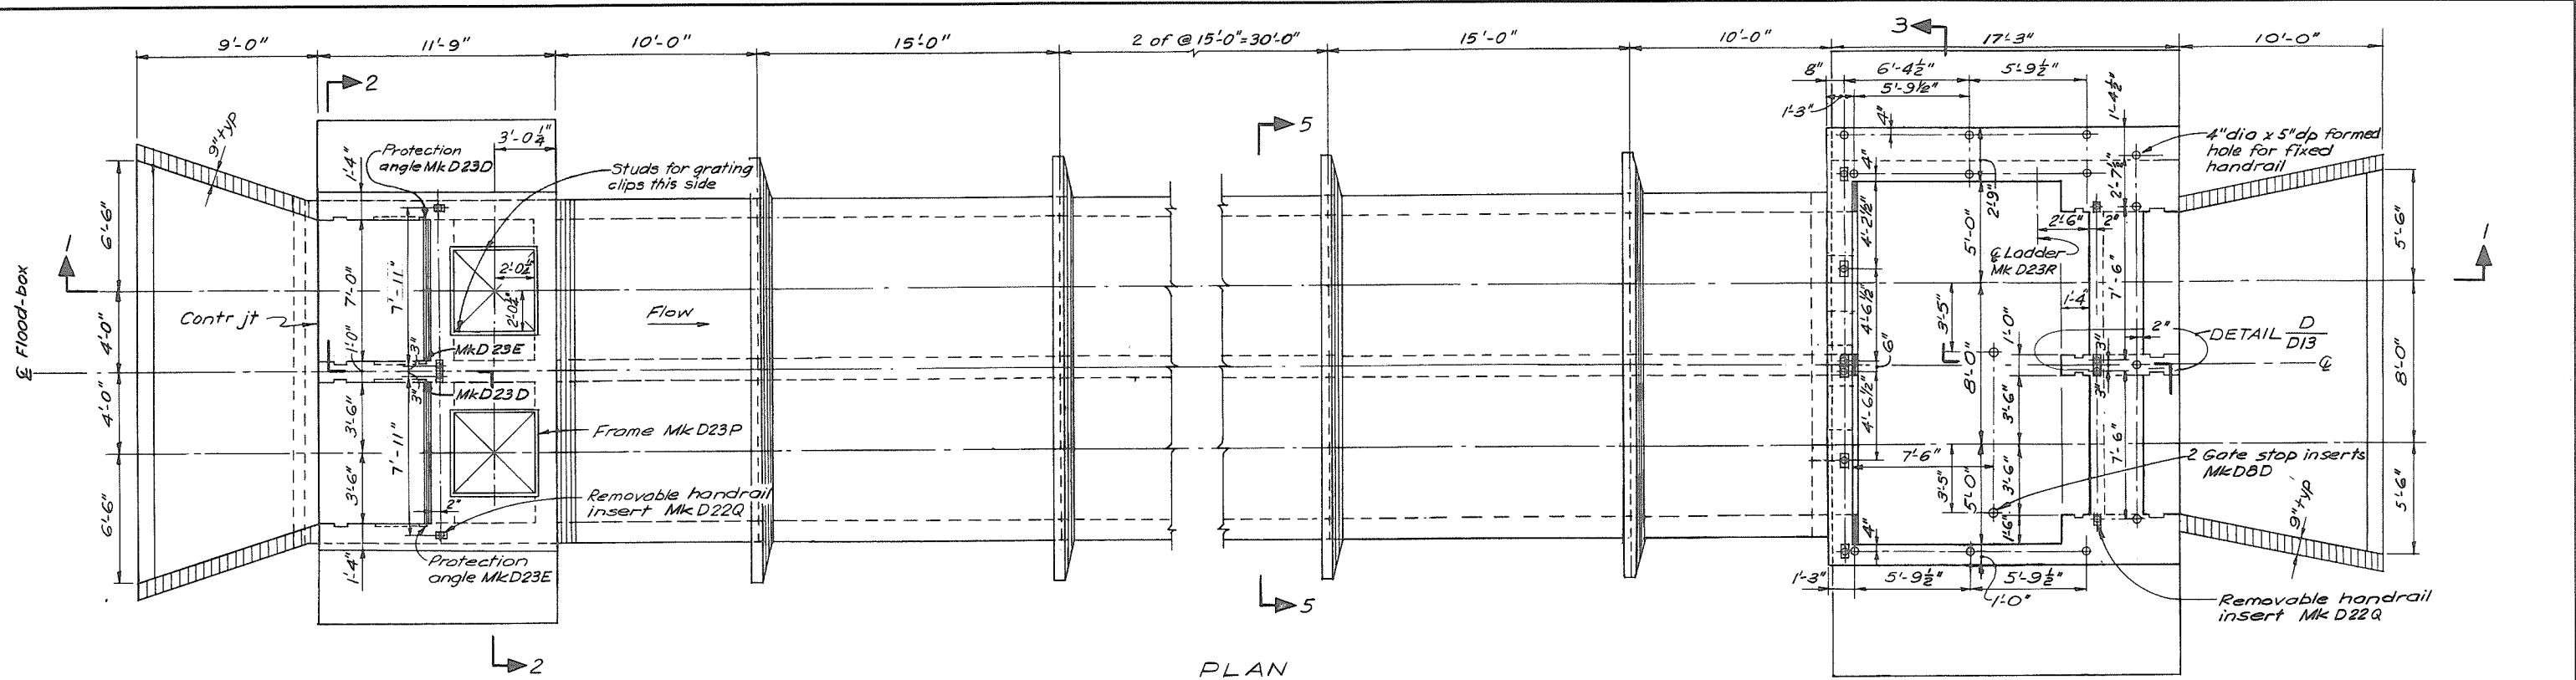


PLAN

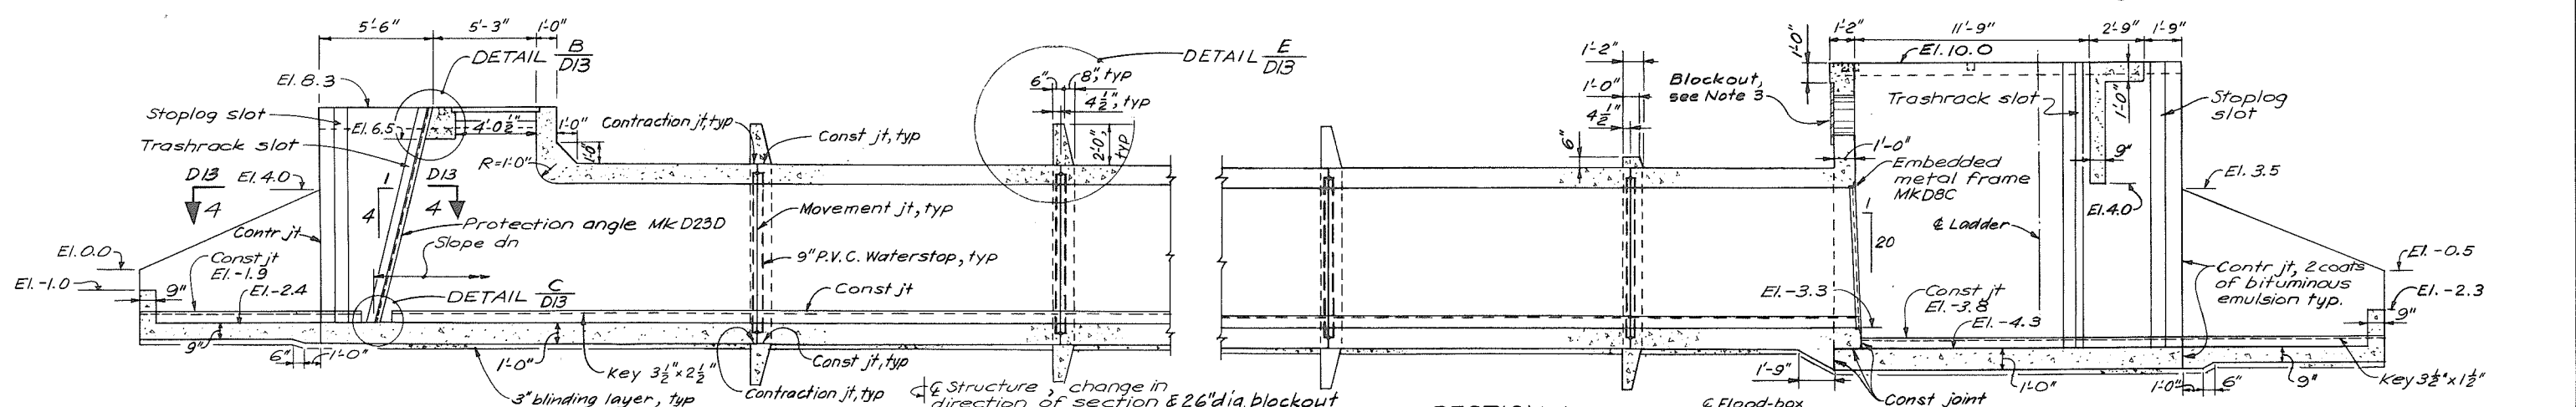


SECTION 1

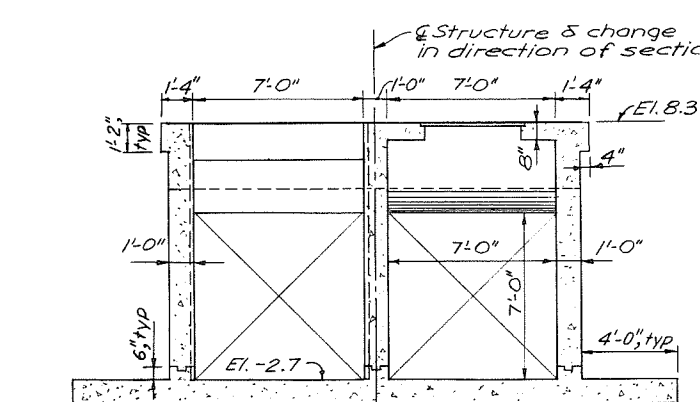

SECTION 2

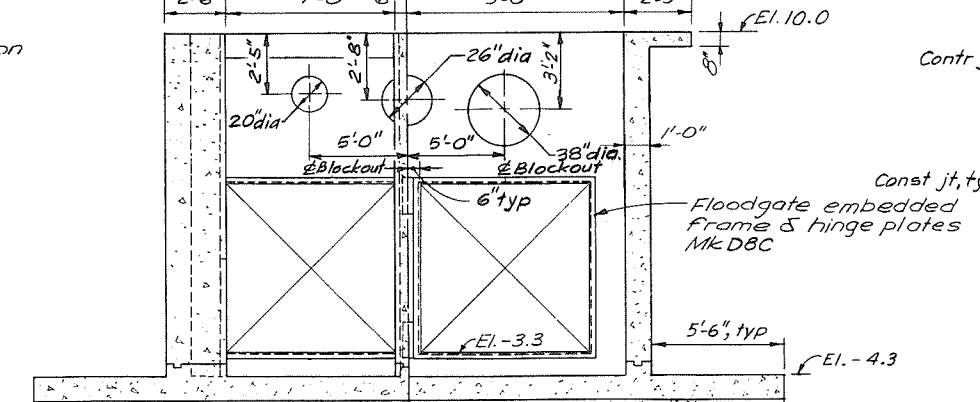

SECTION 3

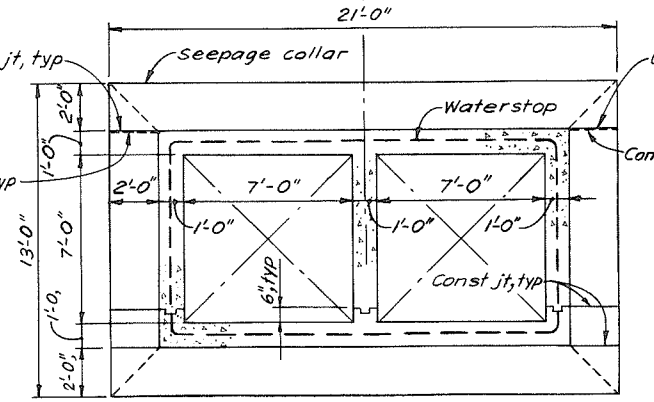

SECTION 5
(Blinding layer not shown)

- NOTES**
1. For reinf. details see Dwg 4884-3-D6 & D7.
 2. Concrete:
3" Blinding layer: Class III
Inlet, Outlet & Conduit: Class I.
 3. Blockout covered by nominal 2" thick temporary timber bulkheads



CRIPPEN ENGINEERING LTD.
NORTH VANCOUVER, B.C.
PROJECT NO. 10405

DEPARTMENT HEAD: *C.R. Blair*

PROJECT ENGINEER: *M.A. Merlo*

CHIEF ENGINEER: *John B. ...*

2. Record Drawing.
APPROVED FOR CONSTRUCTION JUL 25 84

1. Prepared for Tender (Combined Contracts).

RECOMMENDED: *Bob ...*
PROJECT MANAGER

DATE: June 6 1984.


APPROVED: *John ...*
DIRECTOR, WATER INVESTIGATIONS

DATE: Jun 6/84

BRITISH COLUMBIA
MINISTRY OF THE ENVIRONMENT
WATER INVESTIGATIONS BRANCH
CANADA - BRITISH COLUMBIA
FRASER RIVER FLOOD CONTROL 1968 AGREEMENT

PROJECT 10.4 CONTRACT NO. 2
**SOUTH WESTMINSTER FLOOD CONTROL WORKS
MANSON ROAD FLOODBOX
CONCRETE OUTLINE**

| | |
|-----------------------------|-------------------------------------|
| DESIGNED: <i>NMC</i> | SURVEYED: |
| DRAWN: <i>M.A.M.</i> | DATE: |
| CHECKED: <i>RSS</i> | FILE NO. 0281550-C12D-3 |
| SCALE: As shown | DATE: 14 Feb, 1979. |
| DWG. NO. 4884-3-D5R2 | SHEET 19 OF 43 SHEETS |

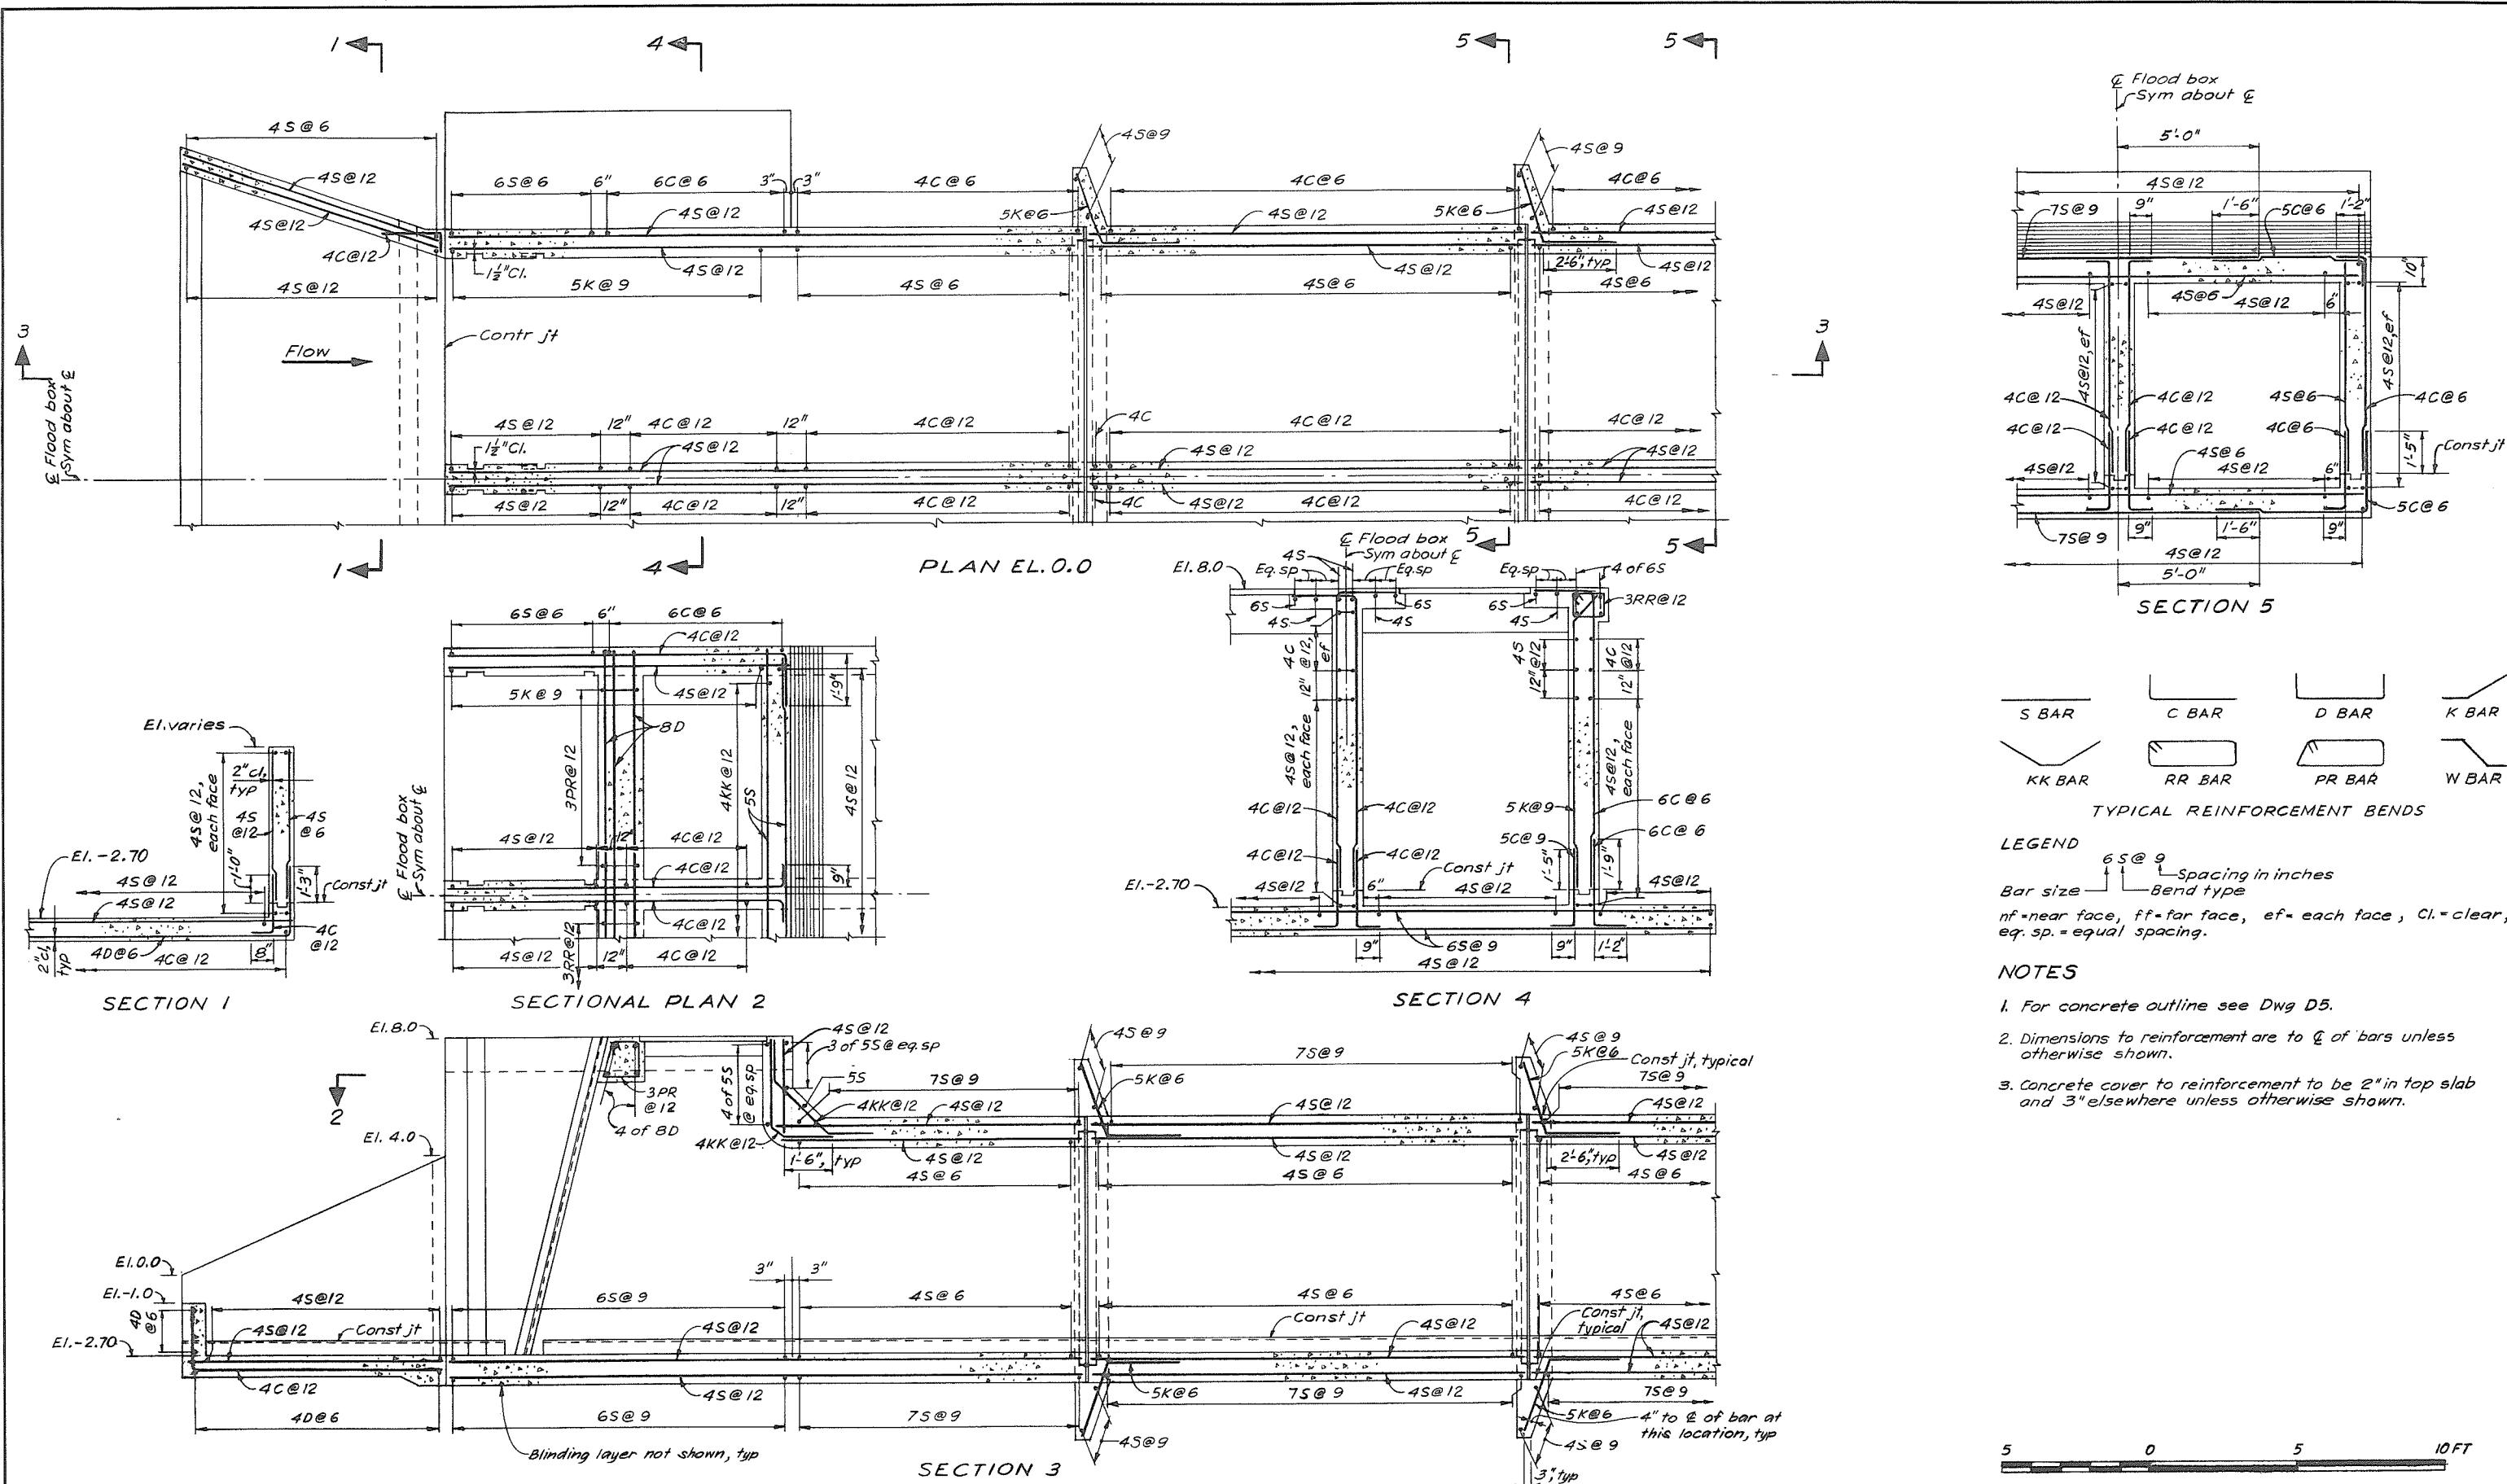

TYPICAL REINFORCEMENT BENDS

LEGEND

Bar size: $6S@9$ Spacing in inches
 Bend type

nf = near face, ff = far face, ef = each face, Cl. = clear, eq. sp. = equal spacing.

NOTES

- For concrete outline see Dwg D5.
- Dimensions to reinforcement are to \varnothing of bars unless otherwise shown.
- Concrete cover to reinforcement to be 2" in top slab and 3" elsewhere unless otherwise shown.



CRIPPEN ENGINEERING LTD.
 NORTH VANCOUVER, B.C.
 PROJECT NO. 10405

DEPARTMENT HEAD: *[Signature]*
 PROJECT ENGINEER: *[Signature]*
 CHIEF ENGINEER: *[Signature]*

REVISIONS

| NO. | DESCRIPTION | BY | CHK | APPR | DATE |
|-----|--|-----|-----|------|-----------|
| 1 | Prepared for Tender (Combined Contracts) | FRS | WML | WML | 5-4-84 |
| 2 | Record Drawing | NO | MM | MM | 30-9-85 |
| | APPROVED FOR CONSTRUCTION | | | | JUL 25 84 |


RECOMMENDED: *[Signature]* PROJECT MANAGER
 DATE: June 6 1984

APPROVED: *[Signature]*
 DATE: Jun 6/84


BRITISH COLUMBIA
 MINISTRY OF THE ENVIRONMENT
 WATER INVESTIGATIONS BRANCH
 CANADA-BRITISH COLUMBIA
 FRASER RIVER FLOOD CONTROL 1988 AGREEMENT

PROJECT NO. 4 CONTRACT NO. 2
SOUTH WESTMINSTER FLOOD CONTROL WORKS
MANSON ROAD FLOODBOX
INLET - REINFORCEMENT


| | |
|------------------------------|-------------------------|
| DESIGNED: <i>[Signature]</i> | SURVEYED: _____ |
| DRAWN: S.K.C. | DATE: _____ |
| CHECKED: RSS | FILE NO: 0281550-C12D-3 |
| SCALE: As shown | DATE: 14 Feb, 1979. |
| DWG. NO. 4884-3-D6 R2 | SHEET 20 OF 43 SHEETS |

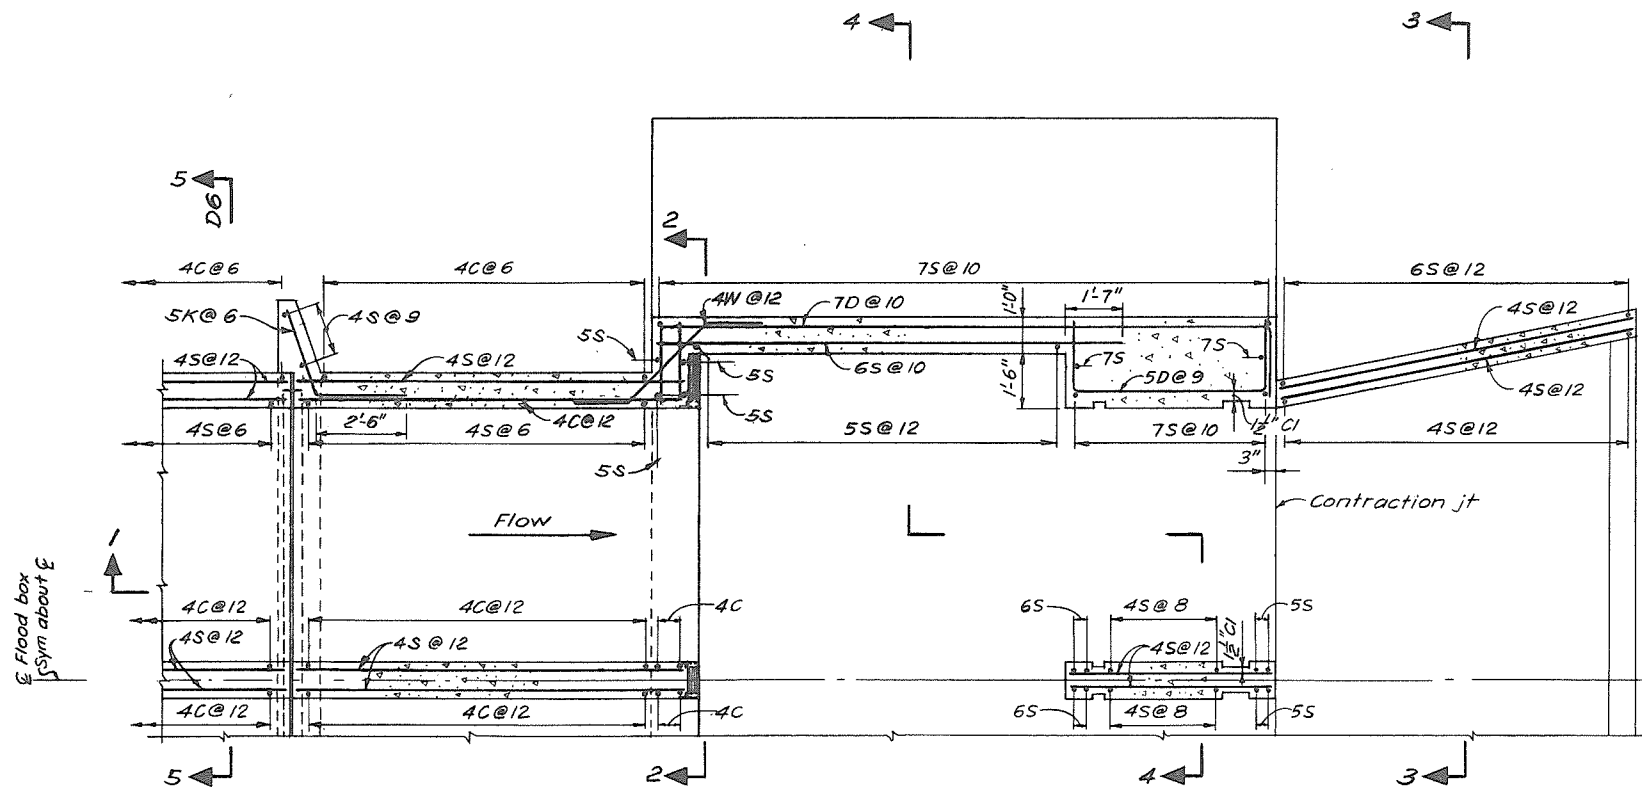


PLAN EL. 0.0

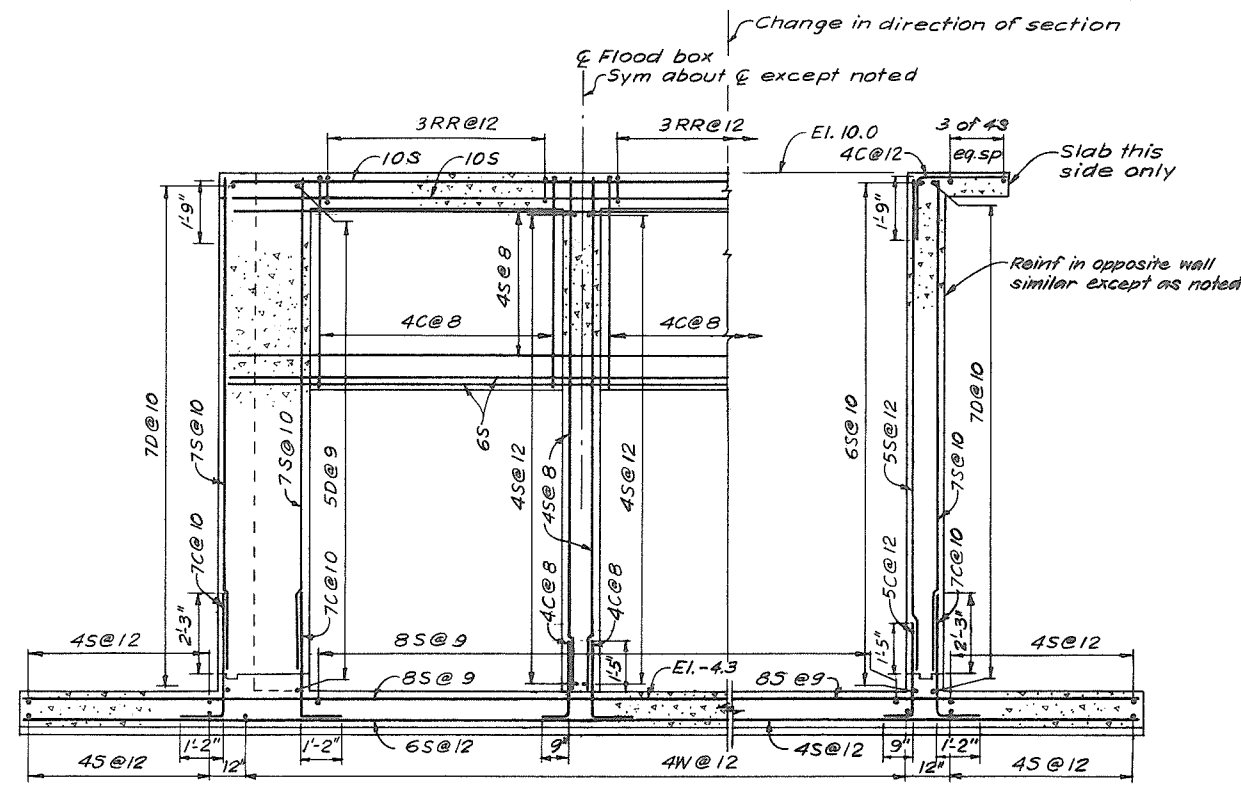


SECTION 4

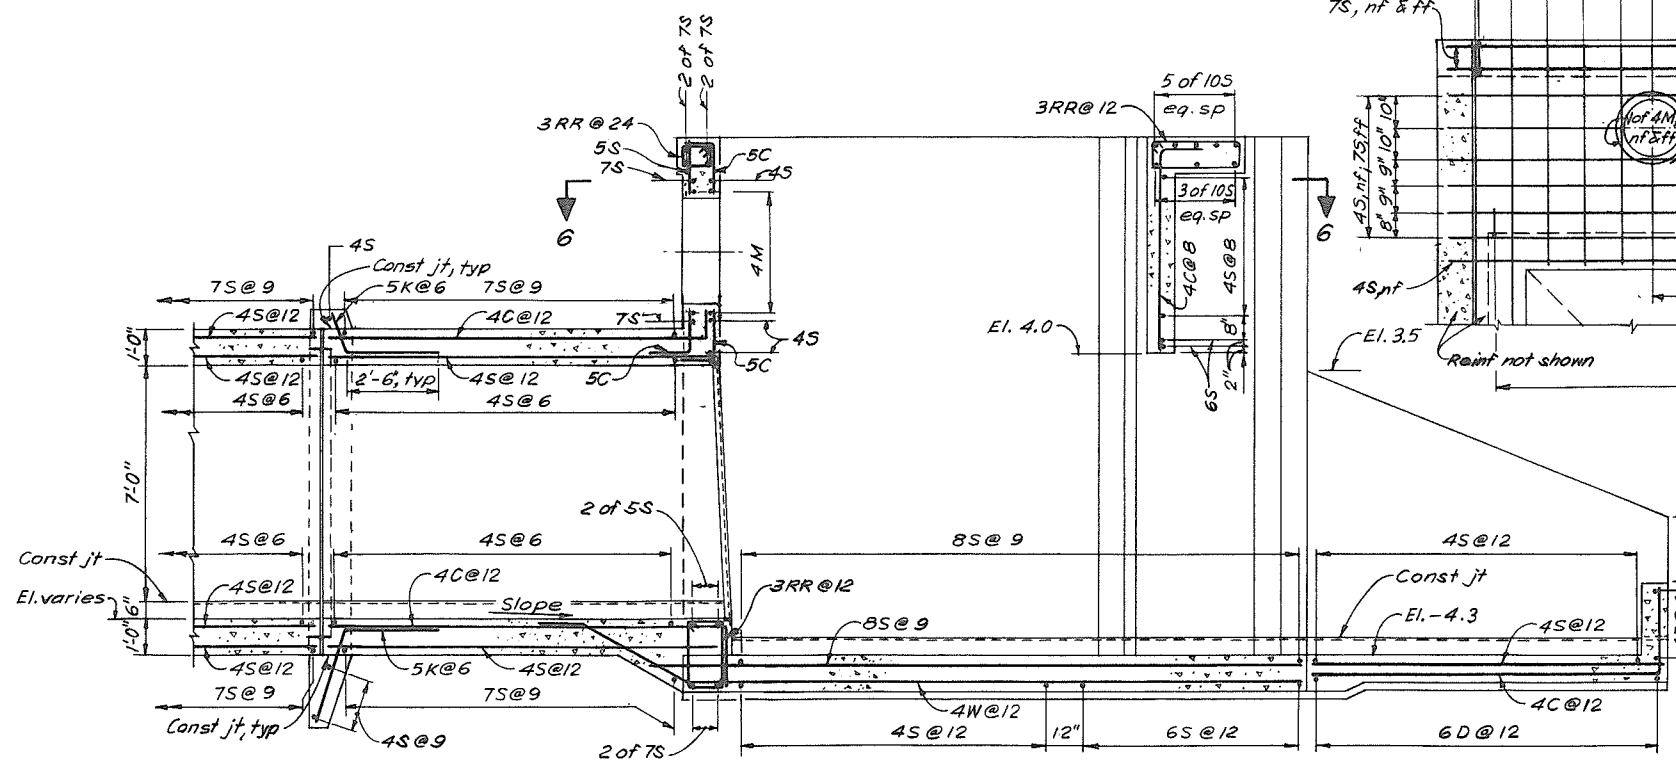


SECTION 1

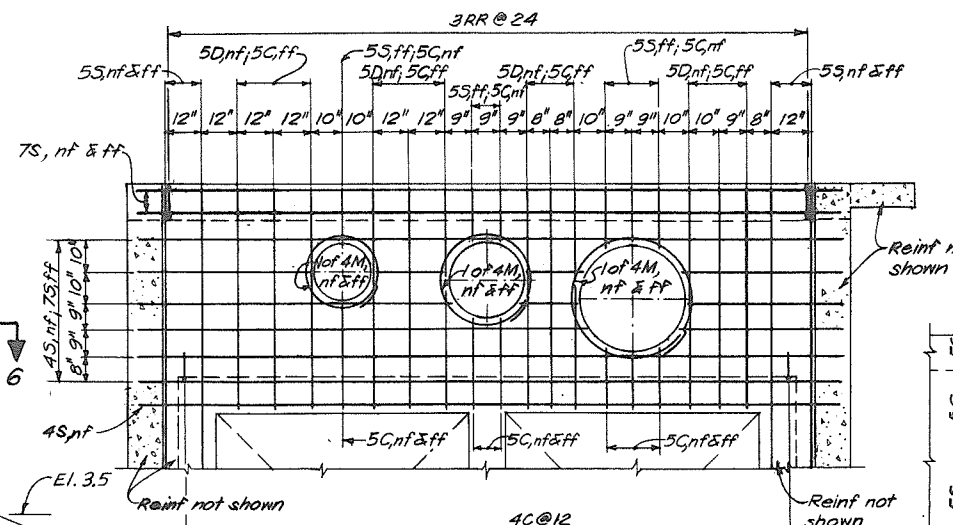

SECTION 2

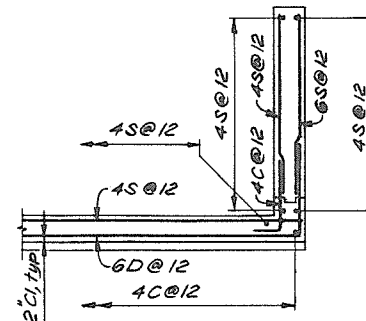


SECTION 3

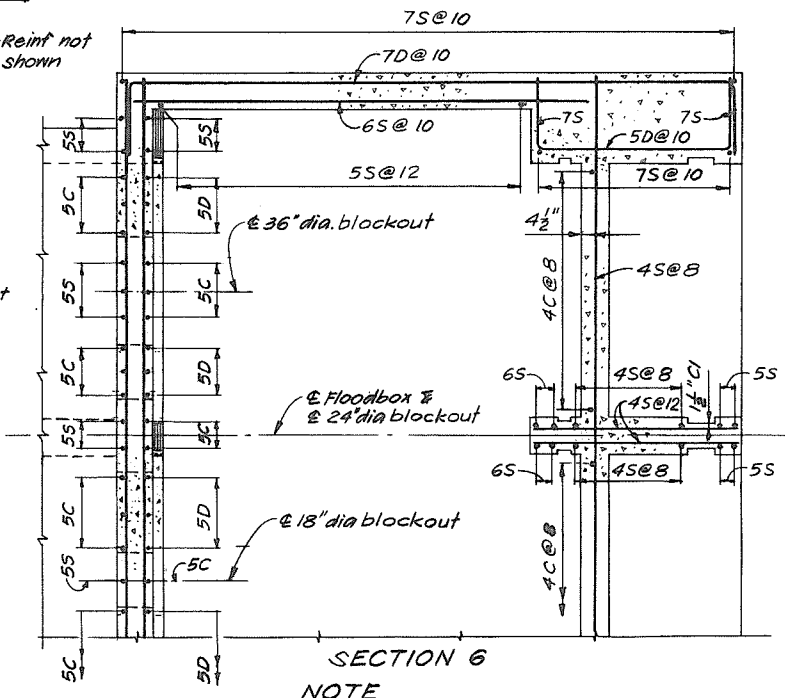

SECTION 6

NOTE
1. For notes and legend see Dwg 4884-3-D6.

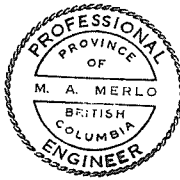


CRIPPEN ENGINEERING LTD.
NORTH VANCOUVER, B.C.
PROJECT NO. 10405
DEPARTMENT HEAD: *[Signature]*
PROJECT ENGINEER: *[Signature]*
CHIEF ENGINEER: *[Signature]*

| | | | | |
|---|-------------|----|-----|---------|
| 2. Record Drawing | | MP | JM | 30-9-85 |
| APPROVED FOR CONSTRUCTION JUL 23 1984 | | MS | MM | 5-6-84 |
| 1. Prepared for Tender (Combined Contracts) | | BY | CHD | APPR |
| NO | DESCRIPTION | BY | CHD | APPR |
| | REVISIONS | | | |


RECOMMENDED *[Signature]*
PROJECT MANAGER
DATE June 6 1984
APPROVED *[Signature]*
DIRECTOR, WATER INVESTIGATIONS
DATE Jun 6/84

BRITISH COLUMBIA
MINISTRY OF THE ENVIRONMENT
WATER INVESTIGATIONS BRANCH
CANADA - BRITISH COLUMBIA
FRASER RIVER FLOOD CONTROL 1968 AGREEMENT
PROJECT 10.4 CONTRACT NO. 2
SOUTH WESTMINSTER FLOOD CONTROL WORKS
MANSON ROAD FLOODBOX
OUTLET - REINFORCEMENT


| | |
|-----------------------------|-------------------------|
| DESIGNED <i>[Signature]</i> | SURVEYED |
| DRAWN S.K.C. | DATE |
| CHECKED RSS | FILE NO. 0281550-C12D-3 |
| SCALE As shown | DATE 14 Feb, 1979 |
| DWG. NO. 4884-3-D7R2 | SHEET 21 OF 43 SHEETS |

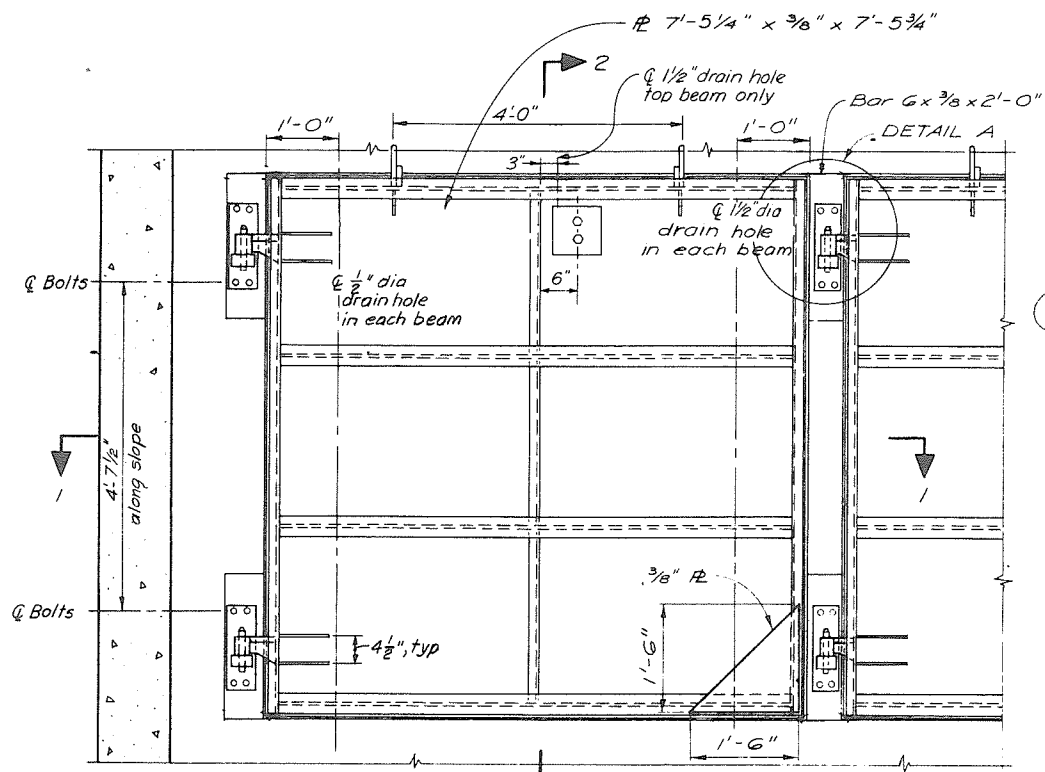


ELEVATION 2 - FLOODGATE MK C - 2 reqd
Scale A

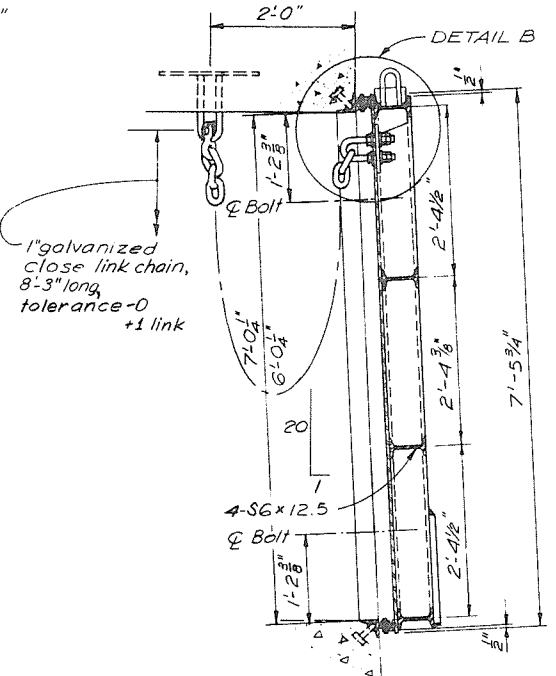


SECTION 2
Scale A

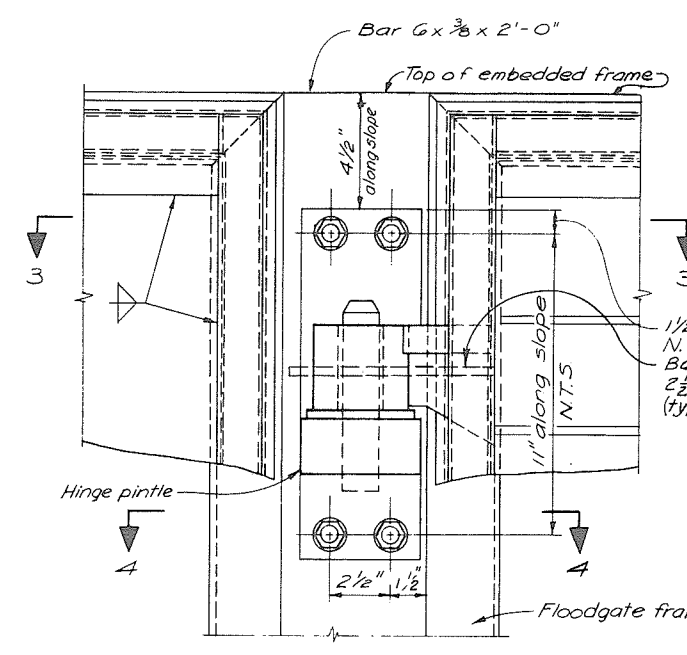


DETAIL A
Scale B

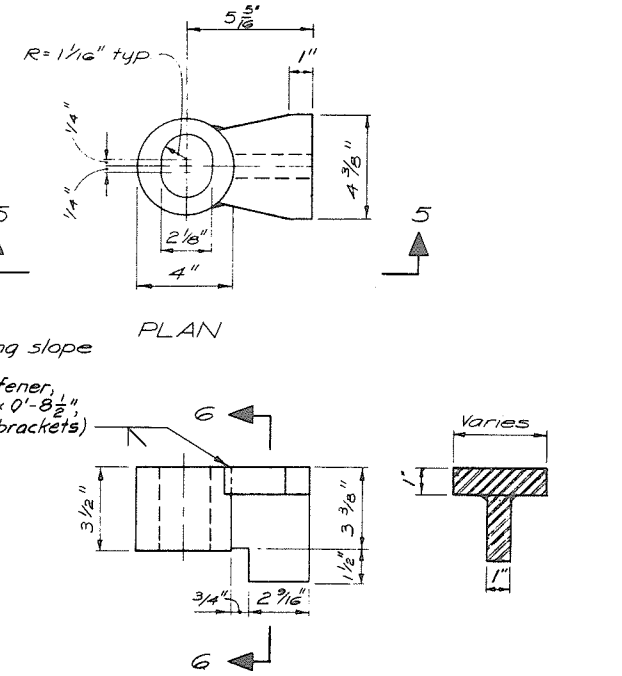


ELEVATION 5 HINGE BRACKET
Scale B

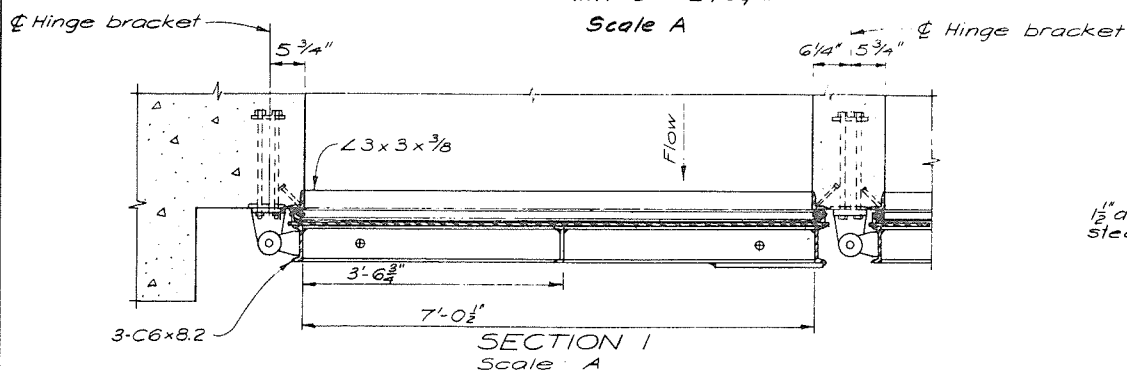


SECTION 1
Scale A

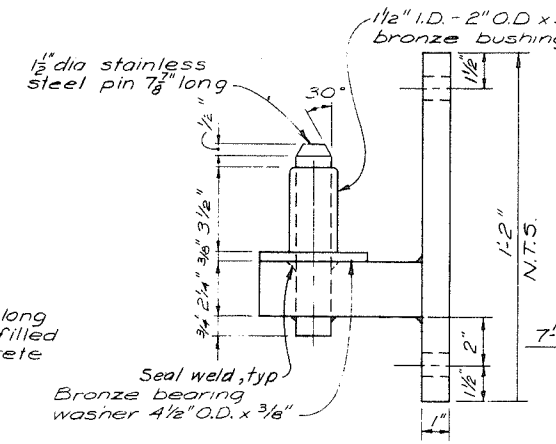


ELEVATION

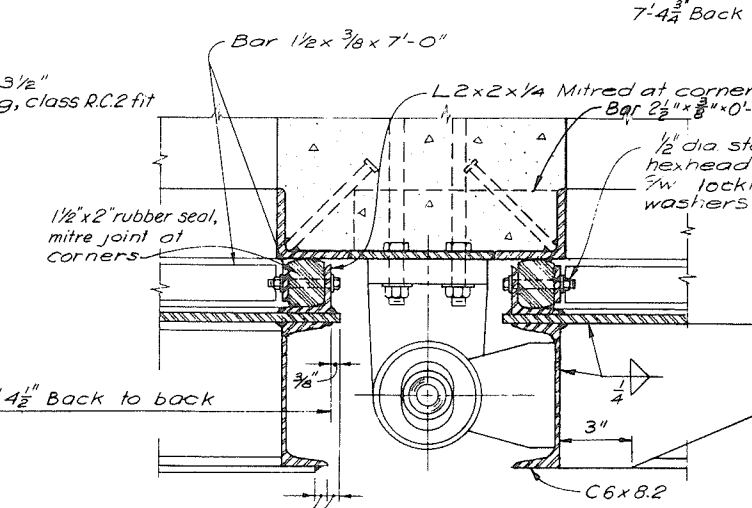

SECTION 3
Scale B

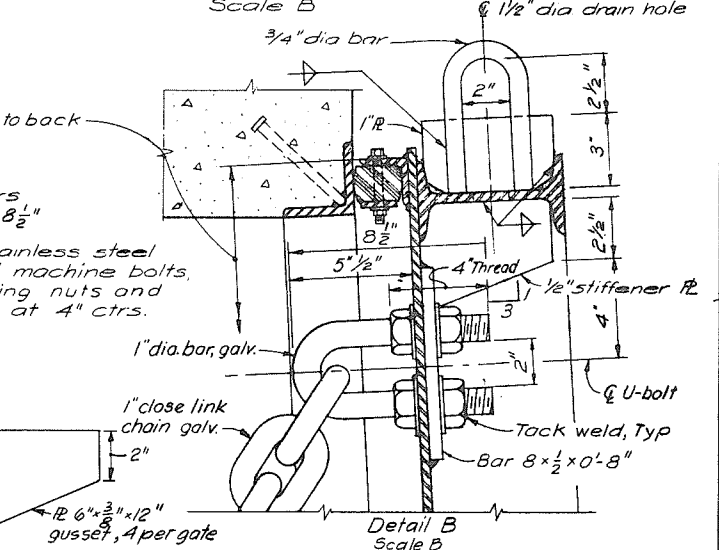


Detail B
Scale B

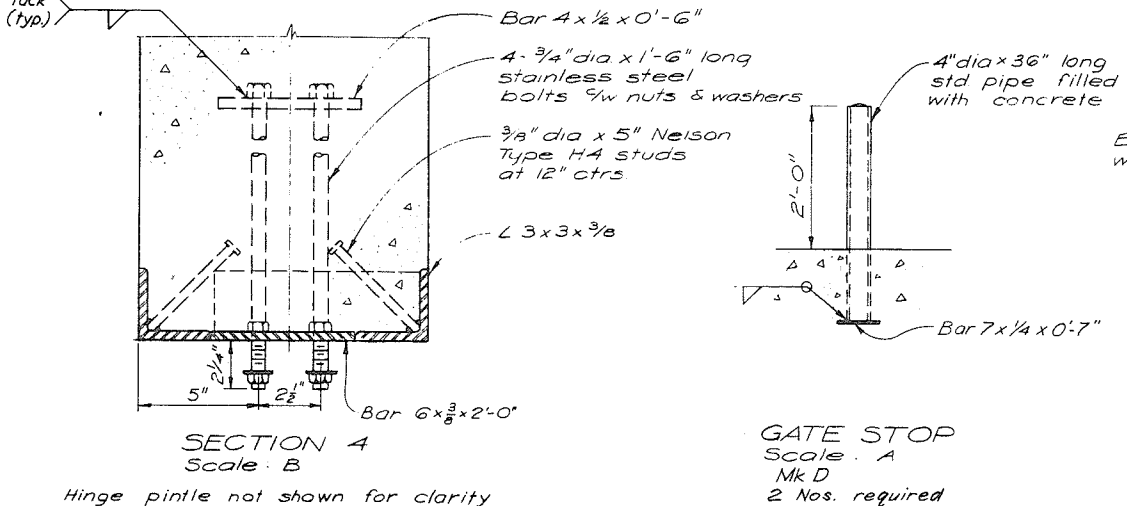


SECTION 4
Scale B

GATE STOP
Scale A
Mk D
2 Nos. required

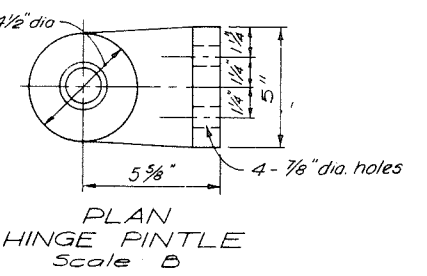



PLAN HINGE PINTLE
Scale B

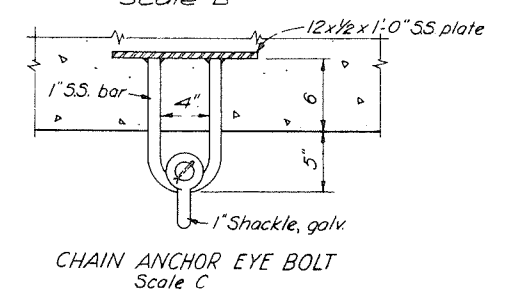

CHAIN ANCHOR EYE BOLT
Scale C

- NOTES**
- Mk letters to be prefixed 4884-3-DB and clearly painted on assemblies.
 - Reinforcement shall be adjusted to clear stud anchors.

NOTE ON DESIGN
Design adapted from Dwg 4944-1-D125
By: N.A.C.
Checked: M.A.M.
Original designed by A.D. checked by M.G.B., Aug 1976.

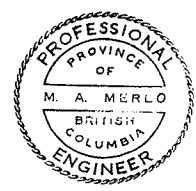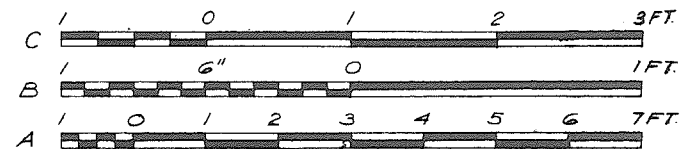

CRIPPEN ENGINEERING LTD.
NORTH VANCOUVER, B.C.
PROJECT NO. 10405
DEPARTMENT HEAD: C.P. Blad
PROJECT ENGINEER: M.A. Merlo
CHIEF ENGINEER: John S. ...



2. Record Drawing
APPROVED FOR CONSTRUCTION
1. Prepared for Tender (Combined Contracts)

APPROVED: M.G.B.
DATE: 5-6-84

RECOMMENDED: Estabark
PROJECT MANAGER
DATE: June 6, 1984



BRITISH COLUMBIA
MINISTRY OF THE ENVIRONMENT
WATER INVESTIGATIONS BRANCH
CANADA - BRITISH COLUMBIA
FRASER RIVER FLOOD CONTROL 1968 AGREEMENT
PROJECT 10.4 CONTRACT NO. 2
SOUTH WESTMINSTER FLOOD CONTROL WORKS
MANSON ROAD FLOODBOX
FLOODGATES

DESIGNED: See Note On Design
DRAWN: ...
CHECKED: ...
SCALE: As shown
DWG. NO.: 4884-3-DB R2
SURVEYED: ...
FILE NO.: 0281550-C12D-3
DATE: 14 Feb, 1979.
SHEET 22 OF 43 SHEETS

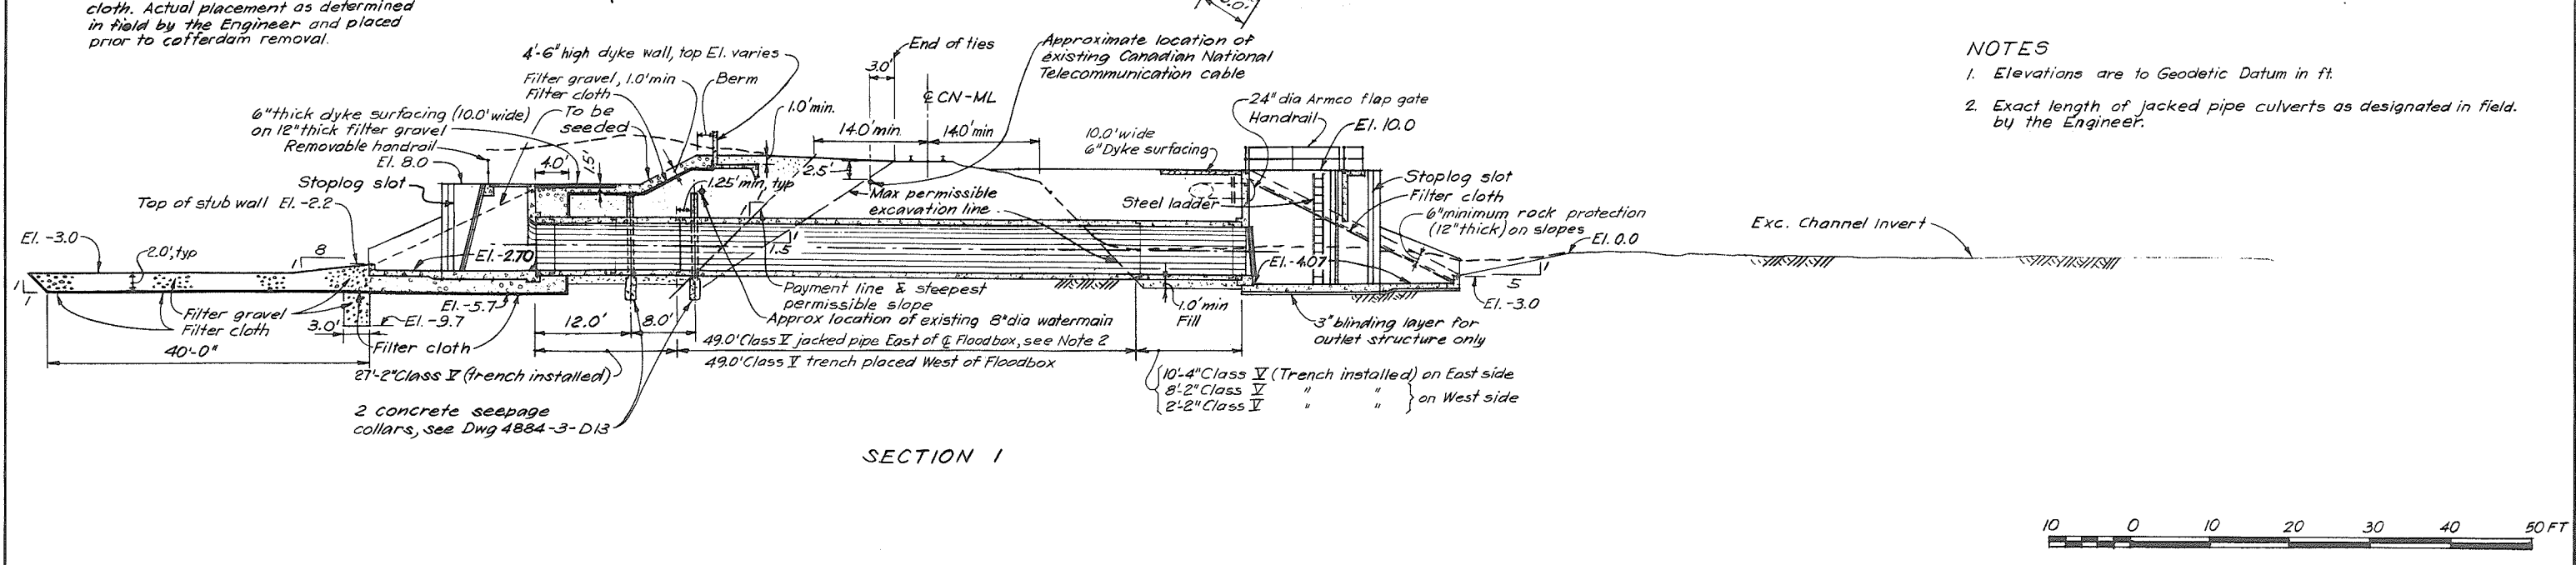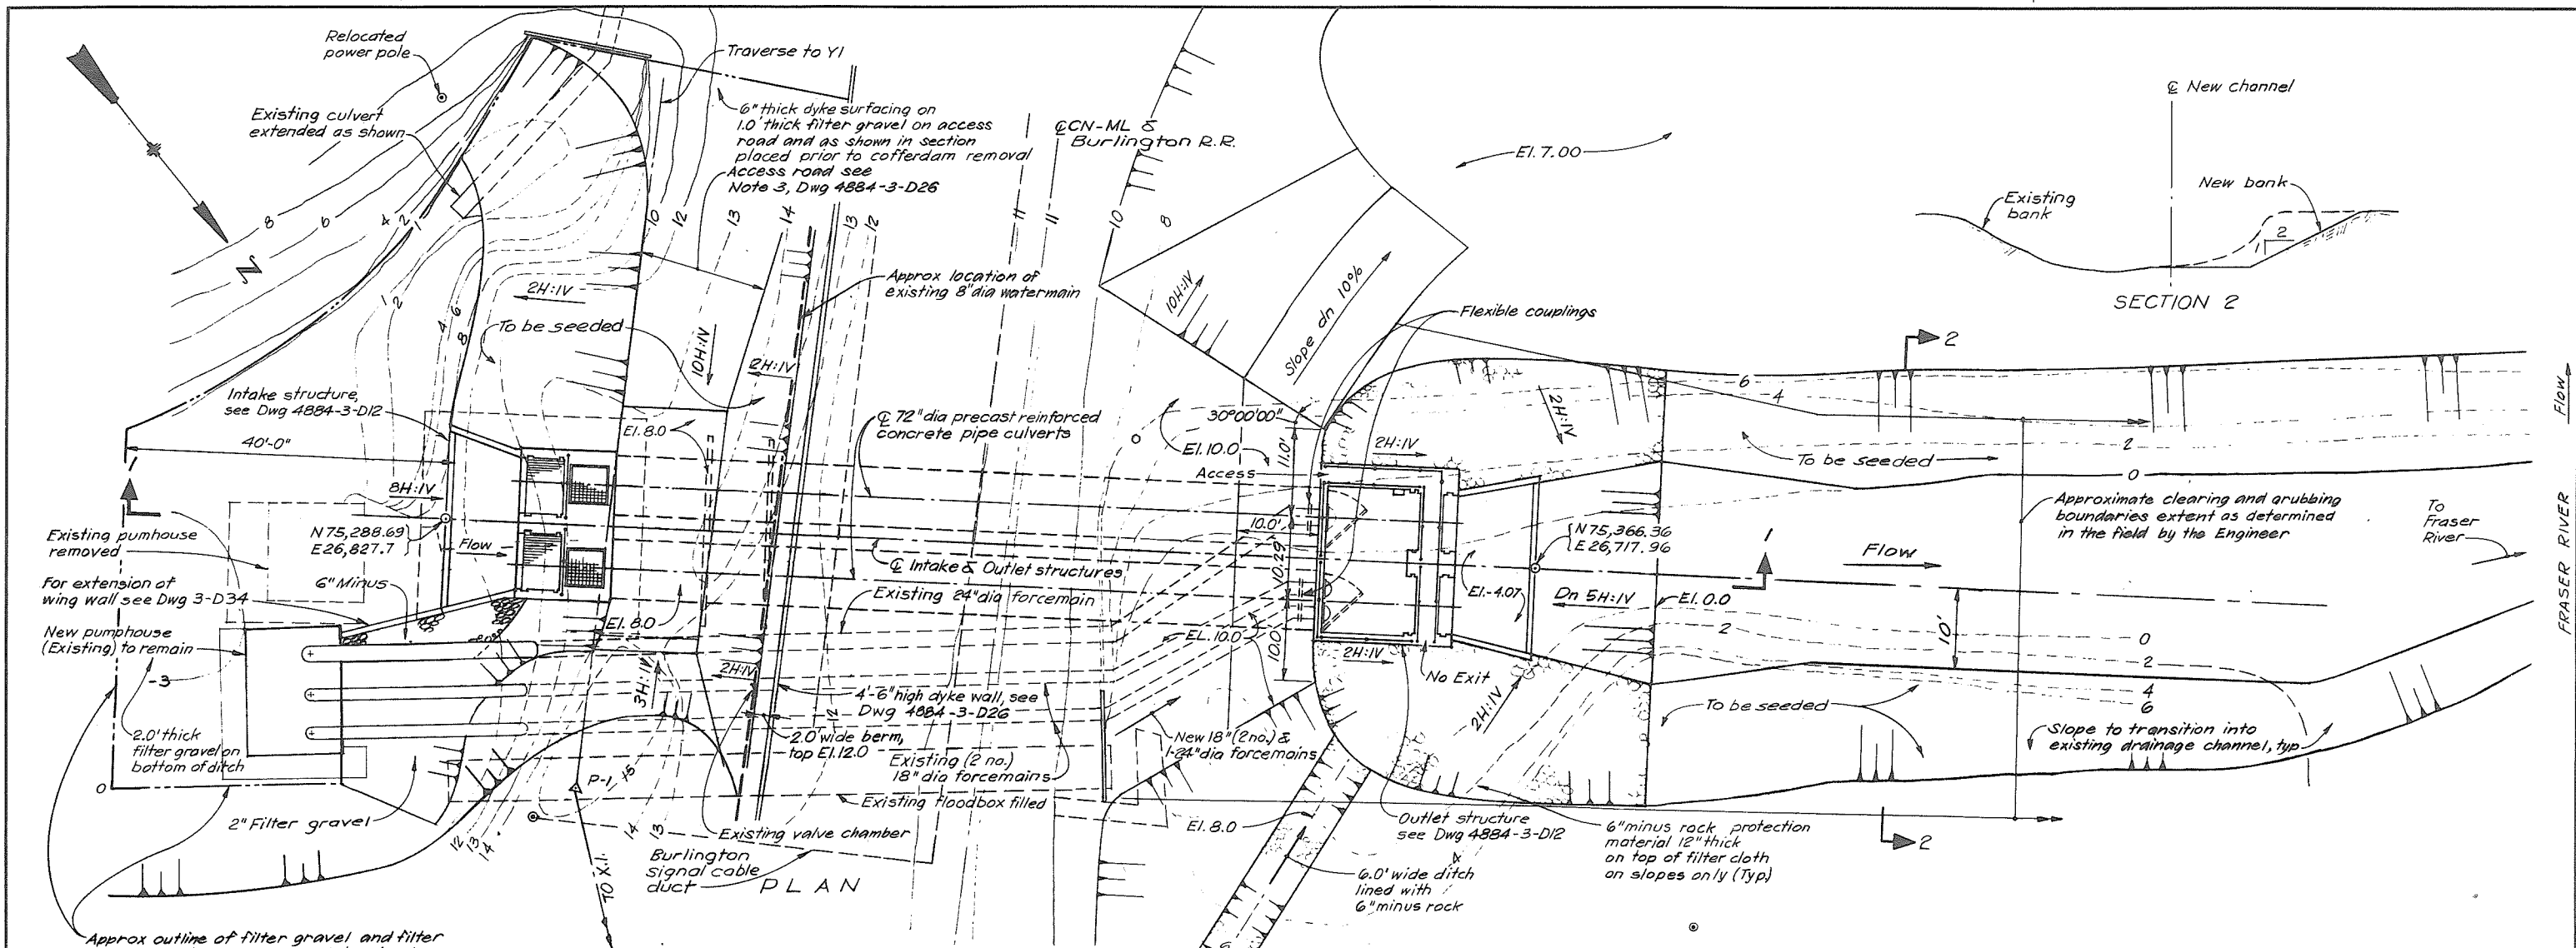

NOTES

1. Elevations are to Geodetic Datum in ft.
2. Exact length of jacked pipe culverts as designated in field by the Engineer.

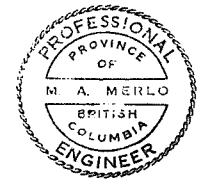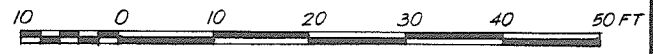

CRIPPEN ENGINEERING LTD.
 NORTH VANCOUVER, B.C.
 PROJECT NO. 10405

DEPARTMENT HEAD: *C. R. Blair*
 PROJECT ENGINEER: *M. A. Merlo*
 CHIEF ENGINEER: *John B. ...*

2. Record Drawing
 APPROVED FOR CONSTRUCTION
 1. Prepared for Tender (Combined Contracts)

NO. _____ DESCRIPTION _____ REVISIONS _____

RECOMMENDED *Edmond*
 PROJECT MANAGER
 DATE: June 6 1984


APPROVED *W. J. ...*
 DIRECTOR, WATER INVESTIGATIONS
 DATE: *June 6 1984*

BRITISH COLUMBIA
 MINISTRY OF THE ENVIRONMENT
 WATER INVESTIGATIONS BRANCH
 CANADA - BRITISH COLUMBIA
 FRASER RIVER FLOOD CONTROL 1968 AGREEMENT

PROJECT 10.4 CONTRACT NO. 2
 SOUTH WESTMINSTER FLOOD CONTROL WORKS
 PATTULLO FLOODBOX
 GENERAL ARRANGEMENT


DESIGNED: *NAC*
 DRAWN: *HNC, MP*
 CHECKED: *R. D., LVS*
 SCALE: As shown
 DWG. NO.: 4884-3-D9R2

SURVEYED: *E. S. & W.S.*
 DATE: Nov, 1974 & May, 1978.
 FILE NO.: 0281550-C12D-3
 DATE: 14 Feb, 1979.
 SHEET 23 OF 43 SHEETS

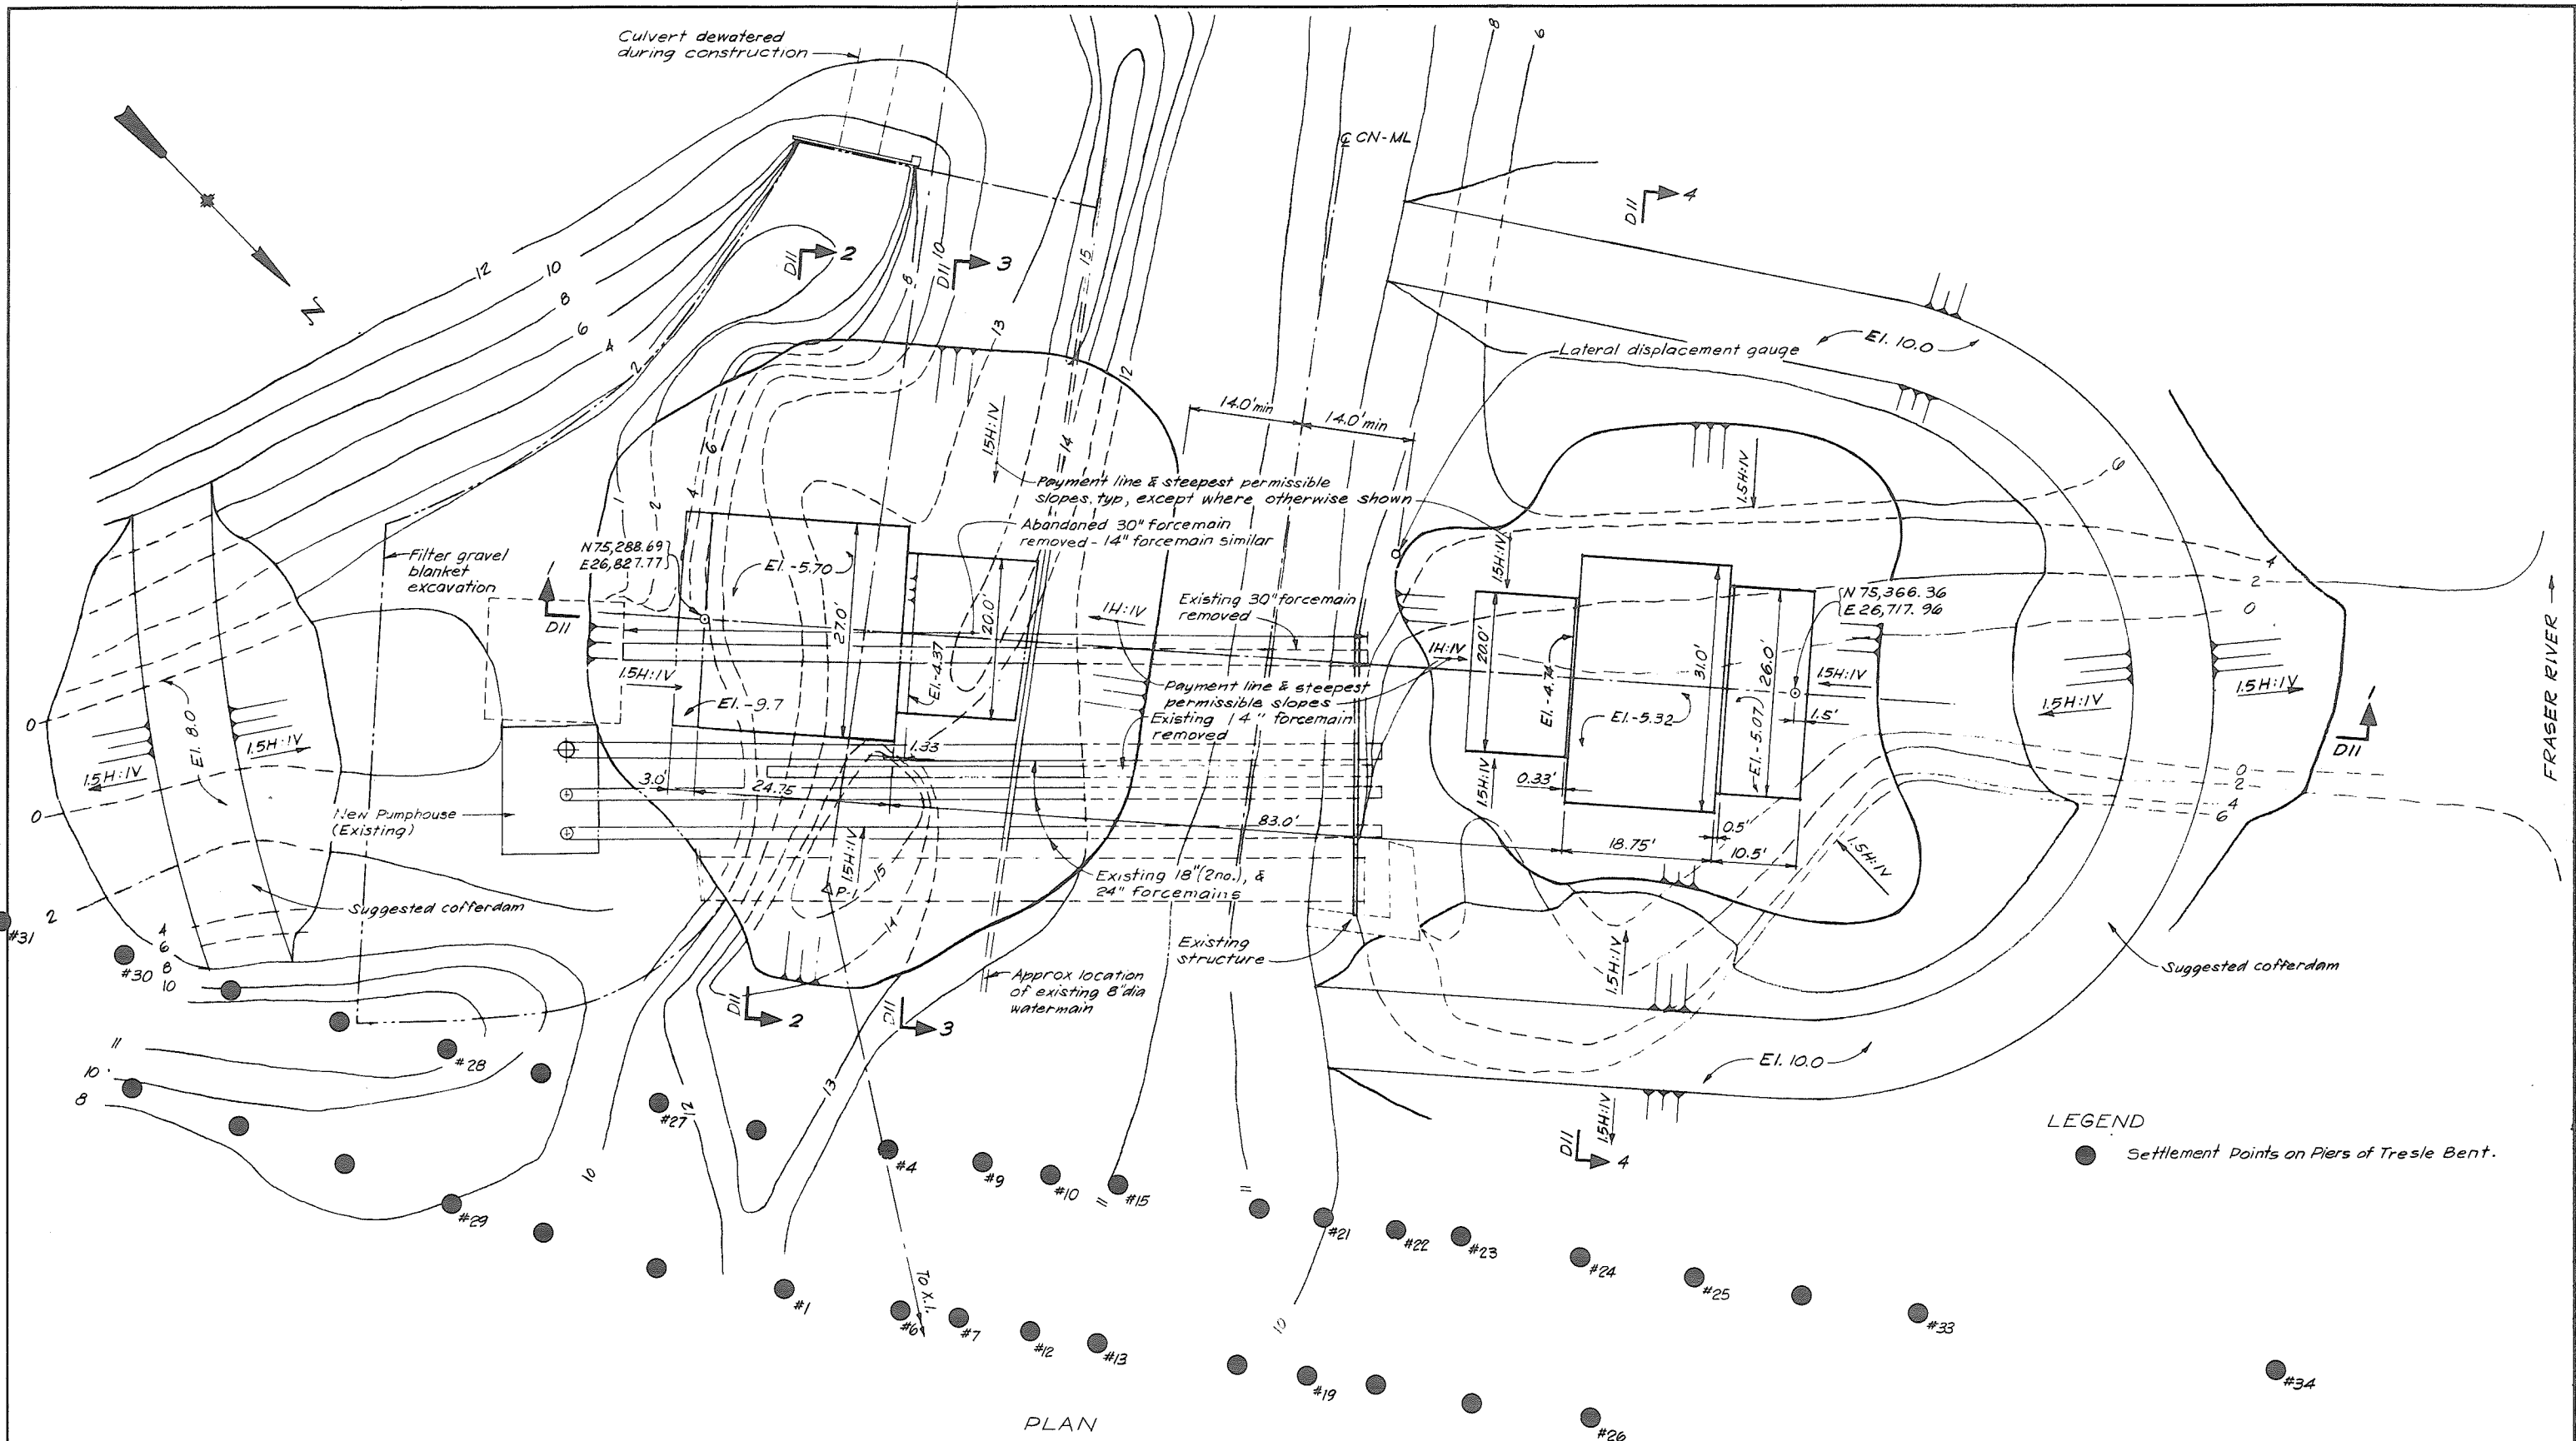

PLAN

LEGEND
 ● Settlement Points on Piers of Tresle Bent.

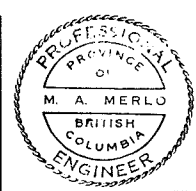

CRIPPEN ENGINEERING LTD.
 NORTH VANCOUVER, B.C.
 PROJECT NO. 10405
 DEPARTMENT HEAD: C.R. Blair
 PROJECT ENGINEER: M.A. Merlo
 CHIEF ENGINEER: John...

2. Record Drawing.
 APPROVED FOR CONSTRUCTION
 1. Prepared for Tender (Combined Contracts)






MP 1-10-85
 5-6-84

RECOMMENDED: [Signature]
 PROJECT MANAGER
 DATE: June 6 1984
 APPROVED: [Signature]
 DIRECTOR, WATER INVESTIGATIONS
 DATE: Jan 6/84

BRITISH COLUMBIA
 MINISTRY OF THE ENVIRONMENT
 WATER INVESTIGATIONS BRANCH
 CANADA-BRITISH COLUMBIA
 FRASER RIVER FLOOD CONTROL 1968 AGREEMENT
 PROJECT 10-4 CONTRACT NO. 2
 SOUTH WESTMINSTER FLOOD CONTROL WORKS
 PATTULLO FLOODBOX
 EXCAVATION & BACKFILL - SHEET 1 OF 2

| | |
|----------------------|---------------------------|
| DESIGNED: NRC | SURVEYED: E.S. & W.S. |
| DRAWN: HNC | DATE: Nov 1974 & May 1978 |
| CHECKED: R.D., LVS | FILE NO.: 0281550-C12D-3 |
| SCALE: As shown | DATE: 14 Feb 1979 |
| DWG. NO: 4884-3-DIOR | SHEET 24 OF 48 |

280107

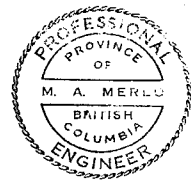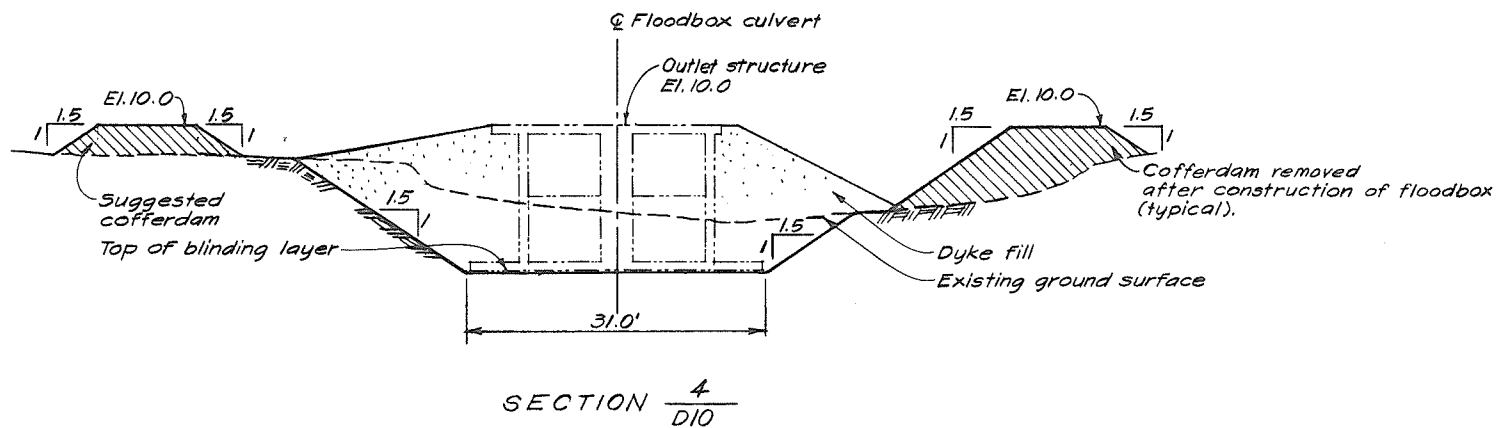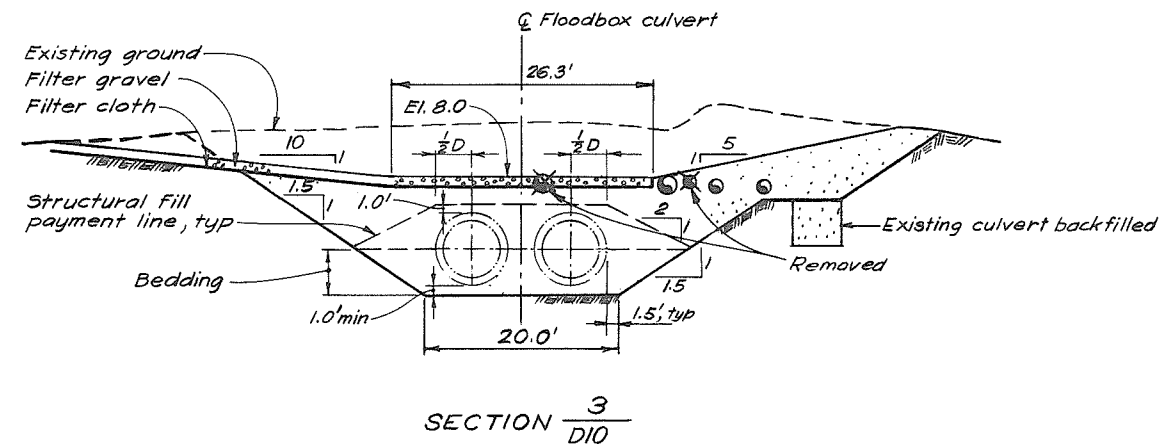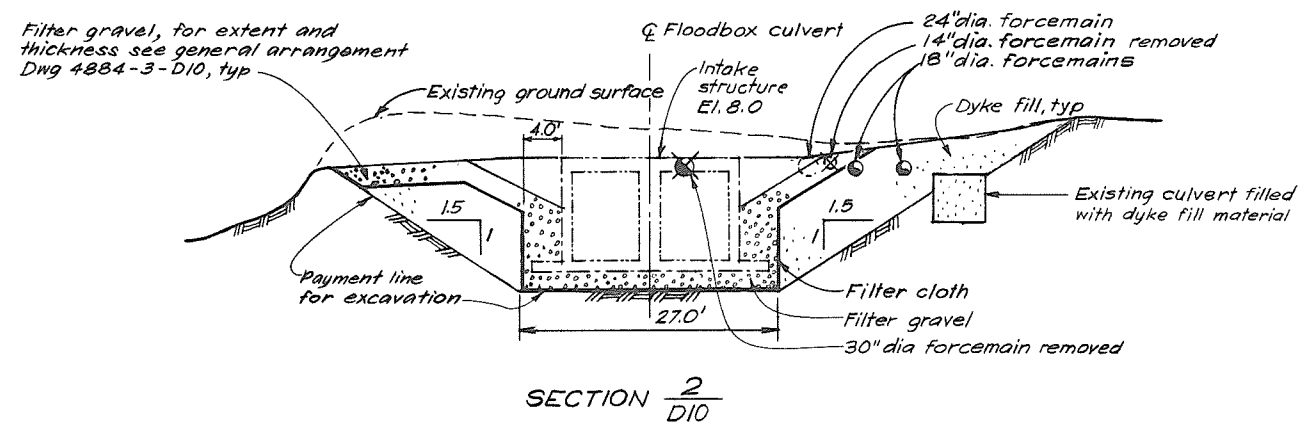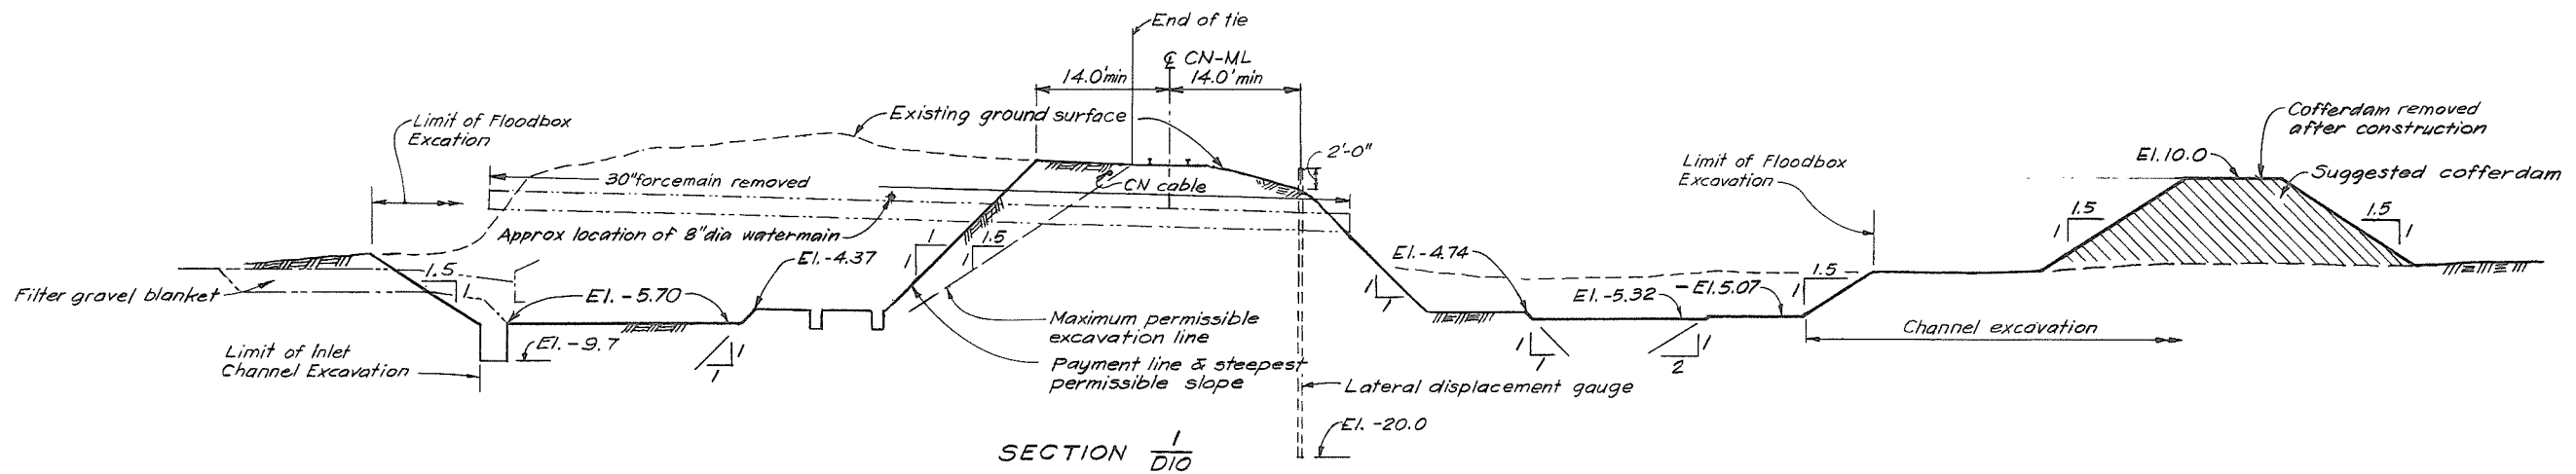

CRIPPEN ENGINEERING LTD.
 NORTH VANCOUVER, B.C.
 PROJECT NO. 10405

DEPARTMENT HEAD: *C.R. Blair*
 PROJECT ENGINEER: *M.A. Merlo*
 CHIEF ENGINEER: *John B. Miller*

2. Record Drawing
 APPROVED FOR CONSTRUCTION
 1. Prepared for Tender (Combined Contracts)


| NO. | DESCRIPTION | BY | CHKD | APPR | DATE |
|-----|-------------|----|------|------|---------|
| 1 | | MP | JM | | 1-10-85 |
| 2 | | MS | MM | MM | 5-6-84 |

RECOMMENDED: *Geo Borden* PROJECT MANAGER
 DATE: *June 6 1984*
 APPROVED: *John Miller* DIRECTOR, WATER INVESTIGATIONS
 DATE: *Jun 6/84*


BRITISH COLUMBIA
 MINISTRY OF THE ENVIRONMENT
 WATER INVESTIGATIONS BRANCH
 CANADA - BRITISH COLUMBIA
 FRASER RIVER FLOOD CONTROL 1968 AGREEMENT

PROJECT 10.4 CONTRACT NO. 2
 SOUTH WESTMINSTER FLOOD CONTROL WORKS
 PATTULLO FLOODBOX
 EXCAVATION & BACKFILL - SHEET 2 OF 2

| DESIGNED | NAC | SURVEYED |
|----------|--------------|-------------------------|
| DRAWN | HNC | DATE |
| CHECKED | R.E.O., LVS | FILE NO. 0281550-C12D-3 |
| SCALE | As shown | DATE 14 Feb, 1979 |
| DWG. NO. | 4884-3-D11R2 | SHEET 25 OF 43 SHEETS |

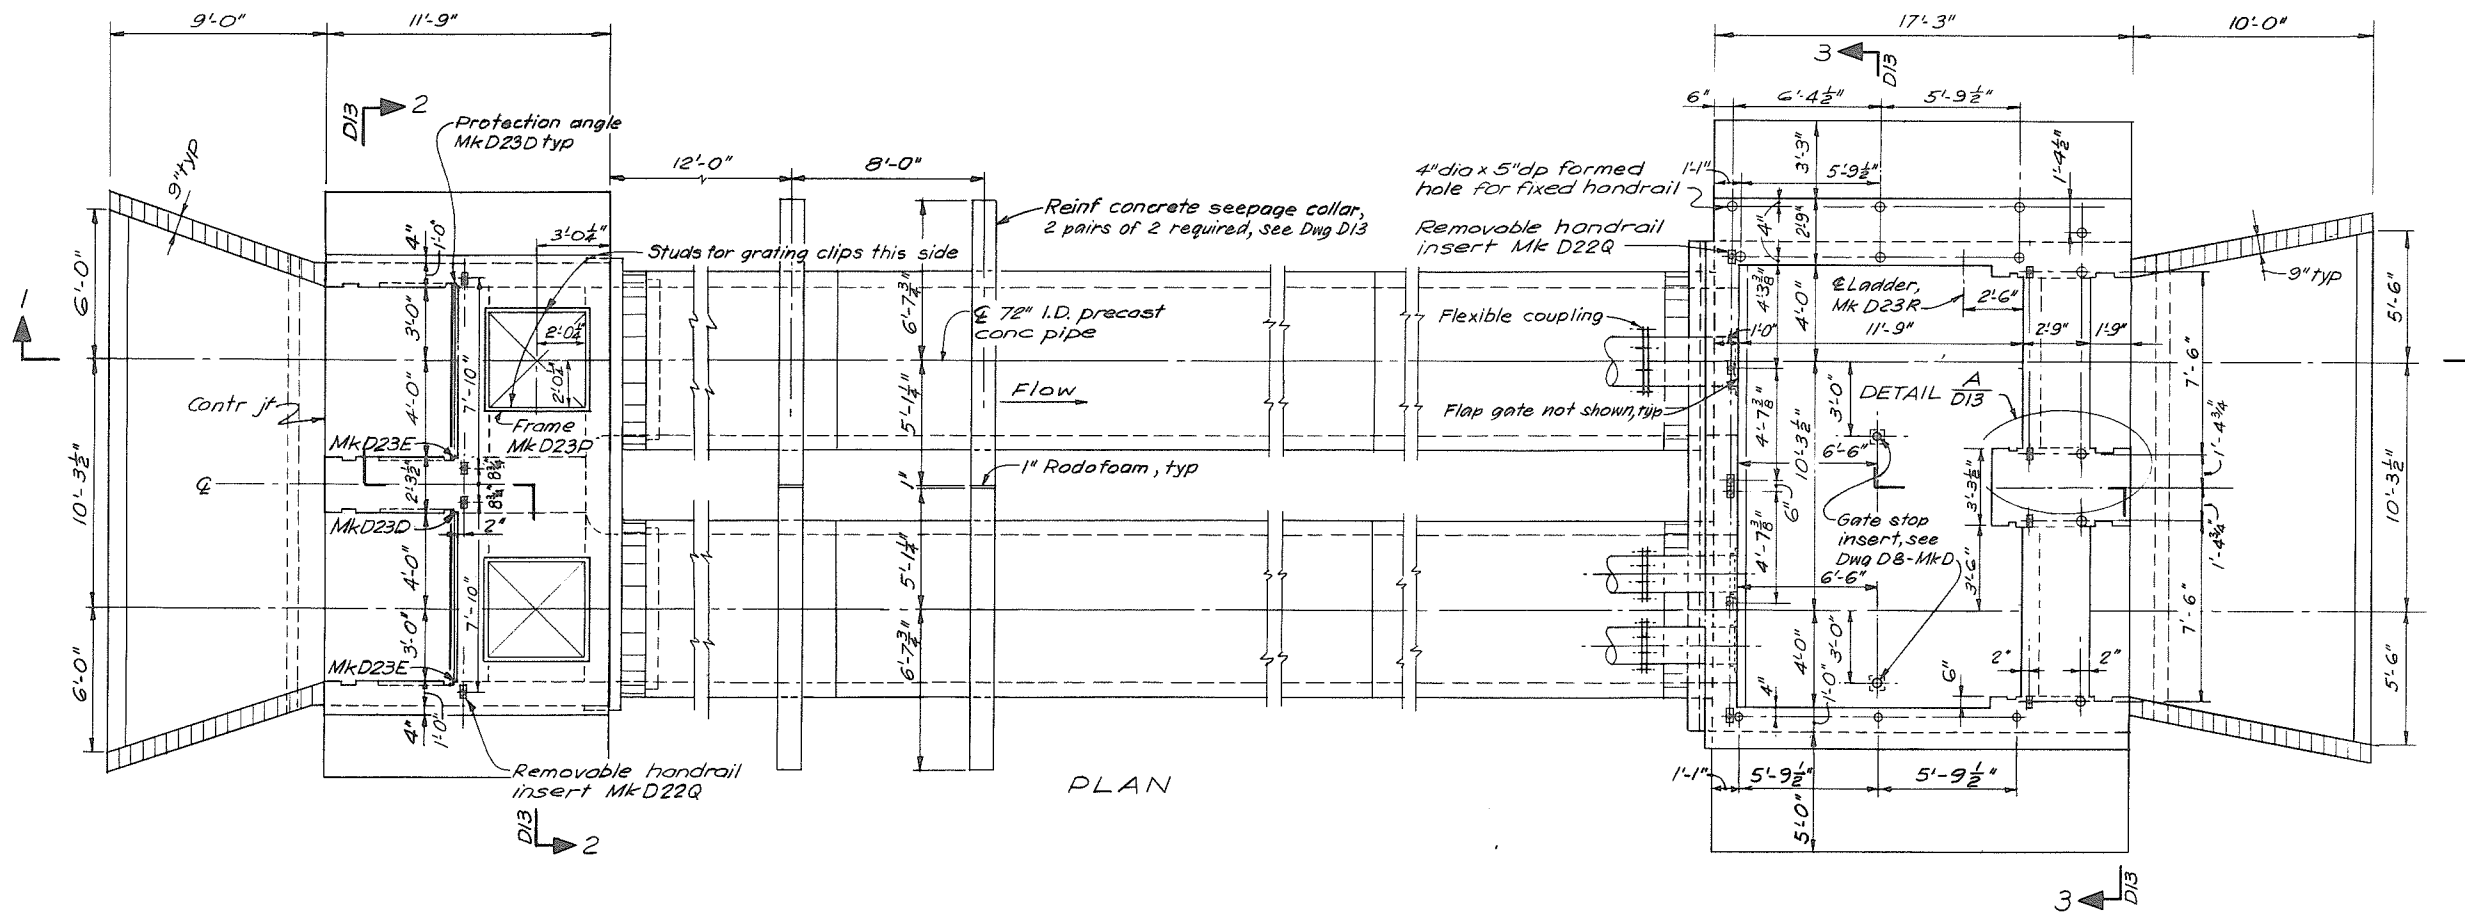


PLAN

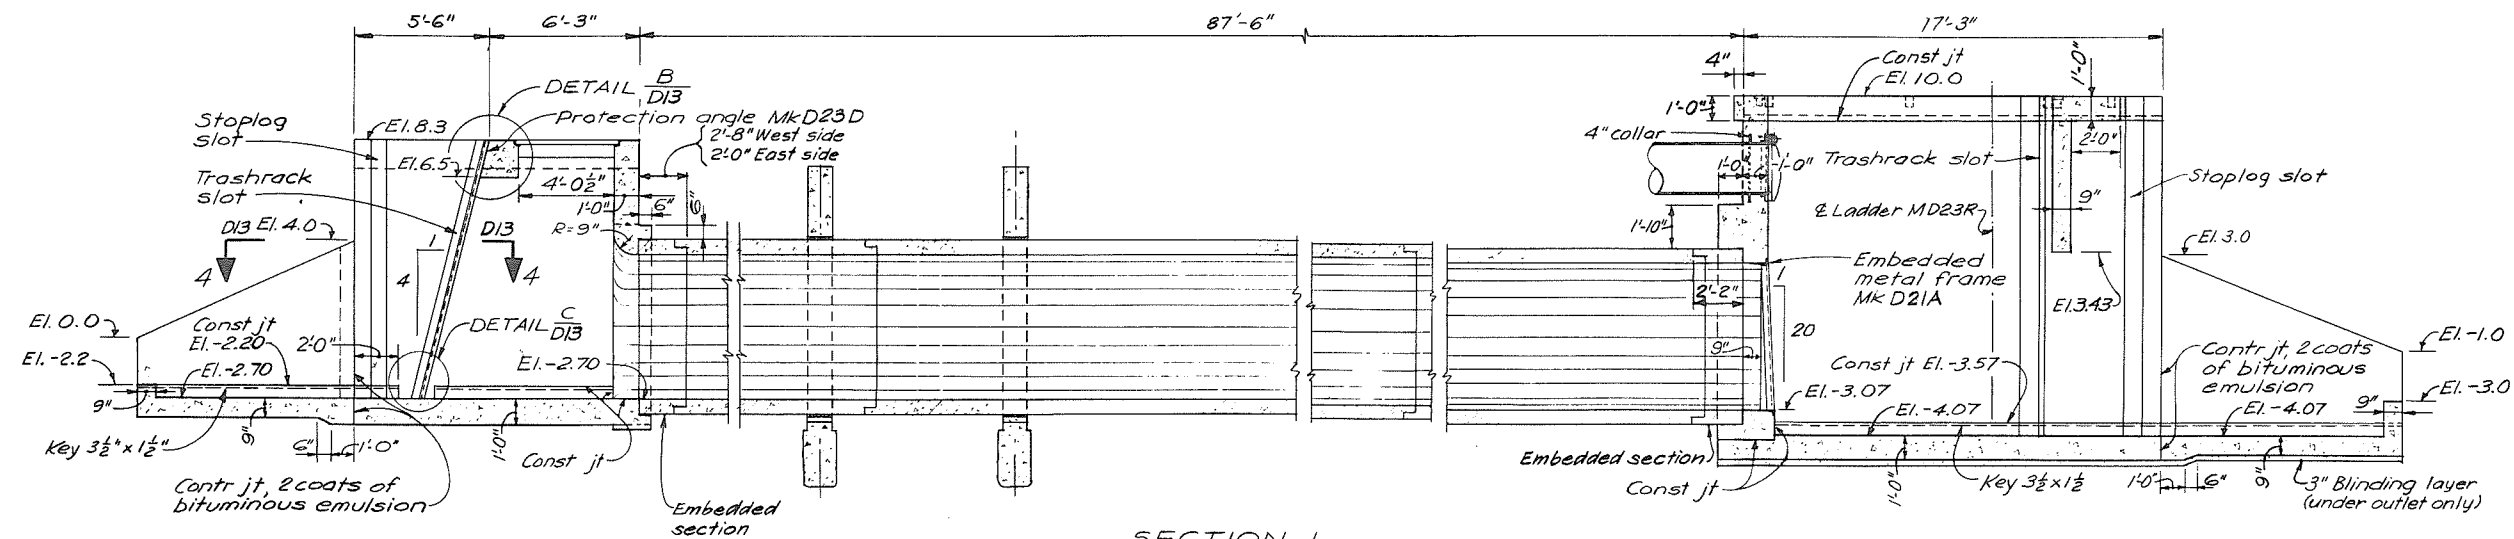

SECTION I

- NOTES**
- For reinforcement see Dwg D14 & D15.
 - Concrete:
 - Precast concrete culvert pipe see Dwg D9
 - 3" Blinding layer: Class III
 - Inlet & outlet: Class I
 - Seepage collar: Class I

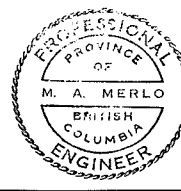

CRIPPEN ENGINEERING LTD.
 NORTH VANCOUVER, B.C.
 PROJECT NO. 10405

DEPARTMENT HEAD: *C.R. Bland*
 PROJECT ENGINEER: *M.A. Merlo*
 CHIEF ENGINEER: *J.P. ...*

2. Record Drawing
 APPROVED FOR CONSTRUCTION
 1. Prepared for Tender (Combined Contracts)

NO. _____ DESCRIPTION _____ REVISIONS _____

RECOMMENDED: *[Signature]*
 PROJECT MANAGER

DATE: June 6 1984


APPROVED: *[Signature]*
 DIRECTOR, WATER INVESTIGATIONS

DATE: June 6/84


BRITISH COLUMBIA
 MINISTRY OF THE ENVIRONMENT
 WATER INVESTIGATIONS BRANCH
 CANADA-BRITISH COLUMBIA
 FRASER RIVER FLOOD CONTROL 1968 AGREEMENT

PROJECT 10.4 CONTRACT NO. 2
**SOUTH WESTMINSTER FLOOD CONTROL WORKS
 PATTULLO FLOODBOX
 CONCRETE OUTLINE - PLAN AND SECTION**


| | |
|-------------------------|-------------------------|
| DESIGNED: <i>NAC Cm</i> | SURVEYED: |
| DRAWN: <i>MMW</i> | DATE: |
| CHECKED: <i>RSS</i> | FILE NO: 0281550-C12D-3 |
| SCALE: As shown | DATE: 14 Feb, 1979 |
| DWG. NO: 4884-3-D12R2 | SHEET 26 OF 43 SHEETS |

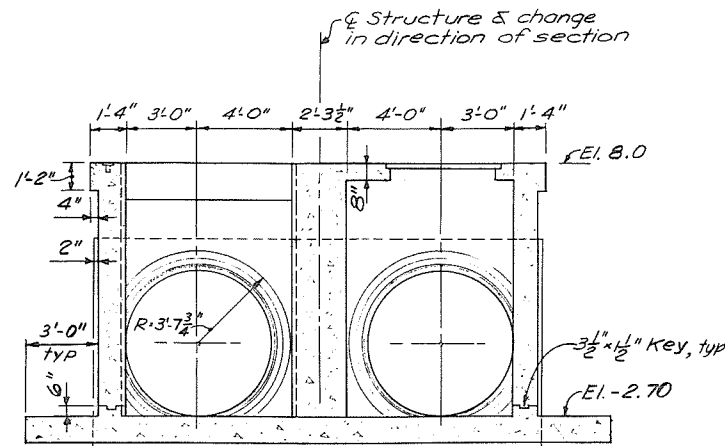


SECTION 2/D12
Scale A

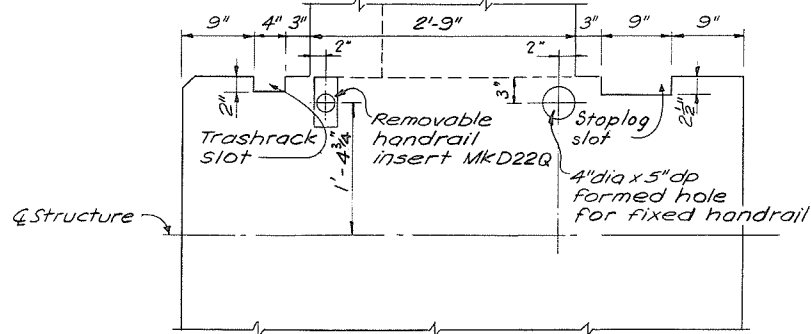


DETAIL A/D12 Shown
DETAIL D/D5 Similar, except for pier width & handrail holes & inserts

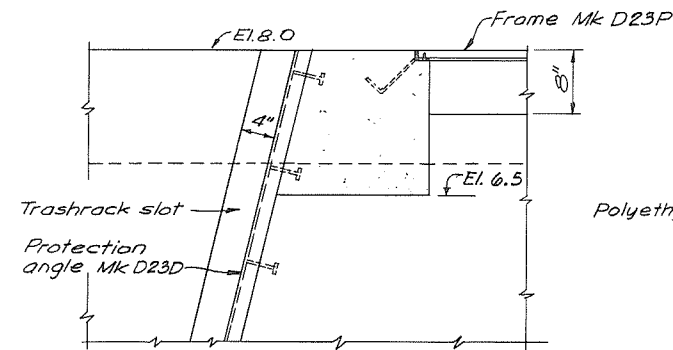


DETAIL B/D5, D12
Scale B

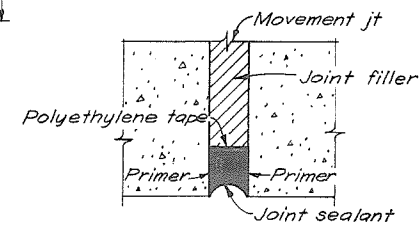


DETAIL F
NTS

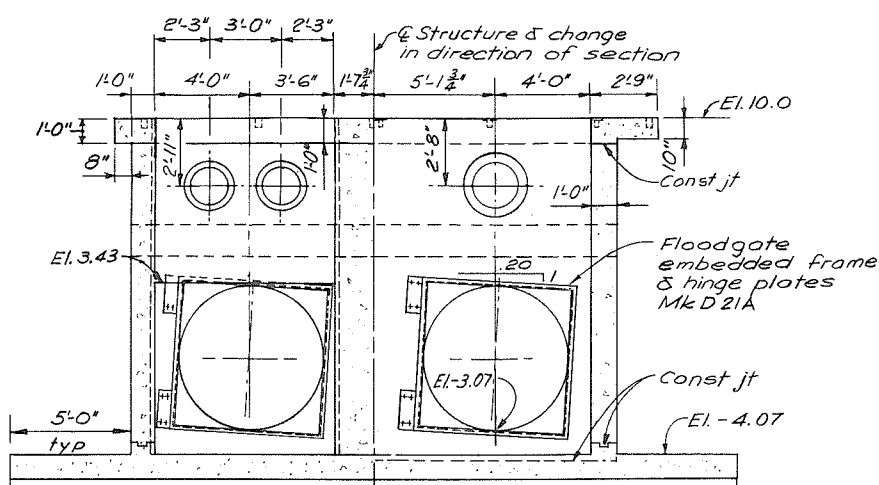


SECTION 3/D12
Scale A

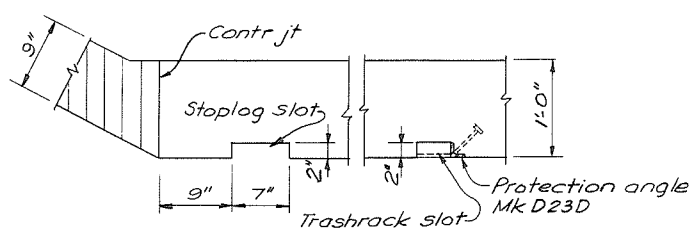

SECTION 4/D5, D12
Scale B

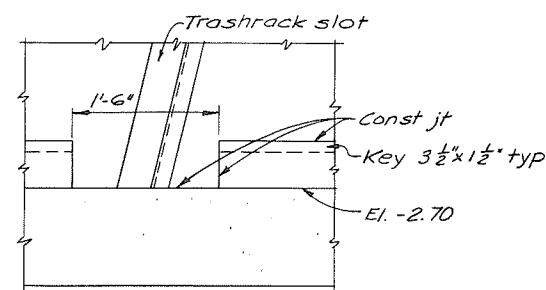


DETAIL C/D5, D12
Scale B

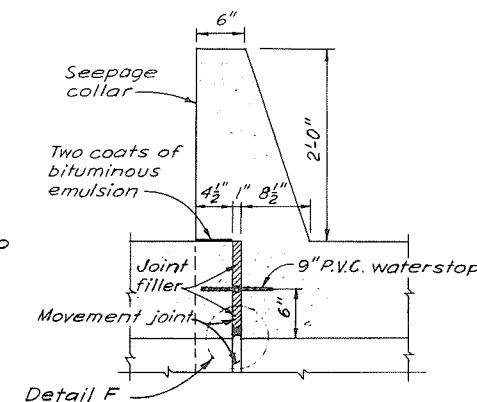


DETAIL E/D5
Typical for joints all round
Scale B

Bolts to be well greased & screwed fully into insert before placing concrete

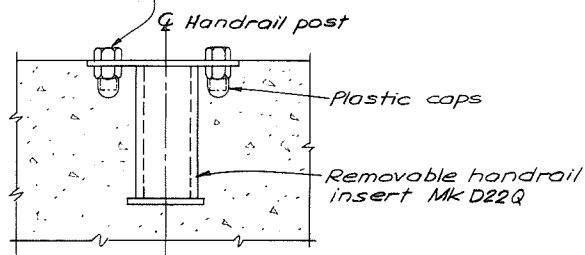



INSERT FOR REMOVABLE HANDRAIL
N.T.S.

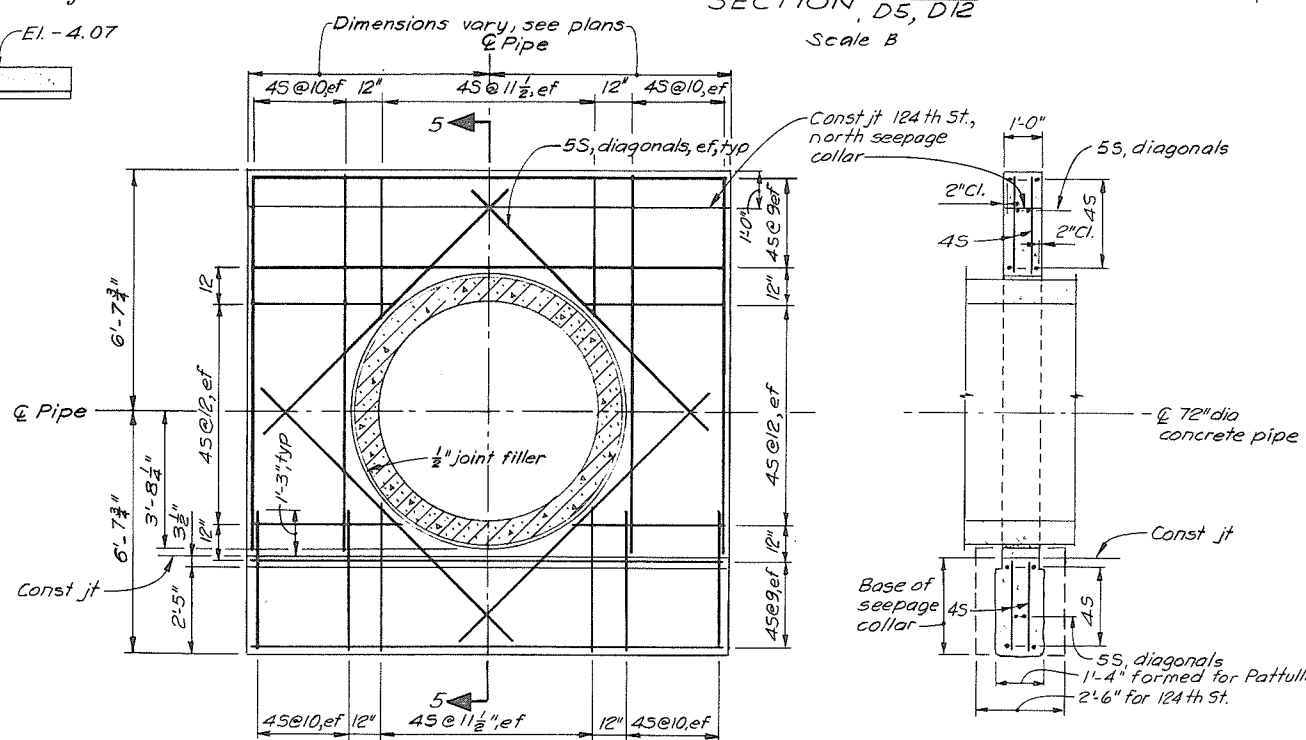

FLOODBOX SEEPAGE COLLAR
ef denotes each face; Cl. denotes clearance
Scale C

SECTION 5
Scale C

NOTE
1. For general notes see Dwg D12.

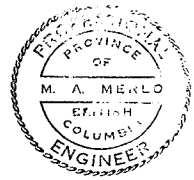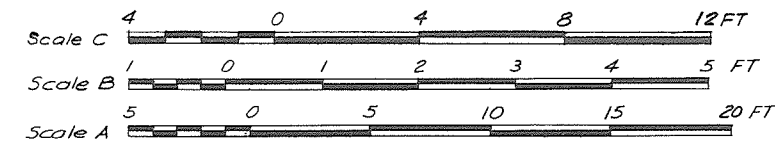

CRIPPEN ENGINEERING LTD.
NORTH VANCOUVER, B.C.
PROJECT NO. 10405

DEPARTMENT HEAD: CR Blad
PROJECT ENGINEER: M.A. Merlo
CHIEF ENGINEER: John S. [Signature]

2. Record Drawing
APPROVED FOR CONSTRUCTION JUL 25 84
1. Prepared for Tender (Combined Contracts)

NO. _____ DESCRIPTION _____ REVISIONS _____

BY: MP Jmm 3-9-85
CHD: [Signature] 5-4-84
APPR: [Signature] 5-4-84
DATE: [Signature] 6/84







RECOMMENDED [Signature] PROJECT MANAGER
DATE: June 6 1984
APPROVED: [Signature] DIRECTOR, WATER INVESTIGATIONS
DATE: [Signature] 6/84

BRITISH COLUMBIA
MINISTRY OF THE ENVIRONMENT
WATER INVESTIGATIONS BRANCH
CANADA - BRITISH COLUMBIA
FRASER RIVER FLOOD CONTROL 1968 AGREEMENT

PROJECT 10.4 CONTRACT NO. 2
SOUTH WESTMINSTER FLOOD CONTROL WORKS
PATTULLO FLOODBOX
CONCRETE OUTLINE - SECTIONS & DETAILS

DESIGNED: NAC [Signature]
DRAWN: [Signature]
CHECKED: RSS
SCALE: As shown
DWG. NO.: 4884-3-D13R2

SURVEYED: _____ DATE: _____
FILE NO.: 0281550-C12D-3
DATE: 14 Feb, 1979.
SHEET 27 OF 43 SHEETS

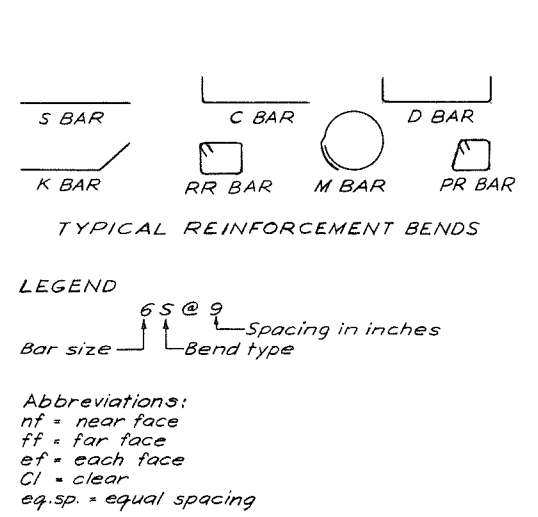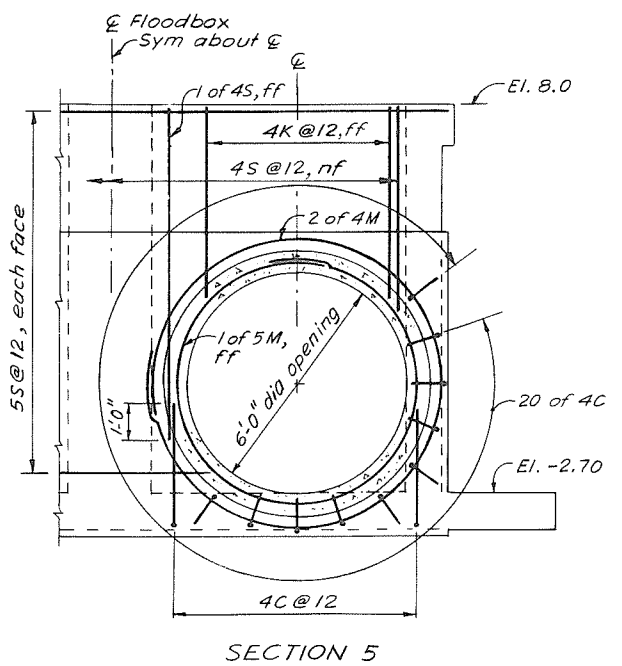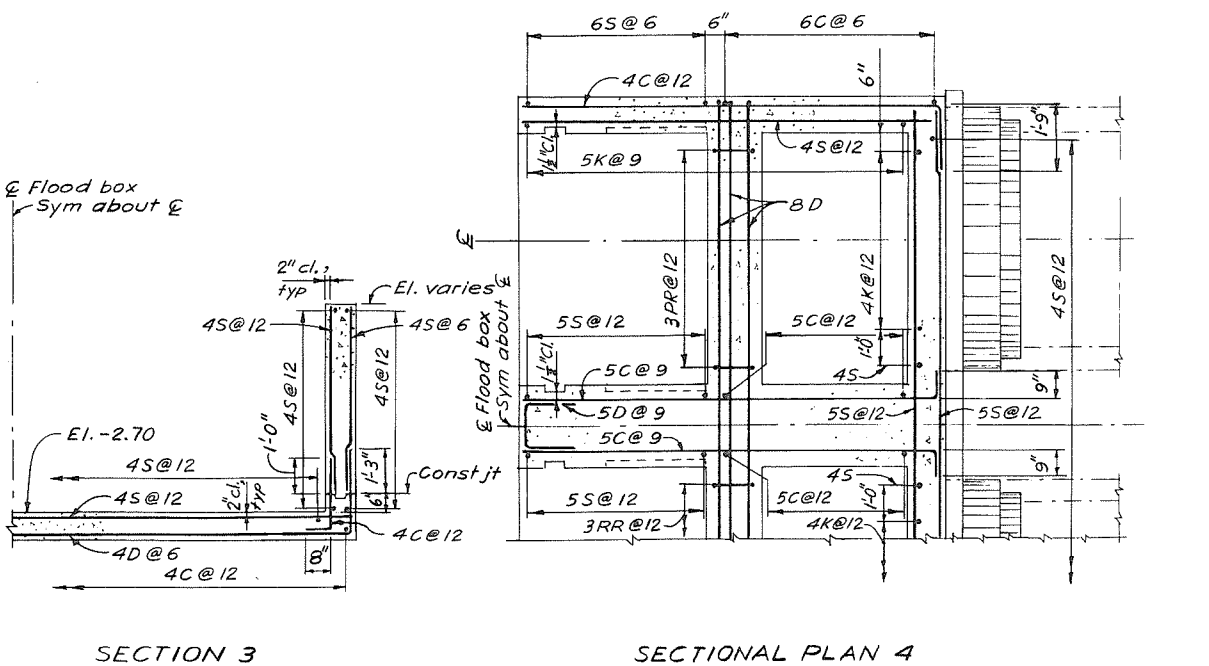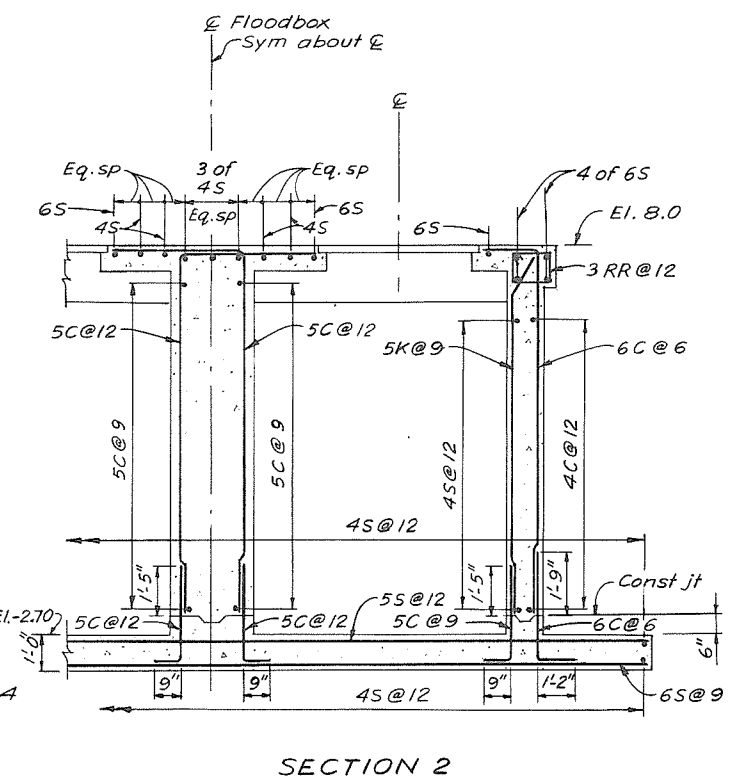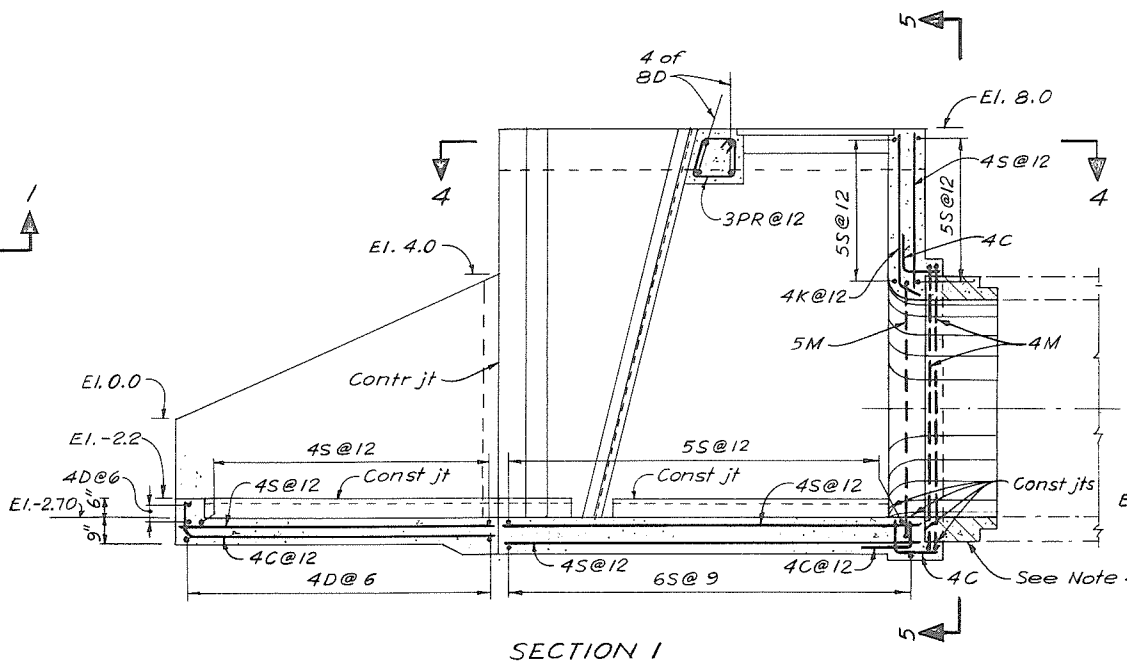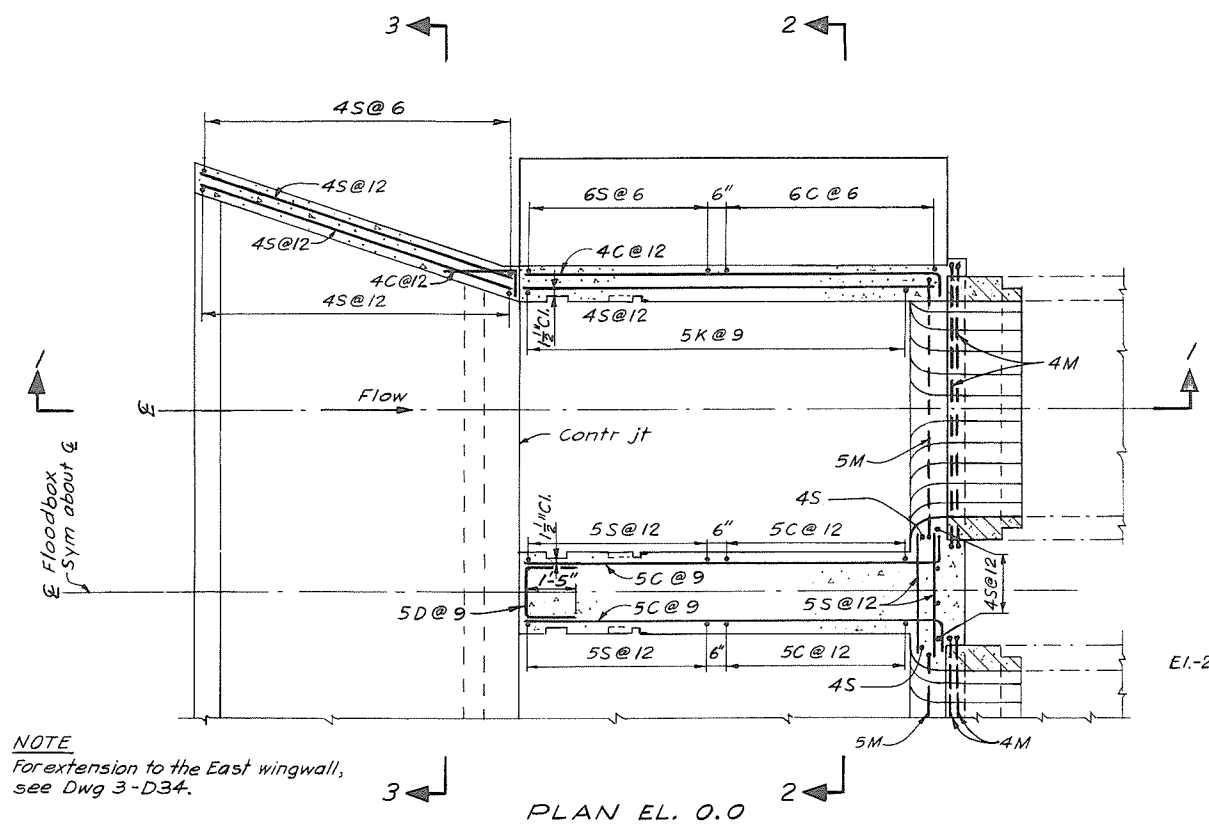

- NOTES
1. Reinforcement shown in sections to be symmetrical about \bar{C} unless otherwise shown.
 2. For concrete outline see Dwg D12 & D13.
 3. Concrete cover to reinforcement to be 2" in top slab and 3" elsewhere unless otherwise shown.
 4. Precast concrete 72" internal diameter culvert sections with exposed reinforcement to be embedded in in-situ inlet and outlet as shown.



CRIPPEN ENGINEERING LTD.
NORTH VANCOUVER, B.C.
PROJECT NO. 10405

DEPARTMENT HEAD: *[Signature]*

PROJECT ENGINEER: *[Signature]*

CHIEF ENGINEER: *[Signature]*

2. Record Drawing
APPROVED FOR CONSTRUCTION JUL 23 84

1. Prepared for Tender (Combined Contracts)

| NO. | DESCRIPTION | BY | CHK | APPR | DATE |
|-----|-------------|----|-----|------|------|
| | | | | | |

RECOMMENDED: *[Signature]* PROJECT MANAGER

DATE: June 6, 1984

APPROVED: *[Signature]* DIRECTOR, WATER INVESTIGATIONS





DATE: June 6/84

BRITISH COLUMBIA
MINISTRY OF THE ENVIRONMENT
WATER INVESTIGATIONS BRANCH
CANADA - BRITISH COLUMBIA



FRASER RIVER FLOOD CONTROL 1968 AGREEMENT

PROJECT 10.4 CONTRACT NO. 2
SOUTH WESTMINSTER FLOOD CONTROL WORKS
PATTULLO FLOODBOX
INLET REINFORCEMENT

| | |
|------------------------------|-------------------------|
| DESIGNED: <i>[Signature]</i> | SURVEYED: |
| DRAWN: S.K.C. | DATE: |
| CHECKED: RSS | FILE NO: 0281550-C12D-3 |
| SCALE: As shown | DATE: 14 Feb, 1979 |
| DWG. NO: 4884-3-D14R2 | SHEET 28 OF 43 SHEETS |

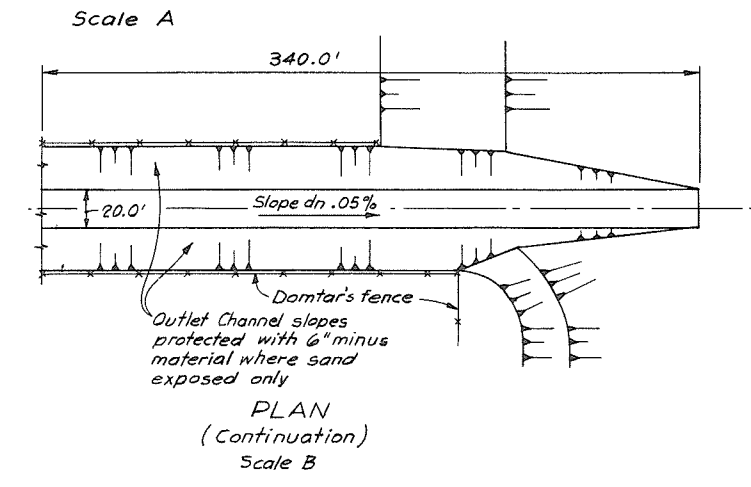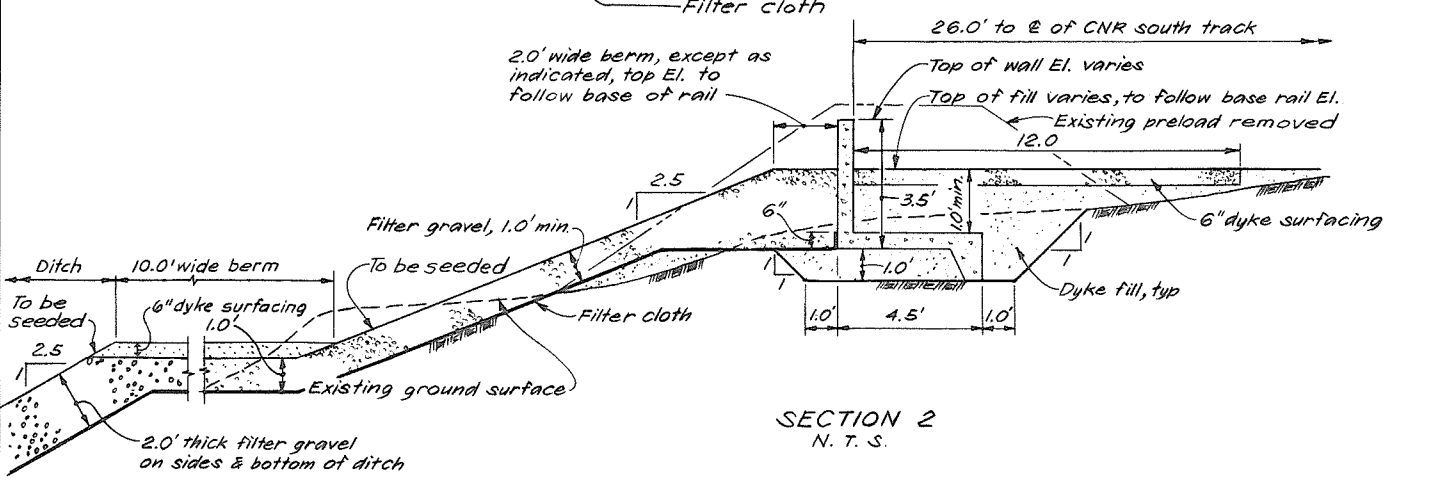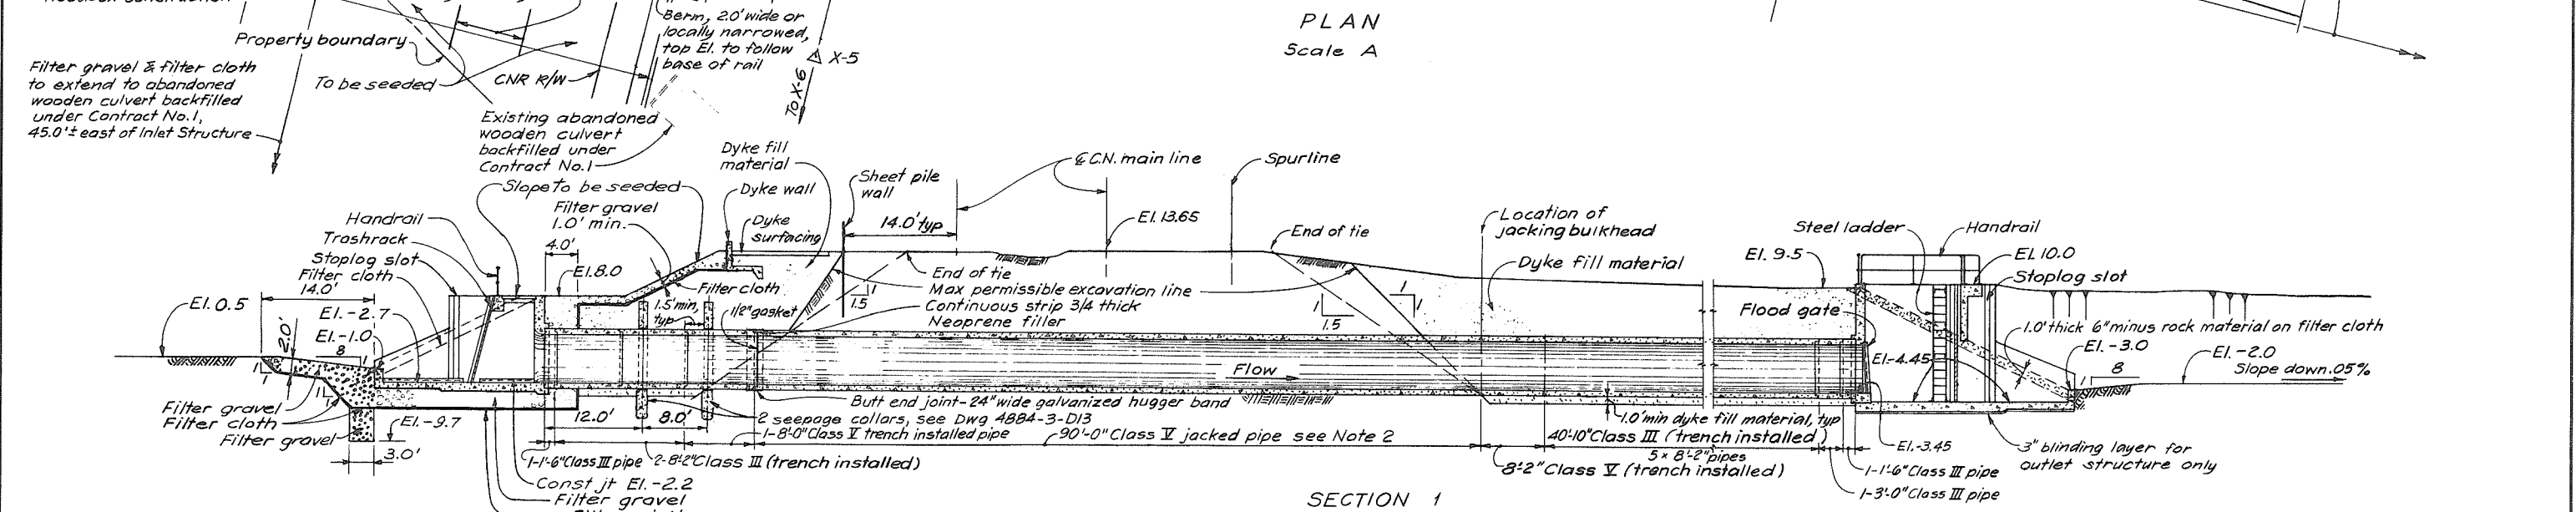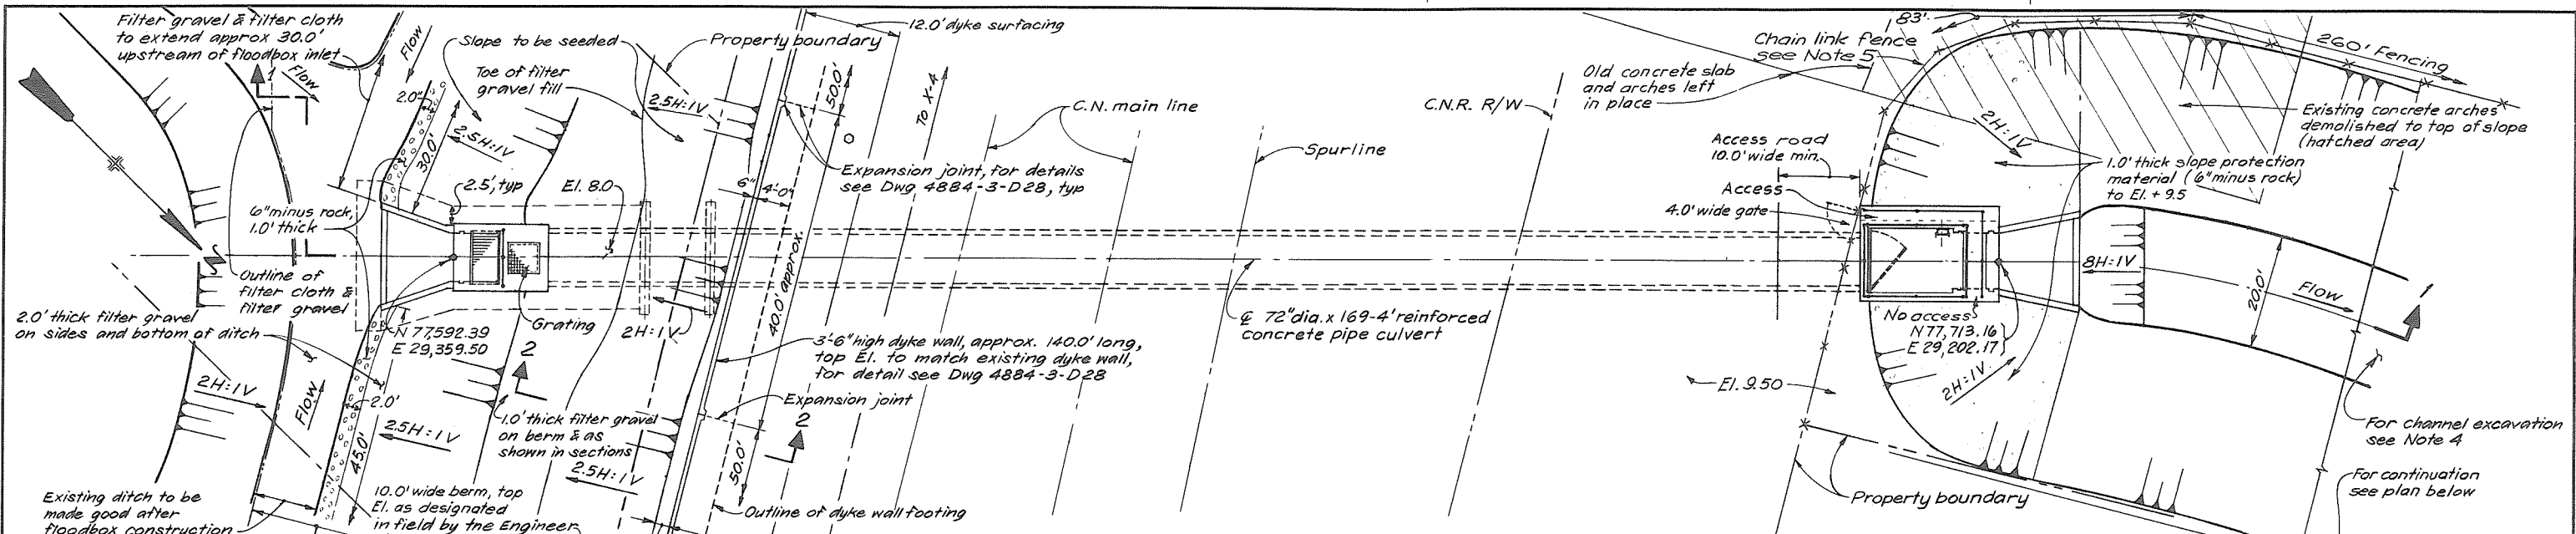

- NOTES:**
- Elevations are to Geodetic Datum in feet.
 - Exact length of jacked pipe designated in the field by the Engineer.
 - Waterstop protection removed and dowels inserted into existing wall prior to new dyke wall construction.
 - Outlet channel extended at slope shown to meet Fraser River, approx. 340ft.
 - Frost Steel & Wire Co. Ltd. standard chain link security fence, height 6'-6" (2.0m) topped with three strands of barbed wire, with gate.

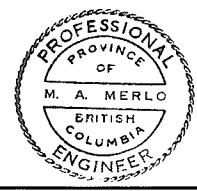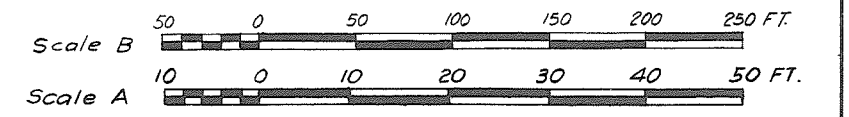

CRIPPEN ENGINEERING LTD.
NORTH VANCOUVER, B.C.
PROJECT NO. 10405

DEPARTMENT HEAD: C.R. Blair
PROJECT ENGINEER: M.A. Merlo
CHIEF ENGINEER: John S. Kibben

3. Record Drawing
APPROVED FOR CONSTRUCTION

2. Chain link fence added.
1. Prepared for Tender (Combined Contracts).

| NO. | DESCRIPTION | BY | CHKD | APPR | DATE |
|-----|-------------|-----|------|------|---------|
| 1 | | MP | JM | | 22-1-85 |
| 2 | | AW | FRS | | 13-7-84 |
| 3 | | FRS | | | 5-6-84 |

RECOMMENDED: *[Signature]*
PROJECT MANAGER

DATE: June 6 1984


APPROVED: *[Signature]*
DIRECTOR, WATER INVESTIGATIONS

DATE: June 6/84


BRITISH COLUMBIA
MINISTRY OF THE ENVIRONMENT
WATER INVESTIGATIONS BRANCH
CANADA-BRITISH COLUMBIA
FRASER RIVER FLOOD CONTROL 1988 AGREEMENT

PROJECT 10.4 CONTRACT NO. 2
SOUTH WESTMINSTER FLOOD CONTROL WORKS
124TH STREET FLOODBOX
GENERAL ARRANGEMENT

| | |
|------------------------|-------------------------|
| DESIGNED: N.A. Connell | SURVEYED: W.S. & M.R. |
| DRAWN: H.N.C. | DATE: May, 1978 |
| CHECKED: R.D., LVS | FILE NO: 0281550-C12D-3 |
| SCALE: As shown | DATE: 14 Feb, 1979. |
| DWG. NO: 4884-3-D16R3 | SHEET 30 OF 43 SHEETS |


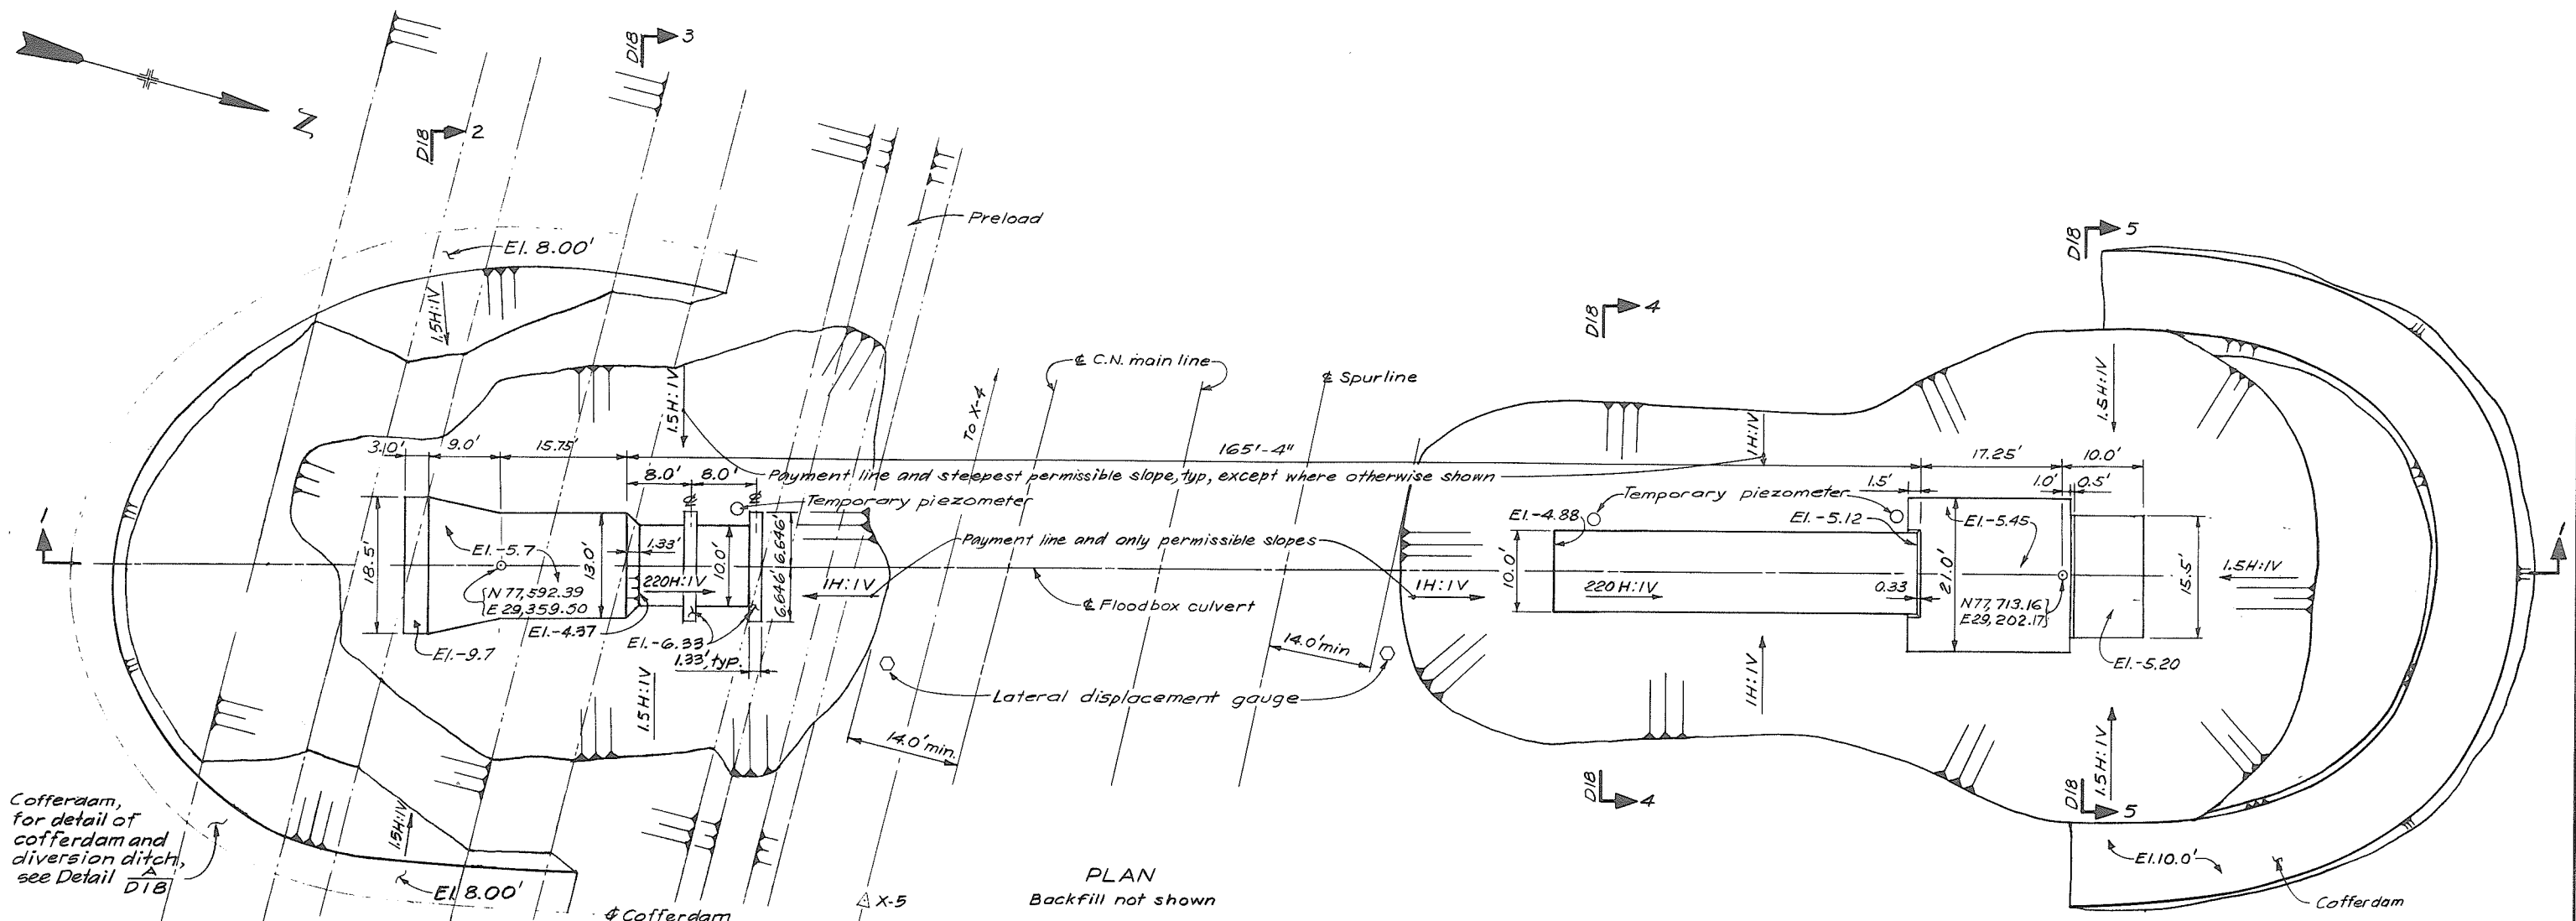


PLAN
Backfill not shown

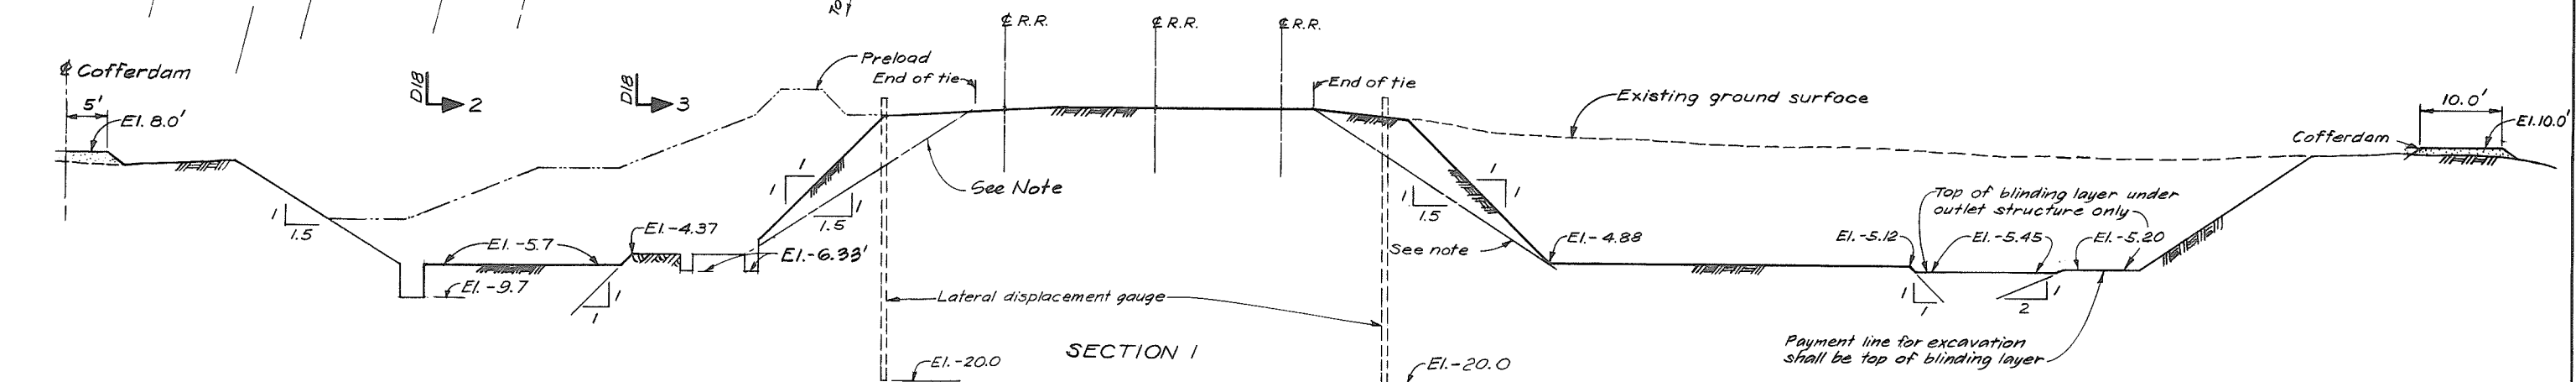

SECTION I

NOTE
• For location of drain diversion and cofferdams see Dwg 4884-3-D18.

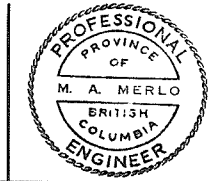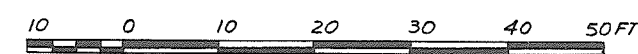







CRIPPEN ENGINEERING LTD.
NORTH VANCOUVER, B.C.
PROJECT NO. 10405
DEPARTMENT HEAD: C.R. Black
PROJECT ENGINEER: [Signature]
CHIEF ENGINEER: John S. Wilson

2. Record Drawing
APPROVED FOR CONSTRUCTION JUL 25 84
1. Prepared for Tender (Combined Contracts)
NO. DESCRIPTION REVISIONS
BY CHD APPR DATE


RECOMMENDED [Signature]
PROJECT MANAGER
DATE: June 6 1984
APPROVED [Signature]
DIRECTOR, WATER INVESTIGATIONS
DATE: Jun 6/84

BRITISH COLUMBIA
MINISTRY OF THE ENVIRONMENT
WATER INVESTIGATIONS BRANCH
CANADA-BRITISH COLUMBIA
FRASER RIVER FLOOD CONTROL 1968 AGREEMENT
PROJECT 10.4 CONTRACT NO. 2
SOUTH WESTMINSTER FLOOD CONTROL WORKS
124TH STREET FLOODBOX
EXCAVATION & BACKFILL - SHEET 1 OF 2

DESIGNED: NMe
DRAWN: SK
CHECKED: [Signature], LVS
SCALE: As shown
DWG. NO.: 4884-3-D17 R2
SURVEYED: W.S. & M.R.
DATE: May, 1978.
FILE NO.: 0281550-C12D-3
DATE: 14 Feb, 1979.
SHEET 31 OF 43 SHEETS

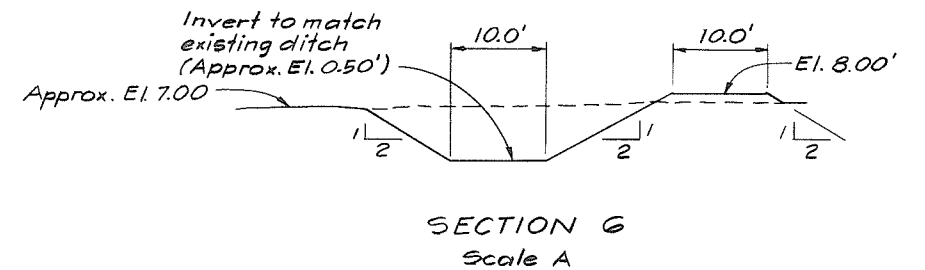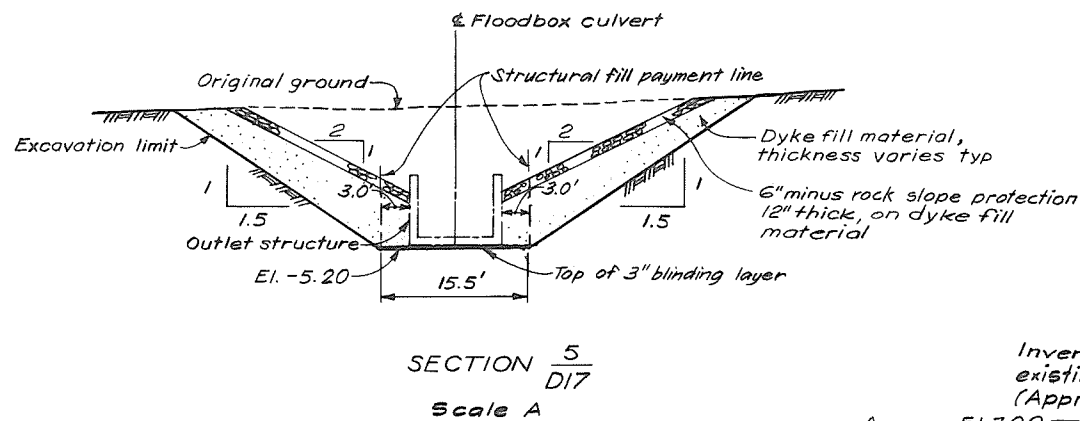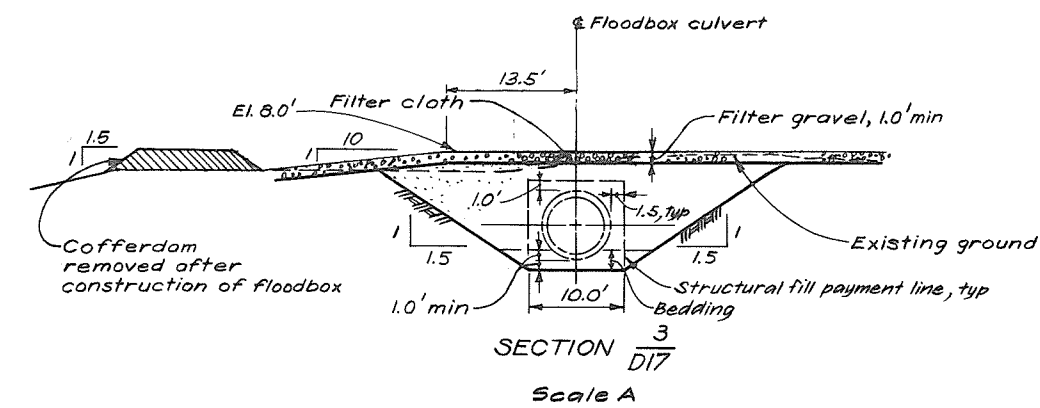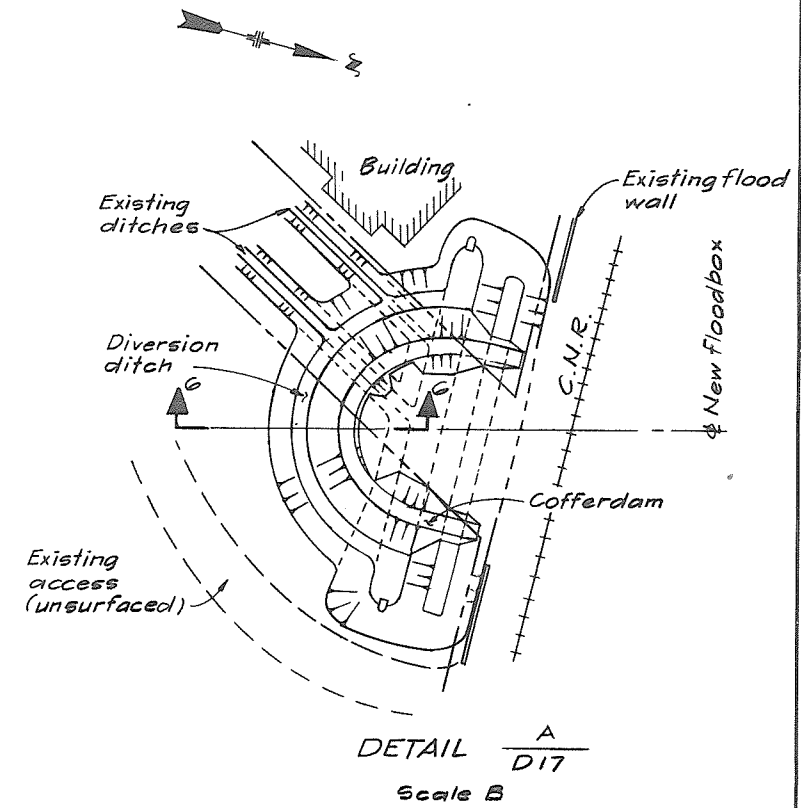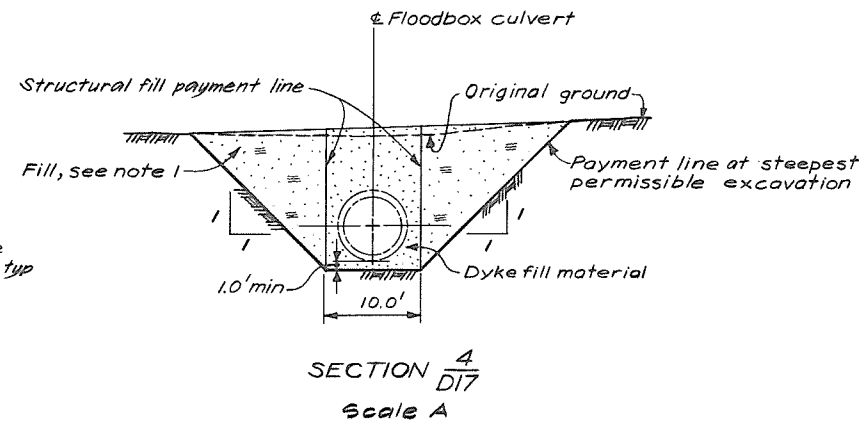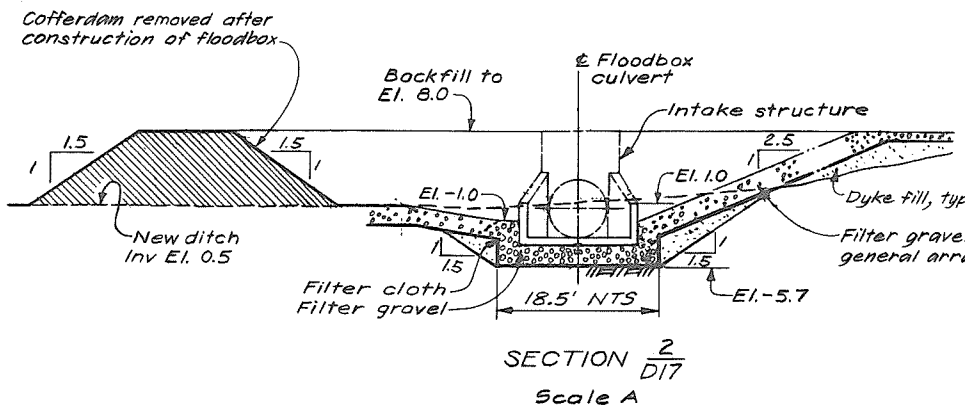

NOTE
 1. North of the CNR right of way the culvert was backfilled with dyke fill material in the 10.0' wide prism shown in Section 4; backfill either side of this prism was material originally excavated.

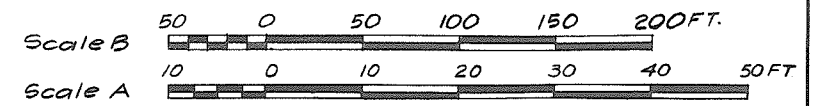










CRIPPEN ENGINEERING LTD.
 NORTH VANCOUVER, B.C.
 PROJECT NO. 10405
 DEPARTMENT HEAD: C.R. Blair
 PROJECT ENGINEER: M.A. Merlo
 CHIEF ENGINEER: John S. ...

| NO. | DESCRIPTION | BY | CHKD | APPR | DATE |
|-----|--|---------|------|------|---------|
| 2 | Record Drawing | MAN/jm | | | 5-11-85 |
| 1 | Prepared for Tender (Combined Contracts) | FRS/... | | | 5-6-84 |

RECOMMENDED: *[Signature]*
 PROJECT MANAGER
 DATE: June 6 1984.
 APPROVED: *[Signature]*
 DIRECTOR, WATER INVESTIGATIONS
 DATE: June 6/84



BRITISH COLUMBIA
 MINISTRY OF THE ENVIRONMENT
 WATER INVESTIGATIONS BRANCH
 CANADA-BRITISH COLUMBIA
 FRASER RIVER FLOOD CONTROL 1968 AGREEMENT
 PROJECT 10.4 CONTRACT NO. 2
SOUTH WESTMINSTER FLOOD CONTROL WORKS
124 TH STREET FLOODBOX
 EXCAVATION & BACKFILL - SHEET 2 OF 2

| | |
|------------------------|--------------------------|
| DESIGNED: NAC | SURVEYED: |
| DRAWN: S K | DATE: |
| CHECKED: R.D., LVS | FILE NO.: 0281550-C12D-3 |
| SCALE: As shown | DATE: 14 Feb, 1979. |
| DWG. NO.: 4884-3-D18R2 | SHEET 32 OF 43 SHEETS |

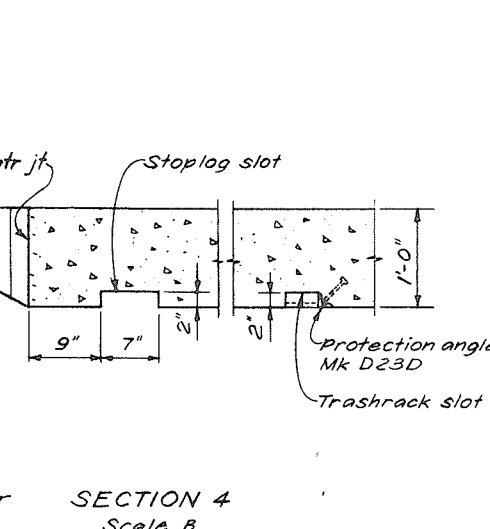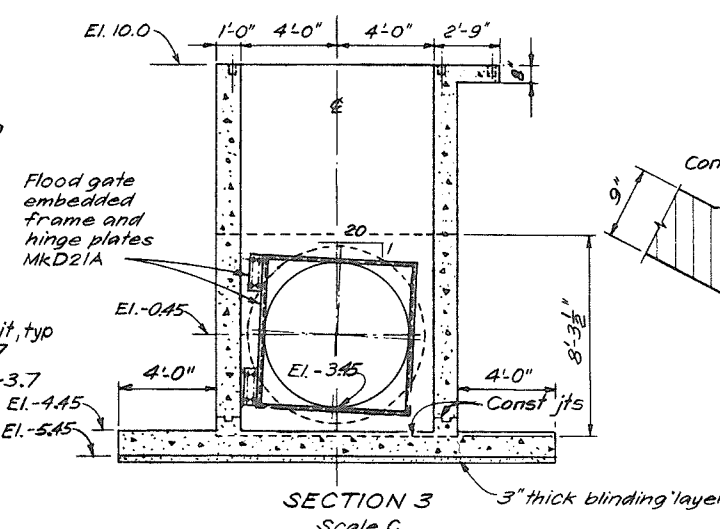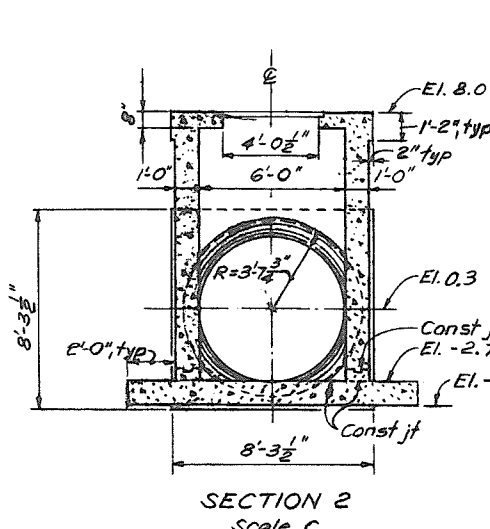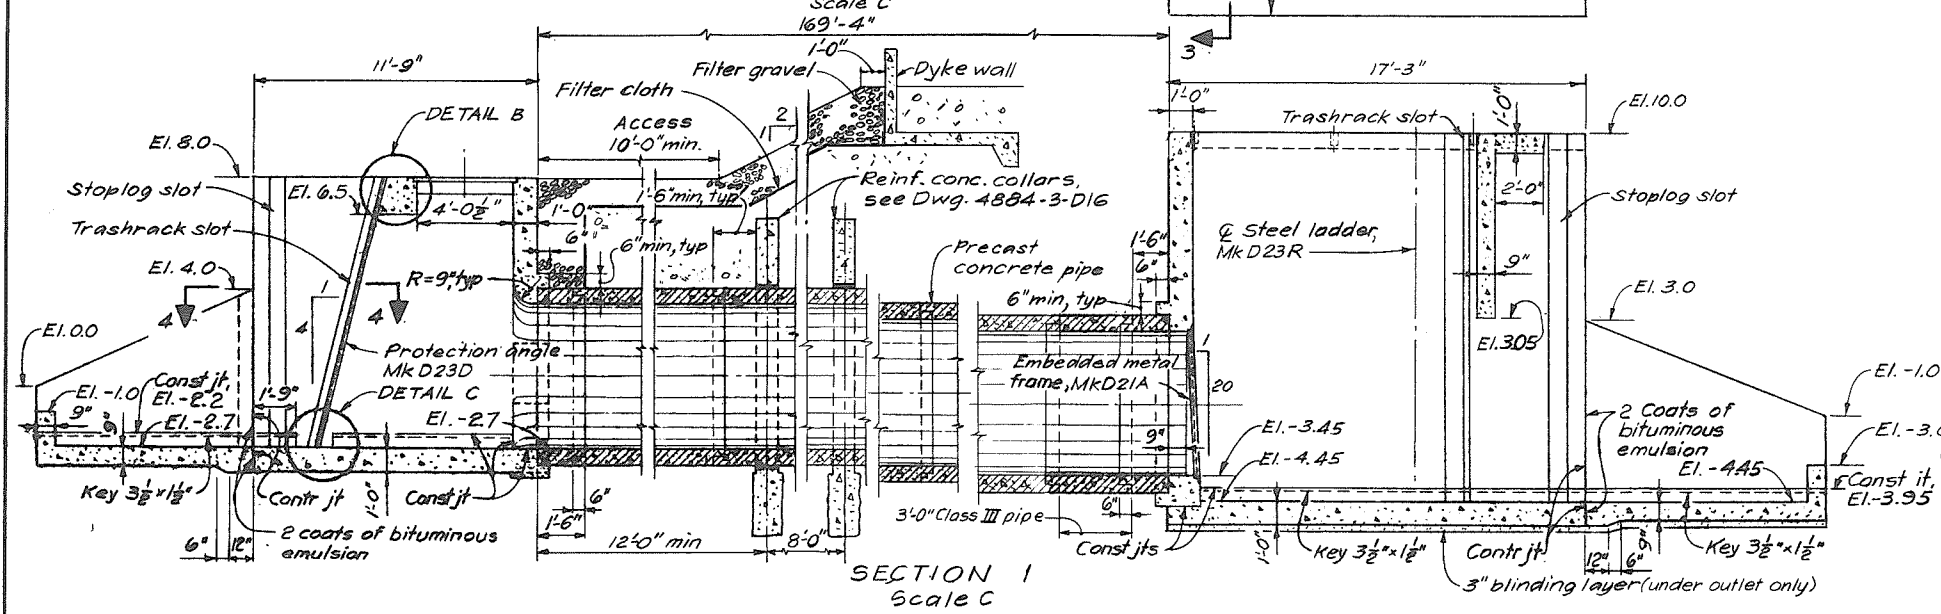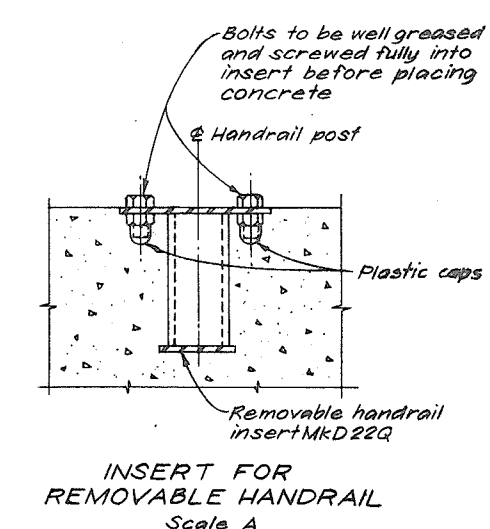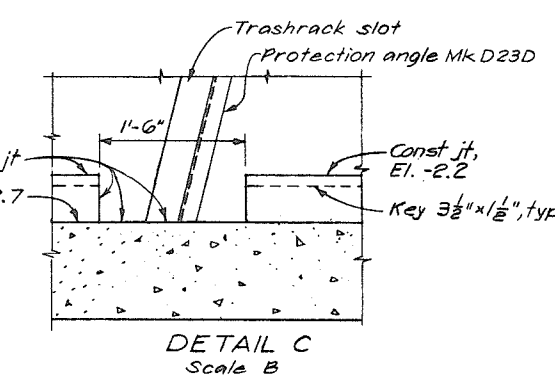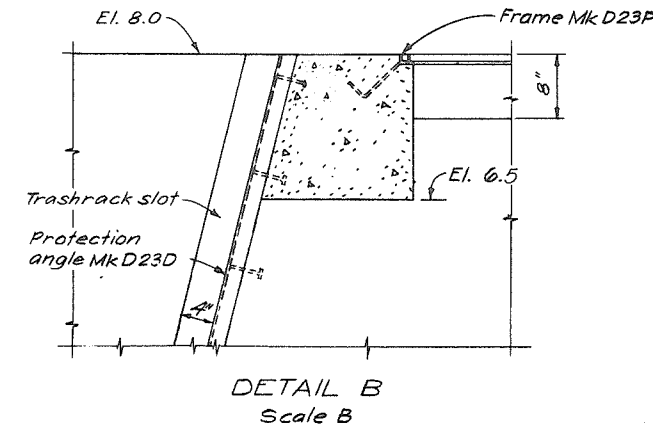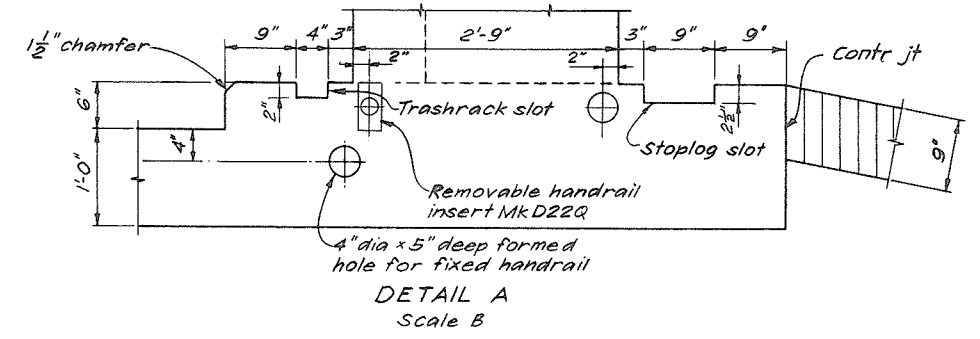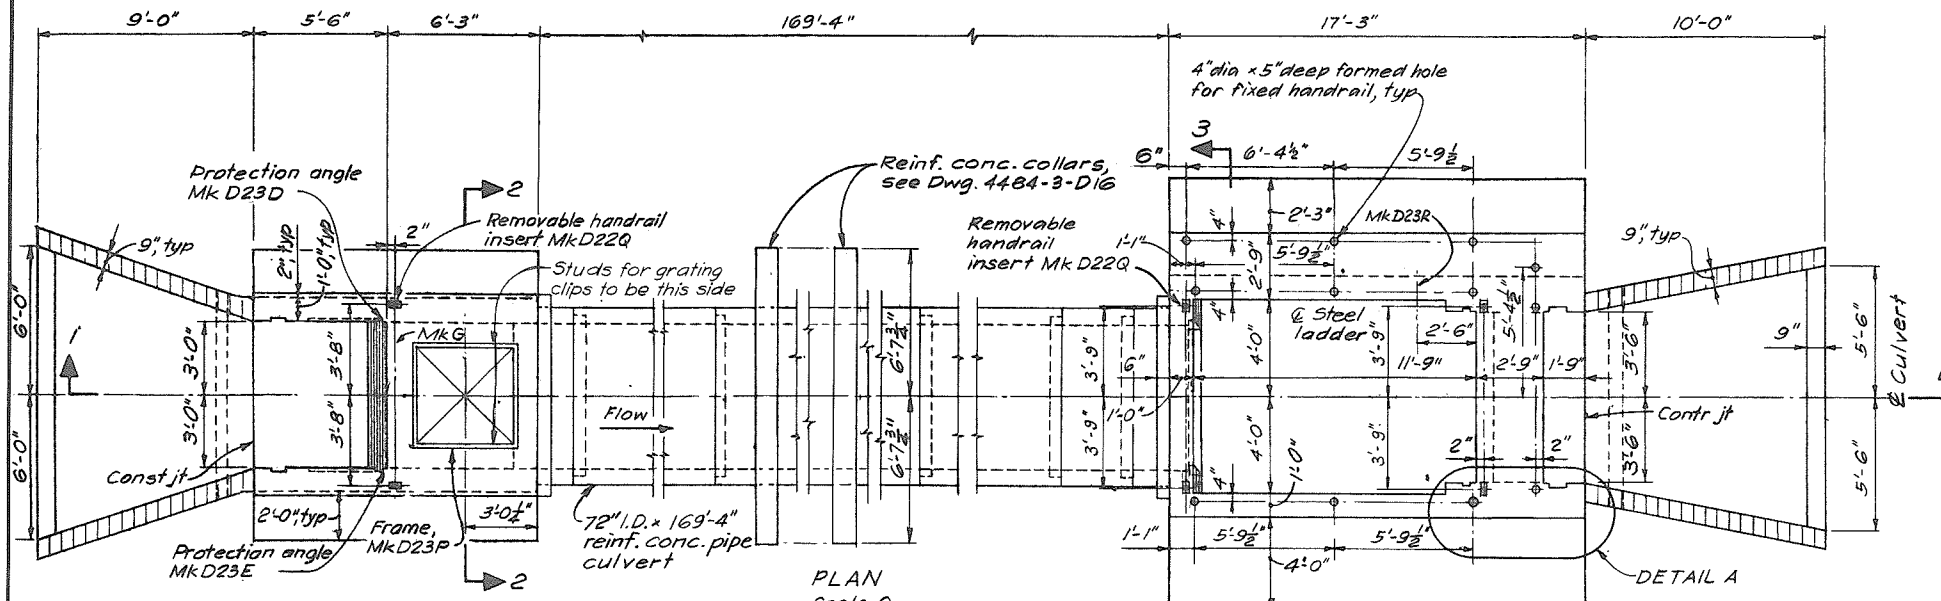

NOTE ON DESIGN
 Design adapted from 4884-1-D13
 By NAC
 Checked MAM
 Original design by C.M., checked by ZBS
 June 1978

NOTES
 1. For reinforcement see Dwg D20
 2. Concrete shall be Class 1.
 3. Precast concrete 72" internal diameter culvert sections with exposed reinforcement was embedded in in-situ inlet and outlet as shown.

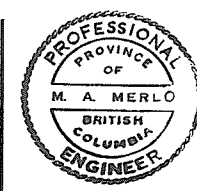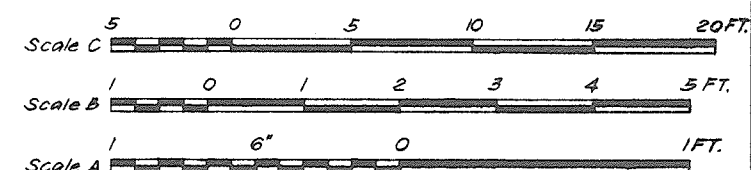

CRIPPEN ENGINEERING LTD.
 NORTH VANCOUVER, B.C.
 PROJECT NO. 10405
 DEPARTMENT HEAD: C.R. Bland
 PROJECT ENGINEER: [Signature]
 CHIEF ENGINEER: [Signature]


2. Record Drawing Approved for Construction
 1. Prepared for Tender (Combined Contracts)

| NO. | DESCRIPTION | BY | CHKD | APPR | DATE |
|-----|-------------|----|------|------|------|
| | | | | | |


RECOMMENDED [Signature]
 PROJECT-MANAGER
 DATE: June 6 1984
 APPROVED: [Signature]
 DIRECTOR, WATER INVESTIGATIONS
 DATE: [Signature]

BRITISH COLUMBIA
 MINISTRY OF THE ENVIRONMENT
 WATER INVESTIGATIONS BRANCH
 CANADA - BRITISH COLUMBIA
 FRASER RIVER FLOOD CONTROL 1968 AGREEMENT
 PROJECT 10.4 CONTRACT NO. 2
 SOUTH WESTMINSTER FLOOD CONTROL WORKS
 124TH STREET FLOODBOX
 CONCRETE OUTLINE


| | |
|------------------------------|-------------------------|
| DESIGNED: See Note On Design | SURVEYED: |
| DRAWN: FL MNC. | DATE: |
| CHECKED: See note | FILE NO. 0281550-C12D-3 |
| SCALE: As shown | DATE: 14 Feb, 1979 |
| DWG. NO. 4884-3-D19 R2 | SHEET 33 OF 43 SHEETS |

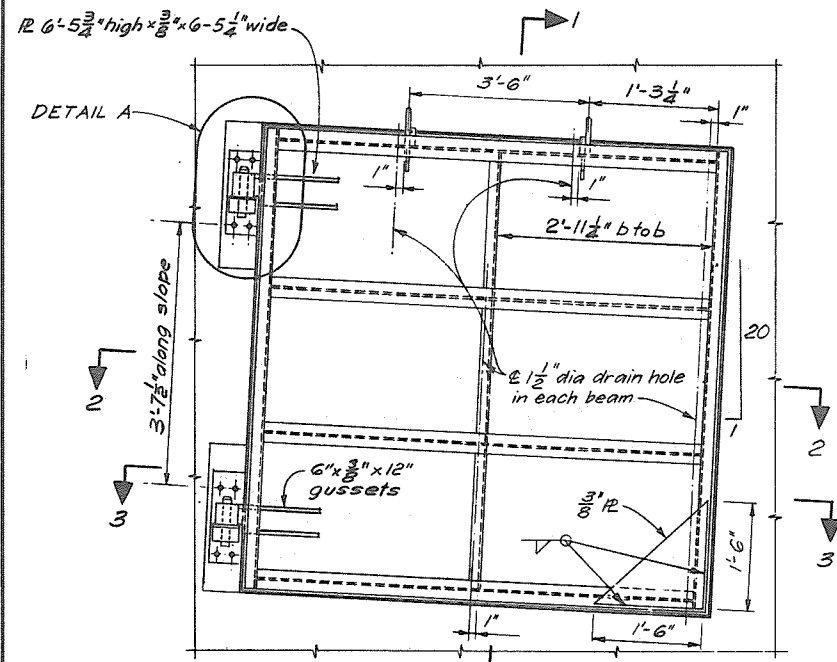


ELEVATION - FLOODGATE
Mk A - 3 required
Scale A

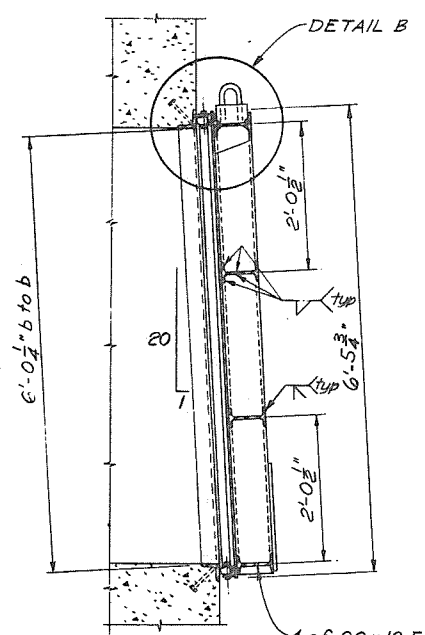


SECTION I
Scale A

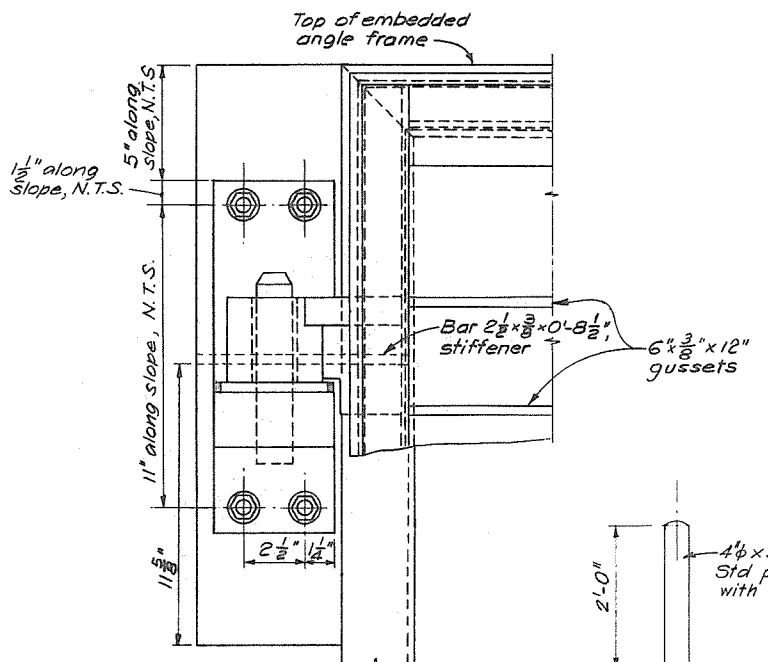


DETAIL A
Scale B

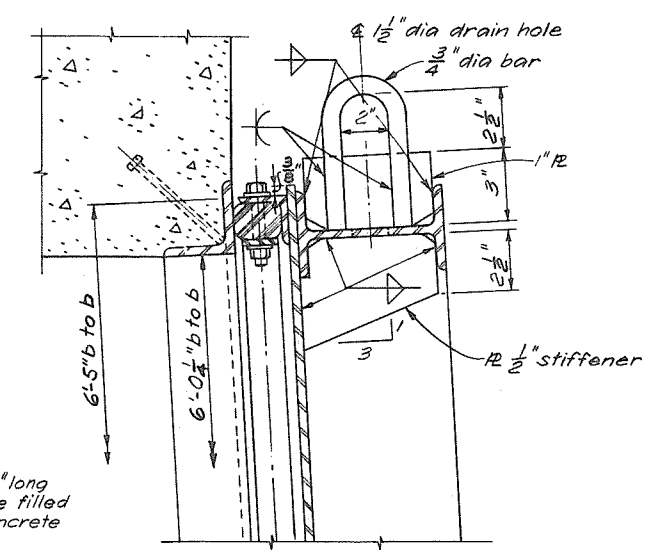


DETAIL B
Scale B

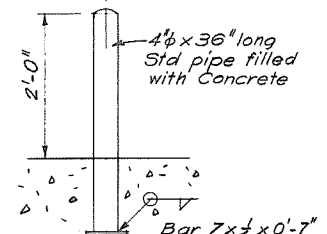


GATE STOP
Scale A
Mark B, 2 req'd for Pattullo Floodbox only

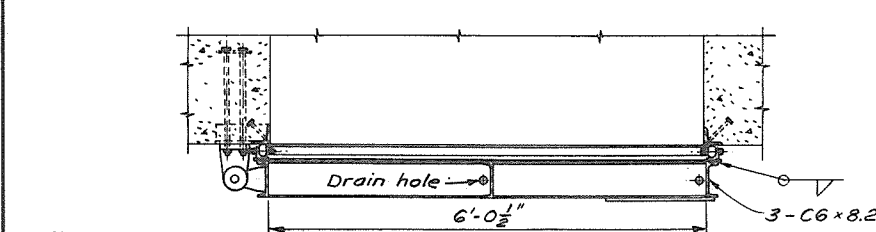


SECTION 2
Scale A

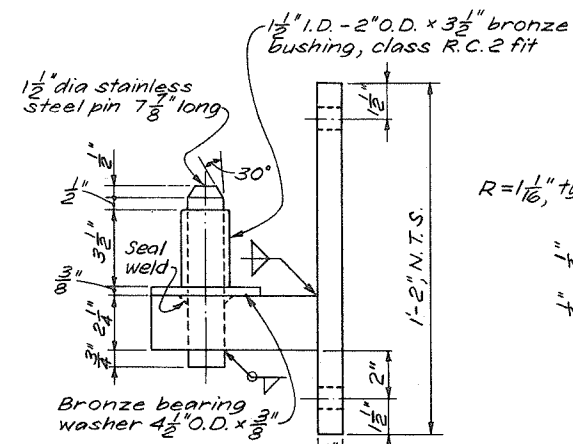


ELEVATION

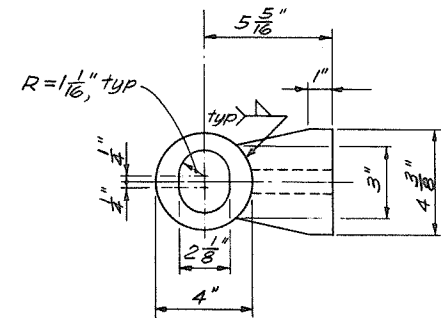


PLAN

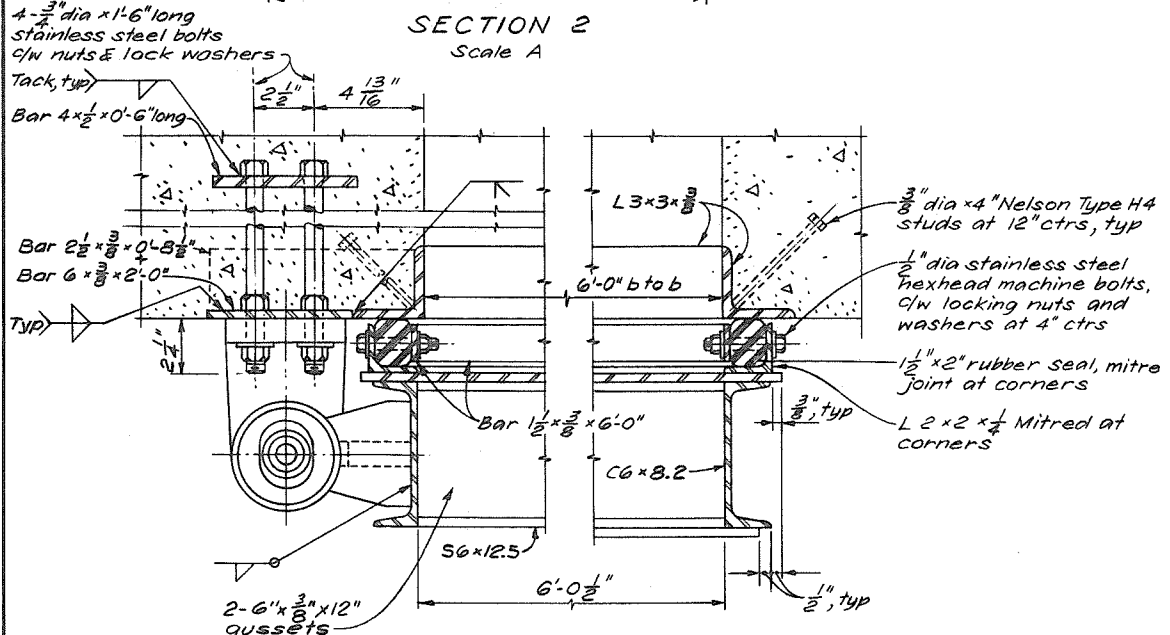


SECTION 3
Scale B

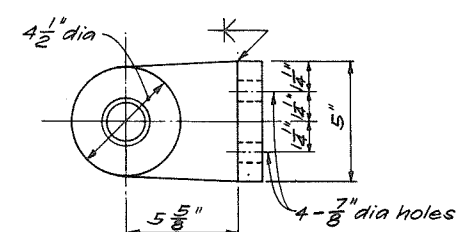


PLAN HINGE PINTLE
Scale B

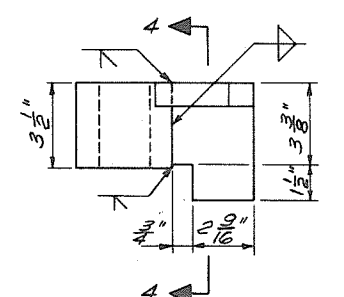

ELEVATION HINGE BRACKET
Scale B

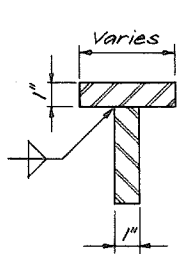

SECTION 4
Scale B

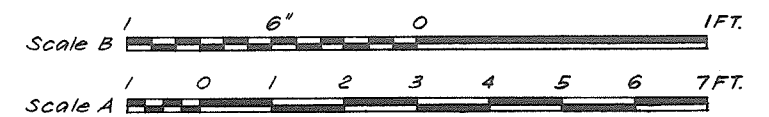

- NOTES
1. Mk letters to be prefixed D21 and clearly painted on assemblies.
 2. Reinforcement shall be adjusted to clear stud anchors.
 3. Floodgate Elevation, Section 2 & 3 and Detail A shown for 124th Street Floodbox, the adjacent gate is not shown for Pattullo Floodbox.

NOTE ON DESIGN
Design adapted from Dwg 4944-1-D125
By: M.A.M.
Checked: N.A.C.
Original designed by A.D. checked by M.G.B., 6 Aug 1976.



CRIPPEN ENGINEERING LTD.
NORTH VANCOUVER, B.C.
PROJECT NO. 10405

DEPARTMENT HEAD C.R. Bland

PROJECT ENGINEER M.A. Merlo

CHIEF ENGINEER John B. Bland

2 Record Drawing
APPROVED FOR CONSTRUCTION JUL 25 1976

1. Prepared for Tender (Combined contracts)

RECOMMENDED Eustace PROJECT MANAGER

DATE June 6 1974


APPROVED M.A. Merlo DIRECTOR, WATER INVESTIGATIONS

DATE June 6 1974


BRITISH COLUMBIA
MINISTRY OF THE ENVIRONMENT
WATER INVESTIGATIONS BRANCH
CANADA - BRITISH COLUMBIA
FRASER RIVER FLOOD CONTROL 1968 AGREEMENT

PROJECT 10.4 CONTRACT NO. 2
SOUTH WESTMINSTER FLOOD CONTROL WORKS
124 TH STREET AND PATTULLO FLOODBOXES
FLOODGATES


| | |
|--------------------------------|--------------------------|
| DESIGNED See Note On Design | SURVEYED |
| DRAWN FL | DATE |
| CHECKED See Note | FILE NO. 0281550-C12D-3 |
| SCALE As shown | DATE 14 Feb, 1979. |
| DWG. NO. 4884-3-D21R2 | SHEET 35 OF 43 SHEETS |

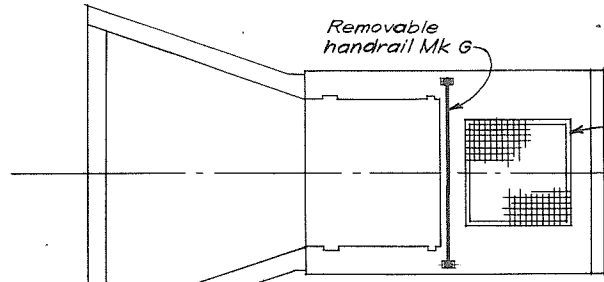


124 TH ST. - INTAKE PLAN
Scale A

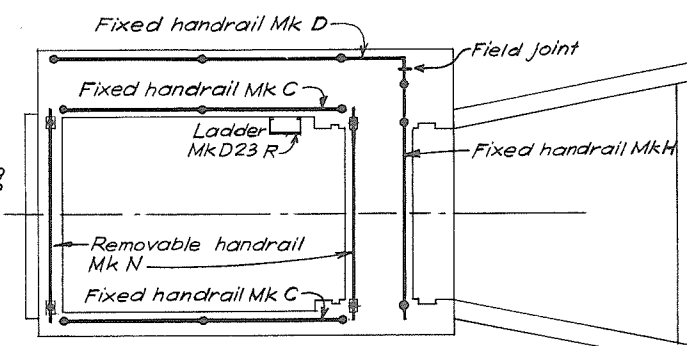


OUTLET PLAN
Scale A

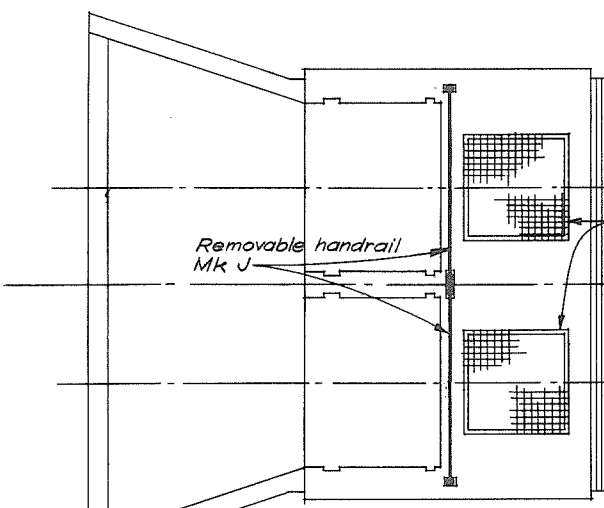


MANSON - INTAKE PLAN
Scale A

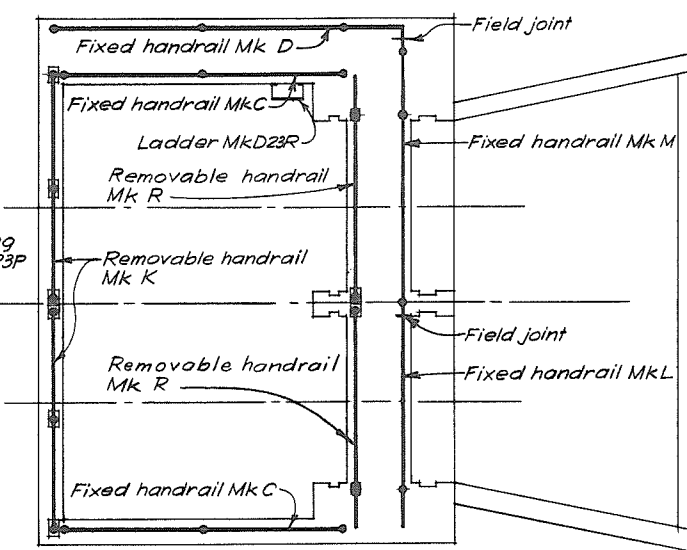


OUTLET PLAN
Scale A

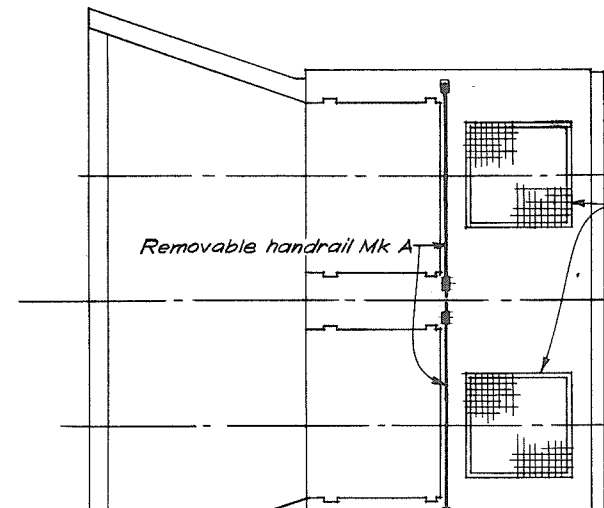

PATTULLO - INTAKE PLAN
Scale A

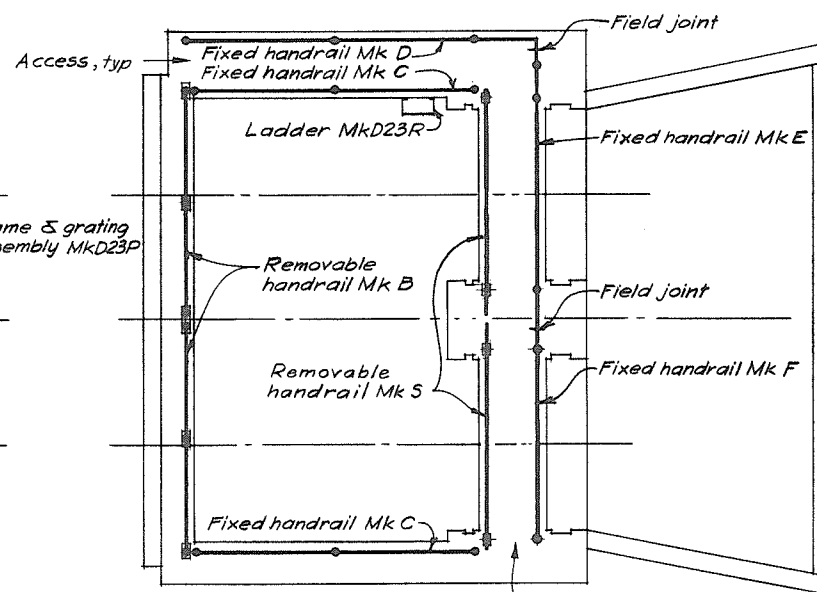


OUTLET PLAN
Scale A

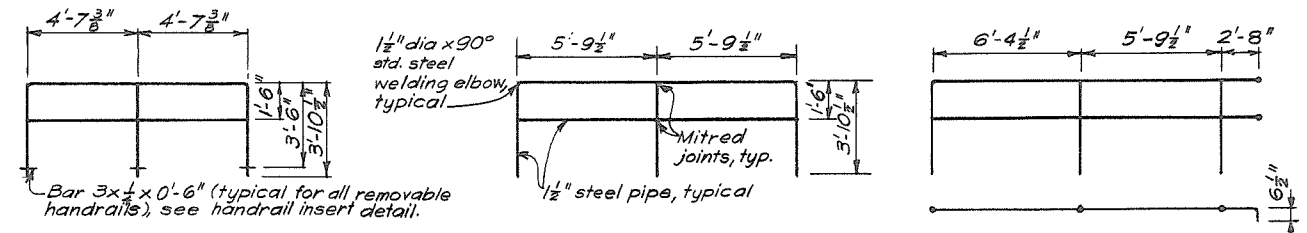


Mk B - 2 reqd
REMOVABLE HANDRAIL

Mk C - 6 reqd
FIXED HANDRAIL


Mk D - 3 reqd
FIXED HANDRAIL

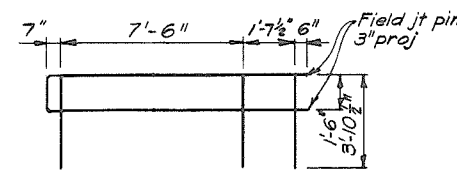


Mk H - one reqd -
FIXED HANDRAIL

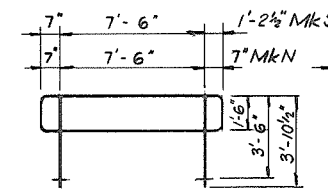


Mk N 2 reqd
REMOVABLE HANDRAIL

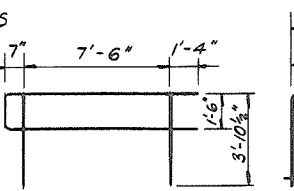


Mk F 1 reqd
FIXED HANDRAIL

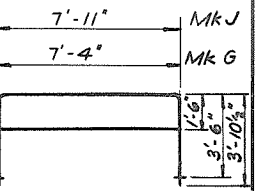


Mk G 1 reqd
REMOVABLE HANDRAIL

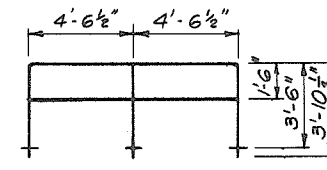


Mk K 2 reqd
REMOVABLE HANDRAIL

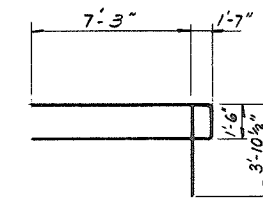


Mk L 1 reqd
FIXED HANDRAIL

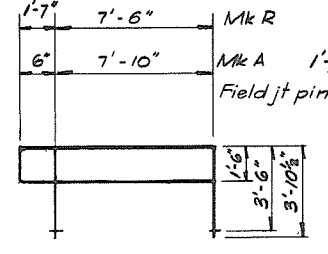


Mk A 2 reqd
Mk R 2 reqd
REMOVABLE HANDRAIL

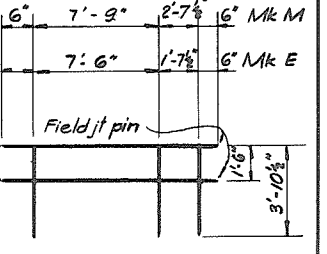


Mk E 1 reqd
Mk M 1 reqd
FIXED HANDRAIL

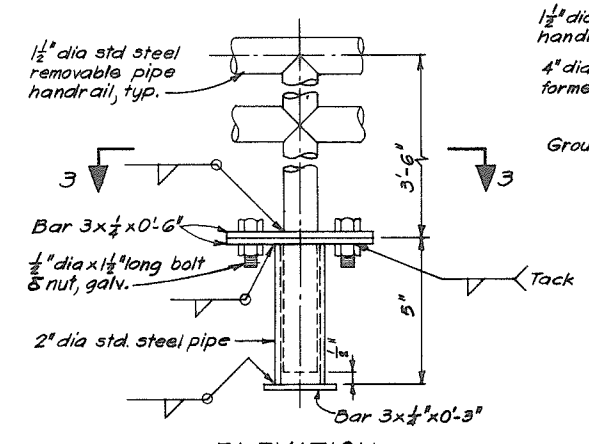


ELEVATION

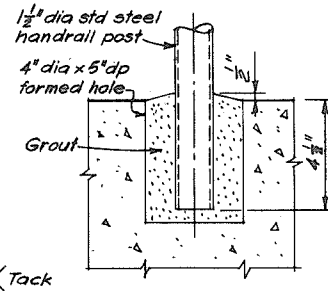


FIXED HANDRAIL
INSTALLATION
Scale B

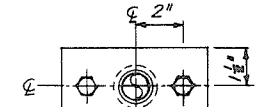

SECTION 3
INSERT FOR REMOVABLE HANDRAIL Mk Q
Scale B

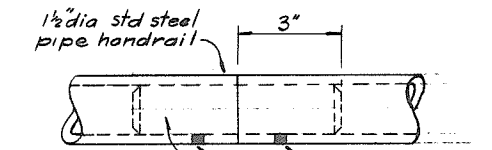


FIELD JOINT DETAIL
N.T.S.

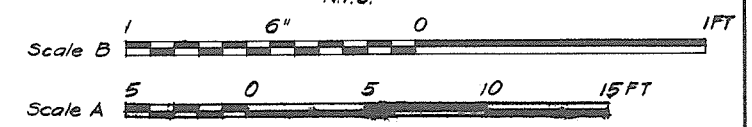

- NOTES**
- All Mk letters to be prefixed D22 and clearly painted on assemblies.
 - Vent holes drilled at underside of handrail piping as required.

NOTE ON DESIGN

Design adapted from Dwg 4944-1-D126 & D127 by M.A.M. & M.H.W.
Checked by: RSS
Original designed by M.H.W., W.K.C & N.v.d.G, checked by M.P. & M.G.B.

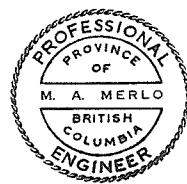

CRIPPEN ENGINEERING LTD.
NORTH VANCOUVER, B.C.
PROJECT NO. 10405

DEPARTMENT HEAD: C.R. Blair
PROJECT ENGINEER: M.A. Merlo
CHIEF ENGINEER: John C. ...

2 Record Drawing
APPROVED FOR CONSTRUCTION

1. Prepared for Tender (Combined contracts)

NO. DESCRIPTION REVISIONS

RECOMMENDED: [Signature] PROJECT MANAGER
DATE: June 6 1984


APPROVED: [Signature] DIRECTOR, WATER INVESTIGATIONS
DATE: June 6/84

BRITISH COLUMBIA
MINISTRY OF THE ENVIRONMENT
WATER INVESTIGATIONS BRANCH
CANADA - BRITISH COLUMBIA
FRASER RIVER FLOOD CONTROL 1968 AGREEMENT


PROJECT 10.4 CONTRACT NO. 2
SOUTH WESTMINSTER FLOOD CONTROL WORKS
124 TH ST., MANSON & PATTULLO FLOODBOXES
HANDRAILS

DESIGNED: See Note On Design
DRAWN: L.S.
CHECKED: See Note On Design
SCALE: As shown
DWG. NO.: 4984-3-D22R2


SURVEYED: DATE
FILE NO.: 0281550-CI2D-3
DATE: 14 Feb, 1979.
SHEET 36 OF 43 SHEETS

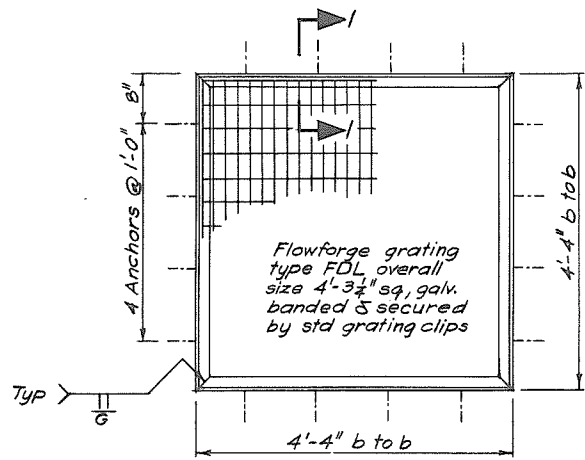


FRAME & GRATING ASSEMBLY
Mk P - 5 reqd
Scale D

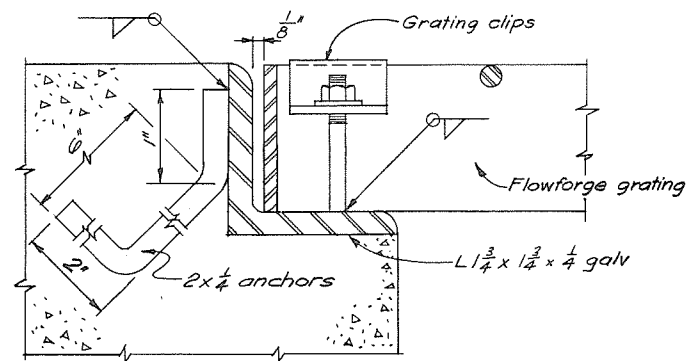


SECTION 1
Scale C

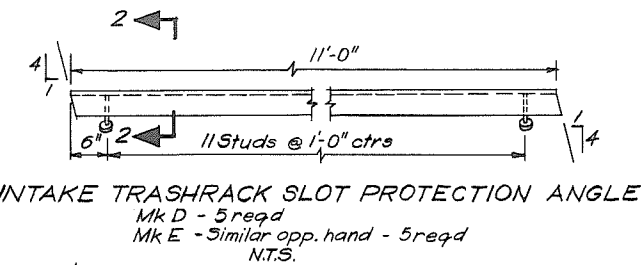

INTAKE TRASHRACK SLOT PROTECTION ANGLE
Mk D - 5 reqd
Mk E - Similar opp. hand - 5 reqd
N.T.S.

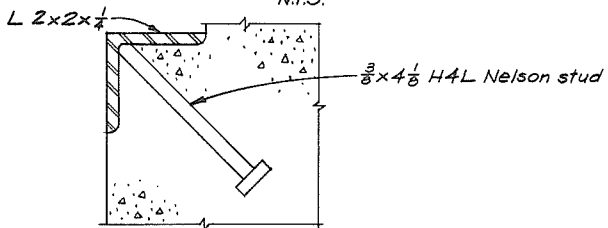


SECTION 2
N.T.S.

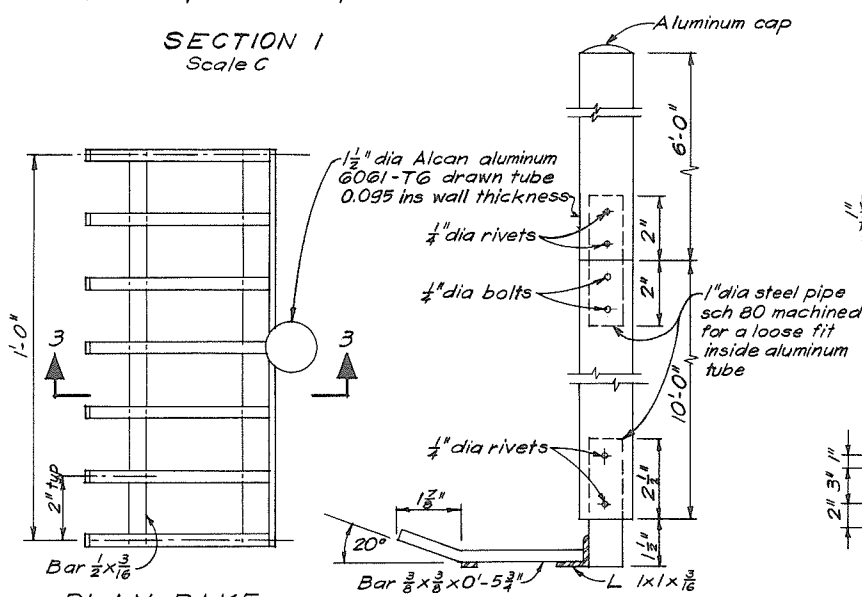


PLAN RAKE
3 reqd
Scale B

SECTION 3
Scale B

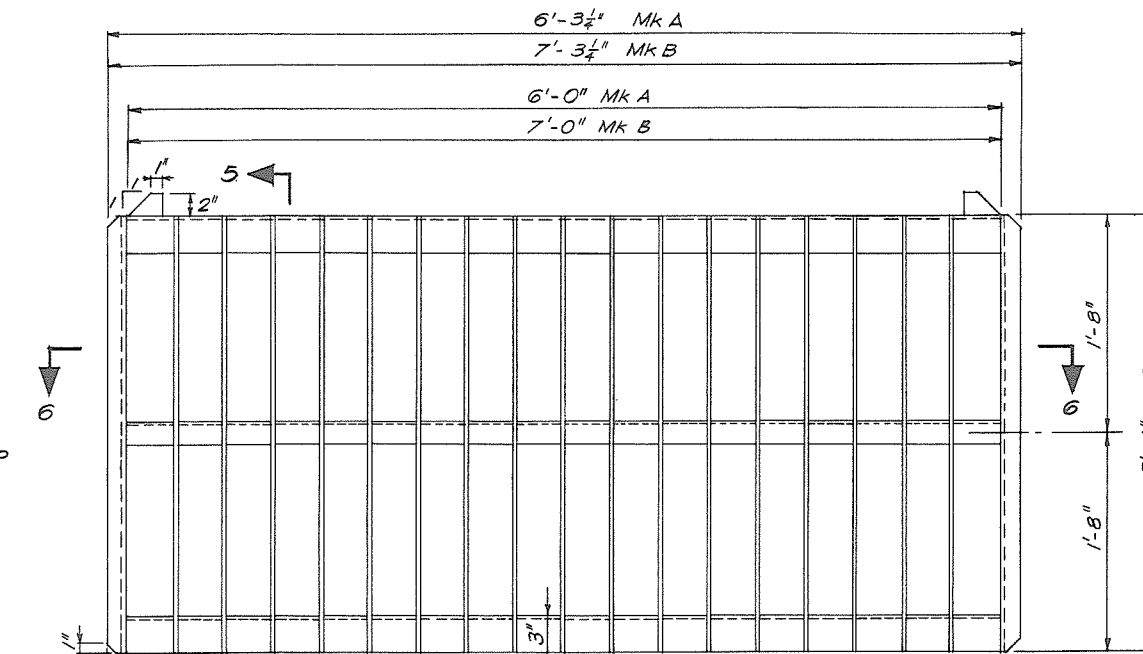


ELEVATION - INTAKE TRASHRACK
Mk A & B
Scale A

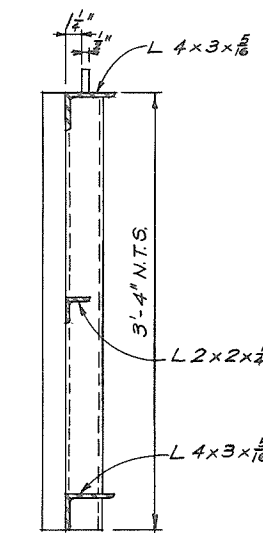

SECTION 5
Scale A



NOTES ON TRASHRACK DESIGN
Design adapted from Dwg 4944-1-D125
By: N.A.C.
Checked: M.A.M.
Original designed by A.D.
Checked by M.G.B., 6 Aug. 1976

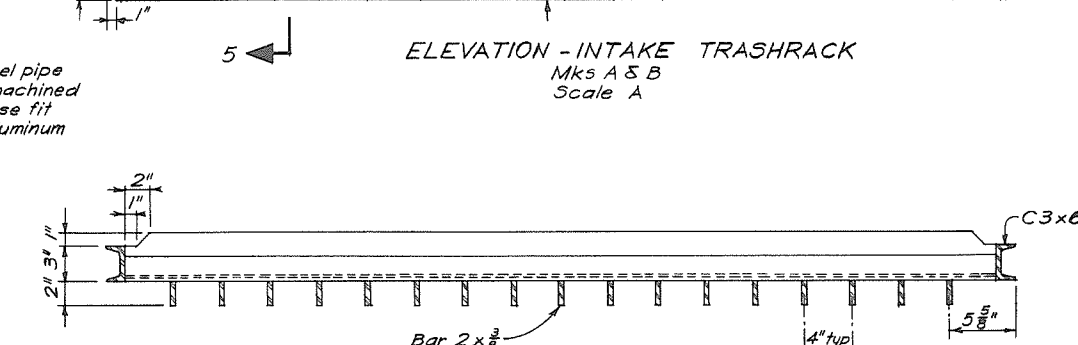

SECTION 6
Scale A


| TRASHRACK SCHEDULE | | | | |
|--------------------|-------------|-------------|-------------|------|
| Location | Intake Mk A | Intake Mk B | Outlet Mk C | Rake |
| Manson | - | 6 | 6 | 1 |
| Pattullo | - | 6 | 6 | 1 |
| 124 Th Street | 3 | - | 3 | 1 |
| Total | 3 | 12 | 15 | 3 |

NOTE
• All Mk letters to be prefixed D23 and clearly painted as assemblies.

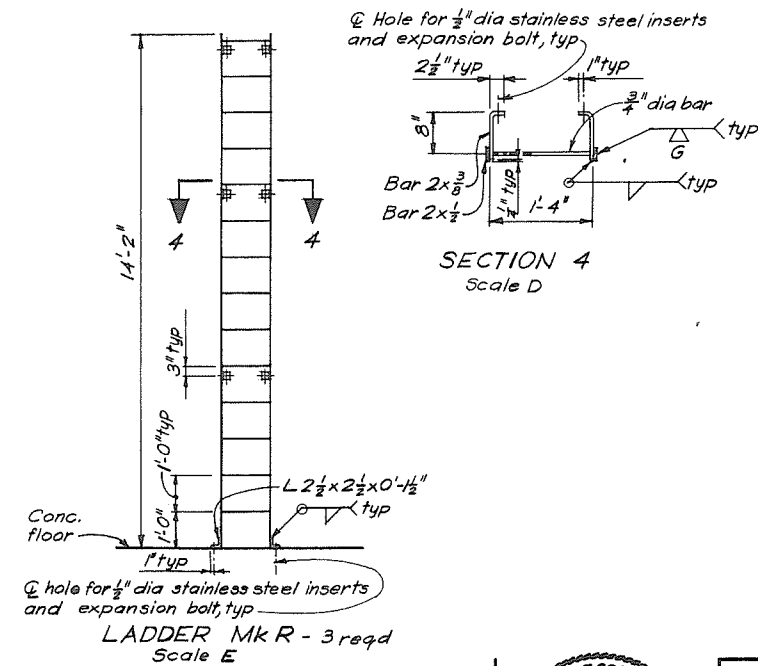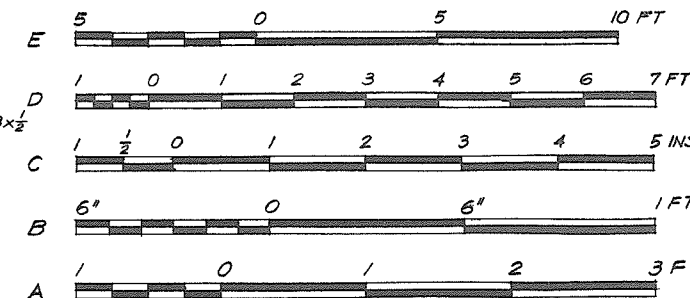

SECTION 4
Scale D

LADDER Mk R - 3 reqd
Scale E

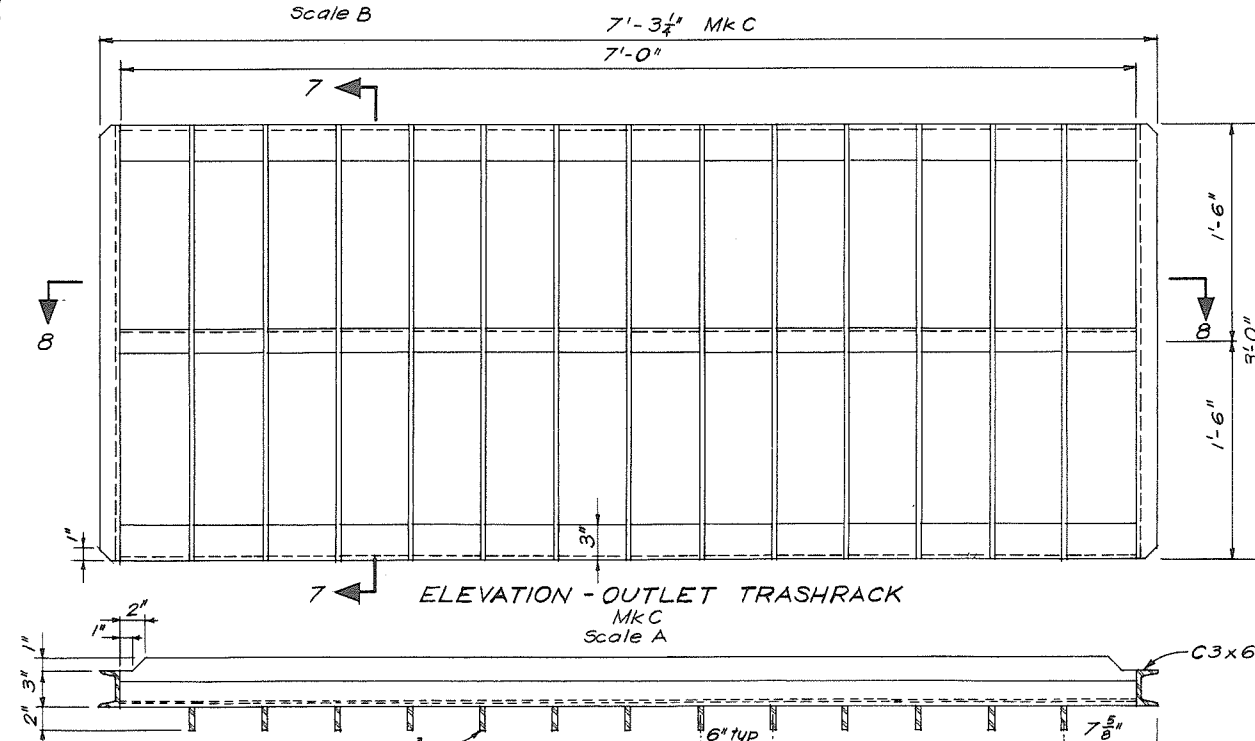

ELEVATION - OUTLET TRASHRACK
Mk C
Scale A

SECTION 7

CRIPPEN ENGINEERING LTD.
NORTH VANCOUVER, B.C.
PROJECT NO. 10429

DEPARTMENT HEAD: C.R. Bland
PROJECT ENGINEER: M.A. Merlo
CHIEF ENGINEER: John B. Hillen

2 Record Drawing
APPROVED FOR CONSTRUCTION JUL 25 1984
1. Prepared for Tender (Combined contracts)

NO. DESCRIPTION BY CHD APPR DATE

RECOMMENDED: Evalomb PROJECT MANAGER
DATE: June 6 1984
APPROVED: John Fuller DIRECTOR, WATER INVESTIGATIONS
DATE: June 6/84


BRITISH COLUMBIA
MINISTRY OF THE ENVIRONMENT
WATER INVESTIGATIONS BRANCH
CANADA-BRITISH COLUMBIA
FRASER RIVER FLOOD CONTROL 1968 AGREEMENT

PROJECT 10.4 CONTRACT NO. 2
SOUTH WESTMINSTER FLOOD CONTROL WORKS
124TH ST., MANSON & PATTULLO FLOODBOXES
TRASHRACKS & MISCELLANEOUS METALWORK


DESIGNED: See Note On Design
DRAWN: L.S.
CHECKED: L.S.
SCALE: As shown
DWG. NO.: 4884-3-D23R2

SURVEYED: DATE
FILE NO.: 0281550-C12D-3
DATE: 14 Feb, 1979.
SHEET 37 OF 43 SHEETS




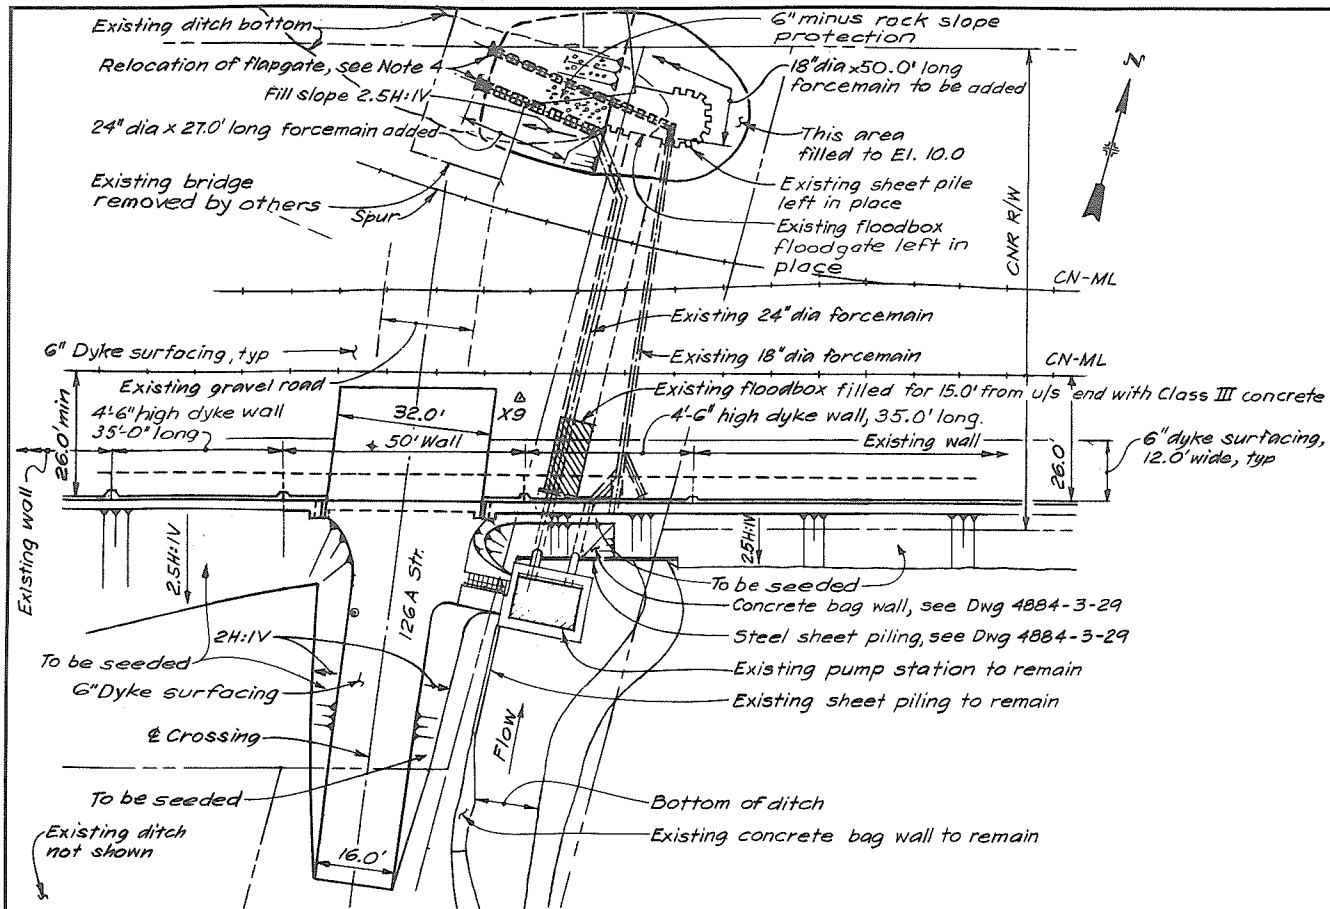


PLAN-126 A STREET DYKE
Scale A

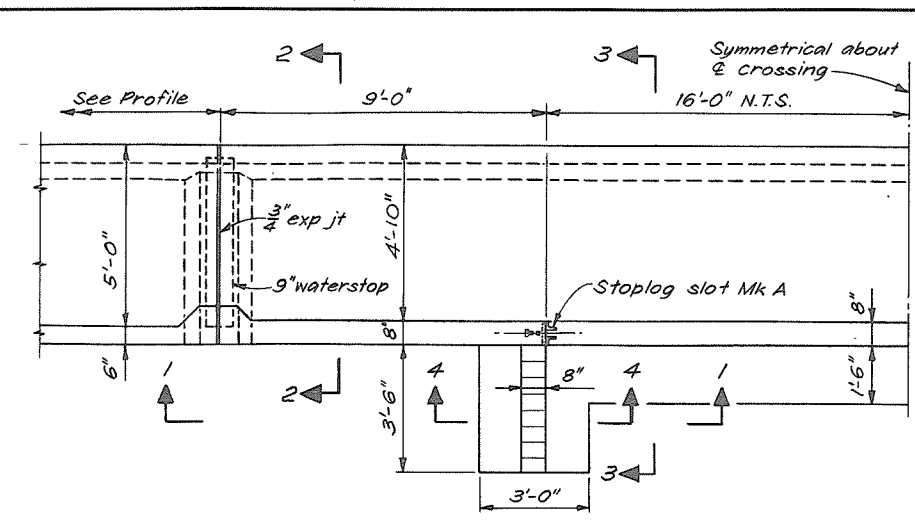


PLAN - CROSSING AT DYKE WALL
(Fill not shown)
Scale C

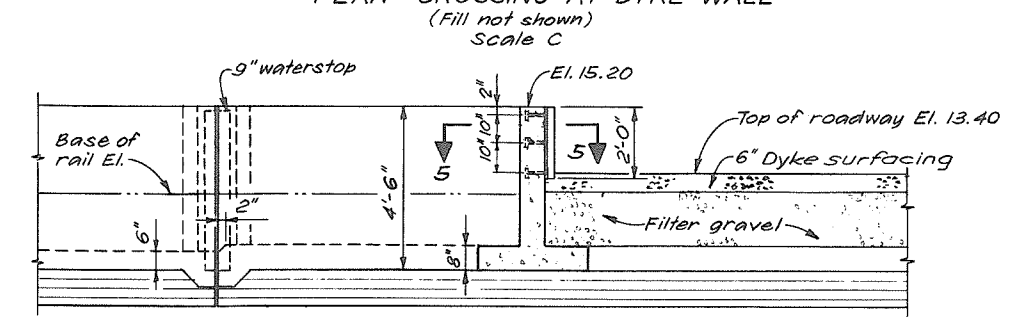


ELEVATION 1
Scale C

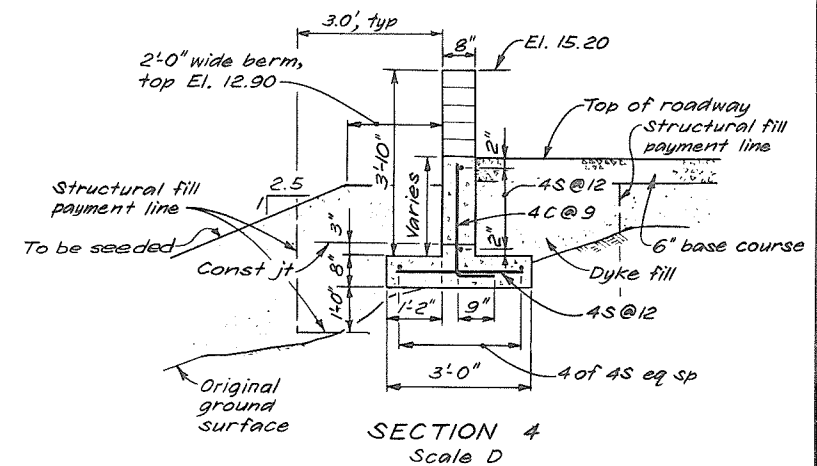


SECTION 4
Scale D

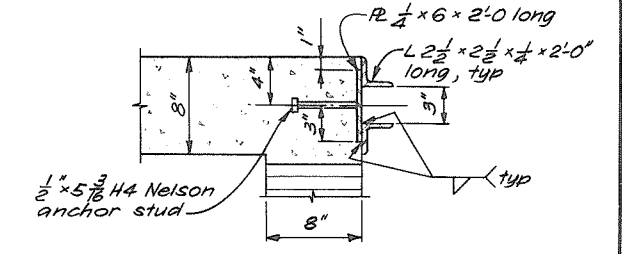


SECTION 5
All metalwork to be hot dip galvanized
Mk A - 2 assemblies req'd.
N. T. S.

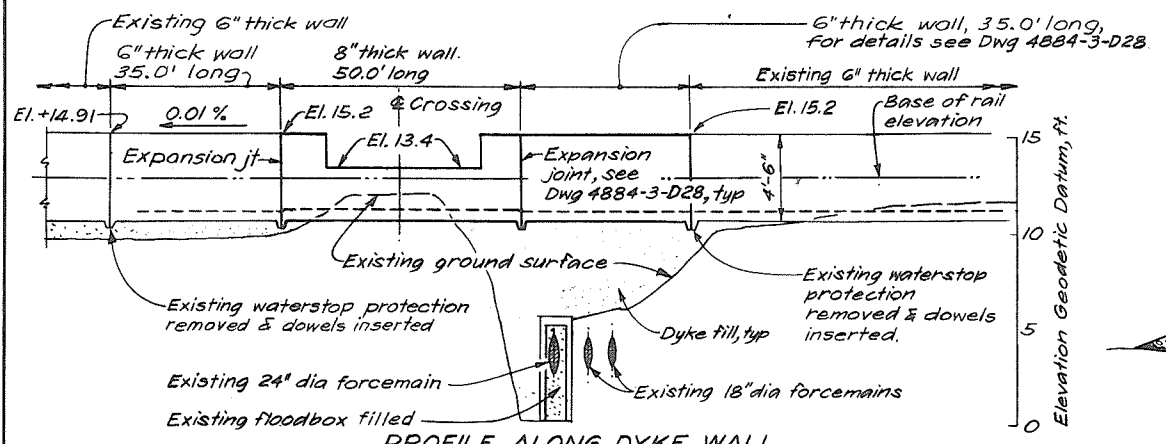


PROFILE ALONG DYKE WALL
Hor. scale A
Vert. scale B

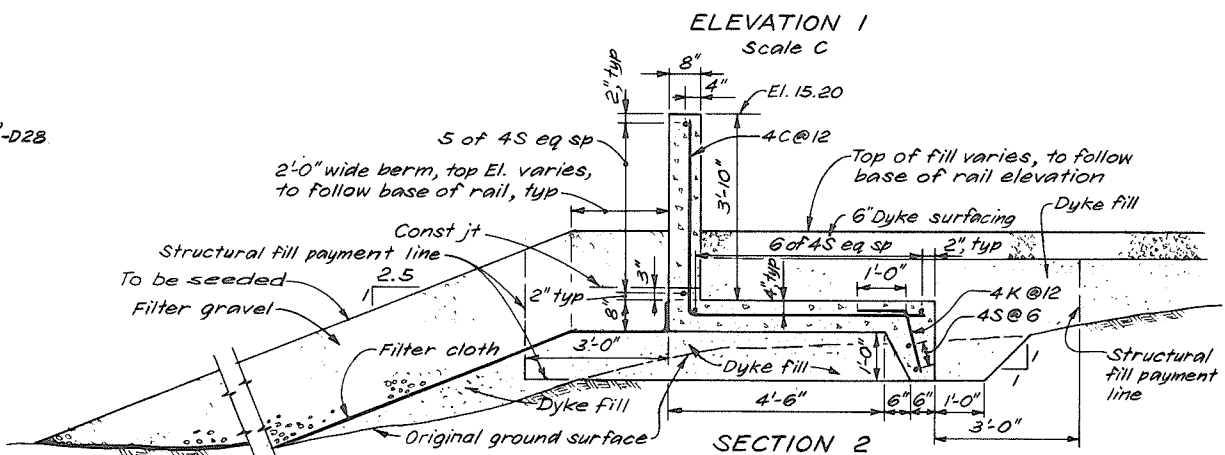

SECTION 2
Excavation & fill for 6\"/>

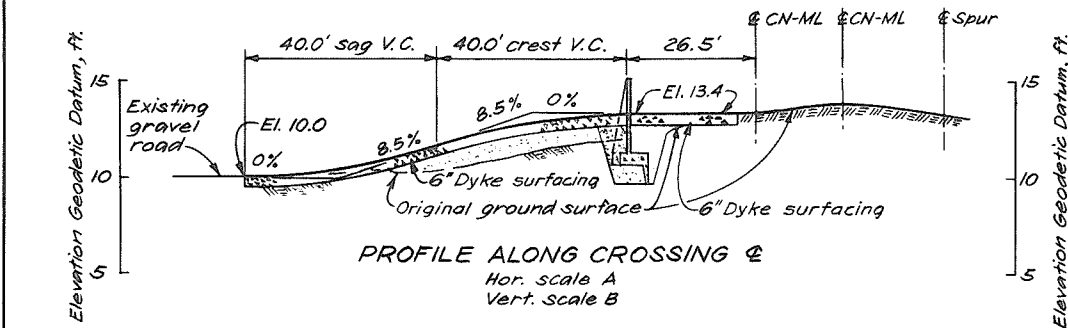



PROFILE ALONG CROSSING &
Hor. scale A
Vert. scale B

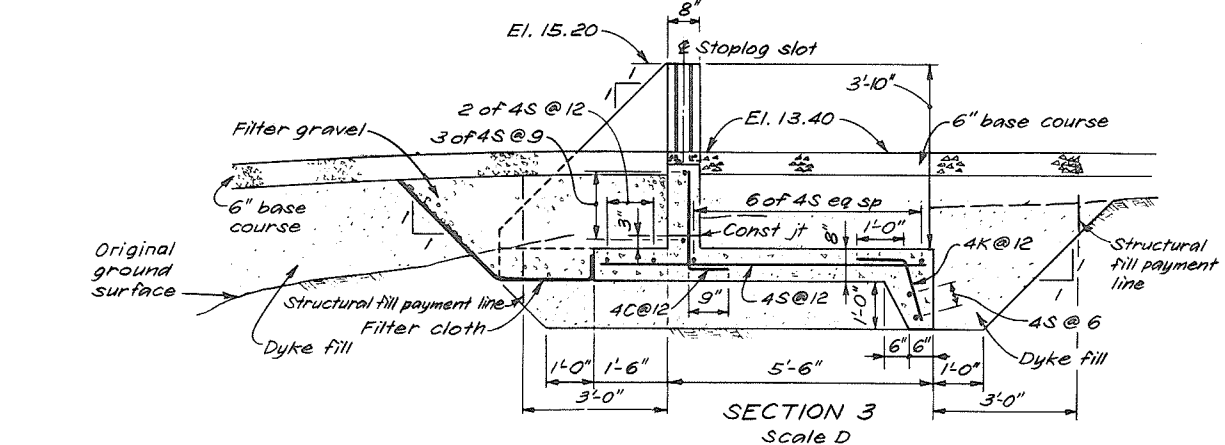

SECTION 3
Scale D

NOTE ON DESIGN
Design adapted from Dwg 4884-1-D15, D2, D18 & D9 by M.A.M & FL.
Checked by: *[Signature]*
Original design by C. Ma checked by ZBS & NAC.

- NOTES
- For general notes and legend see Dwg 4884-3-D27.
 - For notes of concrete & reinforcement see Dwg 4884-3-D28.
 - Mk letters to be prefixed D25 and clearly painted on embedded metalwork.
 - Exact location of extension to existing 24\"/>

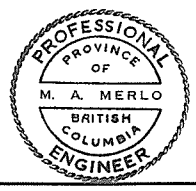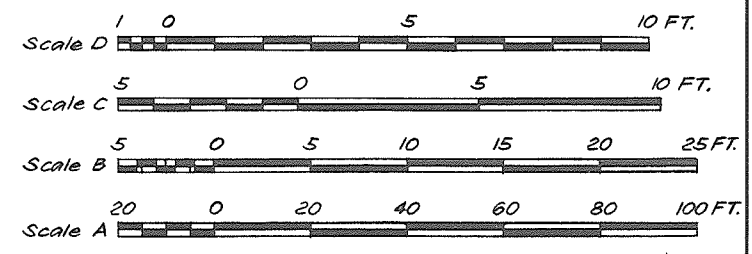

CRIPPEN ENGINEERING LTD.
NORTH VANCOUVER, B.C.
PROJECT NO 10405

DEPARTMENT HEAD *[Signature]*
PROJECT ENGINEER *[Signature]*
CHIEF ENGINEER *[Signature]*

2 Record Drawing
APPROVED FOR CONSTRUCTION JUL 25 84
1. Prepared for Tender (Combined contracts)

NO. _____ DESCRIPTION _____ BY _____ CHD _____ APPR _____ DATE _____

RECOMMENDED *[Signature]*
PROJECT MANAGER
DATE June 6 1984

APPROVED *[Signature]*
DIRECTOR, WATER INVESTIGATIONS
DATE June 6/84


BRITISH COLUMBIA
MINISTRY OF THE ENVIRONMENT
WATER INVESTIGATIONS BRANCH
CANADA - BRITISH COLUMBIA

FRASER RIVER FLOOD CONTROL 1968 AGREEMENT


PROJECT 104 CONTRACT NO.2
SOUTH WESTMINSTER FLOOD CONTROL WORKS
126 A STREET DYKE
PLAN, PROFILE AND SECTIONS

DESIGNED See Note on Design
DRAWN FL
CHECKED See Note on Design
SCALE As shown
DWG. NO 4884-3-D25R2


SURVEYED
DATE
FILE NO. 0281550-C12D-3
DATE 14 Feb, 1979.
SHEET 38 OF 43 SHEETS

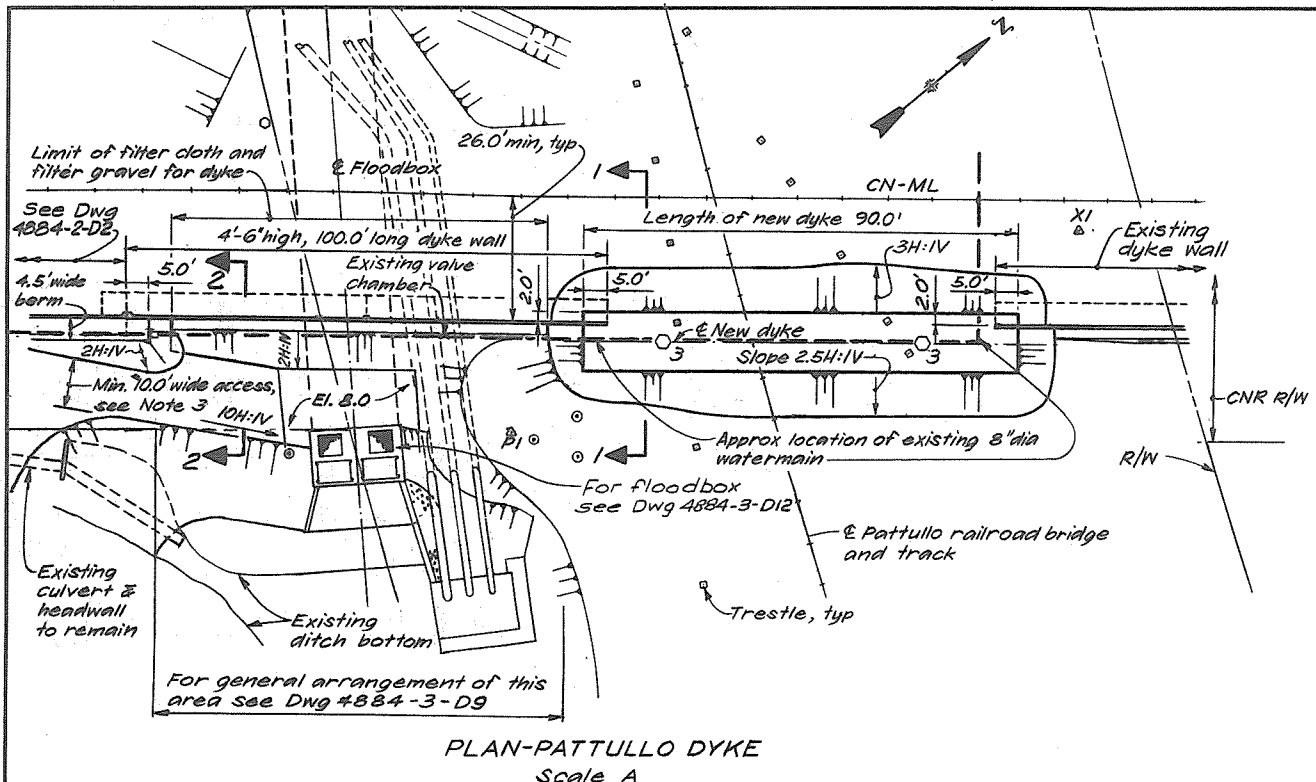


PLAN-PATTULLO DYKE
Scale A

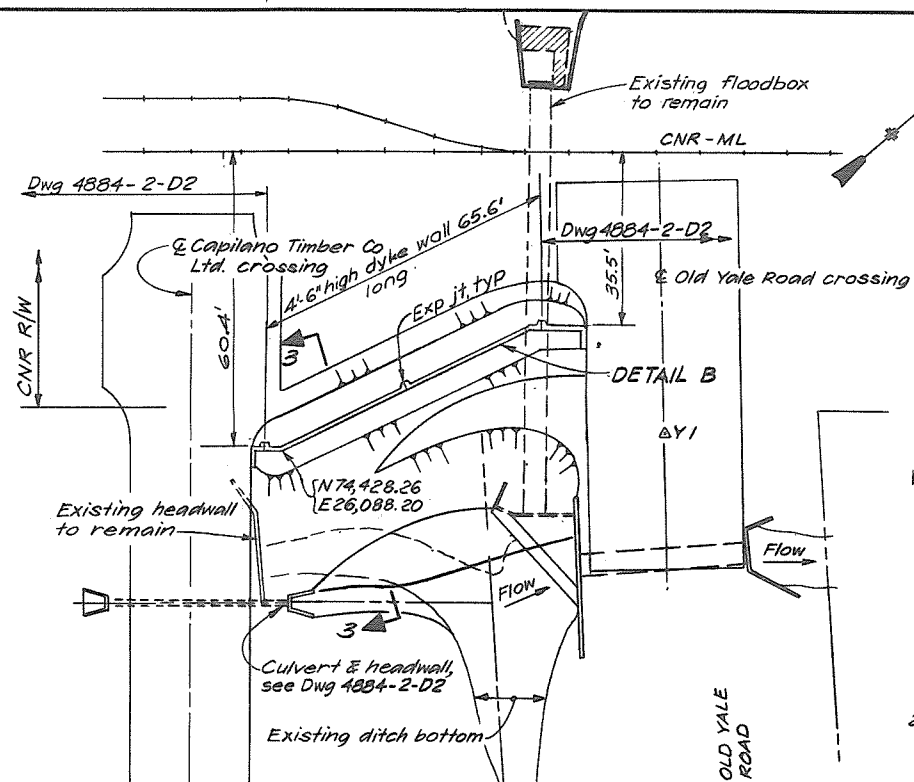


PLAN-OLD YALE ROAD DYKE
Scale A

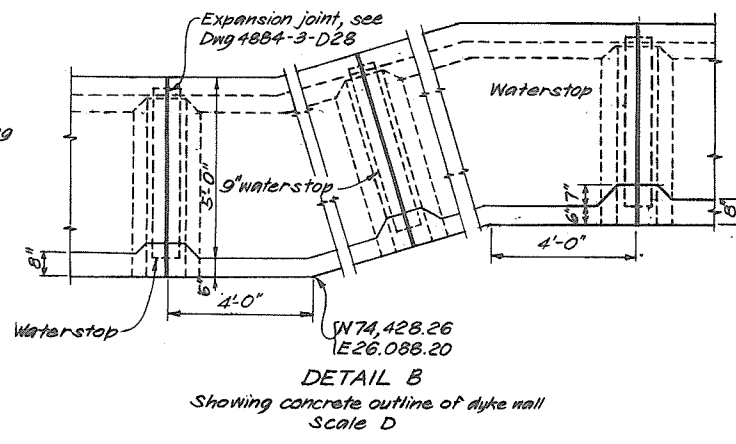


DETAIL B
Showing concrete outline of dyke wall
Scale D

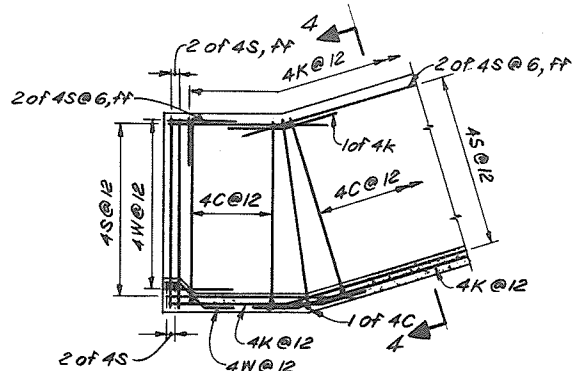


DETAIL B
Showing reinforcement of dyke wall
Scale D

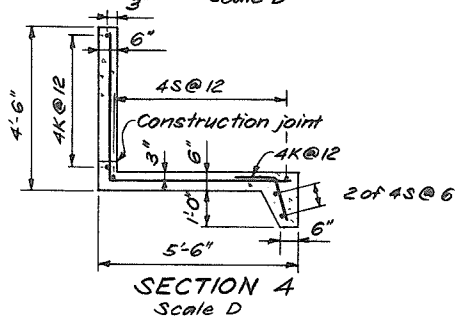


SECTION 4
Scale D

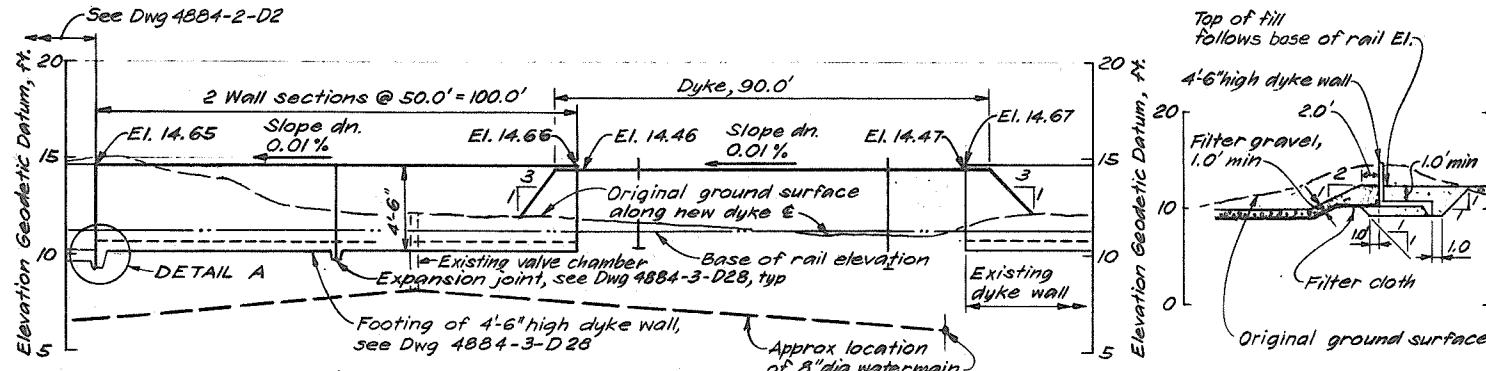


PROFILE-PATTULLO DYKE
Hor. scale A
Vert. scale B

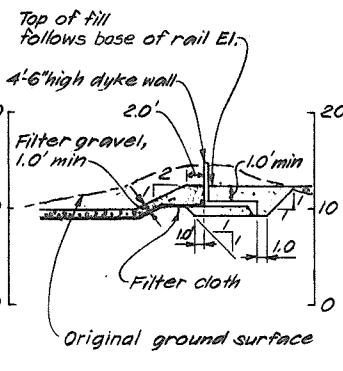


SECTION 2
Scale C

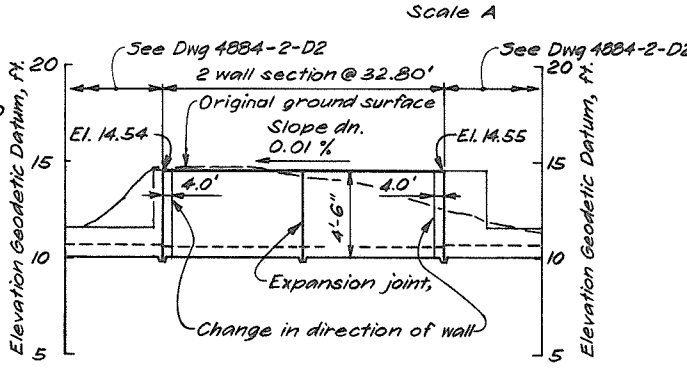


PROFILE-OLD YALE ROAD DYKE
Hor. scale A
Vert. scale B

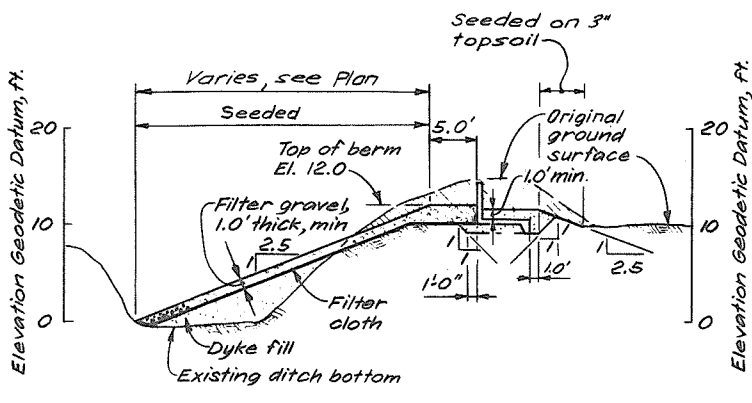

SECTION 3
Scale C

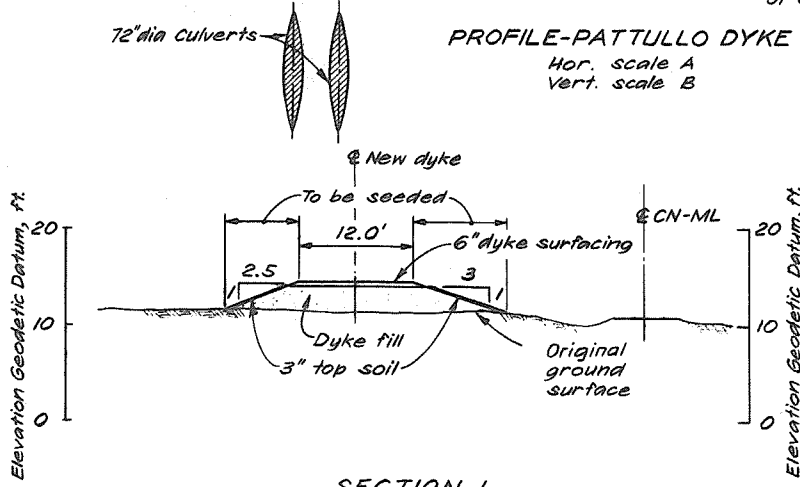


SECTION 1
Scale C

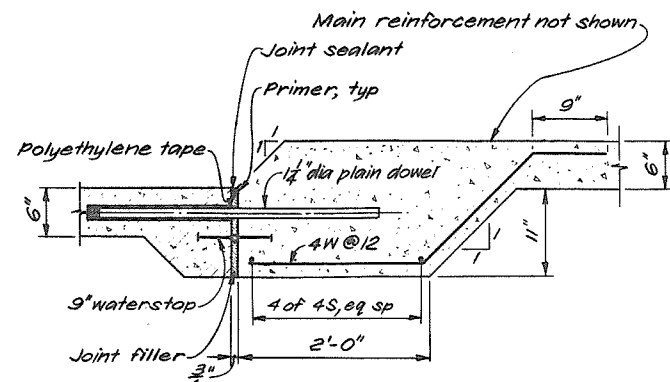

DETAIL A
N.T.S.

- NOTES
- For general notes and legend see Dwg 4884-3-D27.
 - For notes of concrete and reinforcement see Dwg 4884-3-D28.
 - Dyke surfacing, minimum 10.0' wide and minimum 6" thick on access road adjacent to Pattullo Floodbox, was extended to match existing dyke and road accesses.
 - For structural fill & excavation payment lines see Dwg 4884-3-D25.

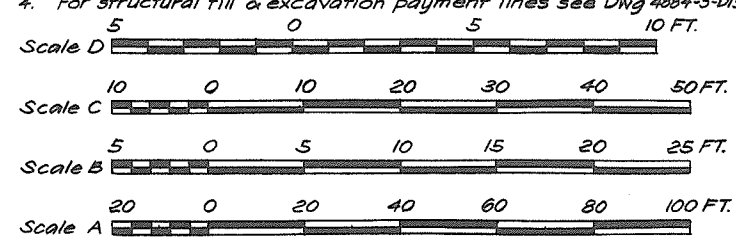

NOTE ON DESIGN
Design adapted from Dwg 4884-1-D4, D2, D18 & D9
by M.A.M. & FL
Check by *M.A.M.*
Original design by M.A.M. & C.Ma, checked
by R.C.D., Z.B.S. & NAC



CRIPPEN ENGINEERING LTD.
NORTH VANCOUVER, B.C.
PROJECT NO. 10465
DEPARTMENT HEAD *[Signature]*
PROJECT ENGINEER *[Signature]*
CHIEF ENGINEER *[Signature]*


2. Record Drawing
APPROVED FOR CONSTRUCTION JUL 25 84
1. Prepared for Tender (Combined contracts)
NO. _____ DESCRIPTION _____ REVISIONS _____

RECOMMENDED *[Signature]* PROJECT MANAGER
DATE June 6 1984
APPROVED *[Signature]* DIRECTOR, WATER INVESTIGATIONS
DATE June 6 1984

BRITISH COLUMBIA
MINISTRY OF THE ENVIRONMENT
WATER INVESTIGATIONS BRANCH
CANADA-BRITISH COLUMBIA
FRASER RIVER FLOOD CONTROL 1988 AGREEMENT
PROJECT 10.4 CONTRACT NO. 2
SOUTH WESTMINSTER FLOOD CONTROL WORKS
PATTULLO & OLD YALE ROAD DYKES
PLAN, PROFILE AND SECTIONS

DESIGNED *[Signature]* See Note On Design
DRAWN FL.
CHECKED *[Signature]* See Note On Design
SCALE As shown
DWG. NO. 4884-3-D26R2
SURVEYED _____ DATE _____
FILE NO. 0281550-C12D-3
DATE 14 Feb, 1979.
SHEET 39 OF 43 SHEETS


FRASER RIVER

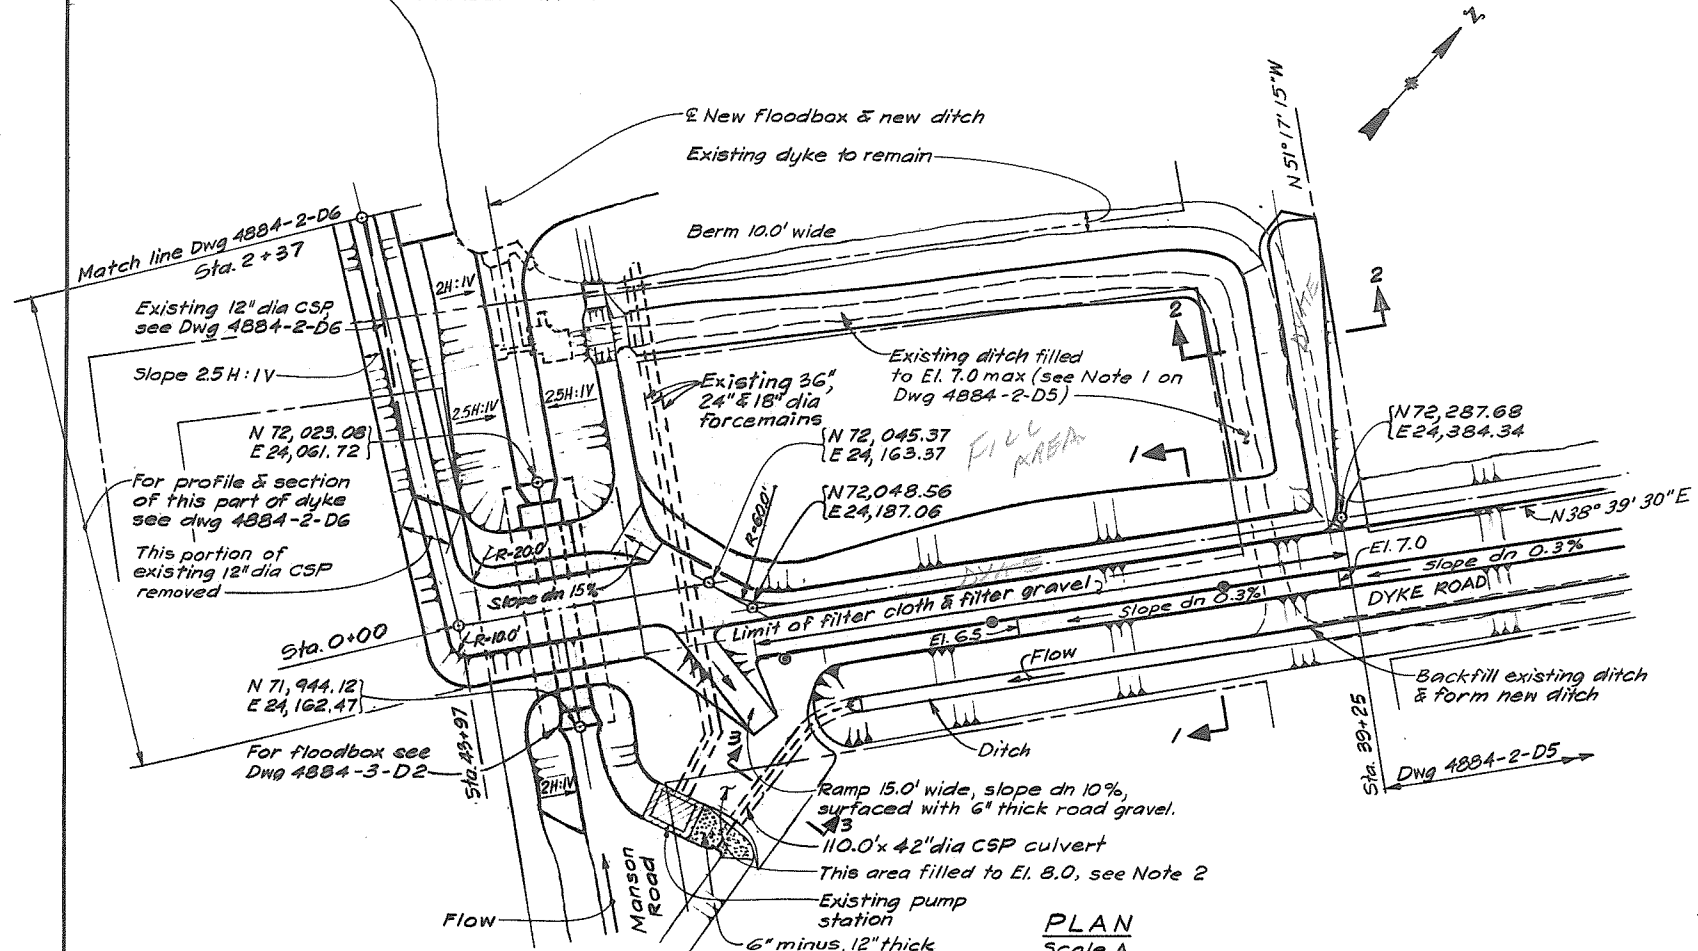


PLAN
Scale A
FINAL ARRANGEMENT OF DYKE & DITCHING

- LEGEND**
- R/W Right of way
 - CNR Canadian National Railroad
 - CN-ML CN-Main line
 - Railroad
 - Asphaltic concrete pavement
 - Legal boundary
 - Base of rail
 - New ditch invert
 - Power pole
 - Dyke coordinate
 - Excavation
 - Fill
 - Lateral movement gauge location (Slope indicator on Plan)
 - Lateral movement gauge in section (Slope indicator casing in section) Bottom El. of casing
 - Telephone pole
 - Dyke traverse control monument


- GENERAL NOTES**
1. Dyke station measured along land side edge of dyke wall or \pm of new dyke.
 2. All sections taken normal to dyke wall centreline or new dyke centreline.
 3. Dyke outline shown in cross-section is final dyke section. Additional settlement allowance not shown.
 4. Dyke & dyke wall alignment have been set by coordinate points and for the dyke section adjacent to CNR tracks by offsets measured at right angles to and from centreline of south railroad track. Exact layout of dyke shall be determined by the Engineer and shall comply with the minimum clearances specified.
 5. Limit of clearing and grubbing as shown on sections are typical for areas as indicated on plans and are maximum limits. Actual limits determined in field by the Engineer.

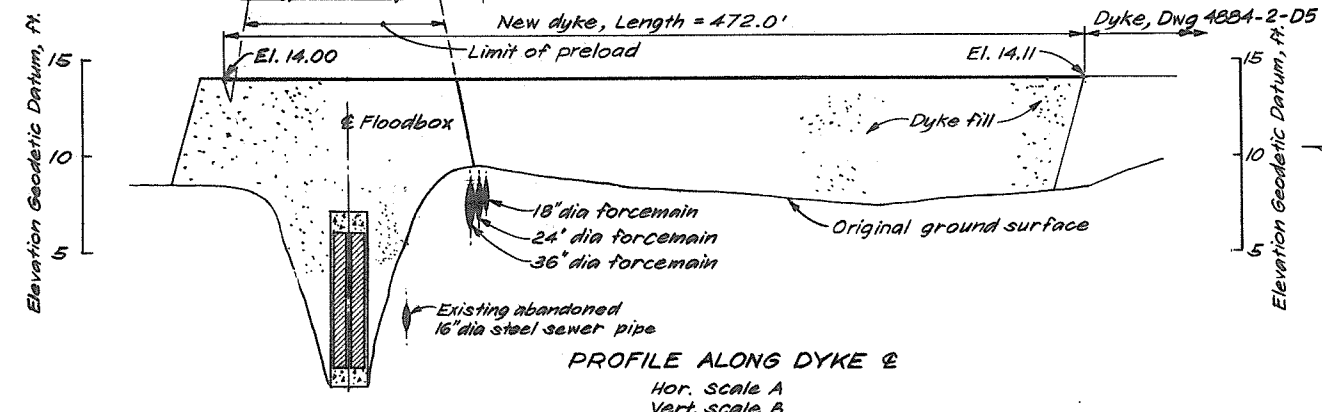


PROFILE ALONG DYKE \pm
Hor. scale A
Vert. scale B

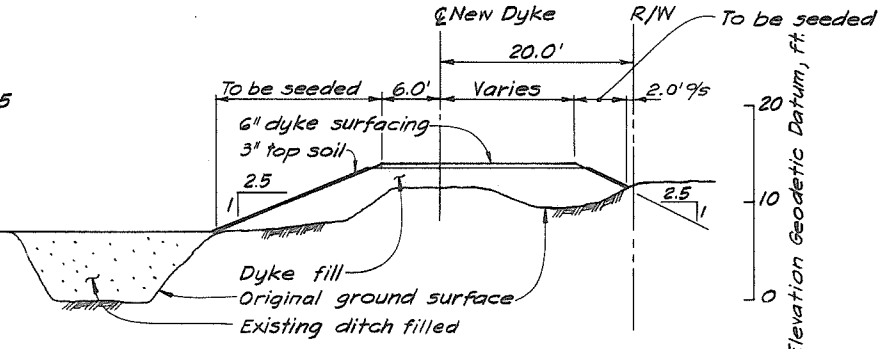

SECTION 2
Scale C

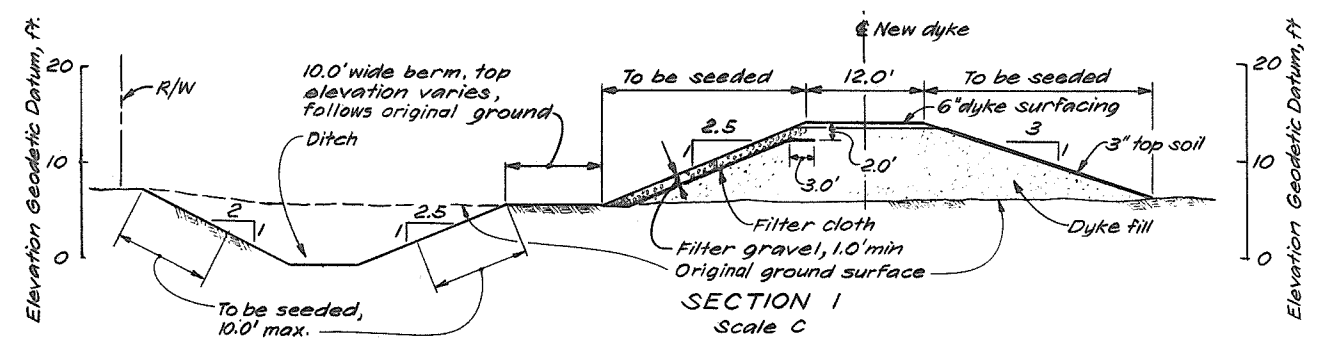


SECTION 1
Scale C

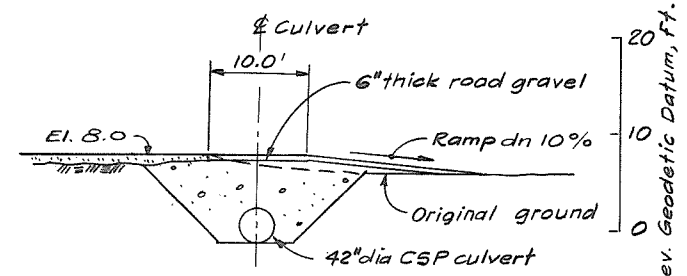

SECTION 3
Scale C

- NOTES**
1. For general arrangement of Manson Road floodbox see Dwg 4884-3-D2.
 2. Gravel surfacing on dyke side of ramp over culvert removed before placing fill over.

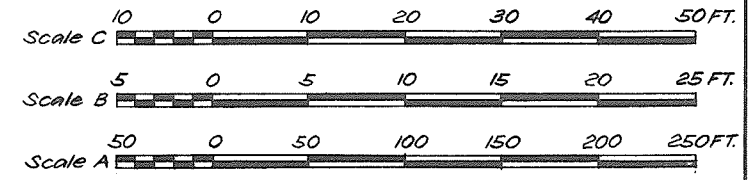

CRIPPEN ENGINEERING LTD.
NORTH VANCOUVER, B.C.
PROJECT NO. 10405

DEPARTMENT HEAD: C.R. Blair
PROJECT ENGINEER: [Signature]
CHIEF ENGINEER: John B. Hudson

2 Record Drawing
APPROVED FOR CONSTRUCTION JUL 25 84

1 Prepared for Tender (Combined contracts)
NO. DESCRIPTION REVISIONS

RECOMMENDED [Signature] PROJECT MANAGER
DATE June 6 1984


APPROVED [Signature] DIRECTOR, WATER INVESTIGATIONS
DATE Jun 6/84

BRITISH COLUMBIA
MINISTRY OF THE ENVIRONMENT
WATER INVESTIGATIONS BRANCH
CANADA-BRITISH COLUMBIA
FRASER RIVER FLOOD CONTROL 1968 AGREEMENT


PROJECT 10.4 CONTRACT NO. 2
SOUTH WESTMINSTER FLOOD CONTROL WORKS
DYKE ROAD DYKE
PLAN, PROFILE AND SECTION

DESIGNED: [Signature]
DRAWN: FL
CHECKED: R.G.D., LVS
SCALE: As shown
DWG. NO.: 4884-3-D27R2


SURVEYED: E.S.
DATE: Nov, 1974.
FILE NO.: 0281550-C12D-3
DATE: 14 Feb, 1979.
SHEET: 40 OF 43 SHEETS

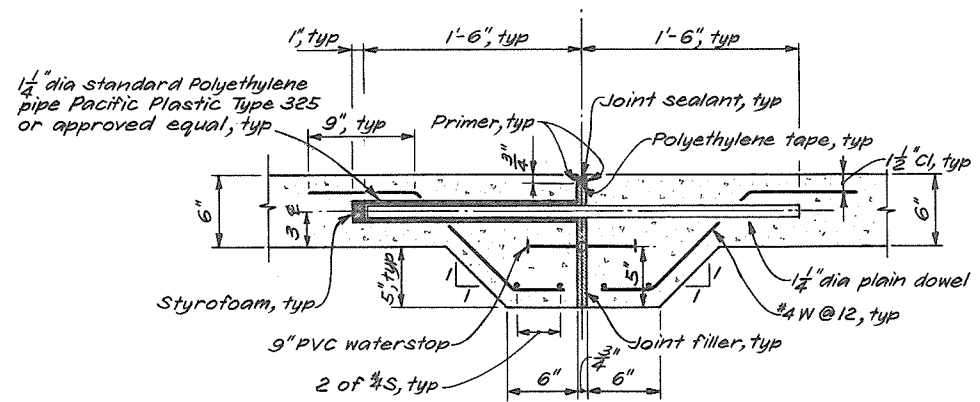


EXPANSION JOINT AT DYKE WALL FOOTING
 Typical for 6" to 6" thick footings
 Scale B

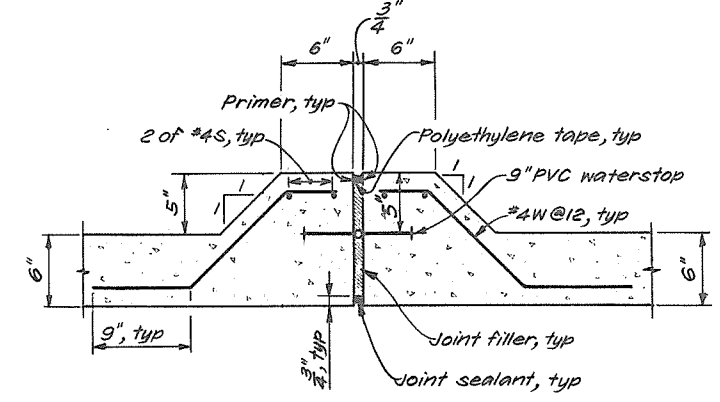


EXPANSION JOINT AT DYKE WALL
 Typical for 6" to 6" thick walls
 Scale B

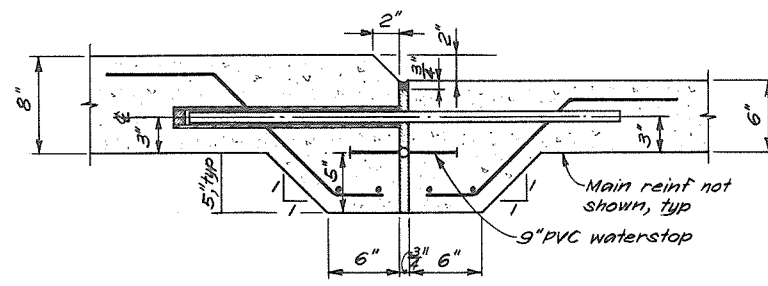


EXPANSION JOINT AT DYKE WALL FOOTING
 ADJACENT TO CROSSING
 Typical for 6" to 8" thick footings
 Scale B

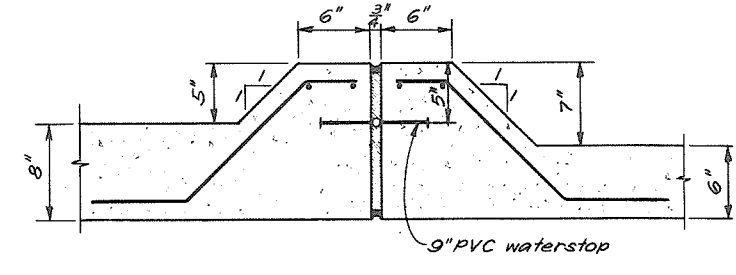


EXPANSION JOINT AT DYKE WALL
 ADJACENT TO CROSSING
 Typical for 6" to 8" thick walls
 Scale B

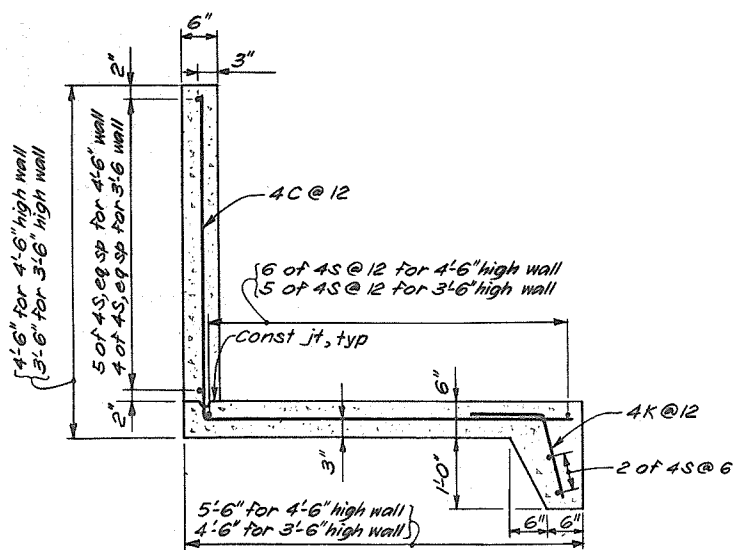

TYPICAL CONCRETE OUTLINE
 AND REINFORCEMENT FOR DYKE WALLS
 4'-6" high wall shown, 3'-6" high wall similar, except as noted
 Scale A

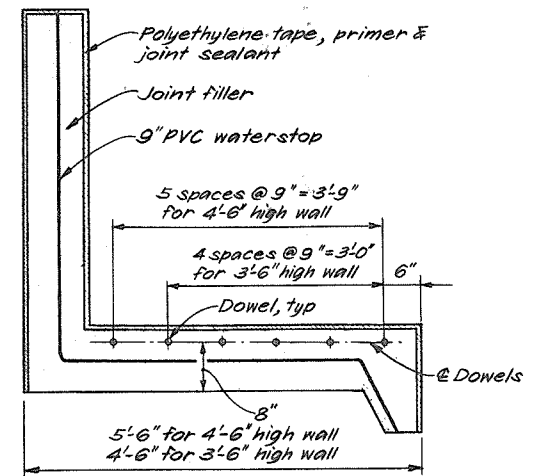



TYPICAL DYKE WALL FOOTING
 DOWELS AT EXPANSION JOINT
 4'-6" high wall shown, 3'-6" high wall similar, except as noted
 Scale A

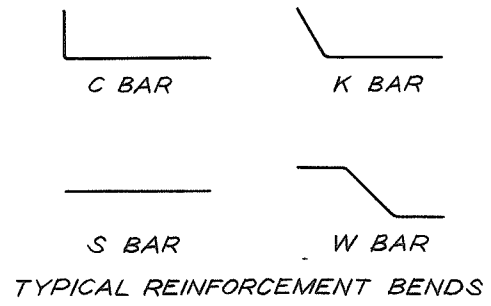

TYPICAL REINFORCEMENT BENDS

NOTES

1. For general notes and legend see Dwg 4884-3-D27.
2. Dimensions to reinforcement are to center of bar unless otherwise shown.
3. Concrete for the walls shall be Class II.
4. Cover to reinforcement shall be 3" unless otherwise shown.

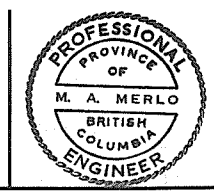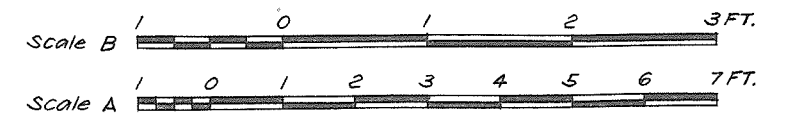

CRIPPEN ENGINEERING LTD.
 NORTH VANCOUVER, B.C.
 PROJECT NO. 10405
 DEPARTMENT HEAD: [Signature]
 PROJECT ENGINEER: [Signature]
 CHIEF ENGINEER: [Signature]


2. Record Drawing.
 APPROVED FOR CONSTRUCTION JUL 25 84
 1. Prepared for Tender (Combined contracts)
 NO. DESCRIPTION BY CHD APPR DATE

RECOMMENDED [Signature]
 DATE June 6 1984
 APPROVED [Signature]
 DATE June 6 1984


PROJECT MANAGER
 PROJECT 10.4 CONTRACT NO. 2
 DIRECTOR, WATER INVESTIGATIONS

BRITISH COLUMBIA
 MINISTRY OF THE ENVIRONMENT
 WATER INVESTIGATIONS BRANCH
 CANADA-BRITISH COLUMBIA
 FRASER RIVER FLOOD CONTROL 1968 AGREEMENT
 SOUTH WESTMINSTER FLOOD CONTROL WORKS
 MISCELLANEOUS CONCRETE DETAILS


DESIGNED NAC
 DRAWN FL
 CHECKED Cm
 SCALE As shown
 DWG NO. 4884-3-D28R2
 SURVEYED
 DATE
 FILE NO. 0281550-C12D-3
 DATE 14 Feb, 1984
 SHEET 41 OF 43 SHEETS

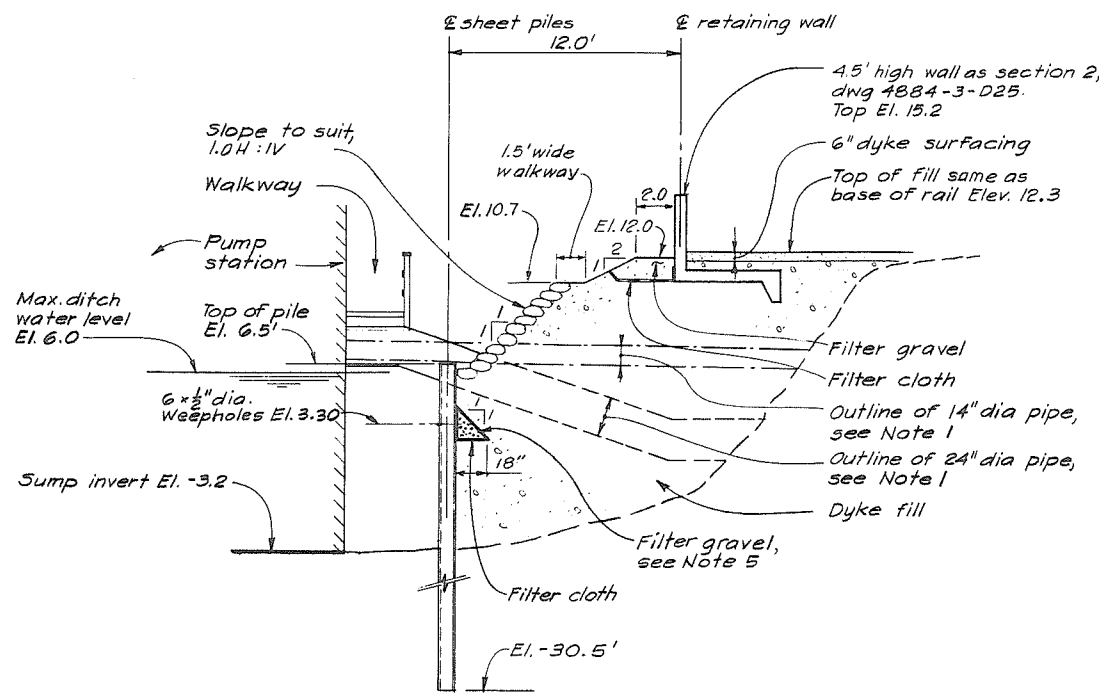


SECTION 1
Scale A

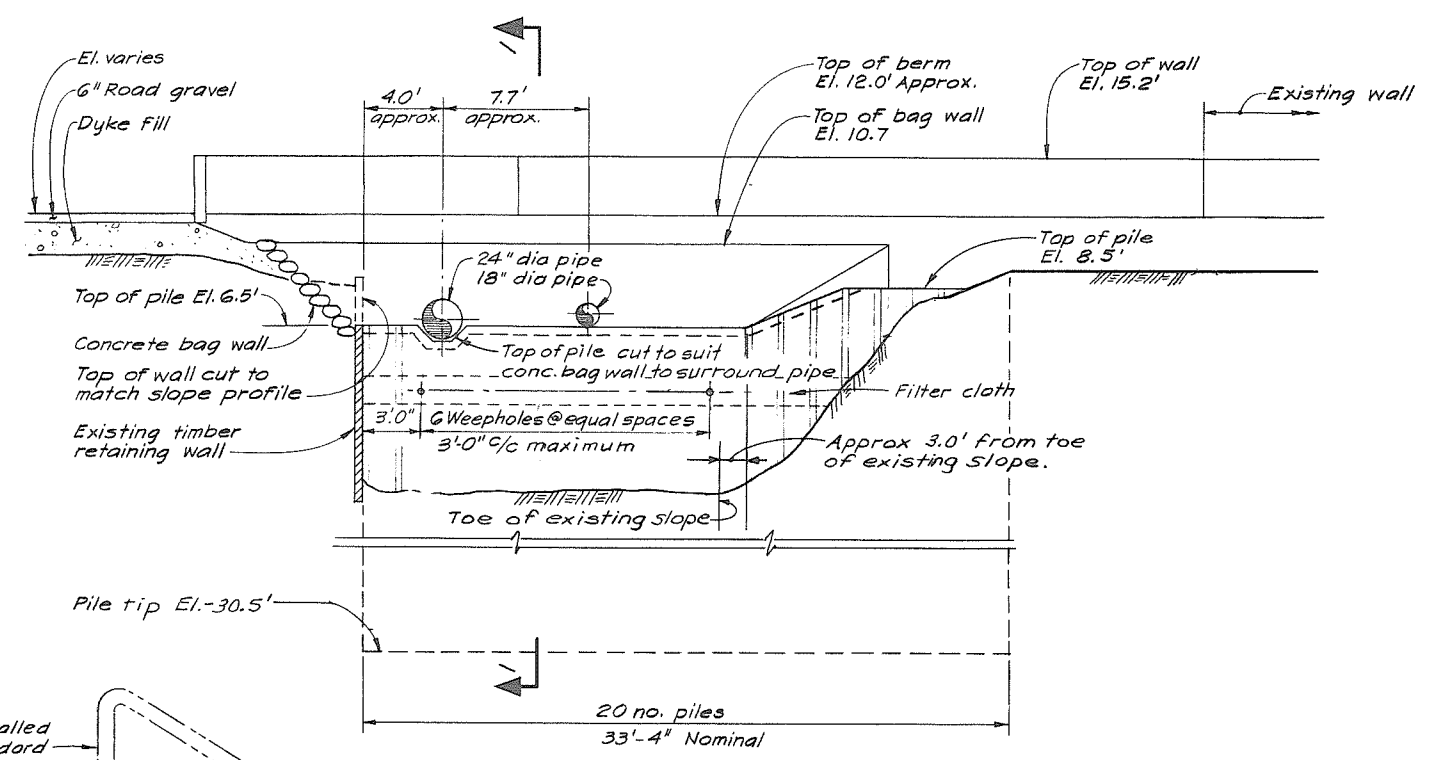

SECTION 2
Scale A


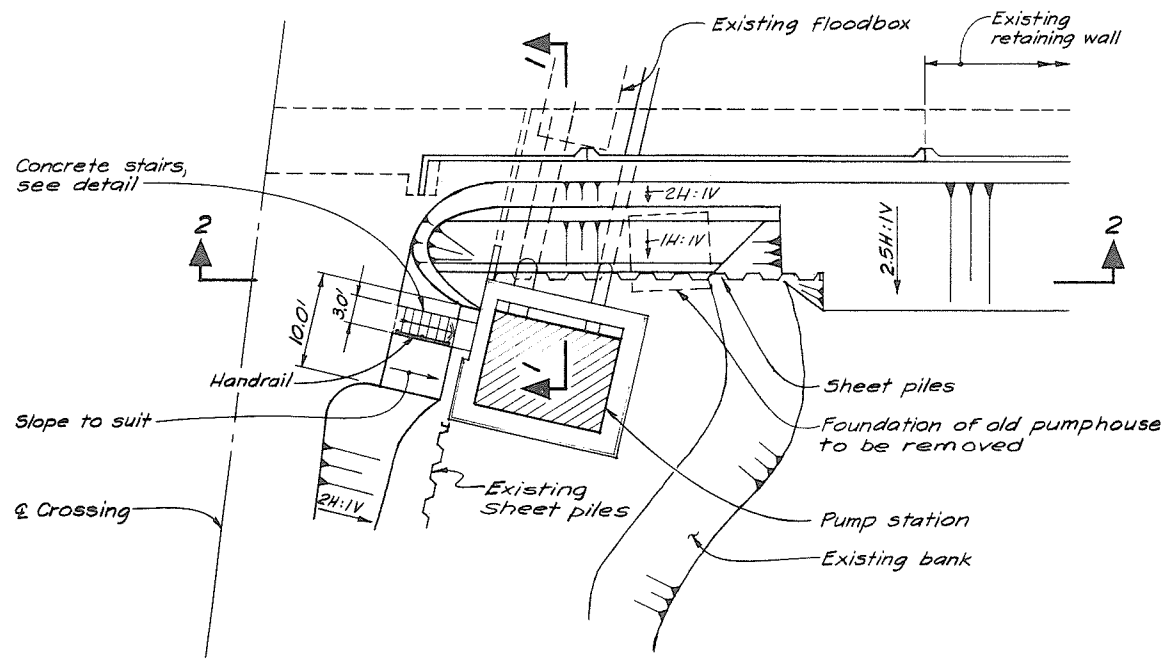


PLAN
For location plan see Dwg 3-D25
Scale B

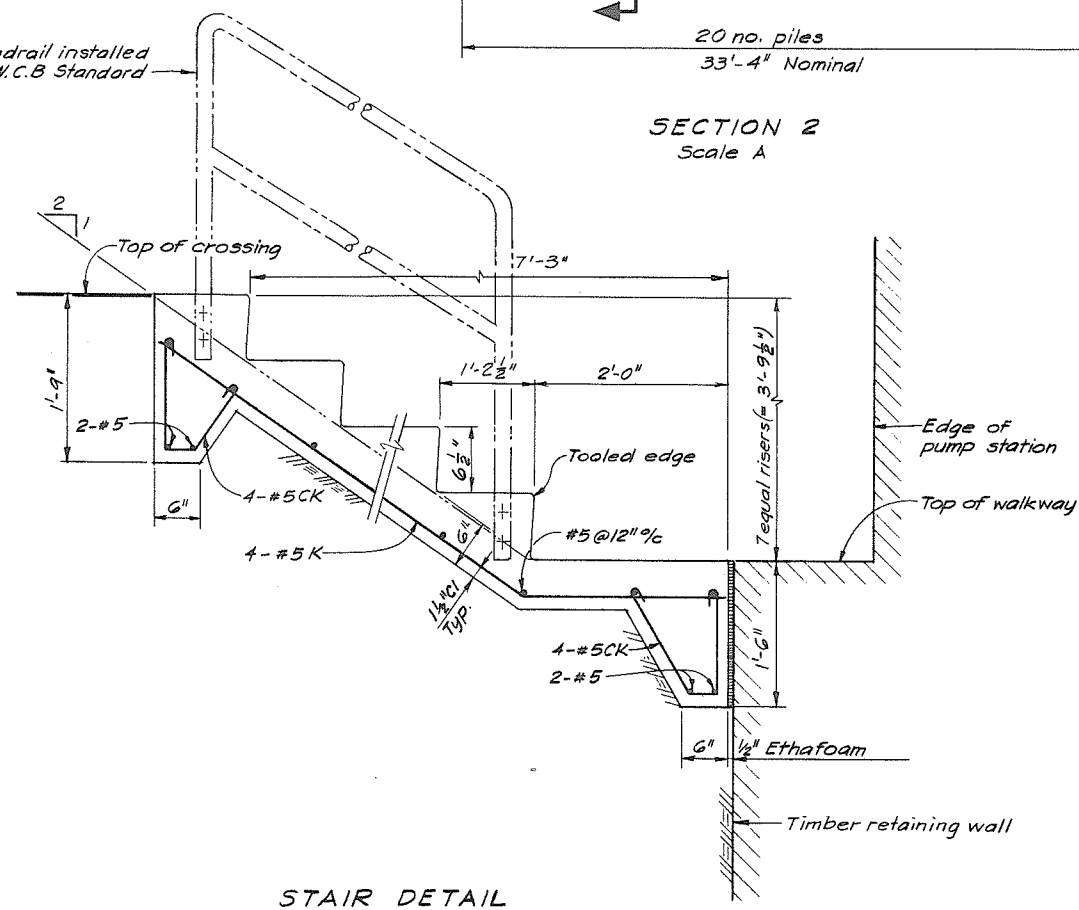

STAIR DETAIL
Scale C

- NOTE
1. Section of discharge pipes temporarily removed for pile driving and replaced.
 2. Concrete for the stairs shall be class II.
 3. For typical reinforcement bends see Dwg 4884-2-D16.
 4. Piles to be Arbed BZ 12.
 5. Filter gravel behind weepholes extended continuously along sheet pile weepholes.

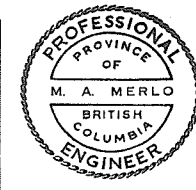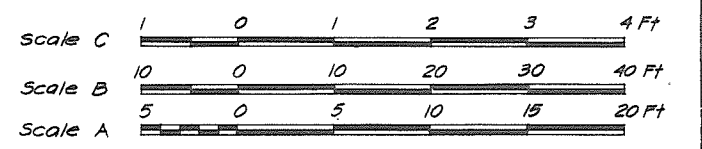

CRIPPEN ENGINEERING LTD.
NORTH VANCOUVER, B.C.
PROJECT NO. 10407

DEPARTMENT HEAD: *[Signature]*

PROJECT ENGINEER: *[Signature]*

CHIEF ENGINEER: *[Signature]*

| NO. | DESCRIPTION | BY | CHK | APPR | DATE |
|-----|--|----|-----|------|----------|
| 3 | Record Drawing. | MP | JM | | 20-11-85 |
| 2 | Pile tip elevation revised | MP | CTL | | 10-8-84 |
| 1 | Prepared for Tender (Combined Contracts) | MP | WHL | | 5-6-84 |

RECOMMENDED: *[Signature]* PROJECT MANAGER

DATE: June 6, 1984

APPROVED: *[Signature]* DIRECTOR, WATER INVESTIGATIONS

DATE: June 6, 1984

BRITISH COLUMBIA
MINISTRY OF ENVIRONMENT
WATER INVESTIGATIONS BRANCH
CANADA - BRITISH COLUMBIA
FRASER RIVER FLOOD CONTROL 1968 AGREEMENT

PROJECT 10.4 CONTRACT NO. 2
SOUTH WESTMINSTER FLOOD CONTROL WORKS
126 A STREET DYKE - SHEET PILE WALL
PLAN, SECTIONS AND DETAIL

DESIGNED: *[Signature]*

DRAWN: L.S.

CHECKED: *[Signature]*


SCALE: As shown

DWG. NO. 4884-3-D29


FILE NO. Q281550-C12D-3

DATE: 29 Feb. 1984


SHEET 42 OF 43 SHEETS

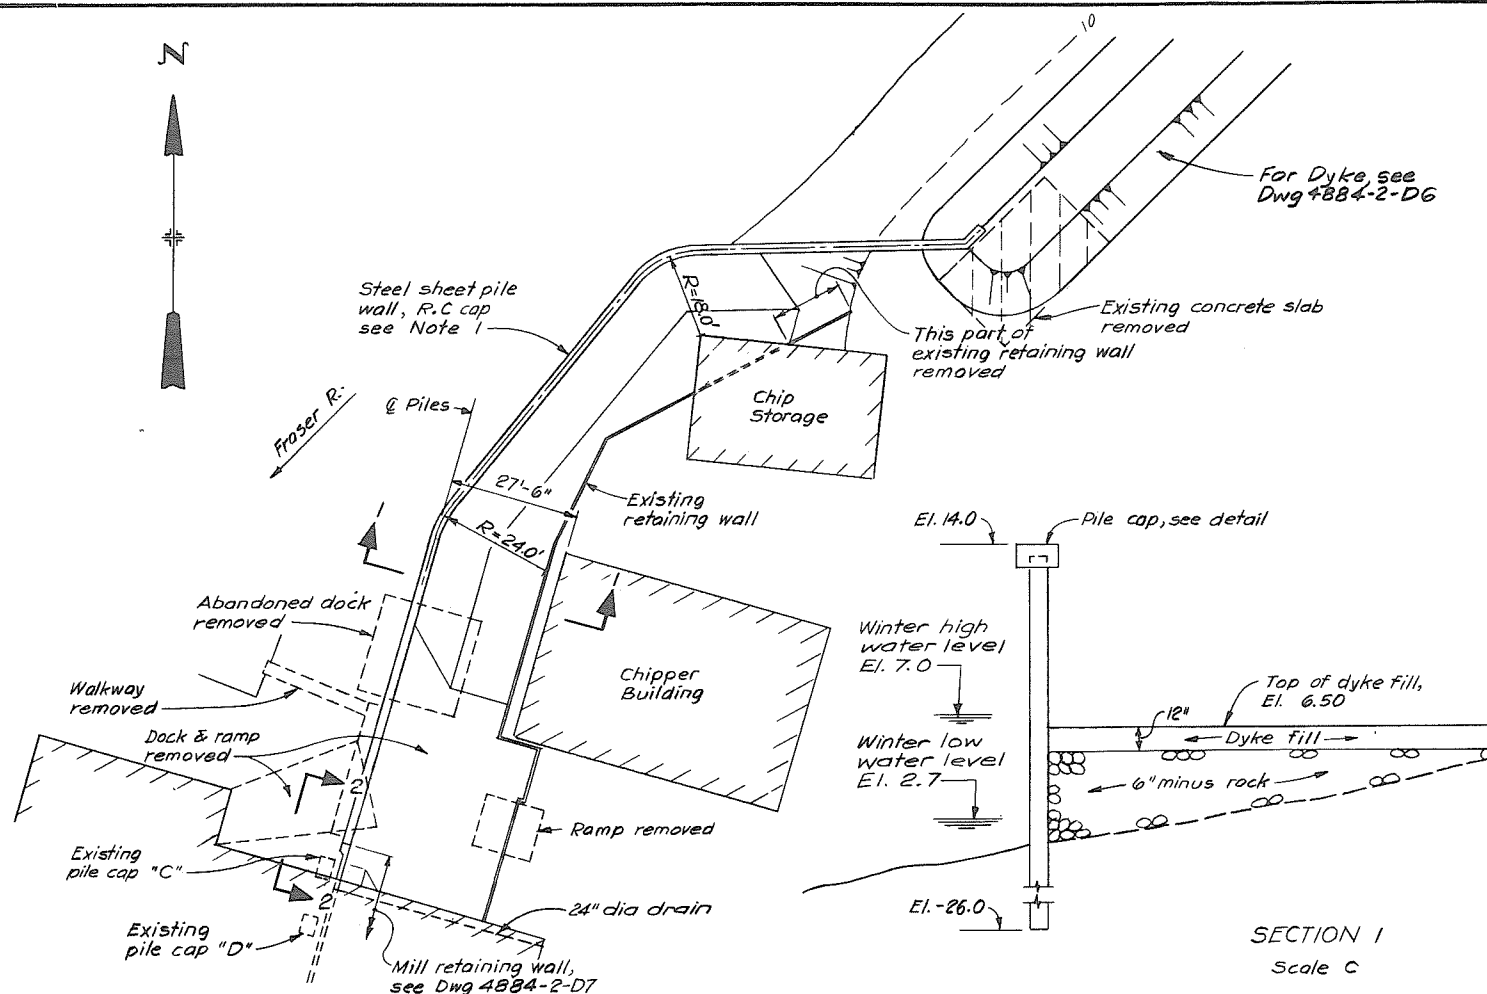


PLAN
Continuation from Dwg 4884-2-D7
Scale E

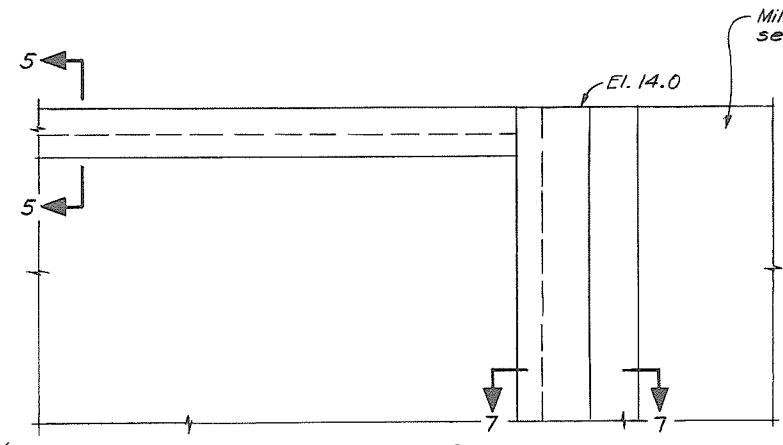


ELEVATION 2
Scale B

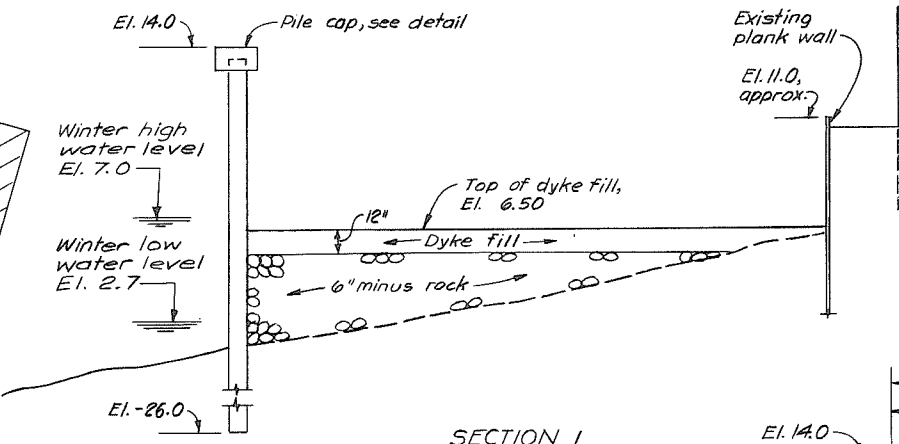

SECTION 1
Scale C

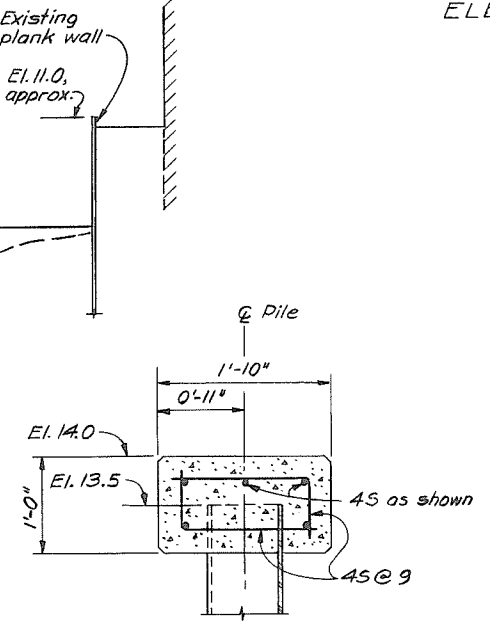


SECTION 5
Typical section of pile cap
Scale A

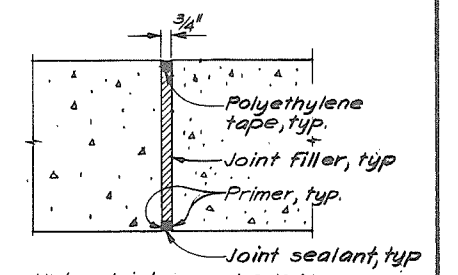


DETAIL OF PILE CAP JOINT
Scale A

Note: Joint spaced @ 10.0' intervals.

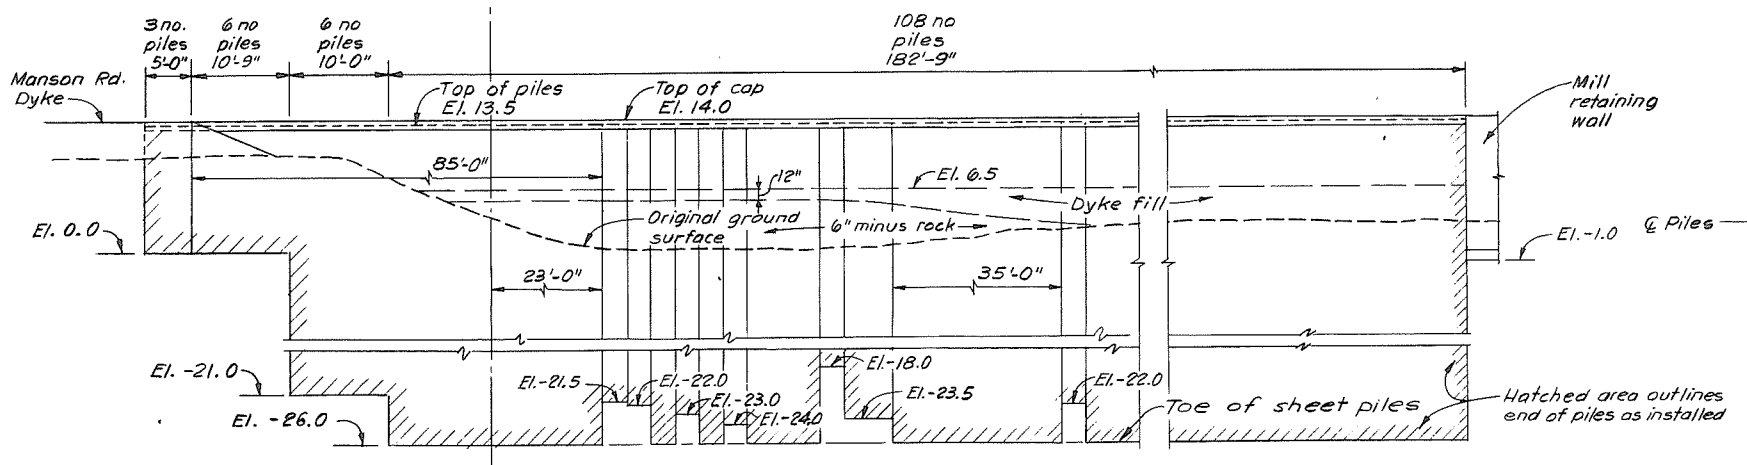


PROFILE
Scale D

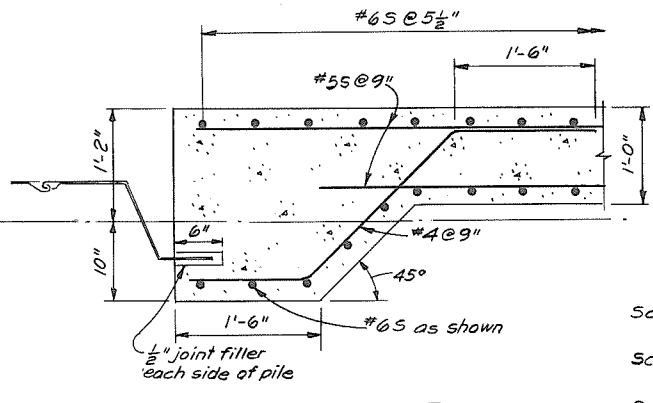

SECTION 7
Detail of joint at
Mill retaining wall / sheet pile wall
Scale A

NOTES
1 Piles to be Arbed BZ12 or equivalent.

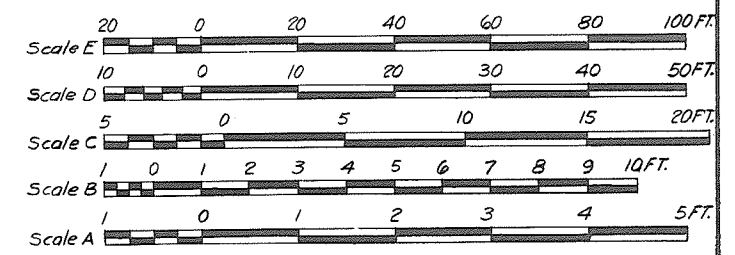

CRIPPEN ENGINEERING LTD.
NORTH VANCOUVER, B.C.
PROJECT NO. 10407
DEPARTMENT HEAD
PROJECT ENGINEER
CHIEF ENGINEER


4. Record Drawing
3. Mill retaining wall extended & 2 piles deleted.
2. Pile tip elevations revised
1. Prepared for Tender (Combined Contracts)

APPROVED
DATE
BY
CHD
APPR
DATE


RECOMMENDED
PROJECT MANAGER
DATE
APPROVED
DATE

BRITISH COLUMBIA
MINISTRY OF ENVIRONMENT
WATER INVESTIGATIONS BRANCH
CANADA-BRITISH COLUMBIA
FRASER RIVER FLOOD CONTROL 1968 AGREEMENT
PROJECT 10-4 CONTRACT NO. 2
SOUTH WESTMINSTER FLOOD CONTROL WORKS
WELDWOOD SHEET PILE WALL
GENERAL ARRANGEMENT AND DETAILS


DESIGNED
DRAWN
CHECKED
SCALE
DWG. NO.
SURVEYED
DATE
FILE NO.
DATE
SHEET 43 OF 43 SHEETS

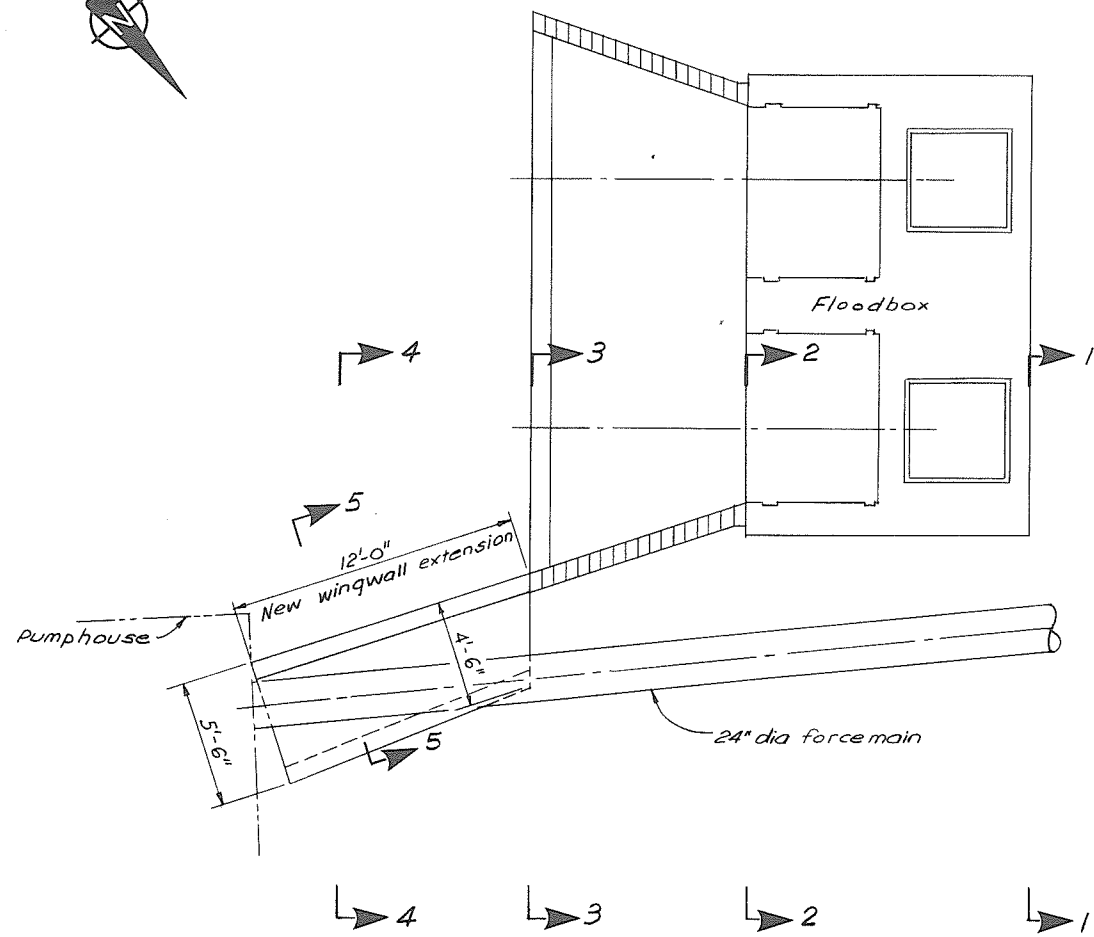


PLAN
Scale: 1/4" = 1'-0"
Backfill not shown

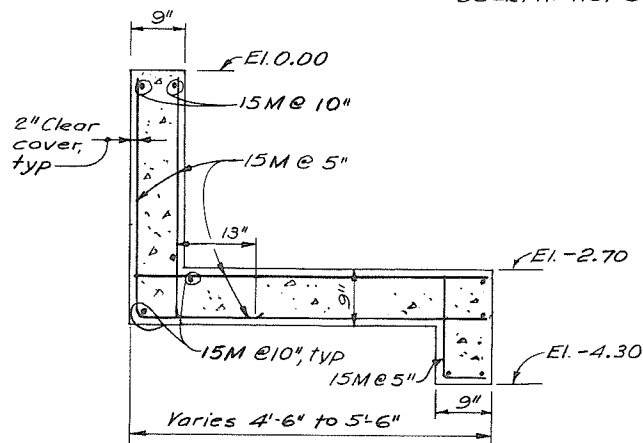


SECTION 5
Scale: 3/4" = 1'-0"

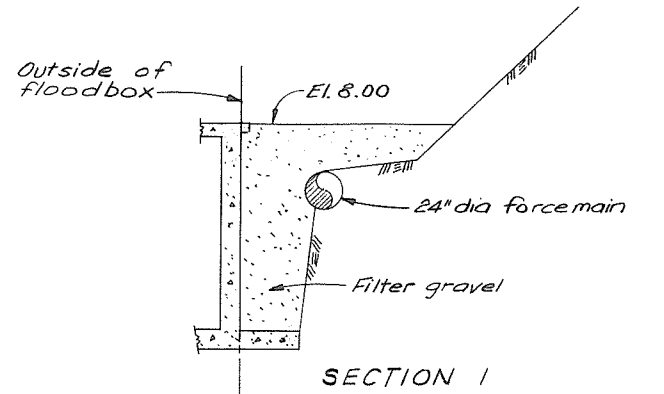


SECTION 1

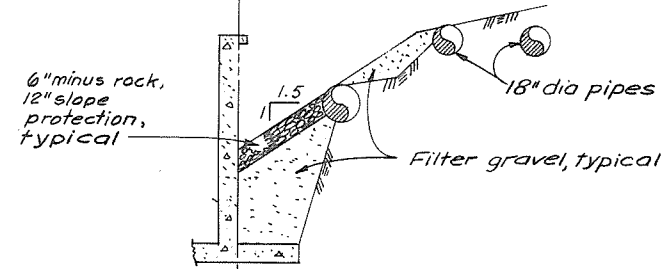

SECTION 2

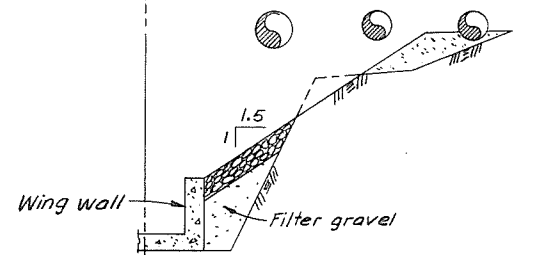

SECTION 3

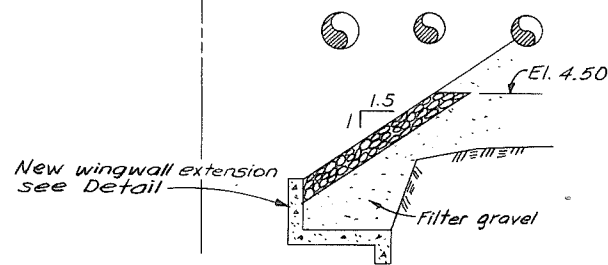

SECTION 4
Scale: 1" = 5'-0"

NOTE

1. Reference Drawings Nos. 4884-3-D9 to D14.



CRIPPEN ENGINEERING LTD.
PROJECT NO. 1040

DEPARTMENT HEAD _____
PROJECT ENGINEER _____
CHIEF ENGINEER *pp John B. Milne*

| NO. | DESCRIPTION | BY | CHK | APPR | DATE |
|-----|----------------|------------|-----------|------|----------|
| 1 | Record Drawing | <i>MHW</i> | <i>jm</i> | | 28-11-85 |

RECOMMENDED *John B. Milne*
PROJECT MANAGER

DATE 12 August 1985

APPROVED *John B. Milne*
DIRECTOR, WATER INVESTIGATIONS


DATE 15 August 1985

BRITISH COLUMBIA
MINISTRY OF THE ENVIRONMENT
WATER INVESTIGATIONS BRANCH
CANADA - BRITISH COLUMBIA

FRASER RIVER FLOOD CONTROL 1988 AGREEMENT


PROJECT 10.4 CONTRACT NO. 2
SOUTH WESTMINSTER FLOOD CONTROL WORKS
PATTULLO FLOODBOX
WINGWALL EXTENSION

| | |
|------------------------|-----------------------------|
| DESIGNED <i>JBM</i> | SURVEYED _____ |
| DRAWN <i>M.H.W.</i> | DATE _____ |
| CHECKED <i>CTL/ACC</i> | FILE NO. _____ |
| SCALE <i>As shown</i> | DATE _____ |
| DWG. NO. 4884-2-D34 R1 | SHEET _____ OF _____ SHEETS |

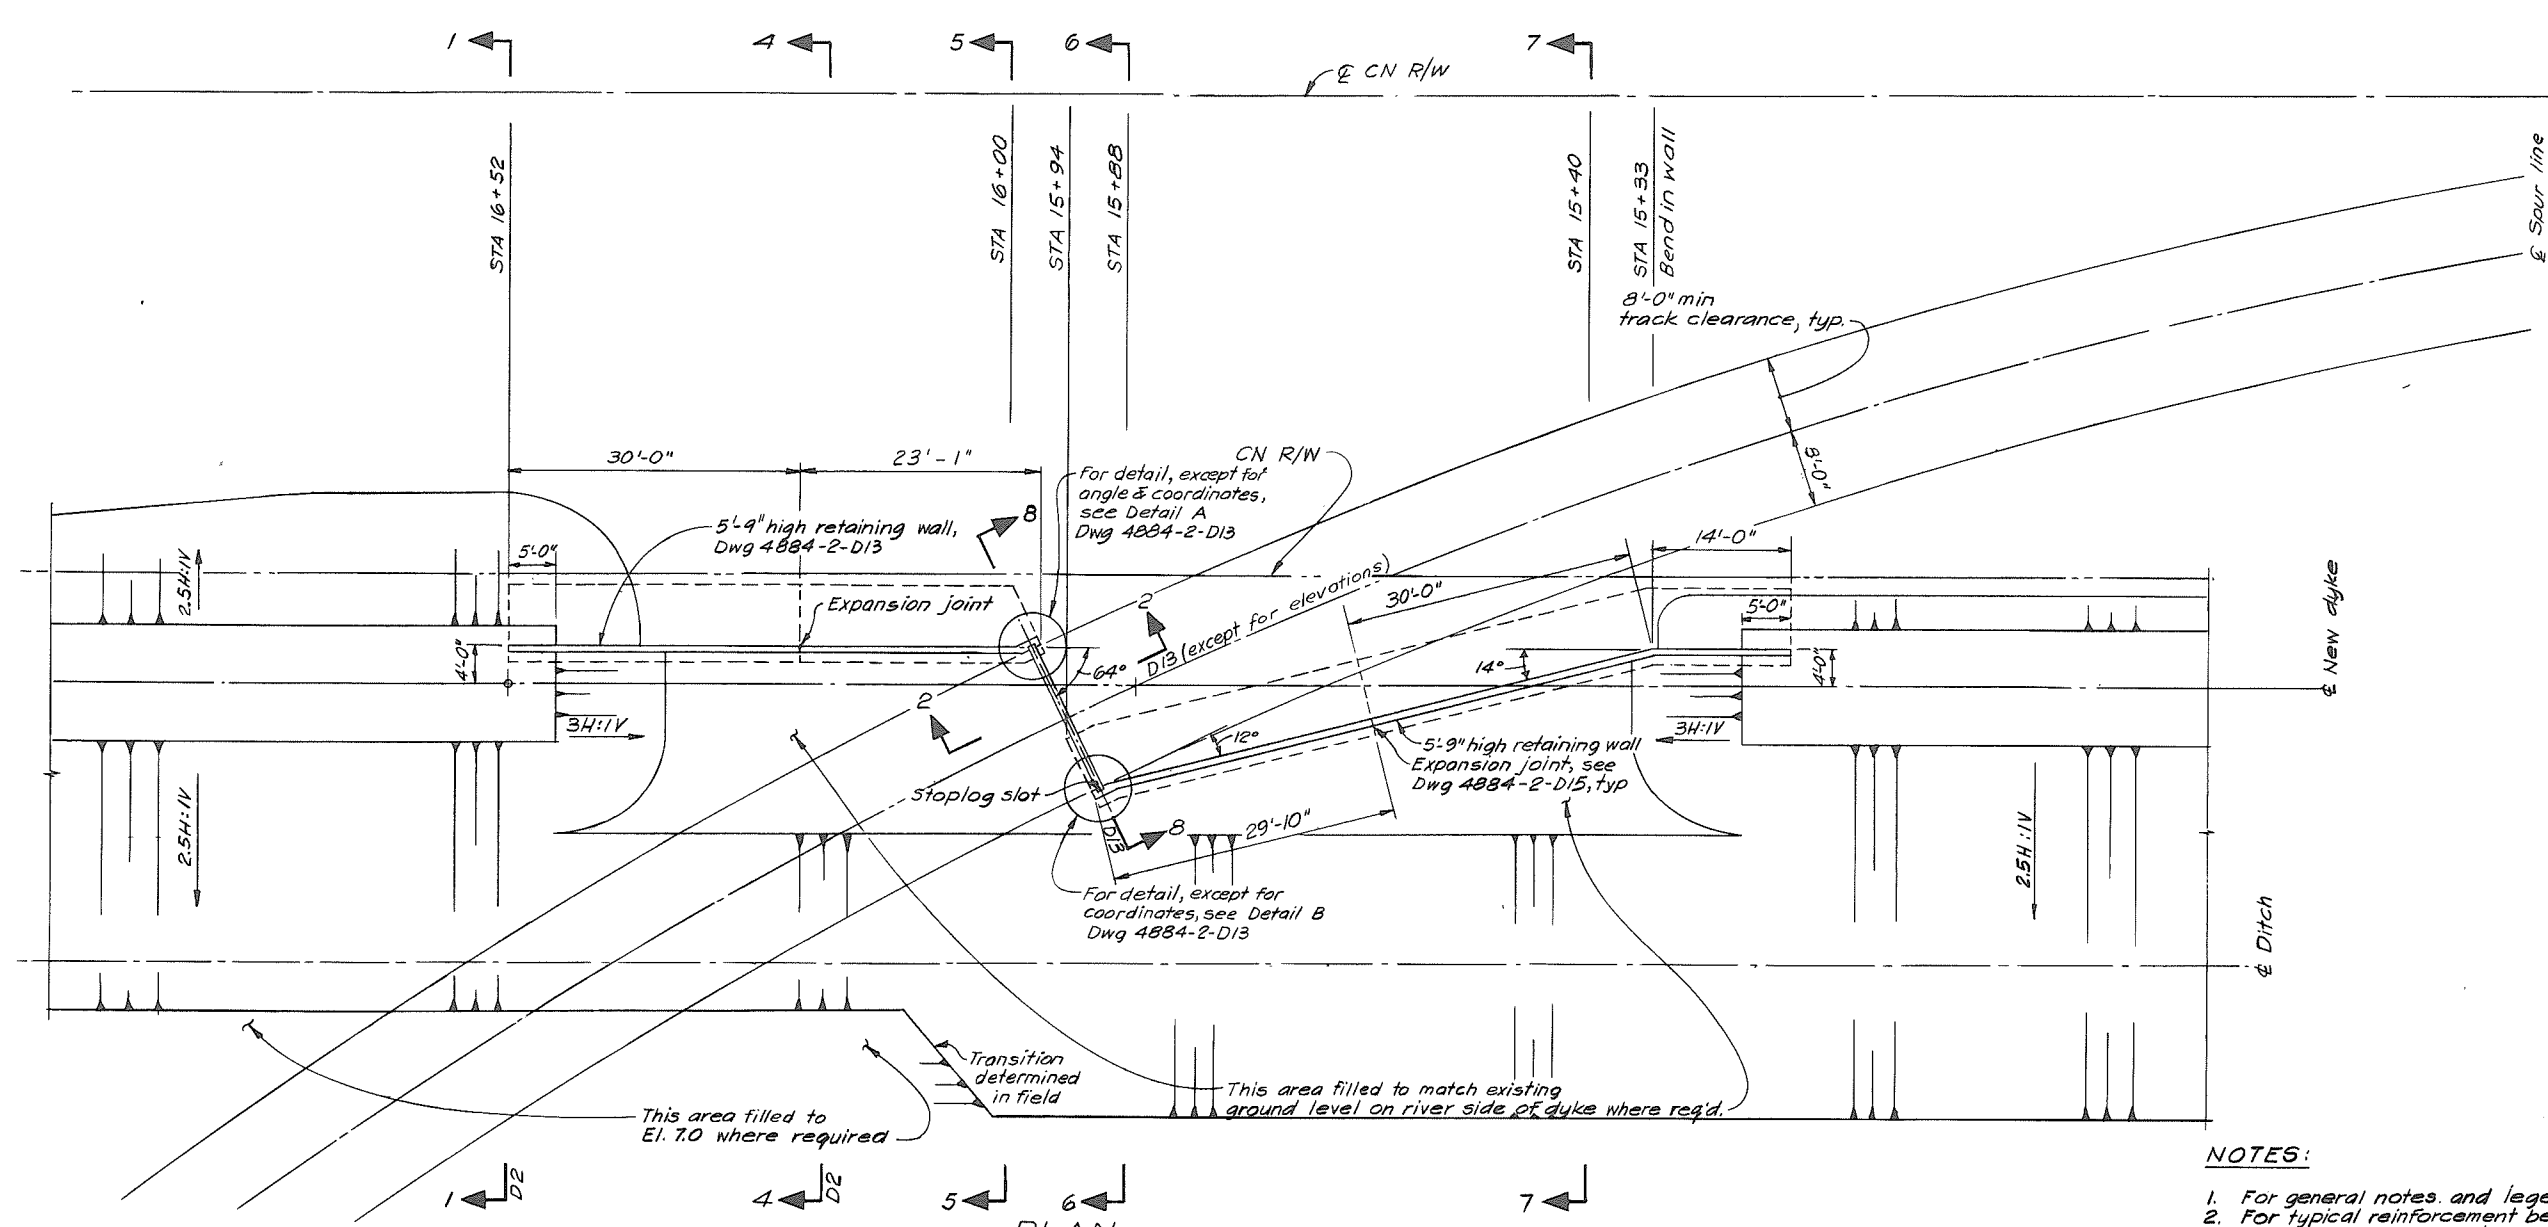


PLAN
Scale 1"=10'


- NOTES:**
1. For general notes and legend see Dwg 4884-2-D3.
 2. For typical reinforcement bands see Dwg 4884-2-D16.
 3. For notes on concrete & reinforcement see Dwg 4884-2-D15.
 4. For note on design see Dwg 4884-2-D12.
 5. For typical detail of dyke wall excavation and structural fill payment lines see Dwg 4884-2-D12.
 6. For concrete wall elevations and connections to dyke see Dwg 2-D3.

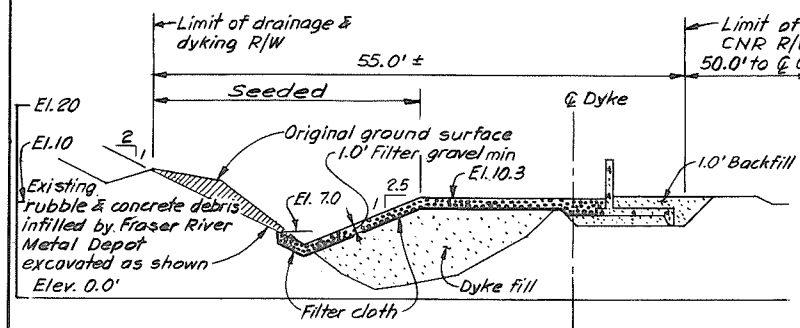

SECTION 5
STA 16+00
Scale 1"=10'

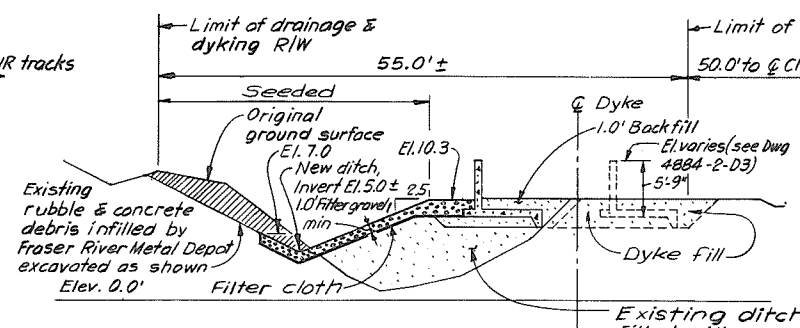

SECTION 6
STA 15+88
Scale 1"=10'

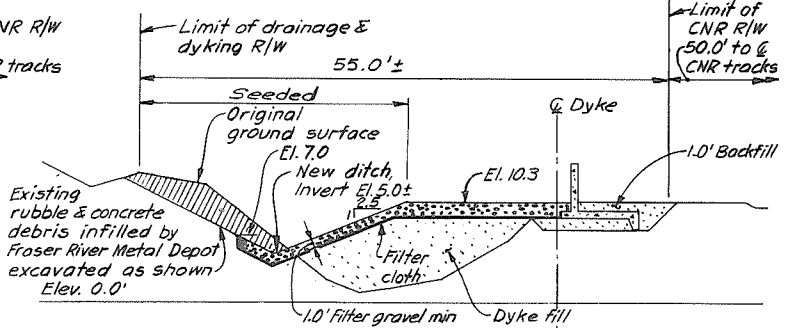

SECTION 7
STA 15+40
Scale 1"=10'

CRIPPEN ENGINEERING LTD.
PROJECT NO. 1040

DEPARTMENT HEAD
PROJECT ENGINEER
CHIEF ENGINEER

John S. Miller
Michael Johnson

1 Record Drawing

| NO. | DESCRIPTION | BY | CHKD | APPR | DATE |
|-----|-------------|----|------|------|------|
| | | | | | |

RECOMMENDED *John S. Miller*
PROJECT MANAGER

DATE 4 April 1985

APPROVED *Bob Jones*
DIRECTOR, WATER INVESTIGATIONS

DATE 12 April 1985

BRITISH COLUMBIA
MINISTRY OF THE ENVIRONMENT
WATER INVESTIGATIONS BRANCH
CANADA-BRITISH COLUMBIA
FRASER RIVER FLOOD CONTROL 1968 AGREEMENT

PROJECT 10.4 CONTRACT NO. 2
SOUTH WESTMINSTER FLOOD CONTROL WORKS
OPENING FOR C.N.R. SPUR LINE TO
FRASER RIVER METALS DEPOT

| DESIGNED | PR.B. | SURVEYED |
|----------|--------------|-------------------------|
| DRAWN | L.S., MP | DATE |
| CHECKED | CTL, RSS | FILE NO. 0281550-C12D-2 |
| SCALE | As shown | DATE |
| DWG. NO. | 4884-2-D33R1 | SHEET OF SHEETS |

APPENDIX I
CONCRETE TEST RESULTS

CONCRETE TEST RESULTS
For Class II - 21 MPa Concrete
In Concrete Dyke Walls

| Test No. | Date Cast | Location | Air % | Slump mm | 7 day Strength MPa | 28 day Strength MPa | Remarks |
|----------|-----------|--|-------|----------|--------------------|---------------------|---------------------------------|
| 3 | 24 Oct 84 | Dyke footings (2+80 to 3+30) (3+80 to 4+30), (4+80 to 5+30), (5+80 to 6+30), (6+80 to 7+30), (7+80 to 8+30), (8+80 to 9+20) and (9+60 to 10+00) (Between Pattullo Floodbox and Old Yale Road Crossing) | 5.0 | 70 | 21.5 | 28.8 | |
| 4 | 25 Oct 84 | Dyke wall footing between Pattullo Floodbox and Old Yale Road Crossing (2+30 to 2+80), (3+30 to 3+80), (4+30 to 4+80), (5+30 to 5+80), (6+30 to 6+80), (7+30 to 7+80), (8+30 to 8+80) and (9+20 to 9+60) | 4.0 | 75 | 21.5 | 30.1 | |
| 6 | 2 Nov 84 | Dyke wall between Pattullo and Old Yale Road Crossing Wall sections (5+80 to 6+30), (6+80 to 7+30), (7+80 to 8+30), (8+80 to 9+20) and (9+60 to 10+00) | 5.0 | 75 | 21.8 | 28.4 | |
| 7 | 8 Nov 84 | Dyke wall between Pattullo Floodbox and Old Yale Road Crossing Wall sections (2+80 to 3+30), (3+80 to 4+30), (4+80 to 5+30), (7+30 to 7+80), (8+30 to 8+80) and (9+20 to 9+60) | 5.1 | 100 | 20.8 | 27.5 | |
| 9 | 16 Nov 84 | Dyke wall between Pattullo and Old Yale Road Crossing | - | 130 | - | - | Concrete rejected (see test 9A) |

CONCRETE TEST RESULTS
Concrete Dyke Walls - (Cont'd)

| Test No. | Date Cast | Location | Air % | Slump mm | 7 day Strength MPa | 28 day Strength MPa | Remarks |
|----------|-----------|--|-------|----------|--------------------|---------------------|--------------------------------|
| | | | | | | | |
| 9A | 16 Nov 84 | Dyke wall between Pattullo Floodbox and Old Yale Road Crossing Wall Sections (2+30 to 2+80), (3+30 to 3+80), (4+30 to 4+80), (5+30 to 5+80) and (6+30 to 6+80) | - | 65 | 20.7 | 26.95 | |
| 12 | 29 Jan 85 | Manson Road Dyke Footings sections | 4.9 | 80 | 23.2 | 32.15 | |
| 13 | 14 Feb 85 | Manson Road Dyke Wall sections | 4.8 | 90 | 20.0 | 25.4 | |
| 14 | 20 Feb 85 | 124th Street Dyke Wall section | 4.0 | 60 | 22.1 | 27.0 | |
| 15 | 14 May 85 | 126A Street Dyke Footing sections 2 x 35' long | 6.0 | 60 | - | 24.8 | 2 cylinders damaged by vandals |
| 16 | 16 May 85 | 126A Steet Dyke Walls sections 2 x 35' long | 5.7 | 70 | 17.6 | 23.85 | |
| 17 | 17 May 85 | 126A street Crossing Footing | 5.5 | 70 | 17.3 | 24.35 | |
| 18 | 24 May 85 | Dyke wall between Pattullo Floodbox and Old Yale Road Crossing Footing Station 10+00 to 10+31.79 | 4.5 | 50 | 21.0 | 26.55 | |

CONCRETE TEST RESULTS
Concrete Dyke Walls - (Cont'd)

| Test No. | Date Cast | Location | Air % | Slump mm | 7 day Strength MPa | 28 day Strength MPa | Remarks |
|----------|-----------|---|-------|----------|--------------------|---------------------|---------|
| 19 | 28 May 85 | Retaining wall for proposed CNR Spurline into Fraser River Metals Depot Wall section (15+19 to 15+63) and (16+22 to 16+52) retaining wall footing at CNR Spurline between Station 22+24 and 23+83.8 Station 23+21 to 23+53.8 | 3.7 | 50 | 22.0 | 29.85 | |
| 20 | 29 May 85 | 5'9" high retaining walls at spurlines Wall section (15+98.9 to 16+22) footing sections (22+70.5 to 23+14.1) | 3.9 | 100 | 17.8 | 24.55 | |
| 21 | 31 May 85 | Retaining wall footing sections at (22+24 to 22+70.5) and (23+53.8 to 23+83.8) Wall sections (15+98.9 to 16+22) and (22+70.5 to 23+14.1) | 5.8 | 60 | 18.1 | 26.2 | |
| 22 | 3 June 85 | Old Yale Road Crossing footing | 5.5 | 80 | 16.9 | 23.7 | |
| 23 | 5 June 85 | Capilano Timber Crossing footing Wall 10+00 to 10+31.79 | 5.5 | 50 | 22.6 | 29.25 | |

CONCRETE TEST RESULTSConcrete Dyke Walls - (Cont'd)

| Test No. | Date Cast | Location | Air % | Slump mm | 7 day Strength MPa | 28 day Strength MPa | Remarks |
|----------|------------|---|-------|----------|--------------------|---------------------|--------------------------------|
| 24 | 6 June 85 | Old Yale Road Crossing Walls | 5.7 | 70 | 18.3 | 25.05 | |
| 25 | 10 June 85 | Capilano Timber Crossing Walls | 6.1 | 40 | 20.7 | 28.4 | |
| 26 | 13 June 85 | Dyke between Pattullo Floodbox and Old Yale Road Footing section (1+80 to 2+30) | - | - | 17.2 | 23.35 | Slump & Air not tested |
| 30 | 12 July 85 | Dyke between Pattullo Floodbox and Old Yale Road Wall section (1+80 to 2+30) | 5.5 | 50 | 23.9 | 30.75 | Class I 28 MPa concrete placed |
| 31 | 24 July 85 | Dyke wall between Old Yale Road and Capilano Timber Crossing - Footing section close to Old Yale Road | 5.5 | 85 | 22.7 | 29.65 | Class I 28 MPa concrete placed |
| 38 | 28 Aug 85 | Retaining wall through Weldwood Mill Footing EI -2.0' to -1.0' | - | 45 | 25.1 | 32.15 | Air not tested |
| 41 | 4 Sept 85 | Retaining wall through Weldwood Mill Wall section from EI -1.0' to +7.3' | 3.5 | 65 | 25.1 | 34.55 | |
| 42 | 17 Sept 85 | Retaining wall through Weldwood Mill Wall section from EI +7.3' to +14.0' Footing dyke wall either side of Other Ramp west of Weldwood Mill | 3.3 | 40 | 20.6 | 32.05 | |

CONCRETE TEST RESULTSConcrete Dyke Walls - (Cont'd)

| Test No. | Date Cast | Location | Air % | Slump mm | 7 day Strength MPa | 28 day Strength MPa | Remarks |
|----------|------------|---|-------|----------|--------------------|---------------------|----------------|
| 43 | 20 Sept 85 | Dyke wall west of Weldwood Mill Footing west of Railway Ramp Walls either side of Wharf Ramp | 5.0 | 30 | 24.6 | 31.95 | |
| 44 | 20 Sept 85 | Dyke wall west of Pattullo Floodbox footing 0+80 to 1+30 Dyke wall east of Pattullo Floodbox (0+20 to 0+30) | 4.5 | 40 | 23.9 | 32.75 | |
| 45 | 8 Oct 85 | Retaining wall through Weldwood Mill Footing at west end from elevation -2.0' to -1.0' | - | 85 | 24.3 | 31.9 | Air not tested |
| 46 | 8 Oct 85 | Dyke wall west of Pattullo Floodbox Footing (0+30 to 0+80) | - | 65 | 21.6 | 30.75 | Air not tested |
| 47 | 11 Oct 85 | Retaining wall through Weldwood Mill Wall section at west end from EI -1.0' to EI +7.3' Wall dyke wall west of Railway Ramp | - | 80 | 21.1 | 29.7 | Air not tested |
| 48 | 11 Oct 85 | Dyke wall west of Pattullo Floodbox Wall section (0+30 to 0+80) | - | 75 | 23.7 | 32.3 | Air not tested |
| 49 | 29 Oct 85 | Dyke wall west of Weldwood Mill Footing west of Mill Wall east of Railway Ramp | - | 65 | 25.1 | 37.15 | Air not tested |

CONCRETE TEST RESULTS

Concrete Dyke Walls - (Cont'd)

| Test No. | Date Cast | Location | Air % | Slump mm | 7 day Strength MPa | 28 day Strength MPa | Remarks |
|----------|-----------|--|-------|----------|--------------------|---------------------|---------|
| 50 | 31 Oct 85 | Dyke wall west of Weldwood Mill Wall west of Mill EI +8.83 to +14.0' | 5.9 | 90 | 20.5 | 30.3 | |

CONCRETE TEST RESULTS
For Class 1 - 28 MPa Concrete
In 124th Street Floodbox

| Test No. | Date Cast | Location | Air % | Slump mm | Strength MPa | | Remarks |
|----------|-----------|---|-------|----------|--------------|--------|----------------|
| | | | | | 7 day | 28 day | |
| 5 | 2 Nov 85 | Base slab for Outlet Structure | 5.2 | 60 | 25.6 | 33.7 | |
| 8 | 9 Nov 85 | Base slab for Inlet Structure and apron slab. | - | 85 | 14.8 | 28.55 | Air not tested |
| 10 | 22 Nov 85 | Inlet Structure walls | 3.0 | 80 | 22.9 | 31.45 | |
| 11 | 22 Nov 85 | Outlet Structure walls | 3.5 | 65 | 23.7 | 31.15 | |

CONCRETE TEST RESULTS
For Class I - 28 MPa Concrete

In Pattullo Floodbox

| Test No. | Date Cast | Location | Air % | Slump mm | Strength MPa | | Remarks |
|----------|------------|---|-------|----------|--------------|--------|---------|
| | | | | | 7 day | 28 day | |
| 27 | 21 June 85 | Base slab for Outlet Structure and apron slab at outlet | 5.0 | 100 | 22.4 | 27.75 | |
| 28 | 11 July 85 | Walls for Outlet Structure | 4.3 | 75 | 24.5 | 31.6 | |
| 29 | 11 July 85 | Base slab for Inlet Structure and apron slab at Inlet | 4.5 | 70 | 22.8 | 32.1 | |
| 31 | 24 July 85 | Walls for Inlet Structure | 5.5 | 85 | 22.7 | 29.65 | |

CONCRETE TEST RESULTS
For Class 1 - 28 MPa Concrete
In Manson Floodbox

| Test No. | Date Cast | Location | Air % | Slump mm | 7 day Strength MPa | 28 day Strength MPa | Remarks |
|----------|-----------|--|-------|----------|--------------------|---------------------|---------|
| 32 | 6 Aug 85 | Base slab for Outlet Structure and alternate base slabs for conduit sections. Also inlet apron slab. | 4.9 | 60 | 24.6 | 31.35 | |
| 33 | 6 Aug 85 | Base slab for Outlet Structure and alternate base slabs for conduit sections. Also inlet apron slab. | 4.8 | 65 | 24.8 | 30.6 | |
| 34 | 8 Aug 85 | Base slab for Inlet Structure and alternate base slabs for conduit sections. Also outlet apron slab. | 4.7 | 60 | 26.3 | 32.85 | |
| 35 | 8 Aug 85 | Base slab for Inlet Structure and alternate base slabs for conduit sections. Also outlet apron slab. | 5.1 | 70 | 25.9 | 35.75 | |
| 36 | 21 Aug 85 | Walls and suspended roof slab for Inlet Structure and alternate conduit sections. | 6.0 | 70 | 27.2 | 31.6 | |
| 37 | 21 Aug 85 | Walls and suspended roof slab for Inlet Structure and alternate conduit sections. | 5.9 | 65 | 29.3 | 34.35 | |
| 39 | 3 Sept 85 | Walls and suspended roof slab for Outlet Structure and alternate conduit sections | 5.5 | 60 | 27.6 | 33.3 | |

CONCRETE TEST RESULTS

Manson Floodbox - (Cont'd)

| Test No. | Date Cast | Location | Air % | Slump mm | 7 day Strength MPa | 28 day Strength MPa | Remarks |
|----------|-----------|---|-------|----------|--------------------|---------------------|---------|
| 40 | 3 Sept 85 | Walls and suspended roof slab for Outlet Structure and alternate conduit sections | 5.3 | 40 | 24.6 | 30.7 | |

APPENDIX 2
DYKE MATERIALS

APPENDIX 2
DYKE MATERIALS


APPENDIX 2

DYKE MATERIALS - CONTRACT NO. 2

- 2.1 Dyke Fill - Grain Size Distribution
- 2.2 Filter Gravel - Grain Size Distribution
- 2.3 Base Course - Grain Size Distribution
- 2.4 Dyke Surfacing - Grain Size Distribution

UNIFIED SOIL CLASSIFICATION SYSTEM

| | | | | | |
|------|------|--------|--------|------|----------|
| SILT | SAND | | GRAVEL | | BOULDERS |
| | FINE | MEDIUM | COARSE | FINE | |

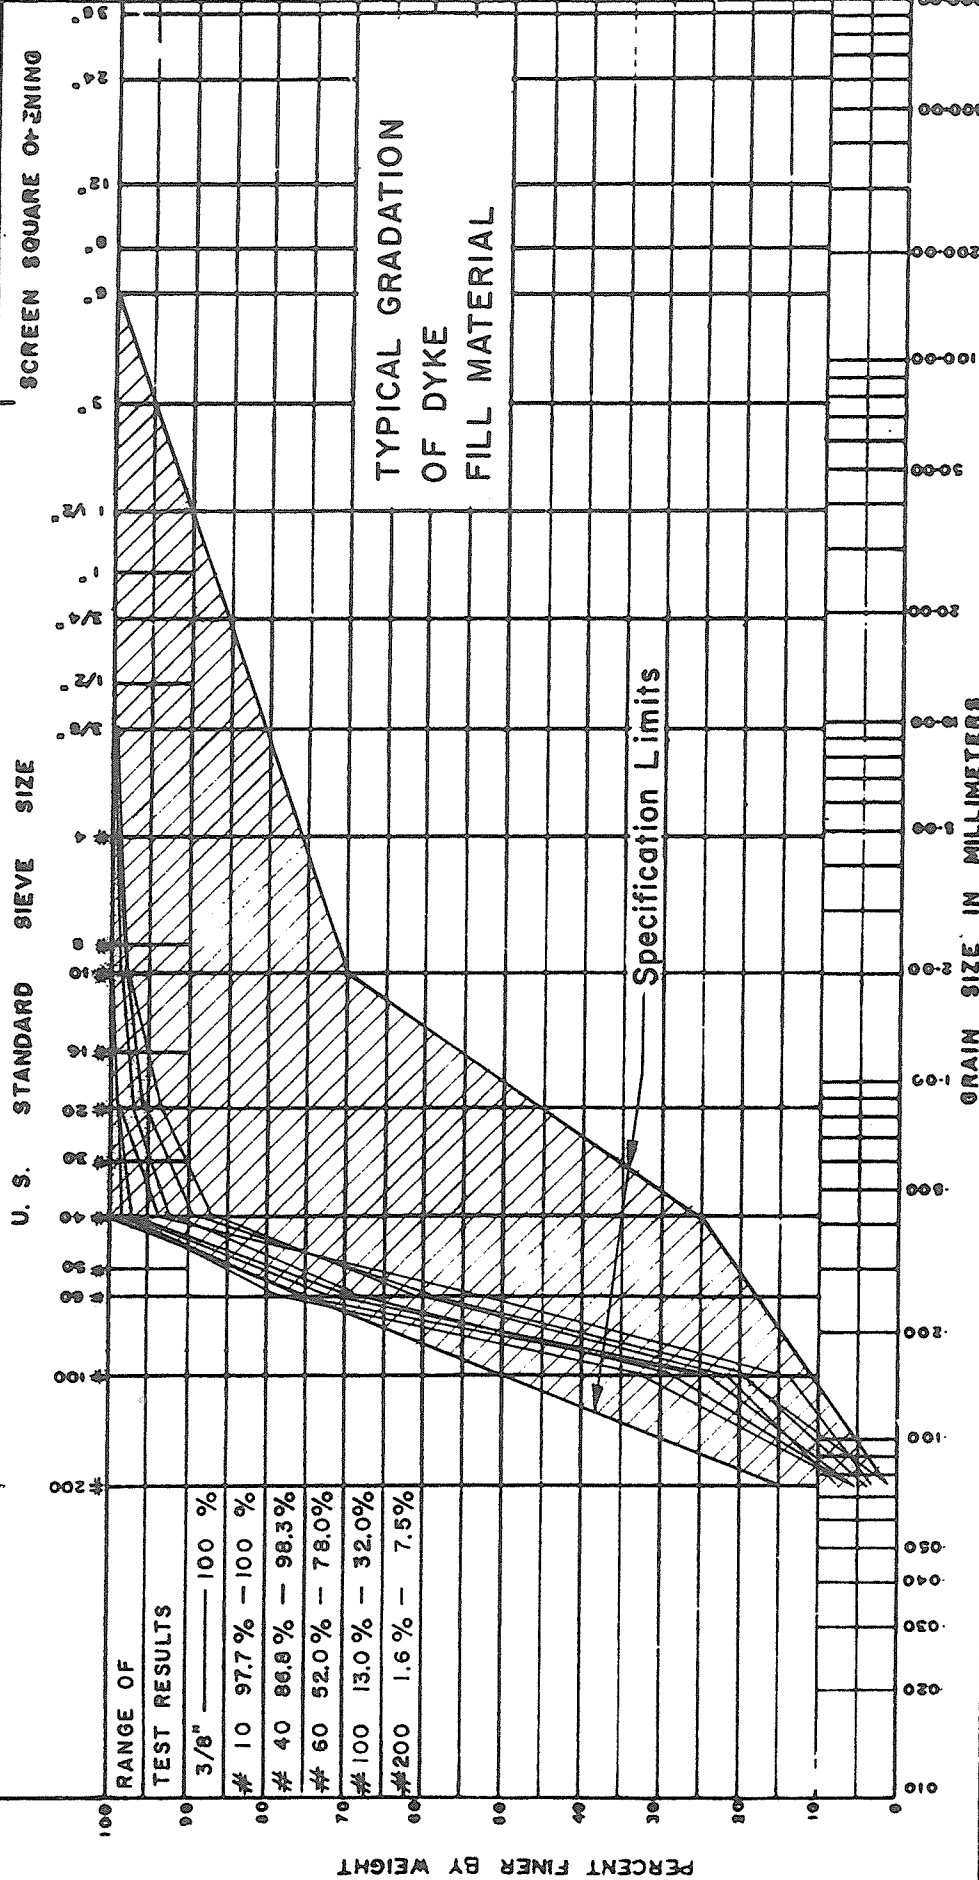

% SILT _____ % SAND _____ % GRAVEL _____
 % COBBLES _____ % BOULDERS _____

CRIPPEN CONSULTANTS


REMARKS _____

GRAIN SIZE DISTRIBUTION

PROJECT SOUTH WESTMINSTER DYKE AND
 FLOODBOX CONSTRUCTION
 CONTRACT NO. 2

MATERIAL DYKE FILL

TESTED BY A.S./R.H. DATE Aug 1984 / Nov 1985

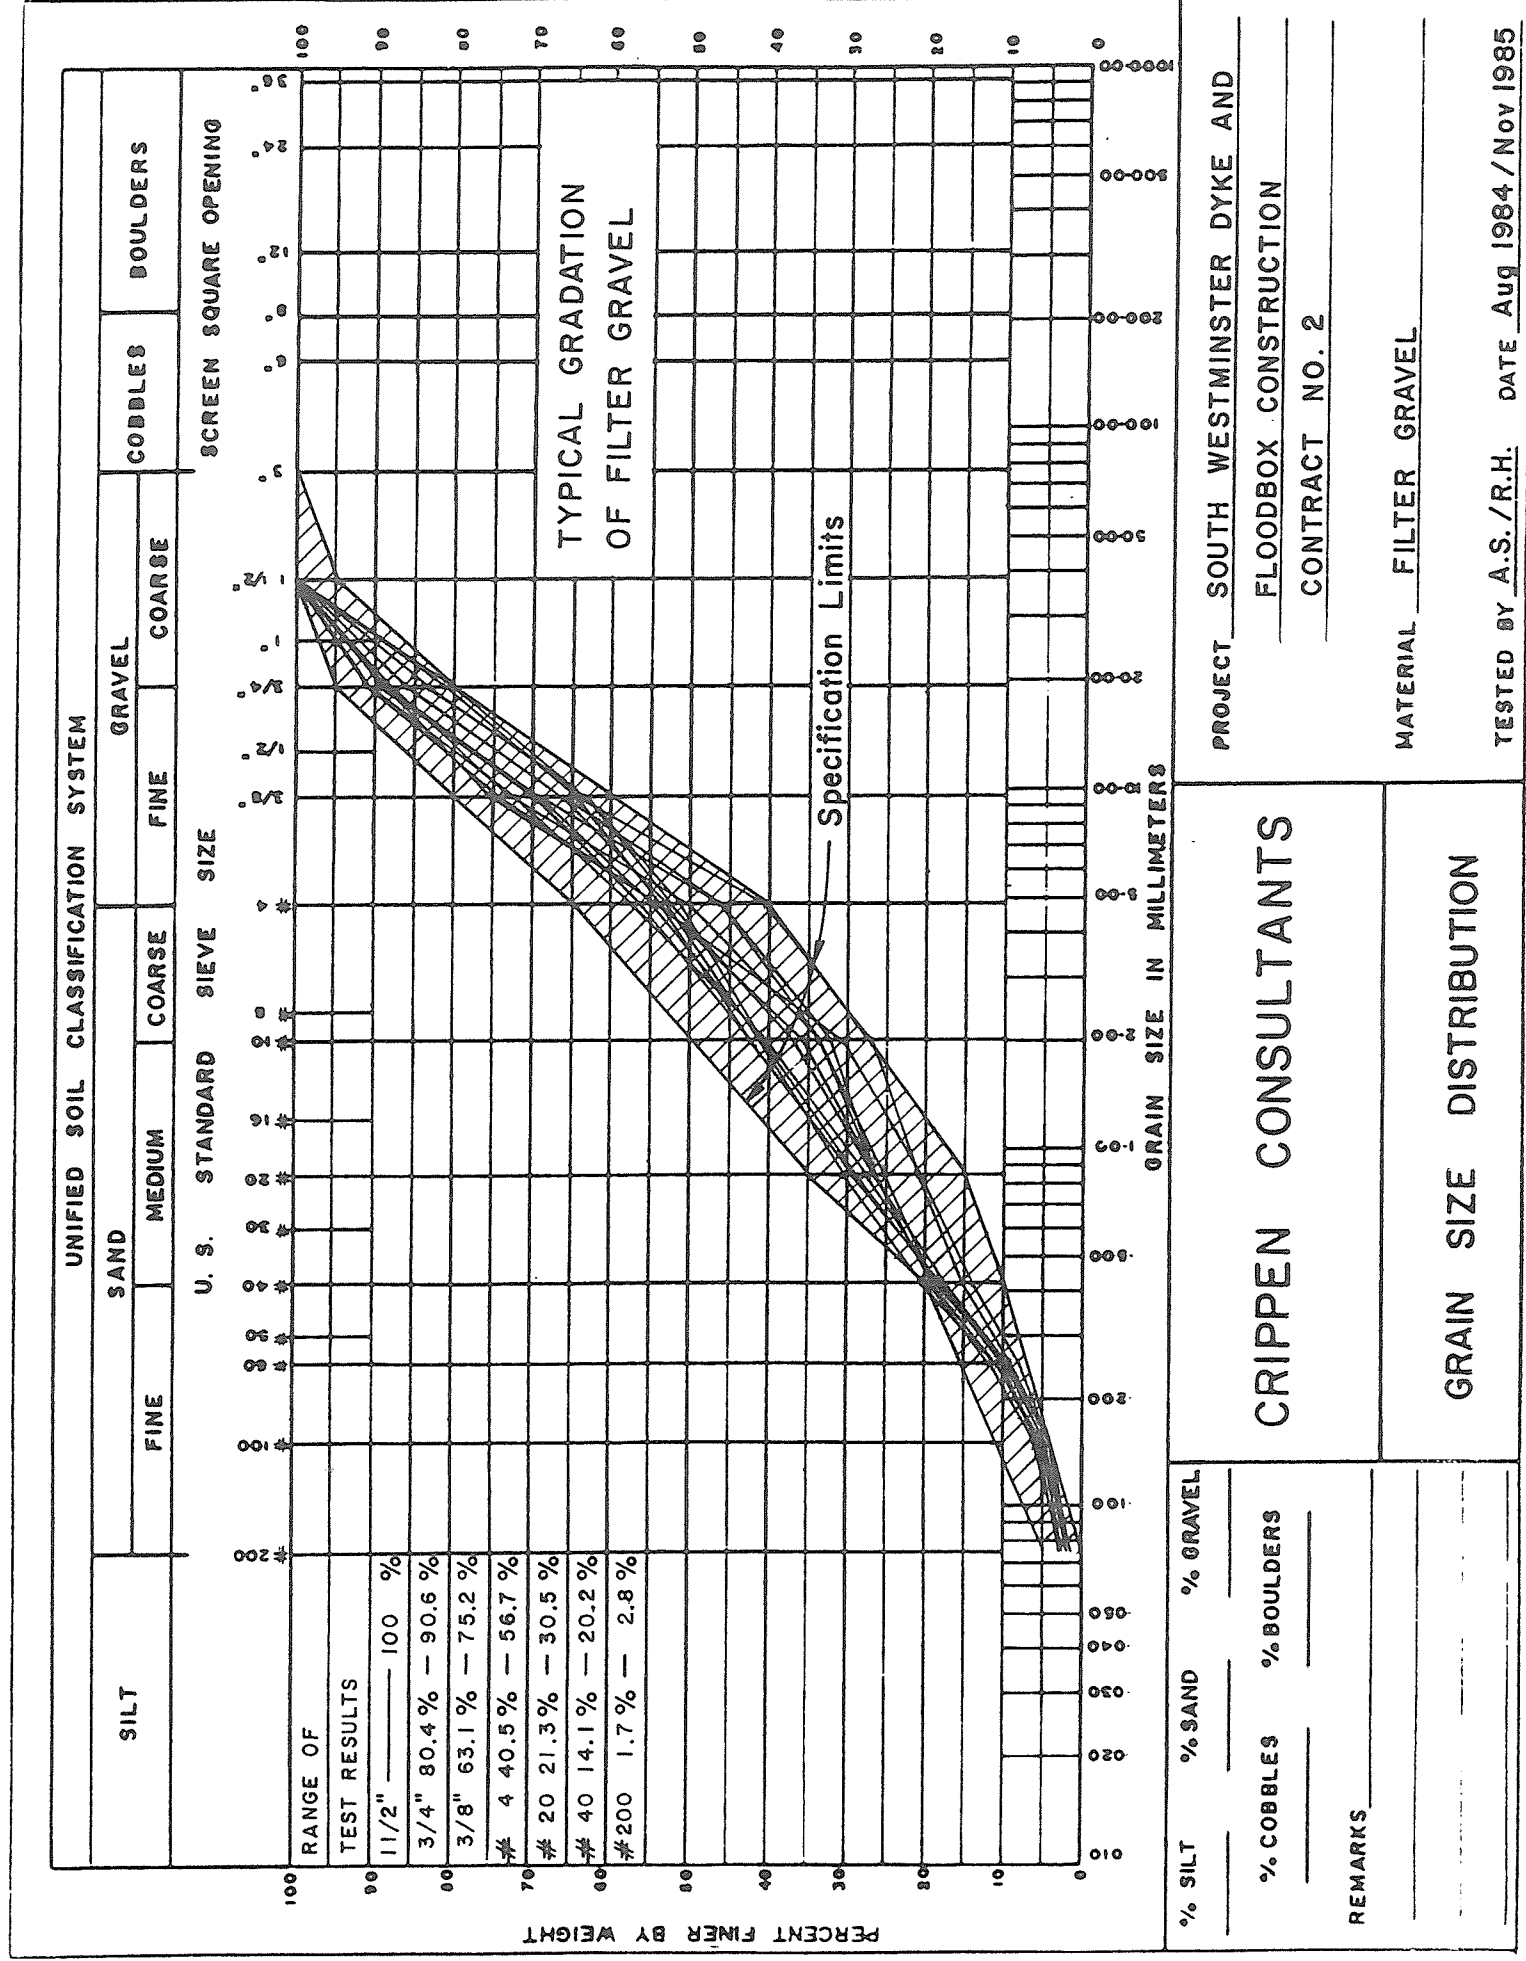

PROJECT SOUTH WESTMINSTER DYKE AND FLOODBOX CONSTRUCTION
 CONTRACT NO. 2

MATERIAL FILTER GRAVEL

TESTED BY A.S./R.H. DATE Aug 1984/Nov 1985

CRIPPEN CONSULTANTS

GRAIN SIZE DISTRIBUTION

% SILT _____ % SAND _____ % GRAVEL _____

% COBBLES _____ % BOULDERS _____

REMARKS _____

FIG. 2.2


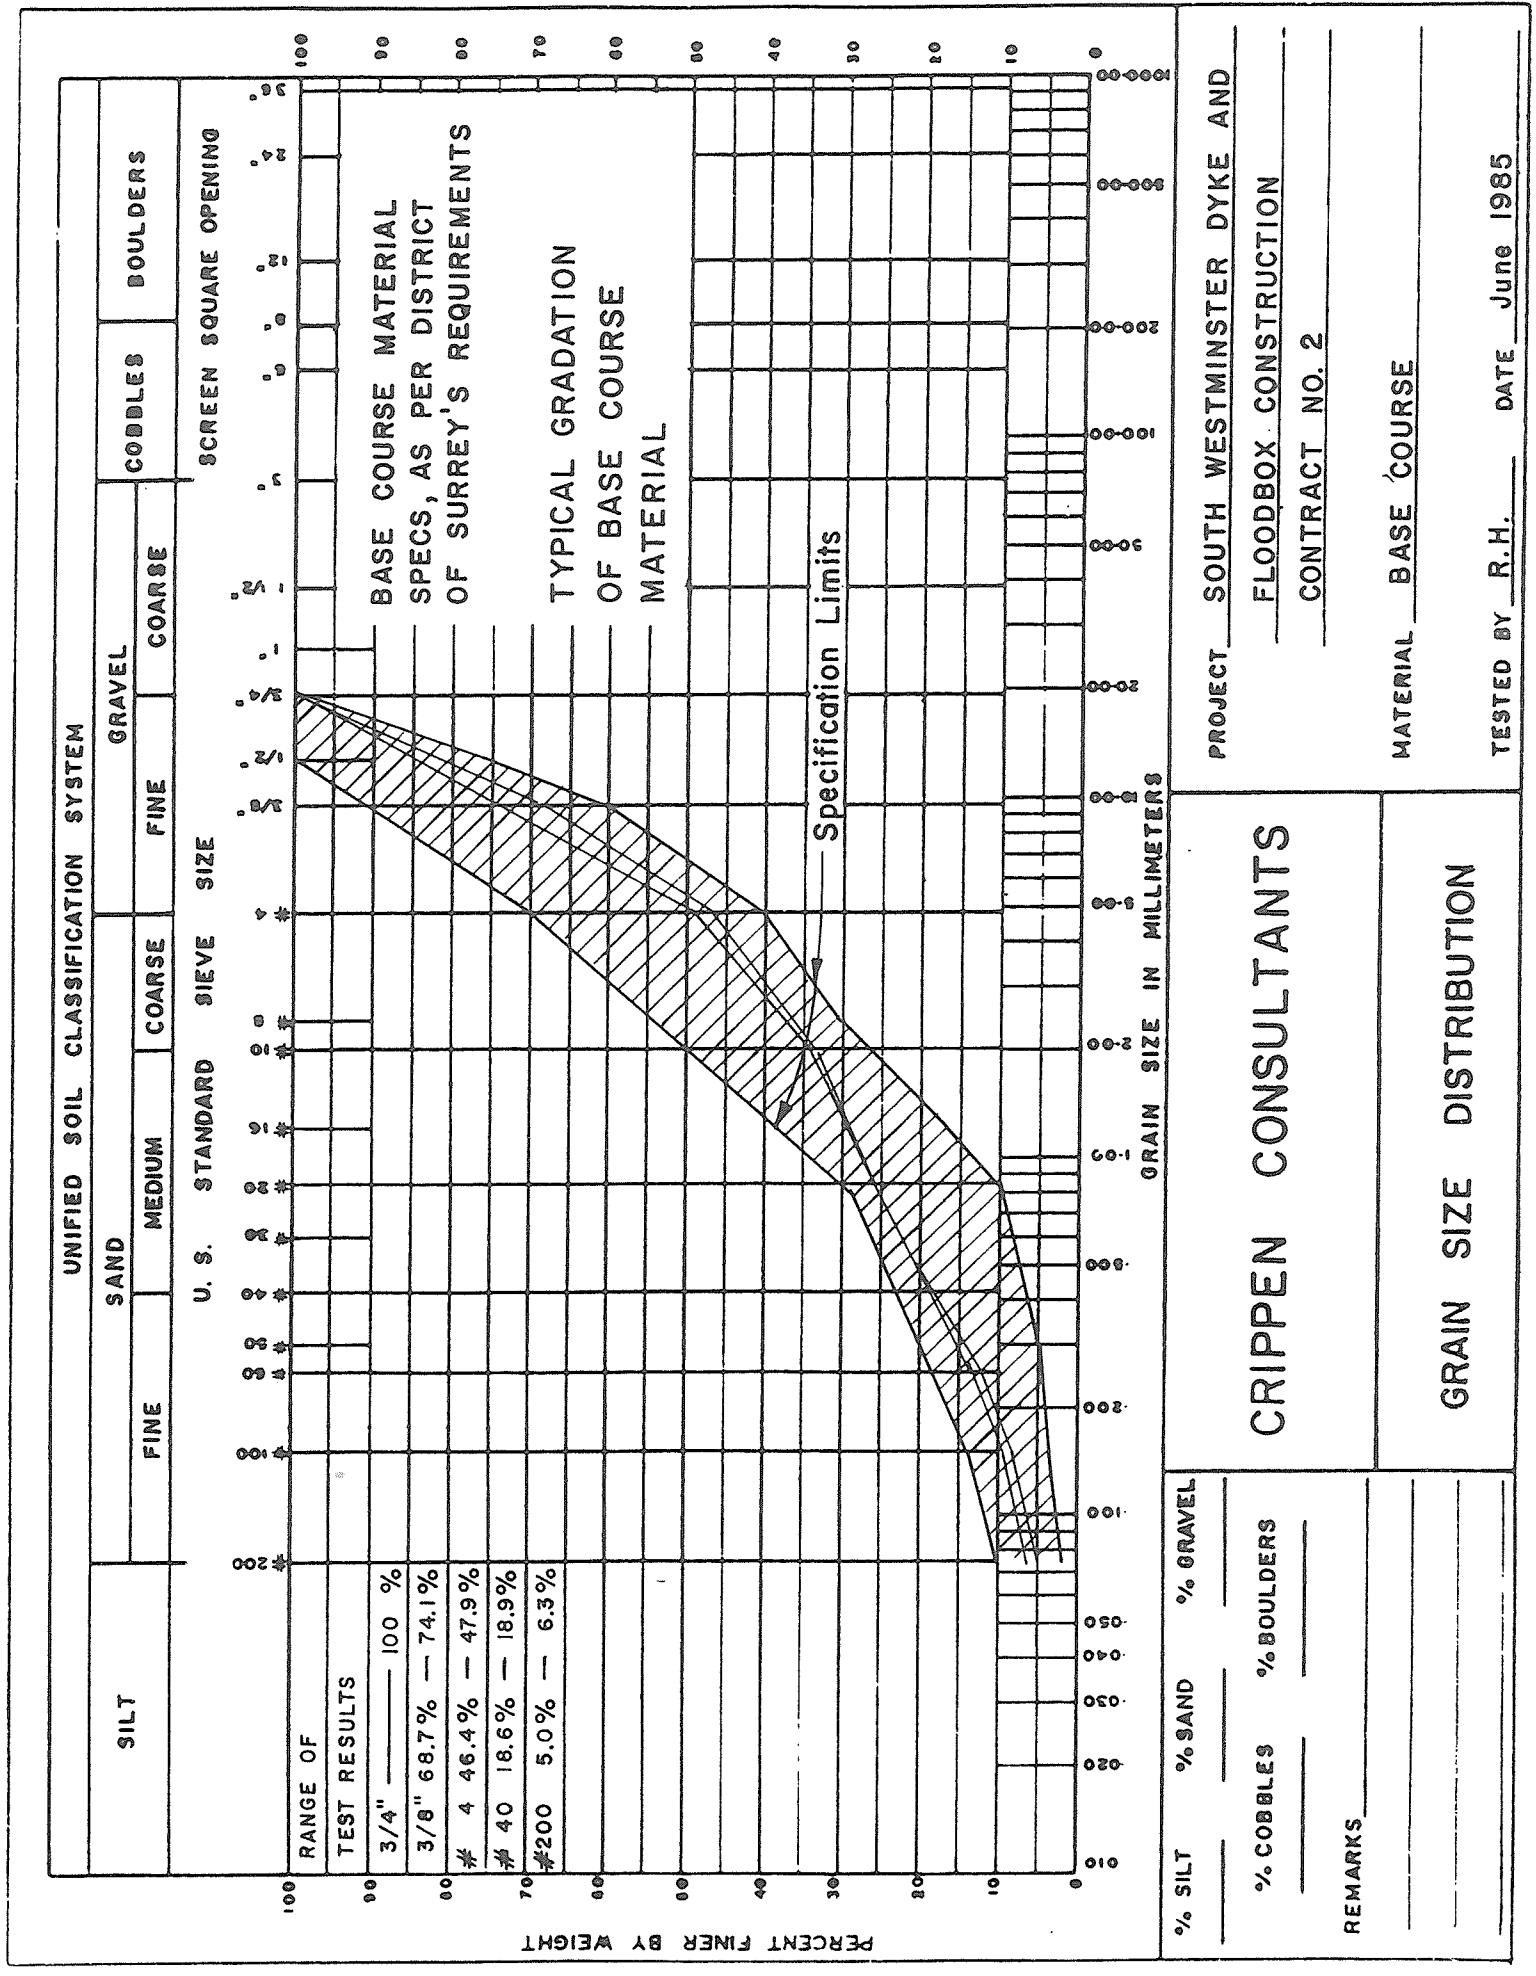


FIG. 2.3

UNIFIED SOIL CLASSIFICATION SYSTEM

| | | | | | |
|------|------|--------|--------|------|----------|
| SILT | SAND | | GRAVEL | | BOULDERS |
| | FINE | MEDIUM | COARSE | FINE | |

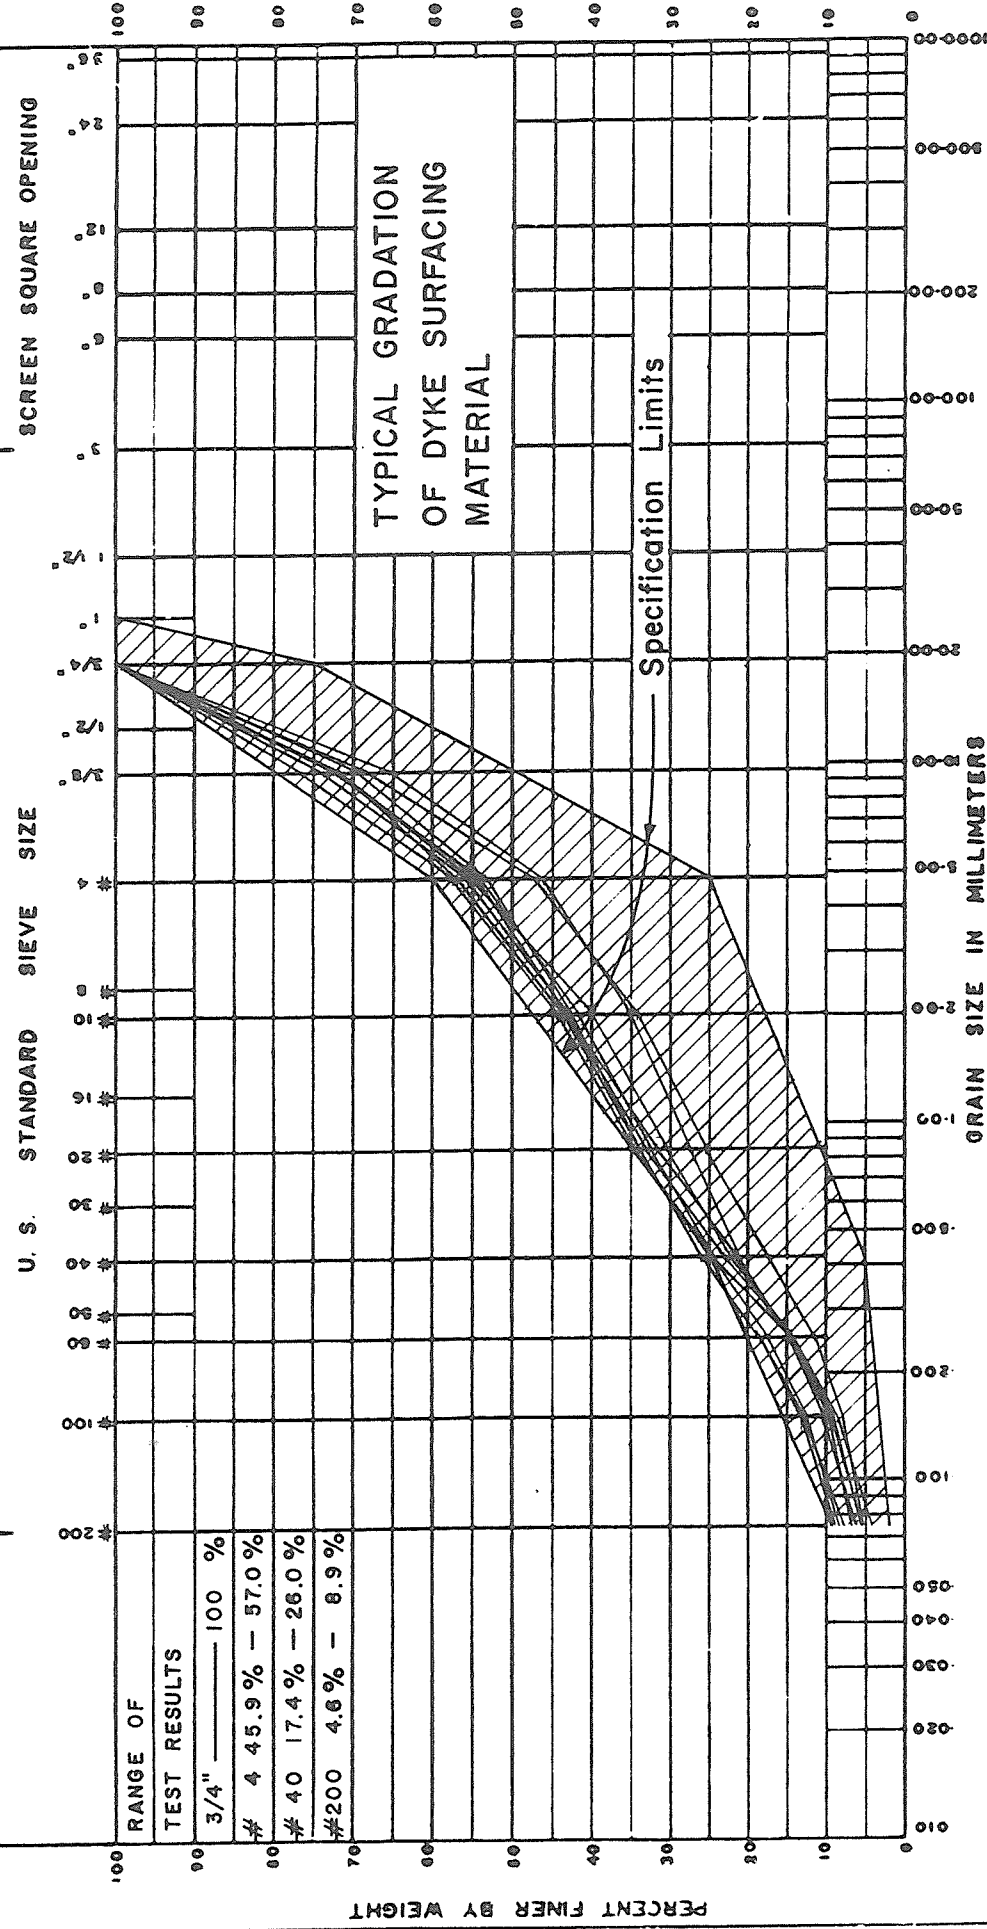

% SILT _____ % SAND _____ % GRAVEL _____
 % COBBLES _____ % BOULDERS _____

CRIPPEN CONSULTANTS

PROJECT SOUTH WESTMINSTER DYKE AND FLOODBOX CONSTRUCTION
 CONTRACT NO. 2

REMARKS _____

GRAIN SIZE DISTRIBUTION

MATERIAL DYKE SURFACING
 TESTED BY R.H. DATE Nov 1984/Nov 1985


FIG. 2.4

APPENDIX 3
INSTRUMENTATION

APPENDIX 3


INSTRUMENTATION - CONTRACT NO. 2

- 3.1 Manson Road - Preload Fill Settlement
- 3.2 Dyke Fill - Moisture Density Relationship
- 3.3 Lateral Movement Gauge S1 - 124th Street Floodbox Excavation, North of CNR Tracks - Final Readings
- 3.4 Lateral Movement Gauge S3 - Pattullo Floodbox Excavation, North of CNR Tracks - Final Readings
- 3.5 Lateral Movement Gauge S4 - 124th Street Floodbox Excavation, South of CNR Tracks - Final Readings
- 3.6 Profile of 72" Diameter Pipe at 124th Street Floodbox
- 3.7 Settlement points on Piers of Trestle Bent - CNR/PWC Trestle by Pattullo Floodbox
- 3.8 Plan - CNR/PWC Trestle Settlement points

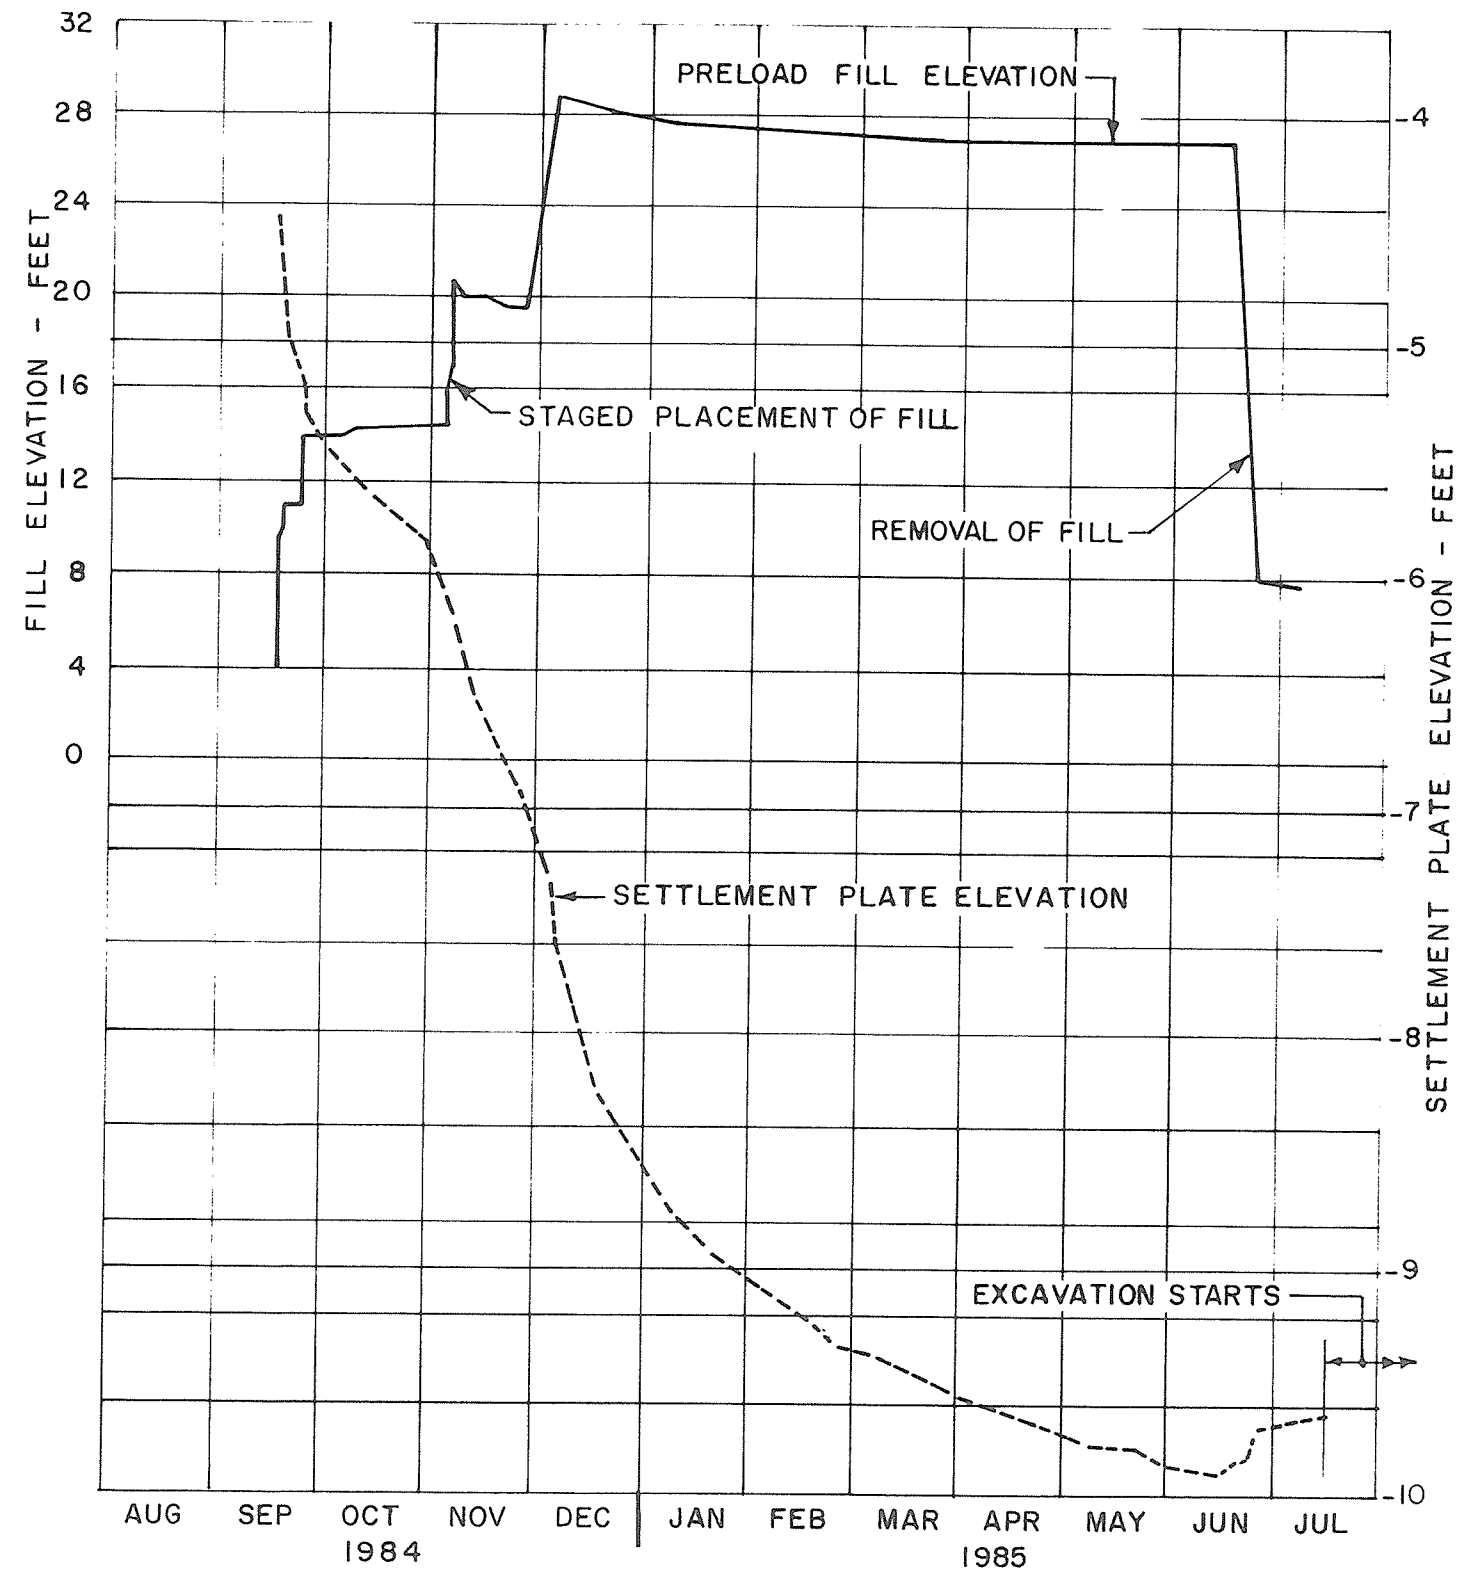

SETTLEMENT PLATE NO.6 - Typical


DYKE FILL MATERIAL - CONTRACT 2

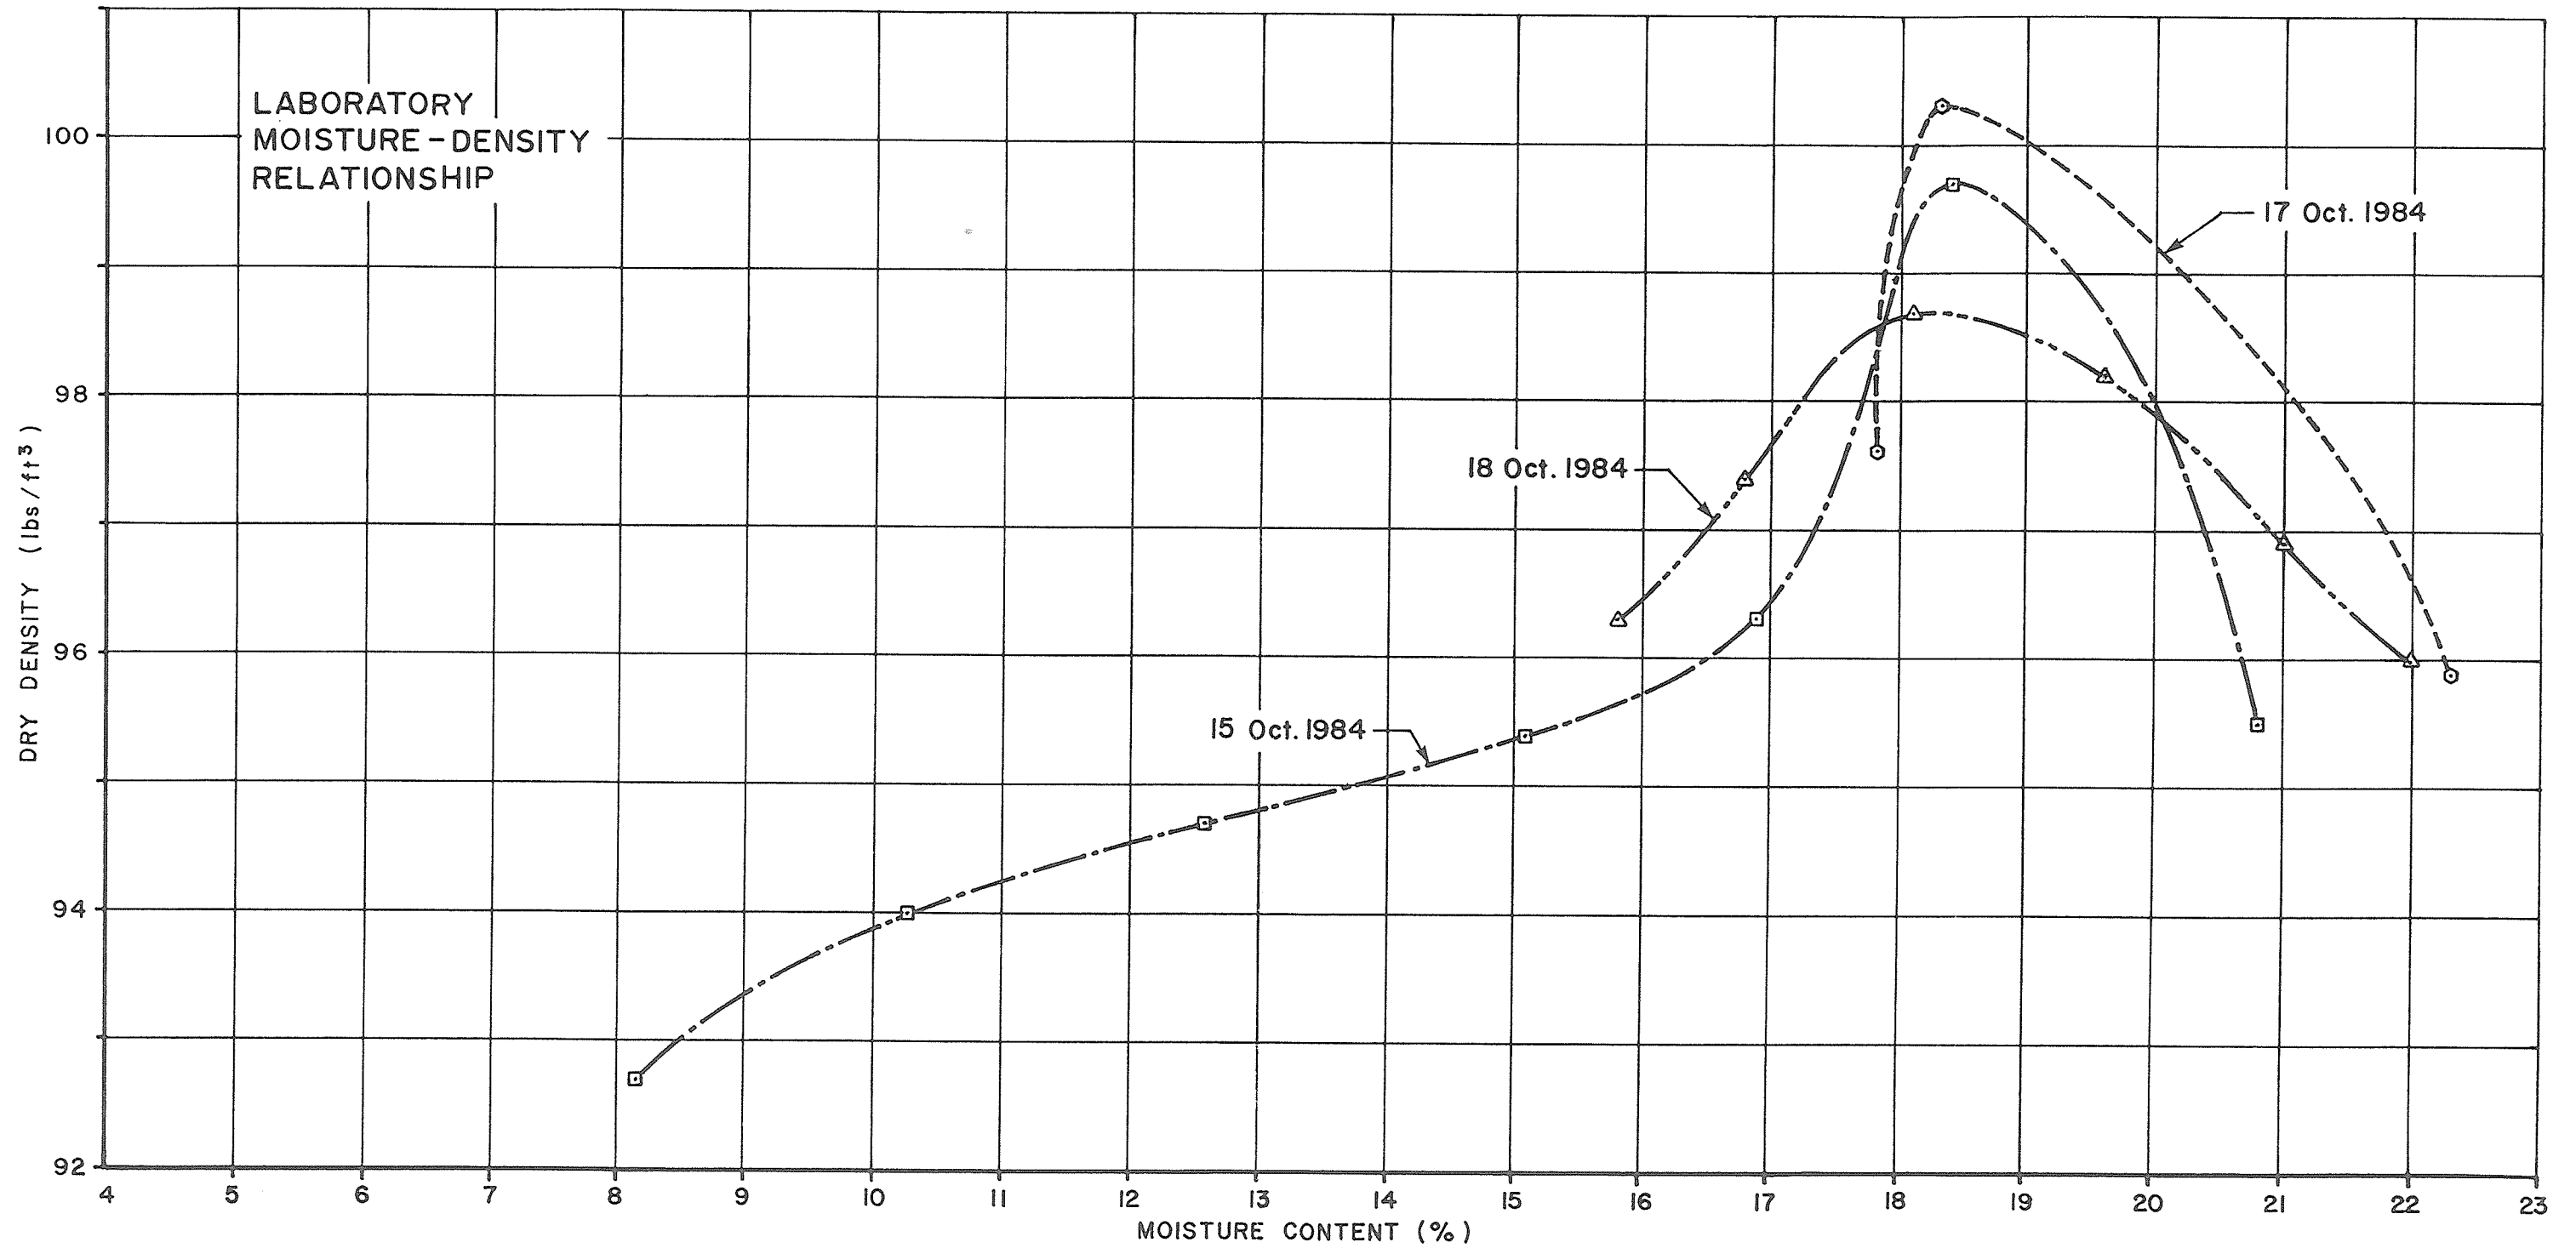

NOTE
LABORATORY TEST RESULTS UNRELIABLE AT HIGHER MOISTURE CONTENTS DUE TO LEAKAGE
OF WATER FROM SAMPLE.
MAXIMUM DRY DENSITY ESTIMATED FROM LOWER PORTION OF CURVES AND FROM FIELD
COMPARISON TESTS OF COMPACTION VS NUMBER OF ROLLER PASSES.


FIG. 3.2

INCREMENTAL DEFLECTION

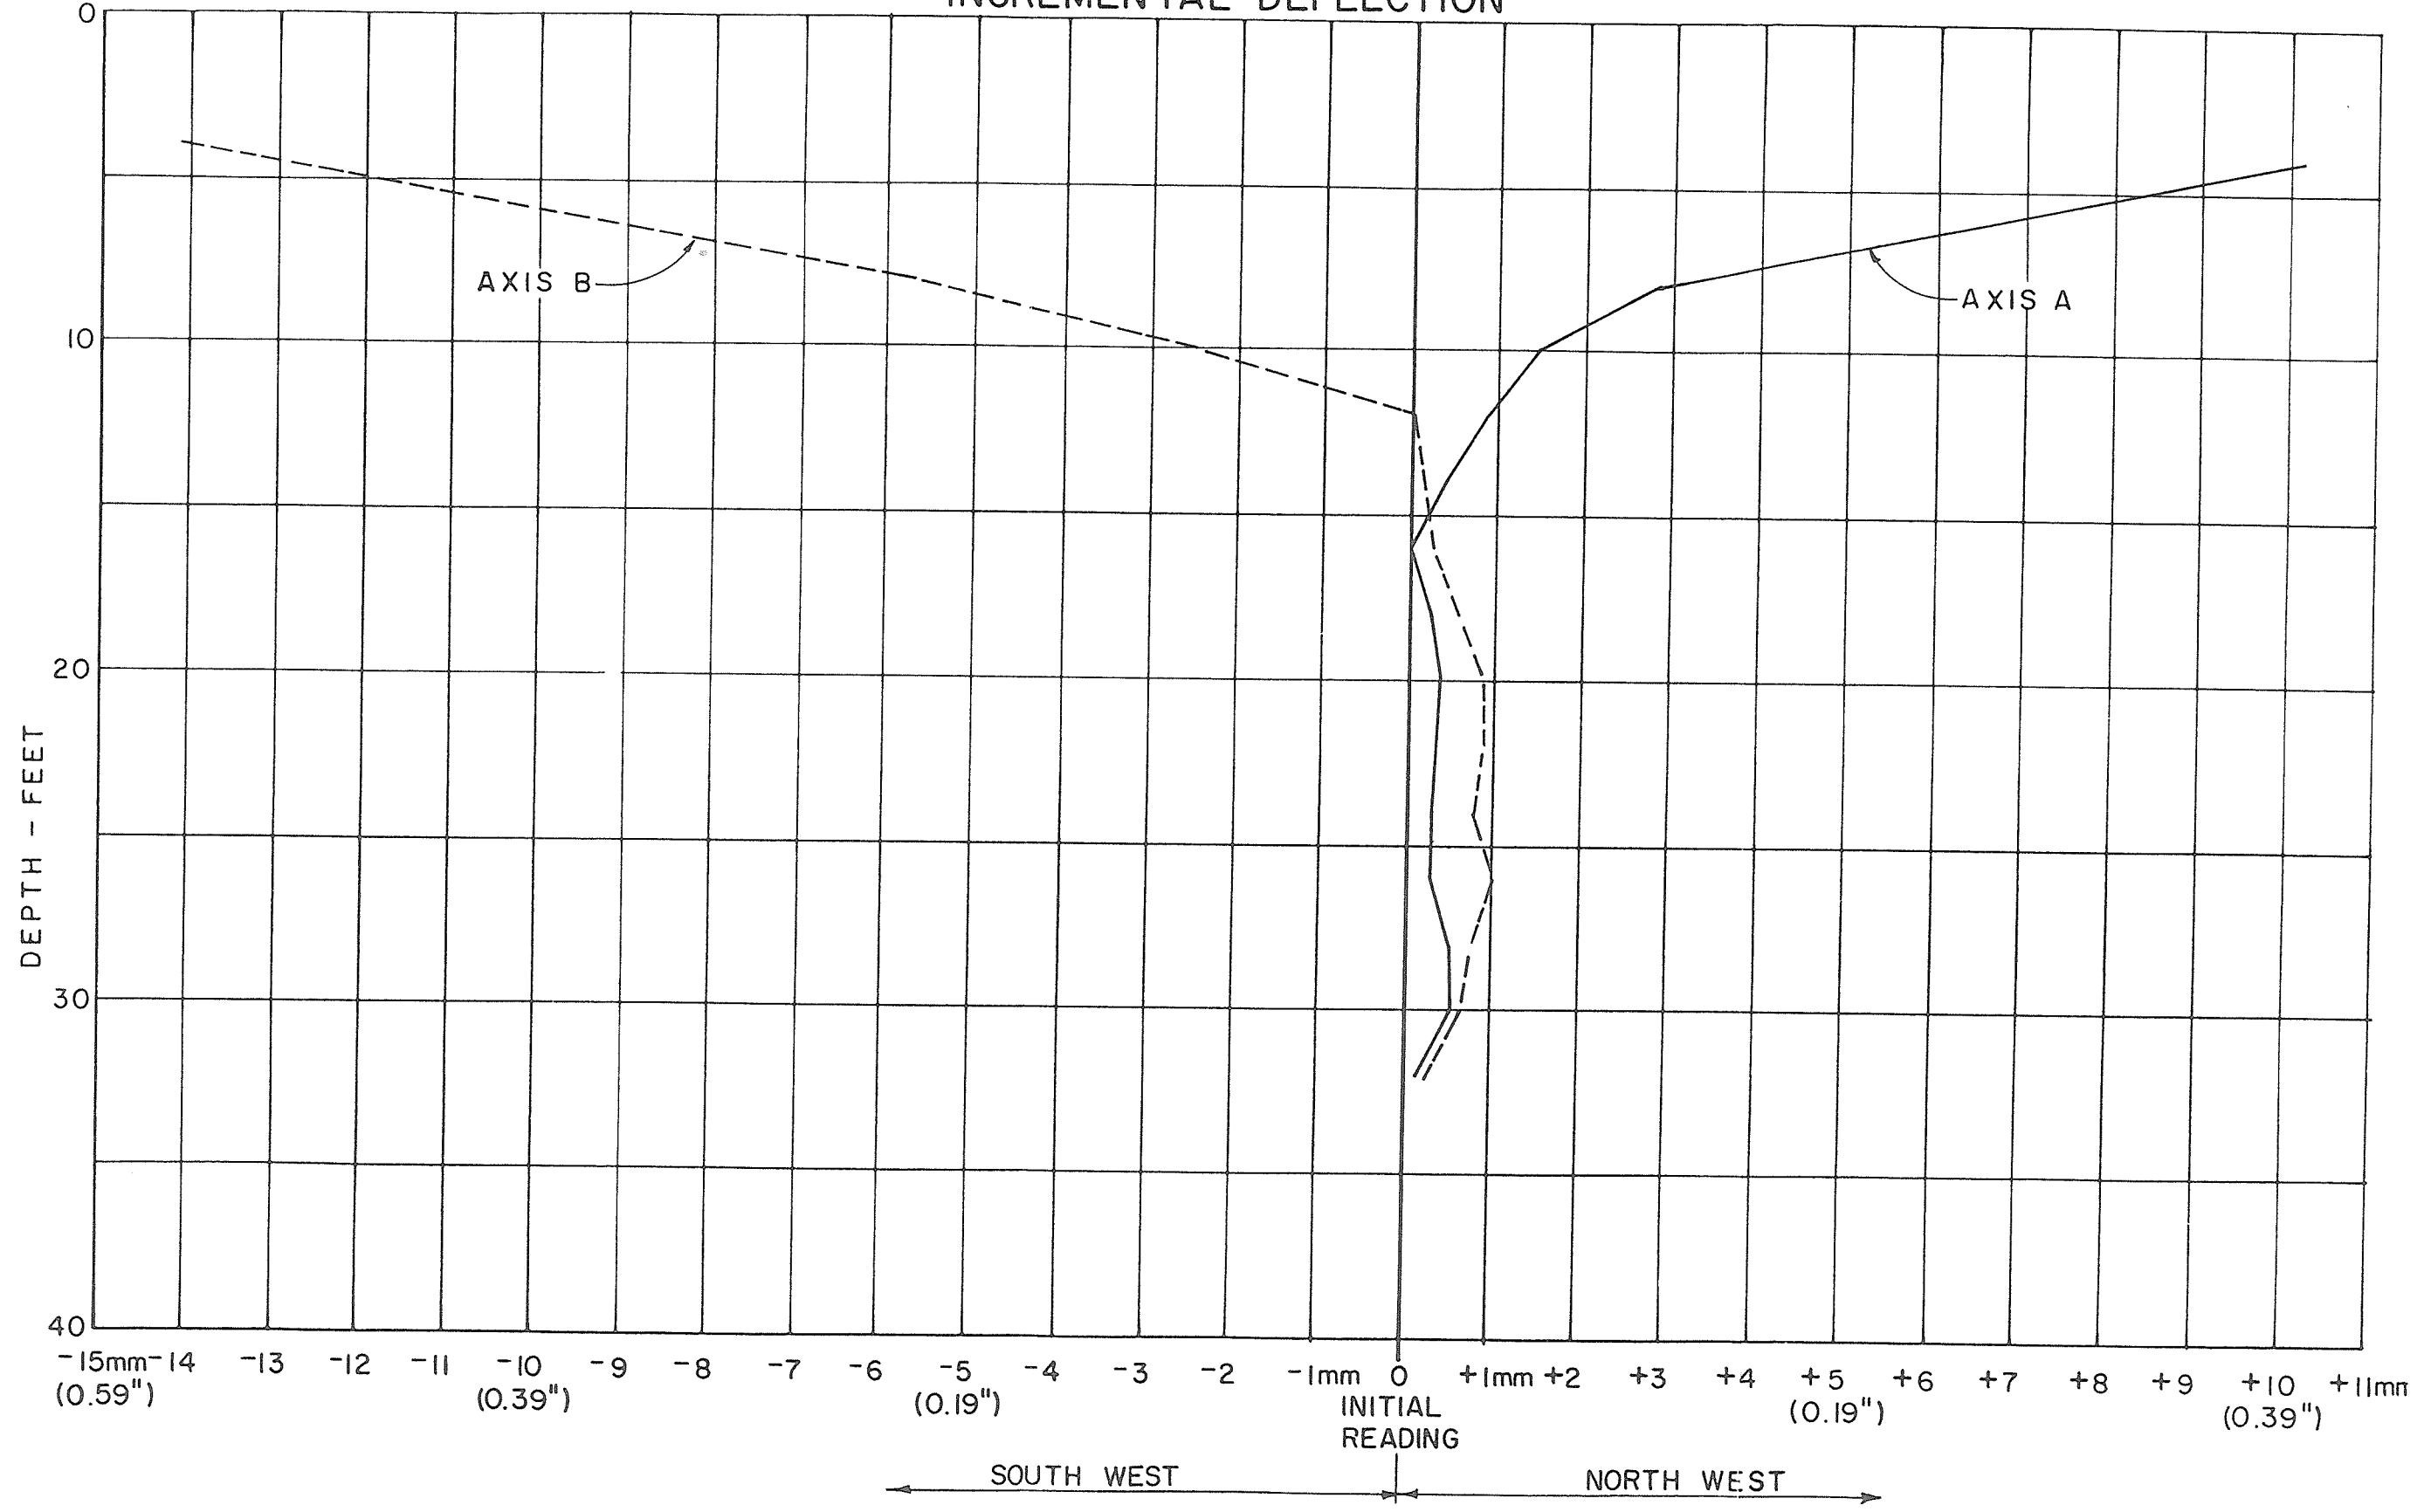

FINAL READINGS LATERAL MOVEMENT GAUGE S1

INCREMENTAL DEFLECTION

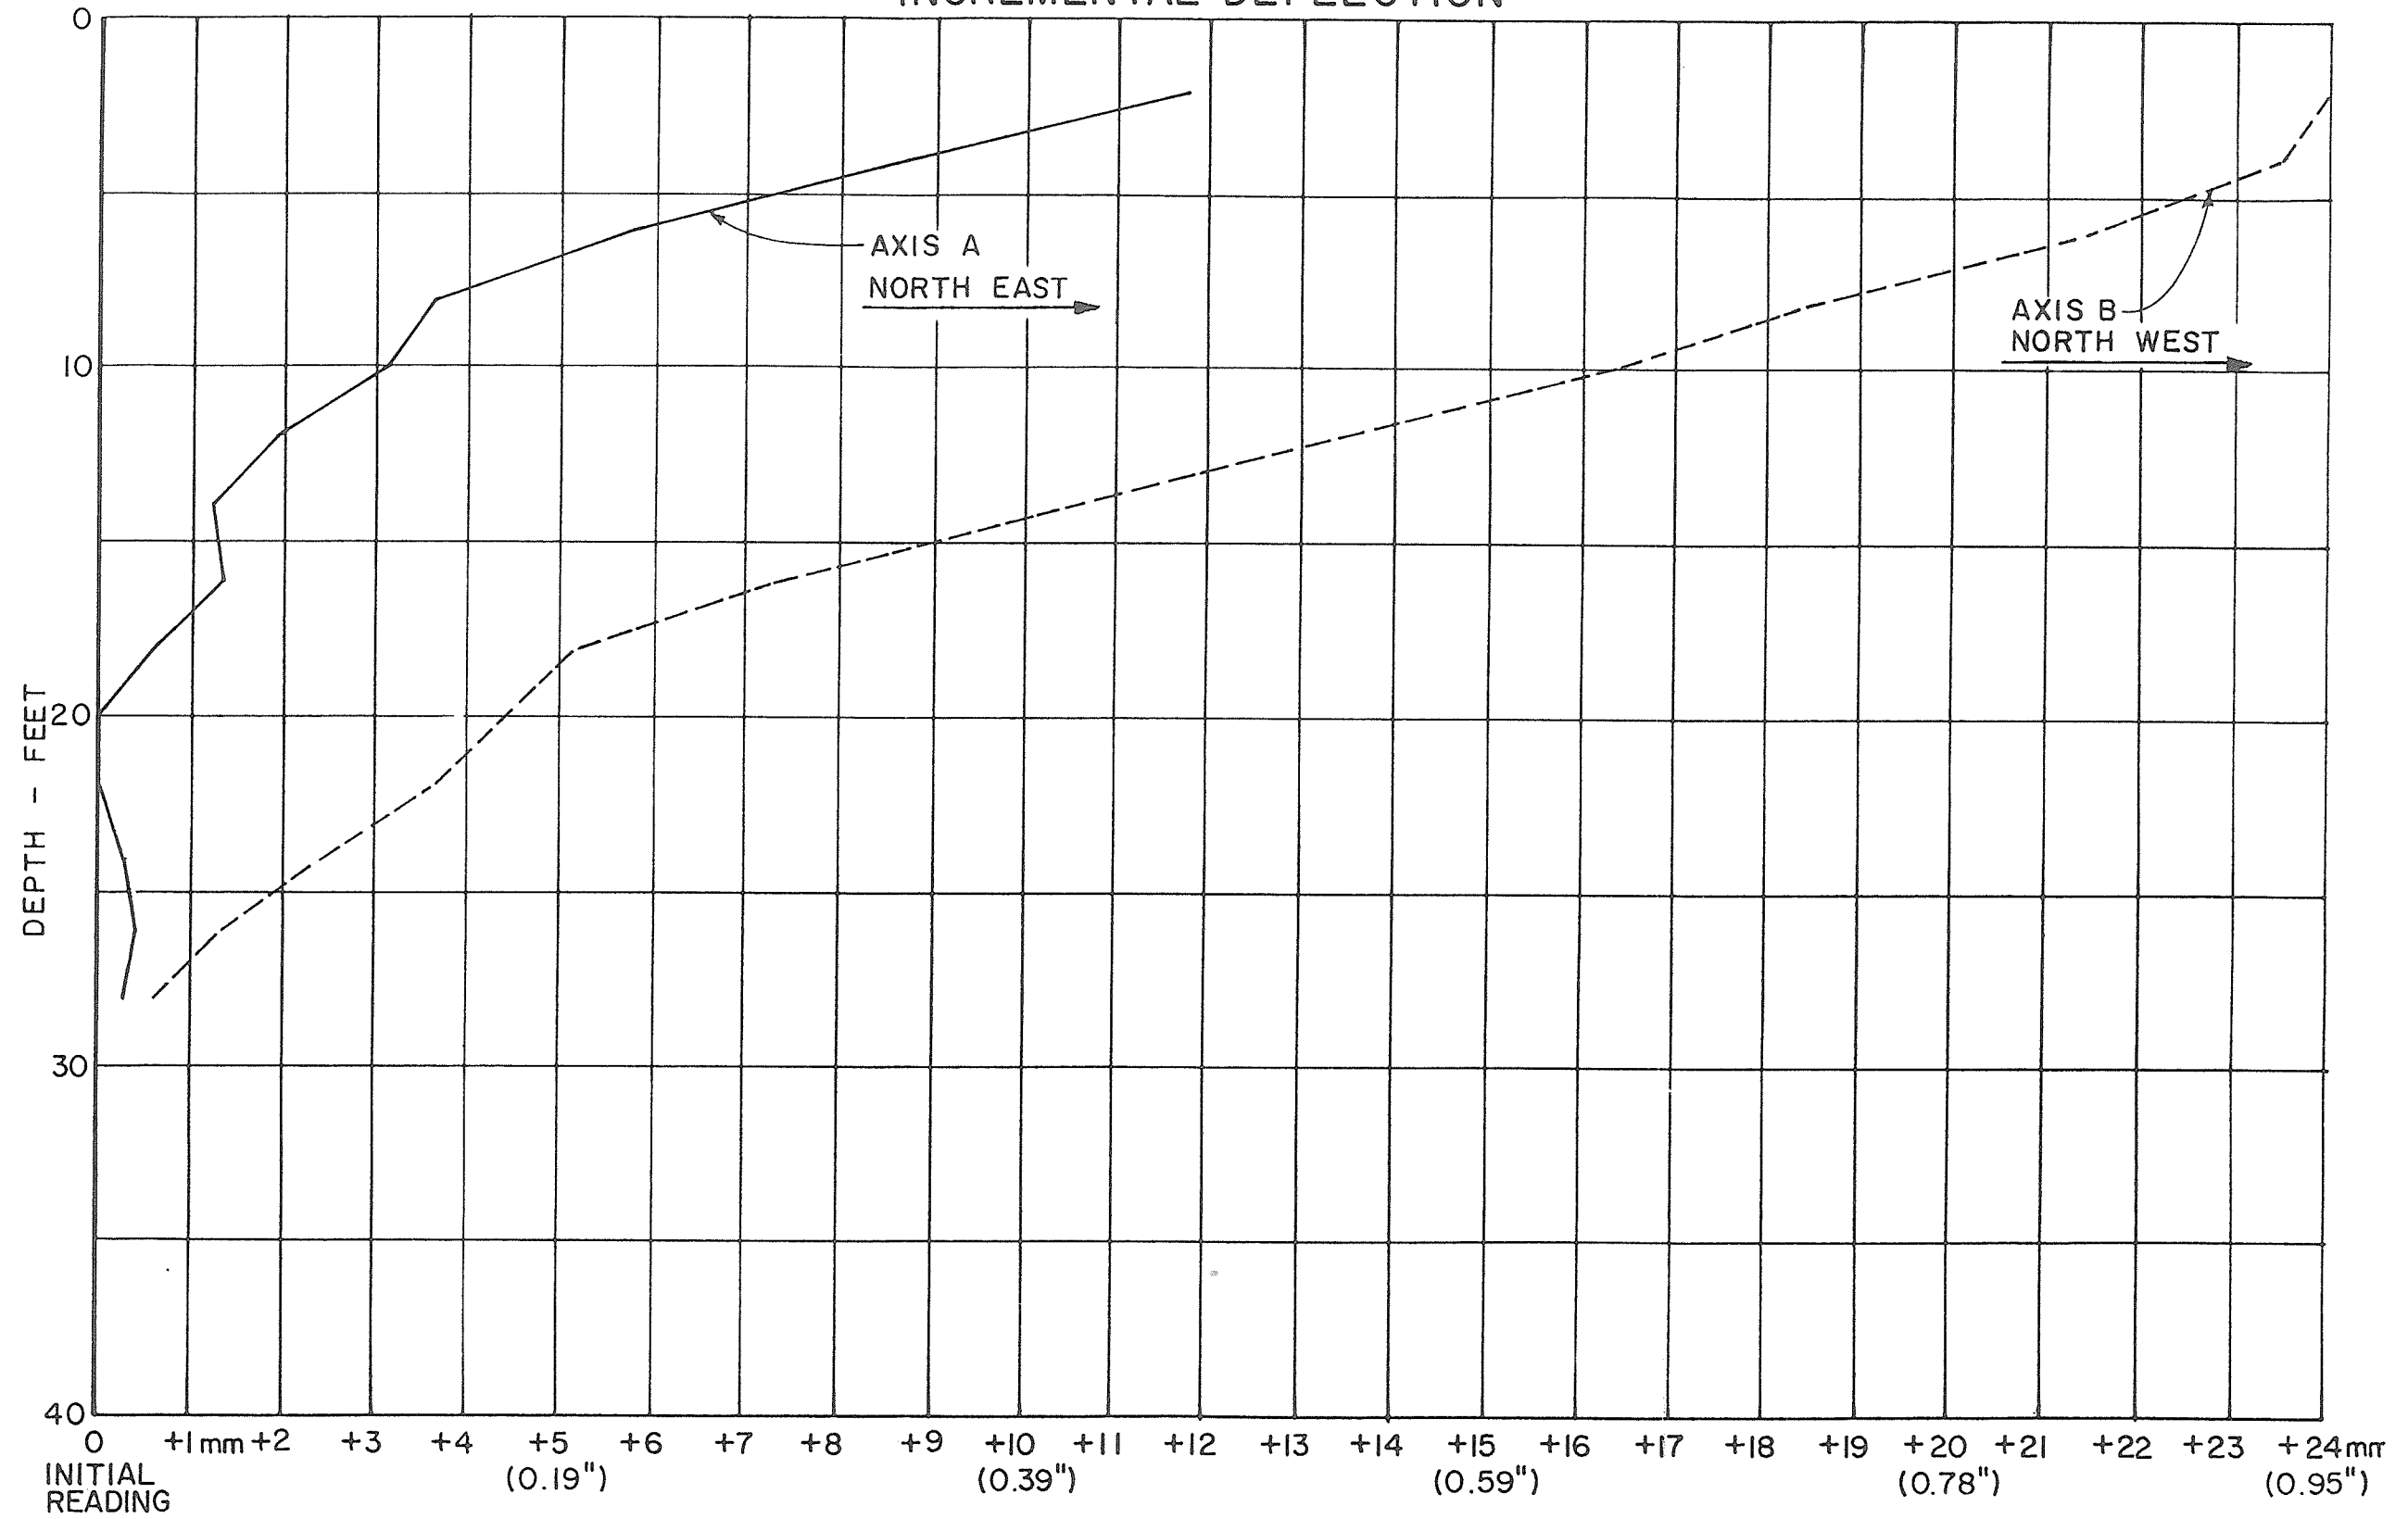


FINAL READINGS

LATERAL MOVEMENT GAUGE S3

FIG. 3.4

INCREMENTAL DEFLECTION

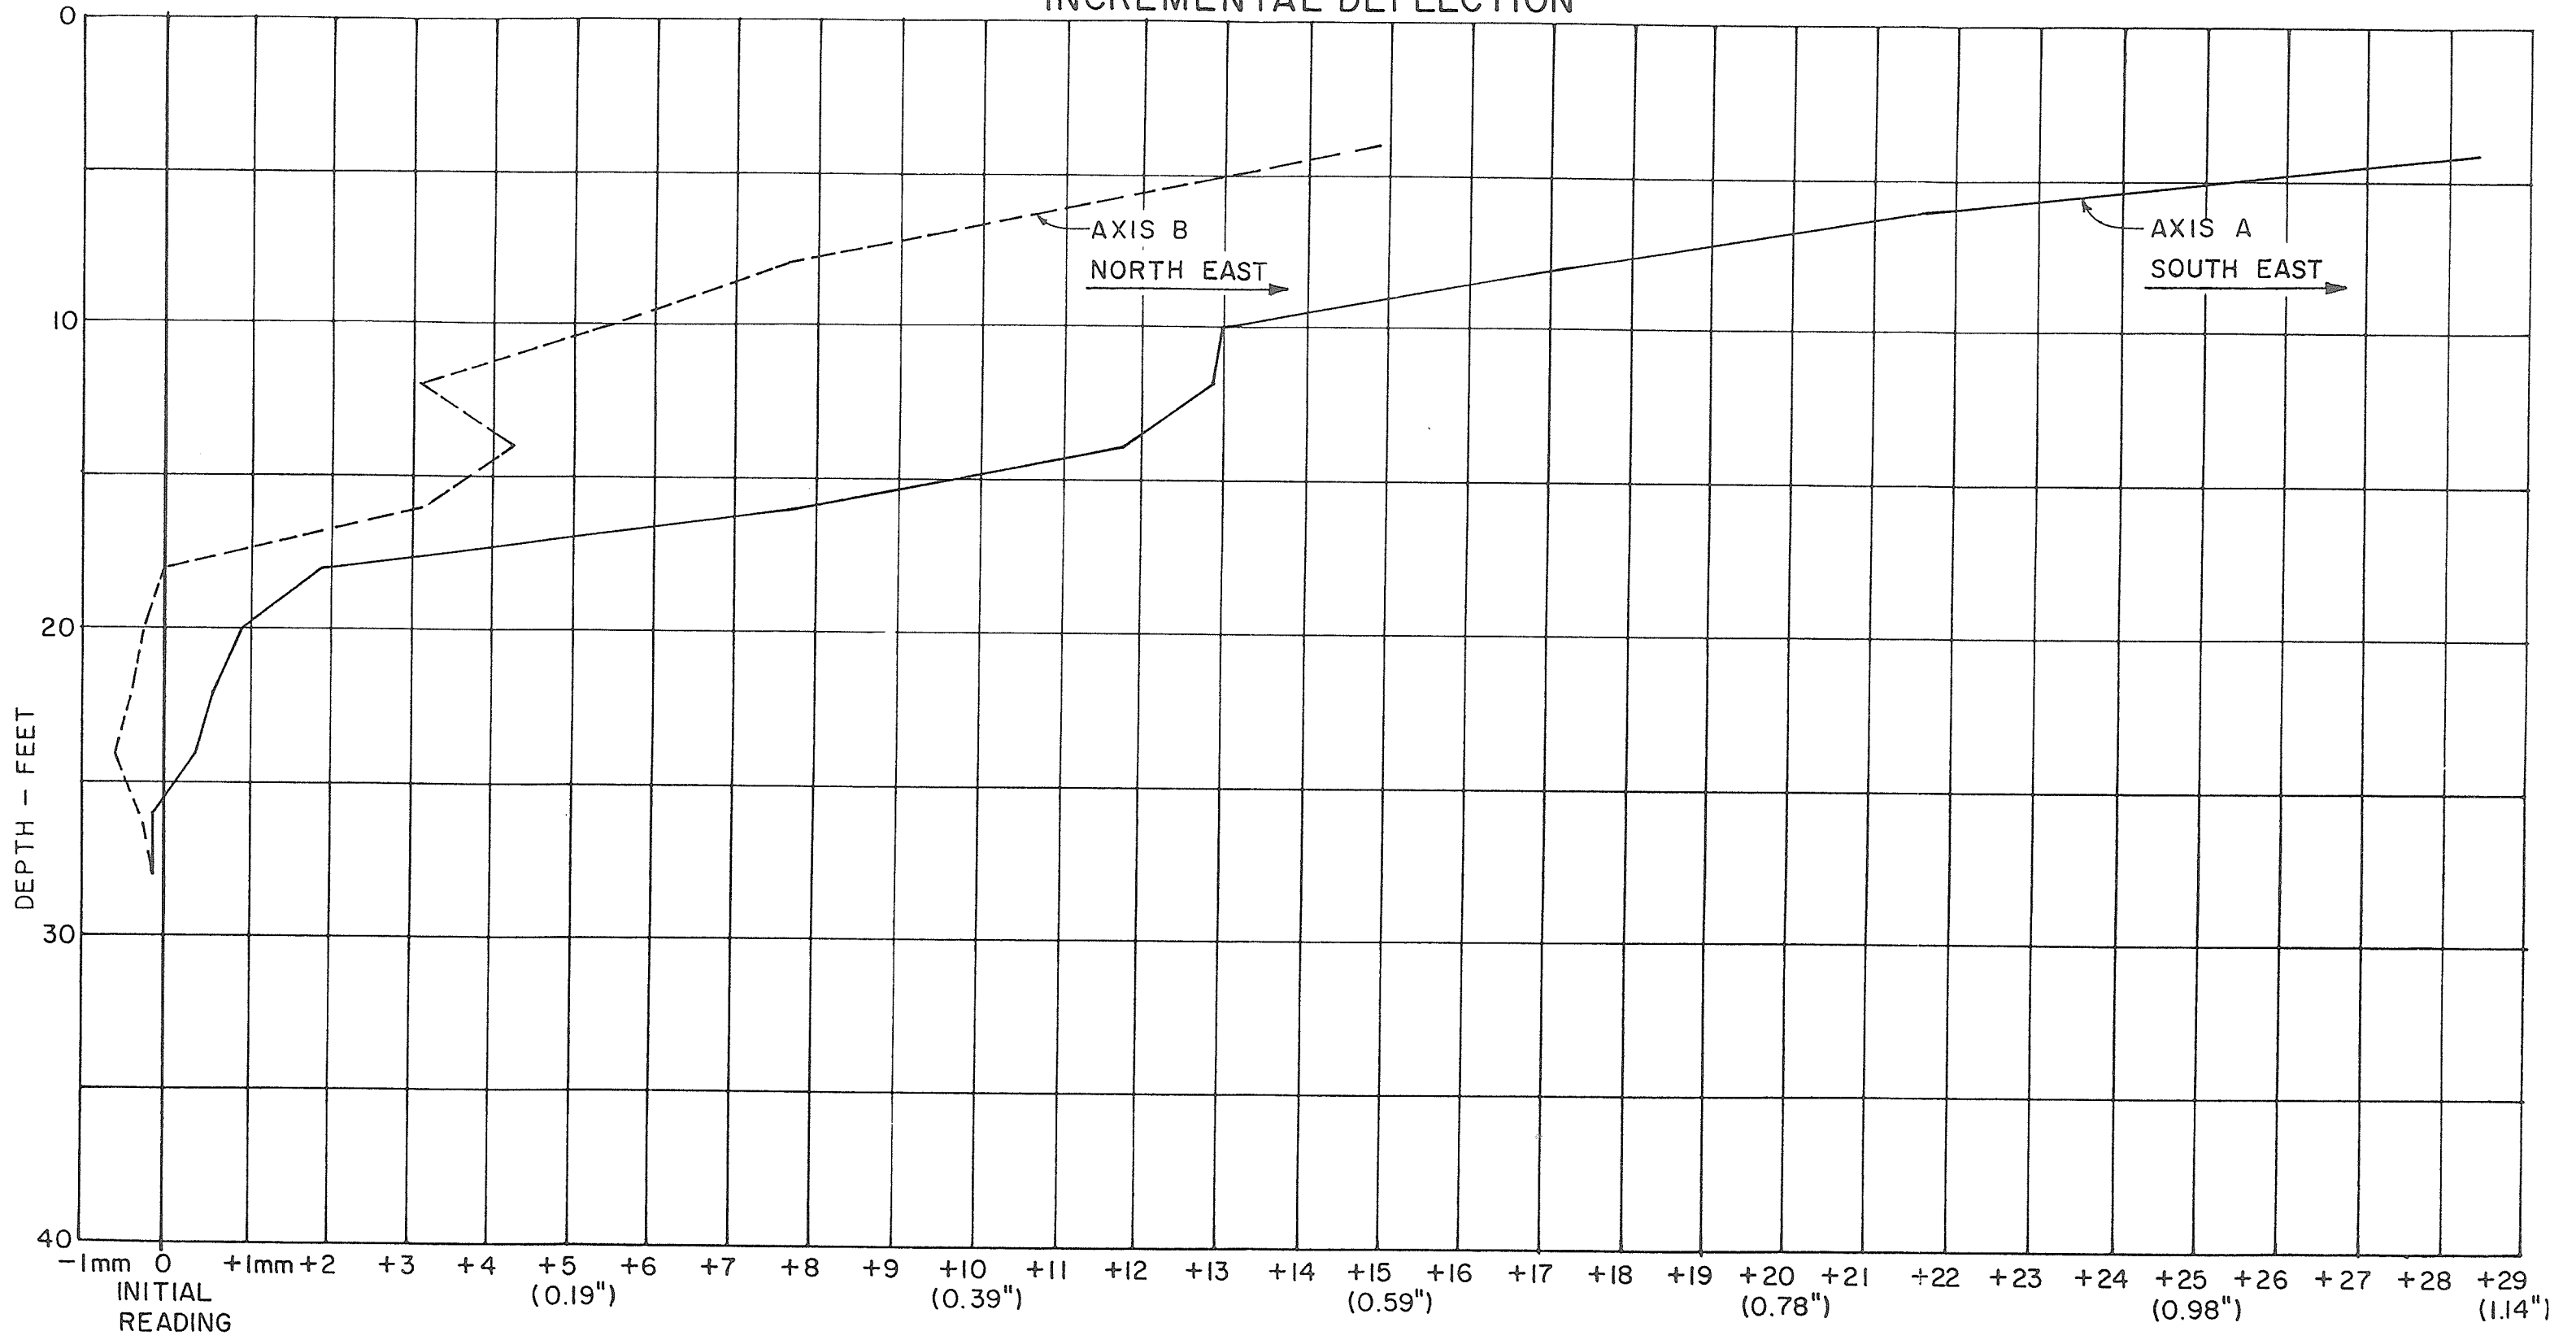

FINAL READINGS
LATERAL MOVEMENT GAUGE S4
FIG. 3.5

INVERT PROFILE OF 72" Ø PIPE AT 124TH ST. OUTLET WORKS

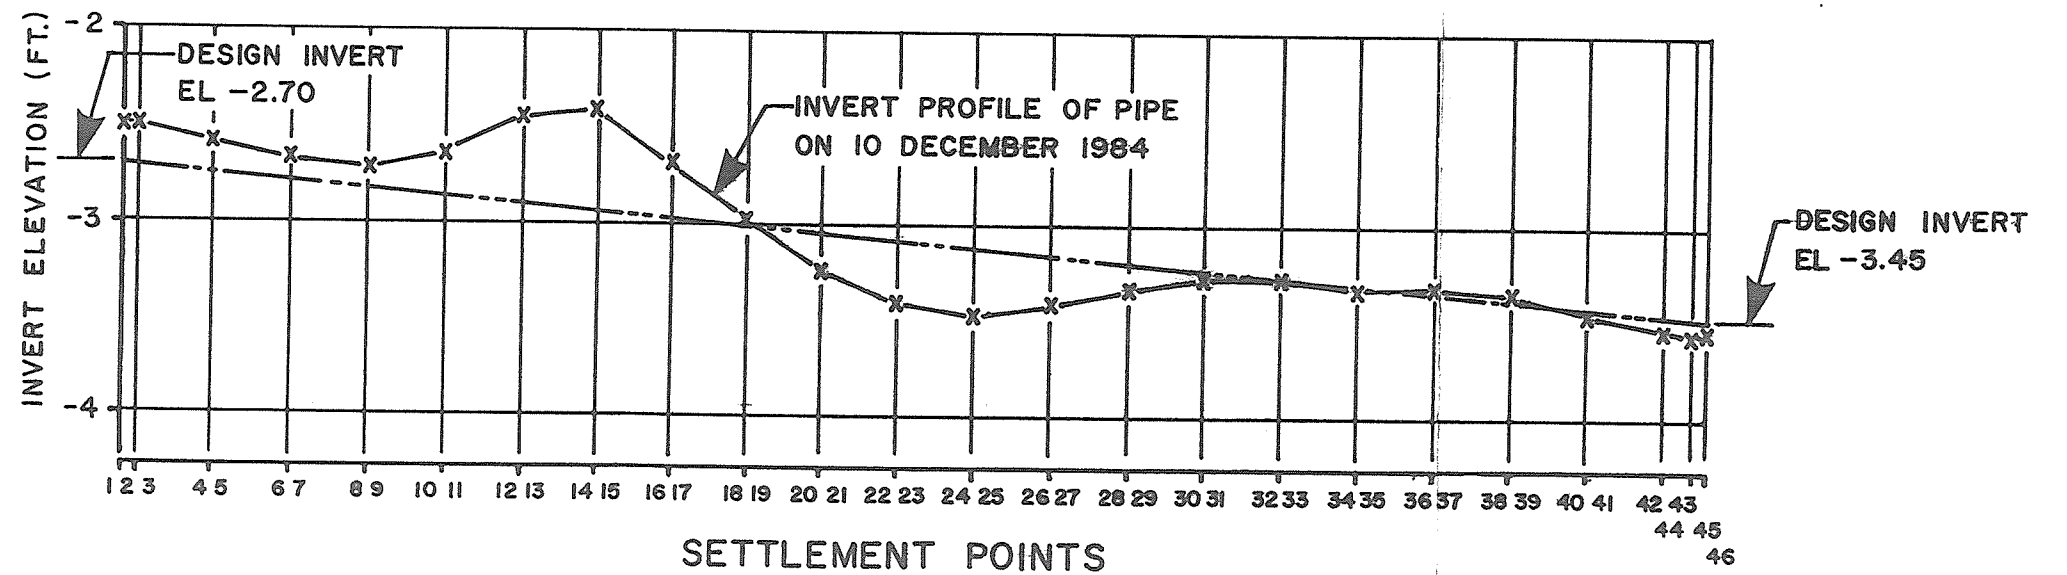
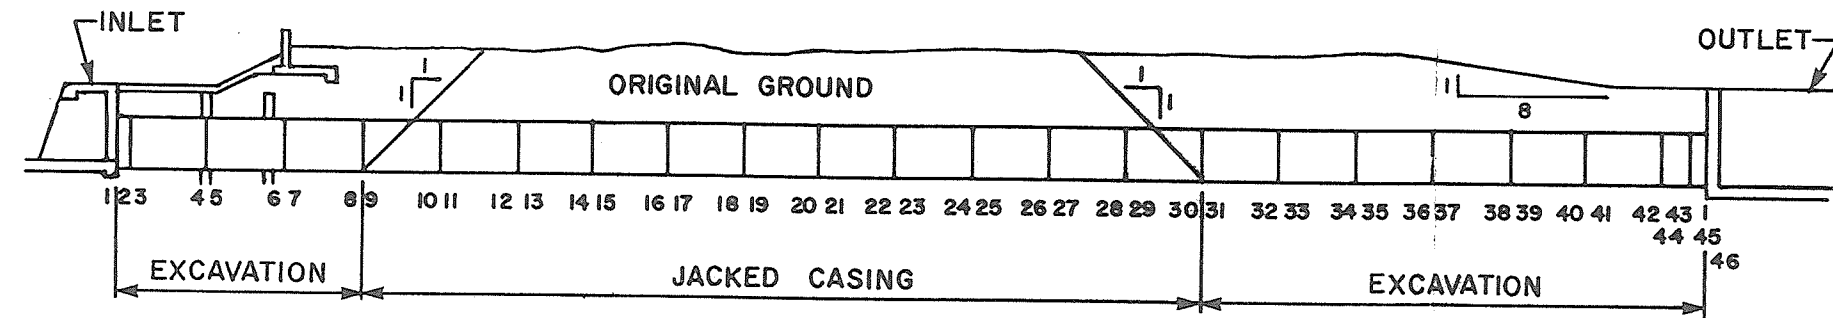



FIG. 3.6

PUBLIC WORKS CANADA - RAIL TRESTLE - PATULLO BRIDGE


MONITORING FOR POSSIBLE SETTLEMENT

DUE TO CONSTRUCTION OF FLOODBOX

| <u>Point No.</u> | <u>Initial Elevation</u> | <u>Final Elevation</u> |
|------------------|--------------------------|------------------------|
| 1 | 11.47 | 11.48 |
| 2 | 14.13 | discontinued |
| 3 | 14.09 | discontinued |
| 4 | 13.26 | 13.31 |
| 5 | 13.50 | discontinued |
| 6 | 12.43 | 12.44 |
| 7 | 13.67 | 13.68 |
| 8 | 12.99 | discontinued |
| 9 | 14.01 | 14.03 |
| 10 | 12.87 | 12.88 |
| 11 | 14.15 | discontinued |
| 12 | 12.46 | 12.47 |
| 13 | 12.55 | 12.55 |
| 14 | 13.12 | discontinued |
| 15 | 12.66 | 12.67 |
| 16 | 12.85 | discontinued |
| 17 | 13.34 | discontinued |
| 18 | 12.70 | discontinued |
| 19 | 16.44 | damaged |
| 20 | 15.19 | discontinued |
| 21 | 12.15 | 12.15 |
| 22 | 10.94 | 10.96 |
| 23 | 10.66 | 10.67 |
| 24 | 10.24 | 10.26 |
| 25 | 9.51 | 9.52 |
| 26 | 12.09 | 12.08 |
| 27 | 13.54 | 13.56 |
| 28 | 9.88 | 9.90 |
| 29 | 11.36 | 11.38 |
| 30 | 7.78 | 7.79 |
| 31 | 8.47 | 8.47 |
| 32 | 7.93 | 7.94 |
| 33 | 9.52 | 9.53 |
| 34 | 8.68 | 8.69 |

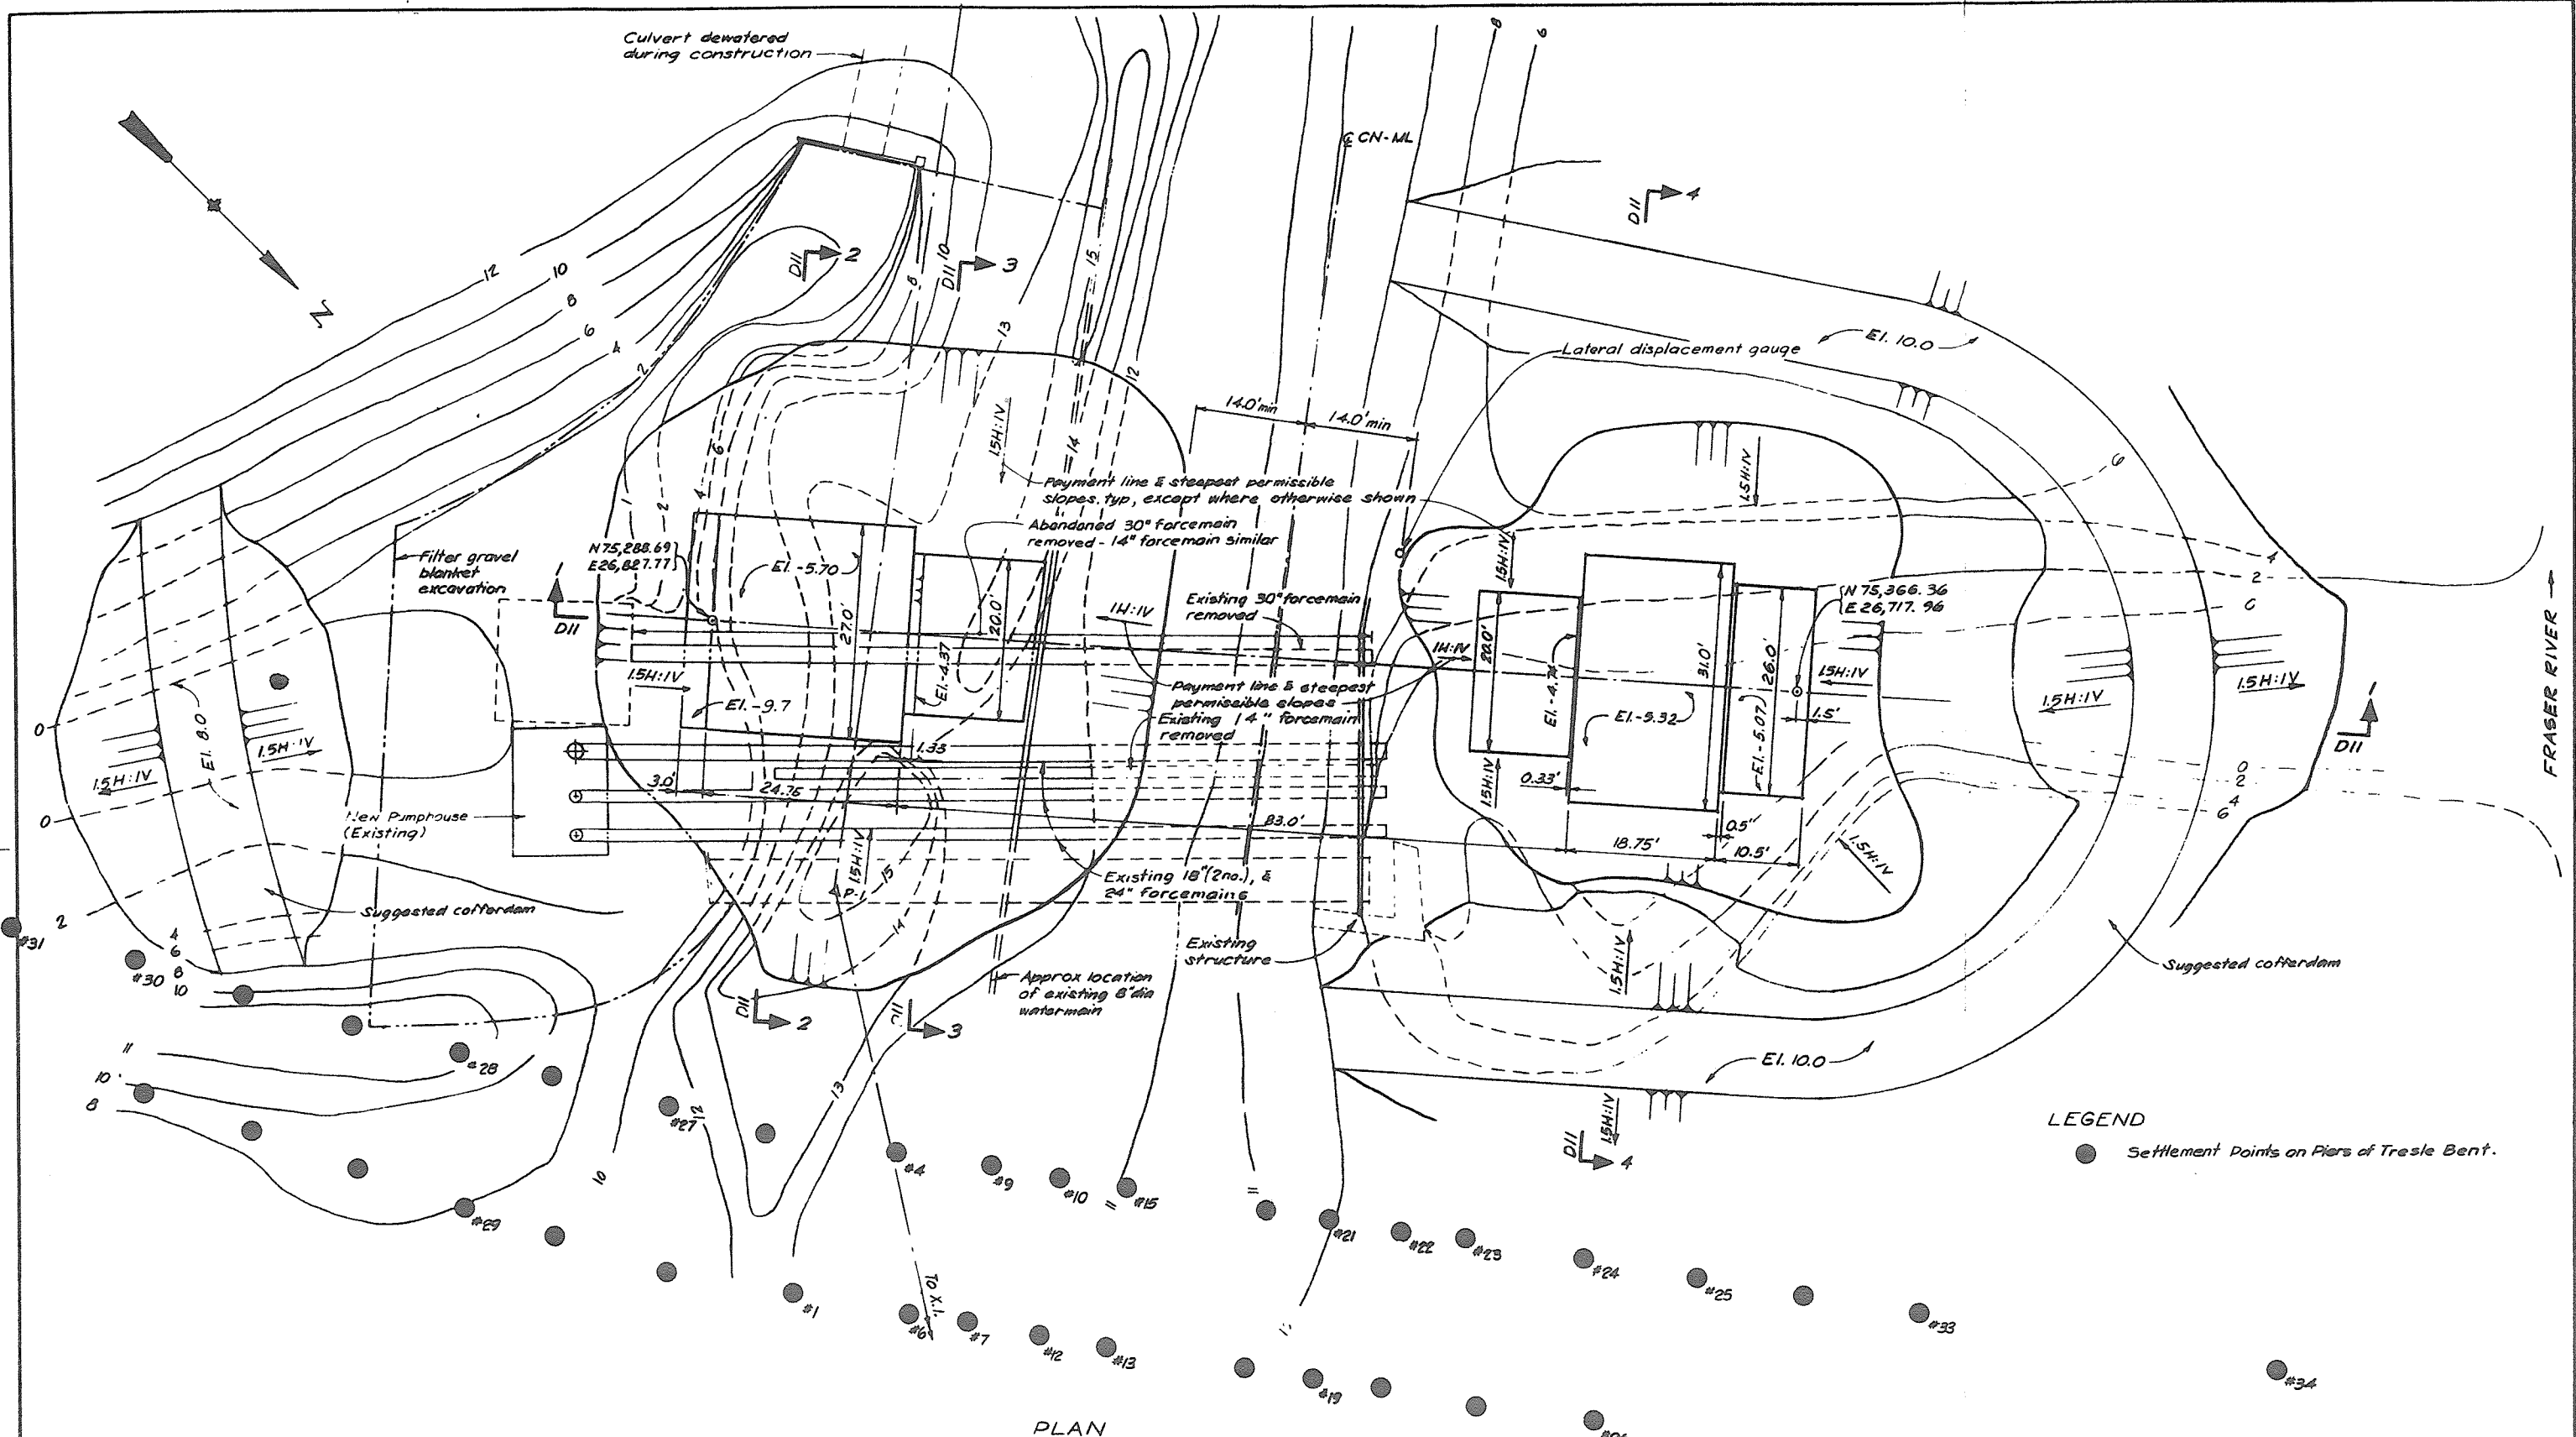

LEGEND
 ● Settlement Points on Piers of Trestle Bent.

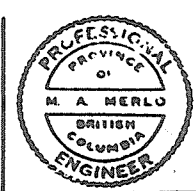

CRIPPEN ENGINEERING LTD.
 NORTH VANCOUVER, B.C.
 PROJECT NO. 10005
 DEPARTMENT HEAD: C.R. Blair
 PROJECT ENGINEER: M.A. Merlo
 CHIEF ENGINEER: John S. ...

2. Record Drawing.
 1. Prepared for Tender (Combined Contracts)
 DATE: 1-10-85
 BY: CHO
 APPROVED: [Signature]
 DATE: 5-2-84

RECOMMENDED: [Signature]
 DATE: June 6 1984
 APPROVED: [Signature]
 DATE: June 6/84

BRITISH COLUMBIA
 MINISTRY OF THE ENVIRONMENT
 WATER INVESTIGATIONS BRANCH
 CANADA - BRITISH COLUMBIA
 FRASER RIVER FLOOD CONTROL 1988 AGREEMENT
 PROJECT 104 CONTRACT NO. 2
 SOUTH WESTMINSTER FLOOD CONTROL WORKS
 PATTLELO FLOODBOX
 GNR/PWC TRESTLE SETTLEMENT POINTS

DESIGNED: NAC
 DRAWN: HNC
 CHECKED: J.D., LVS
 SCALE: As shown

SURVEYED: E.S. & W.S.
 DATE: Nov 1974 & May, 1978
 FILE NO.: 028180-C120-5
 DATE: 14 Feb, 1979.
FIG. 3.8